

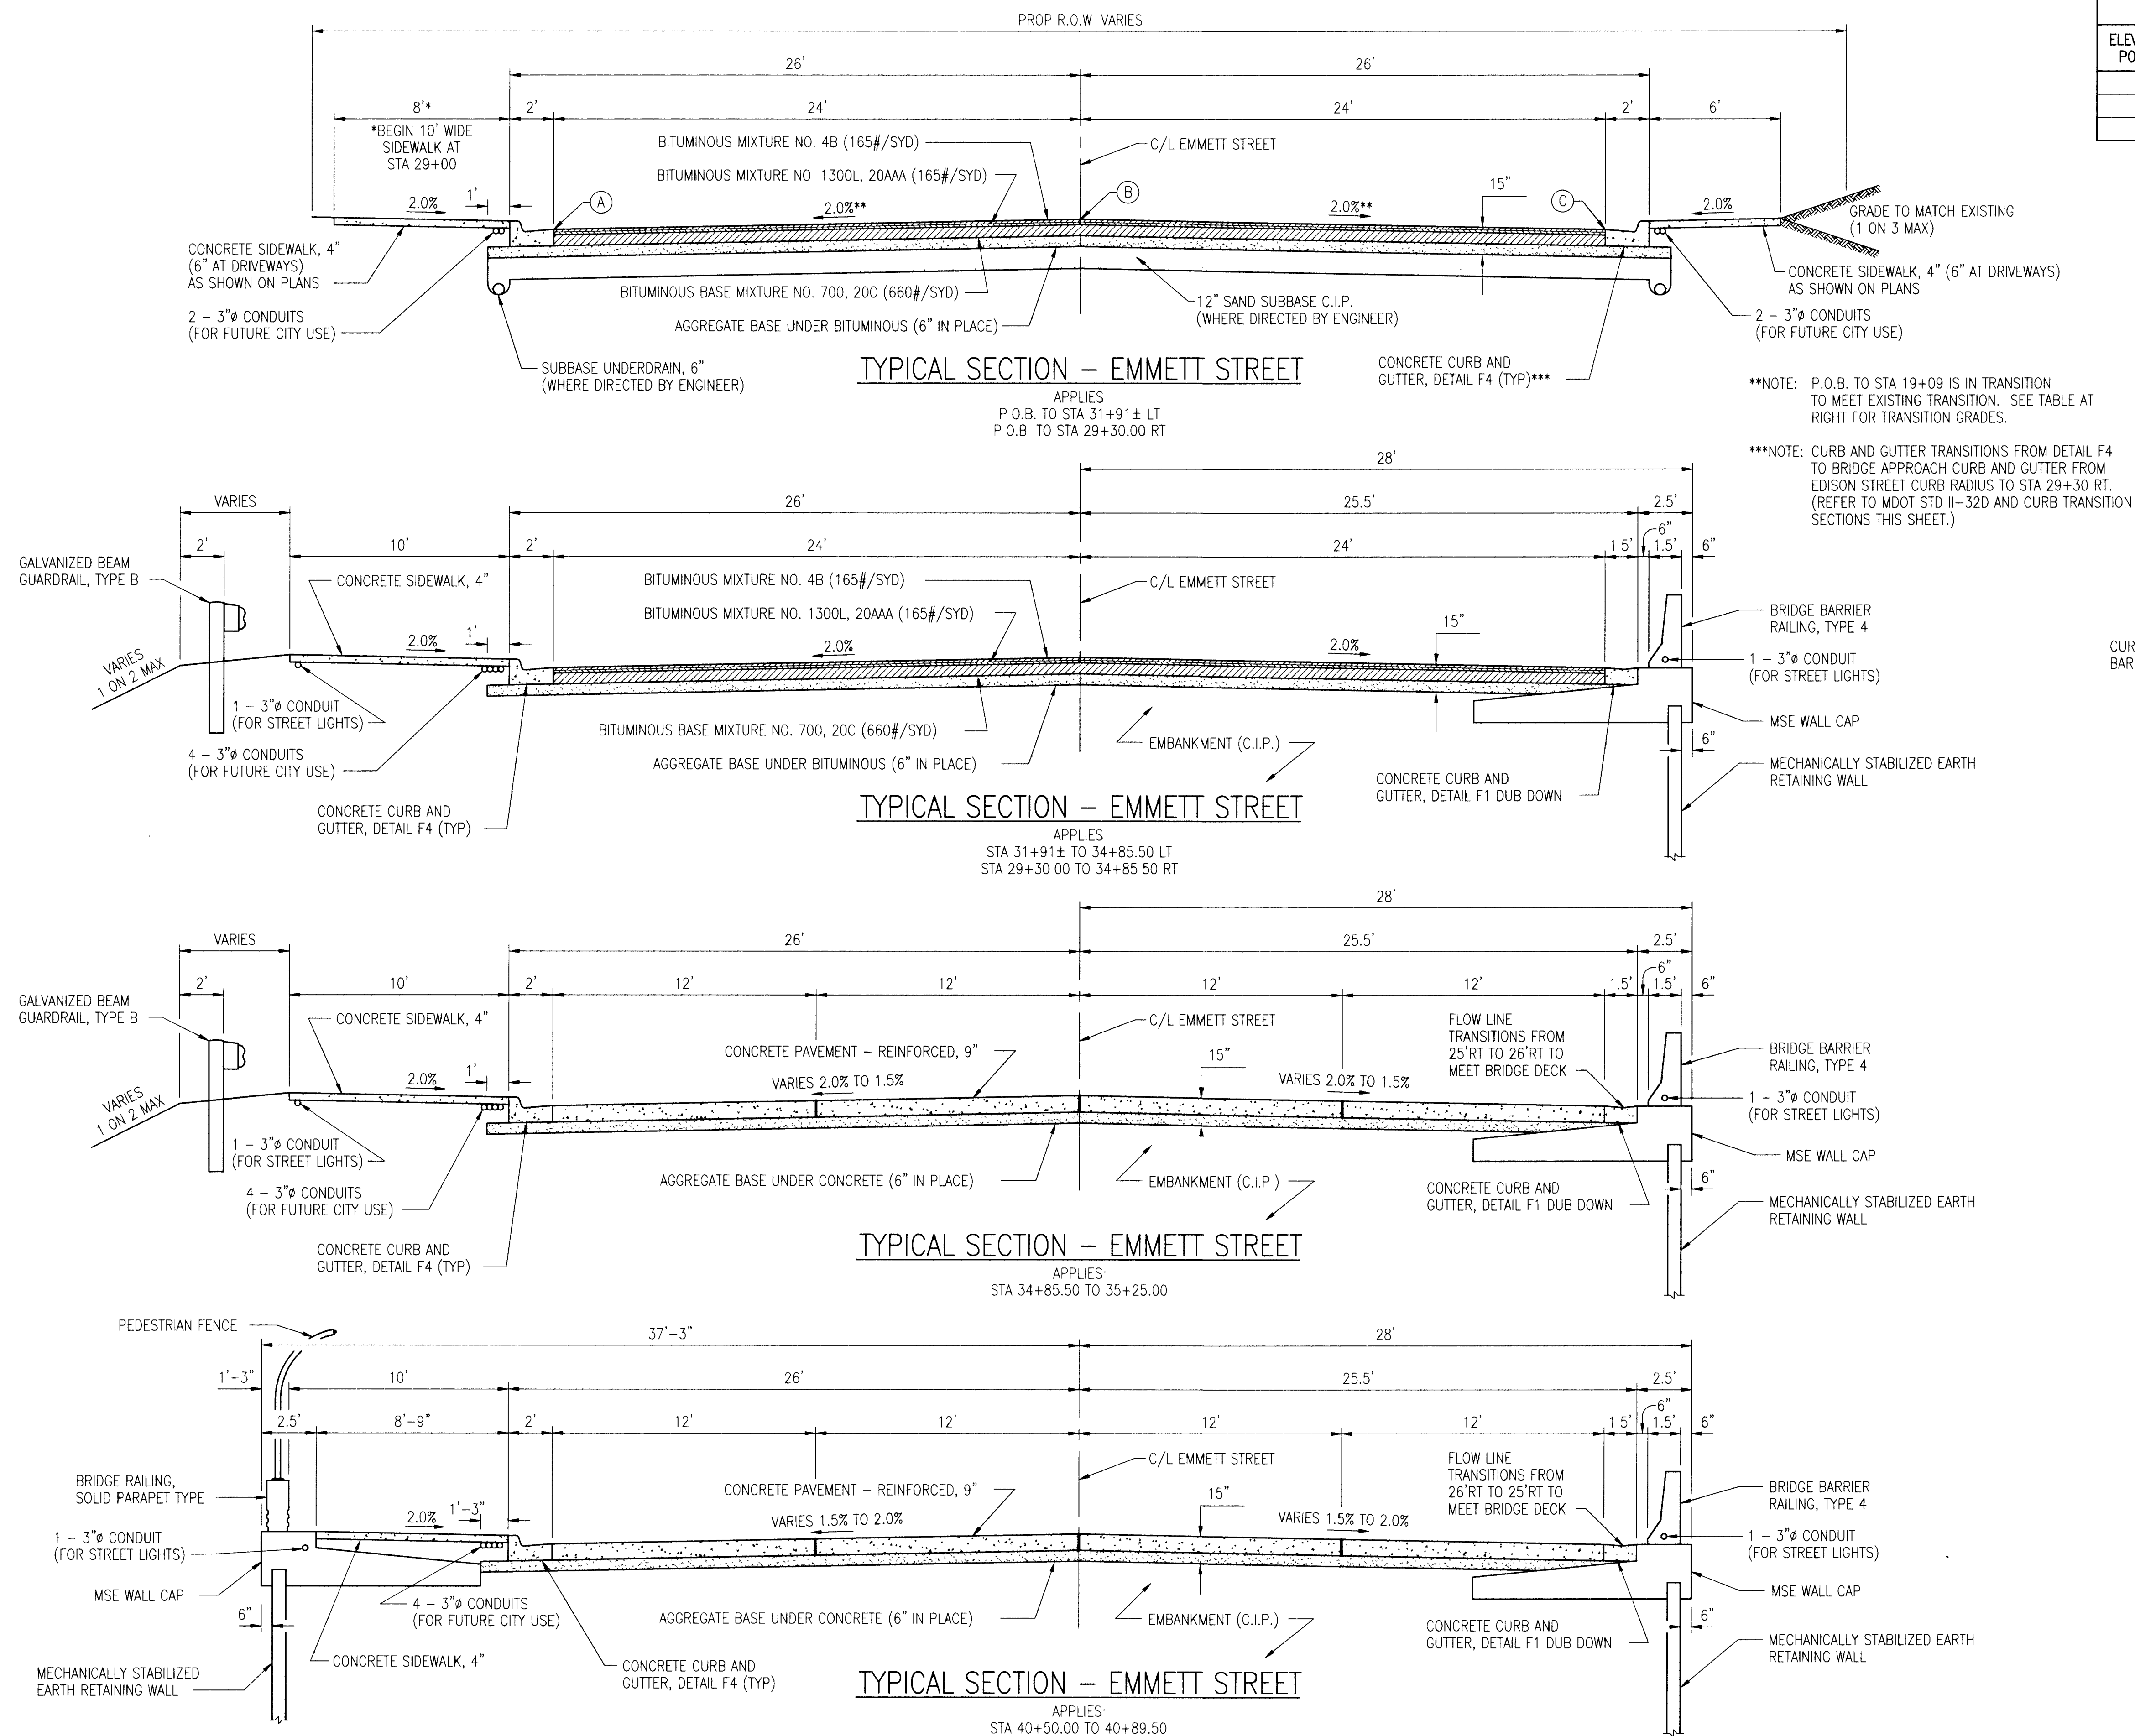


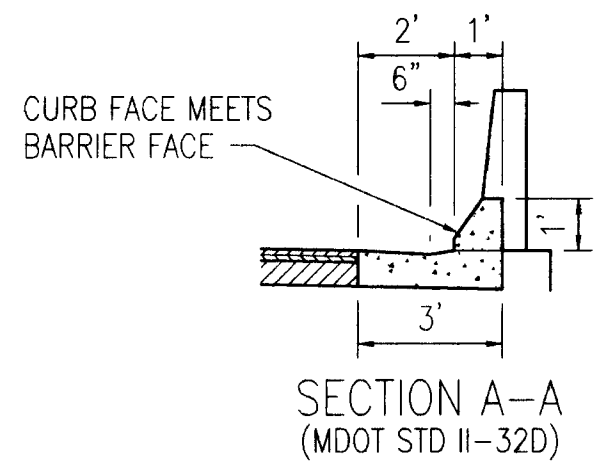

EMMETT STREET TRANSITION			
ELEVATION POINTS	STATION		
	18+50	19+00	19+09
A	830.97	830.57	830.50
B	831.45	831.05	830.98
C	831.38	830.63	830.50

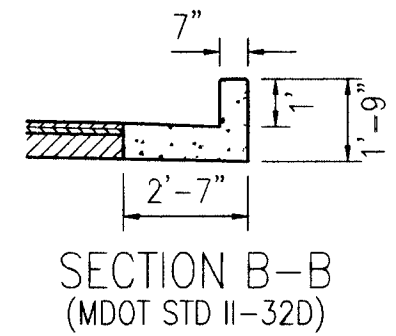

CITY OF BATTLE CREEK
 MICHIGAN
 EMMETT STREET OVERPASS
 AS BUILT TYPICAL SECTIONS

RECORDED BY	DATE
ALH/KBC	03/19/98
DRAWN BY	DATE
KBC	03/19/98
CHECKED BY	DATE
ALH	03/19/98
FILE	EDIT
601TY1	
SCALE	
1" = 4'	
DRAWING	

PROJECT C9601







AB-1

SHEET NO

REVISIONS	DATE	BY

REVISIONS	DATE	BY

HH
 HH ENGINEERING LTD.
 220 BAGLEY AVE., SUITE 500, DETROIT, MICHIGAN 48226
 (313) 963-6660

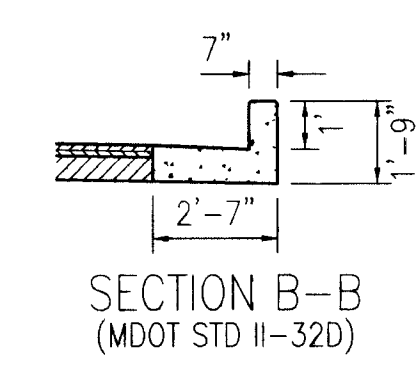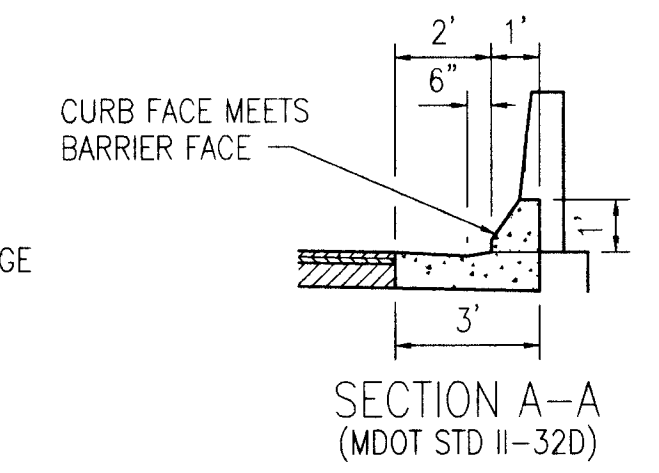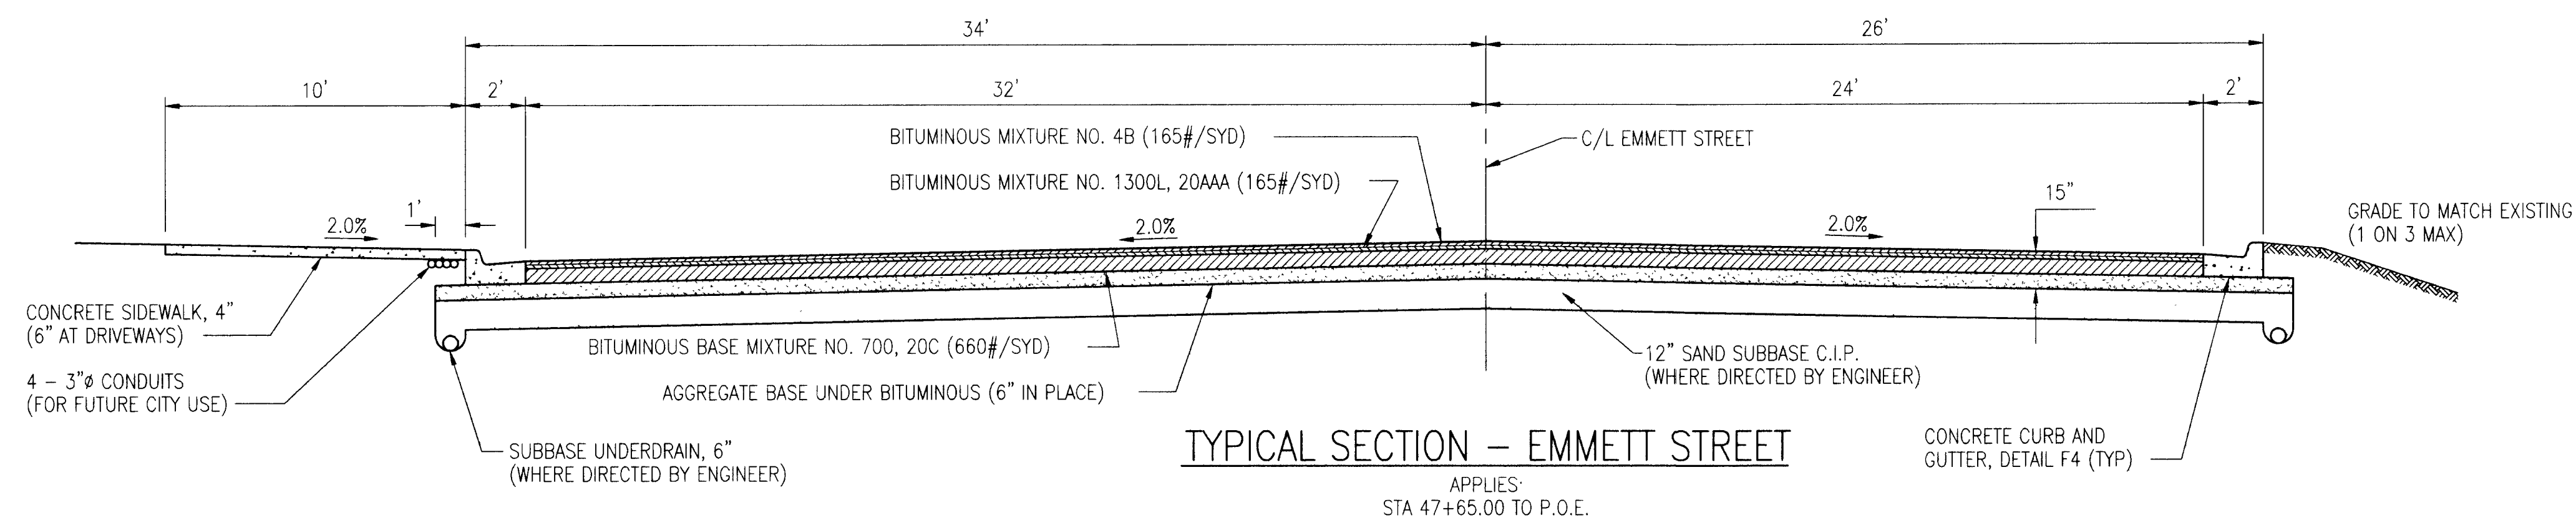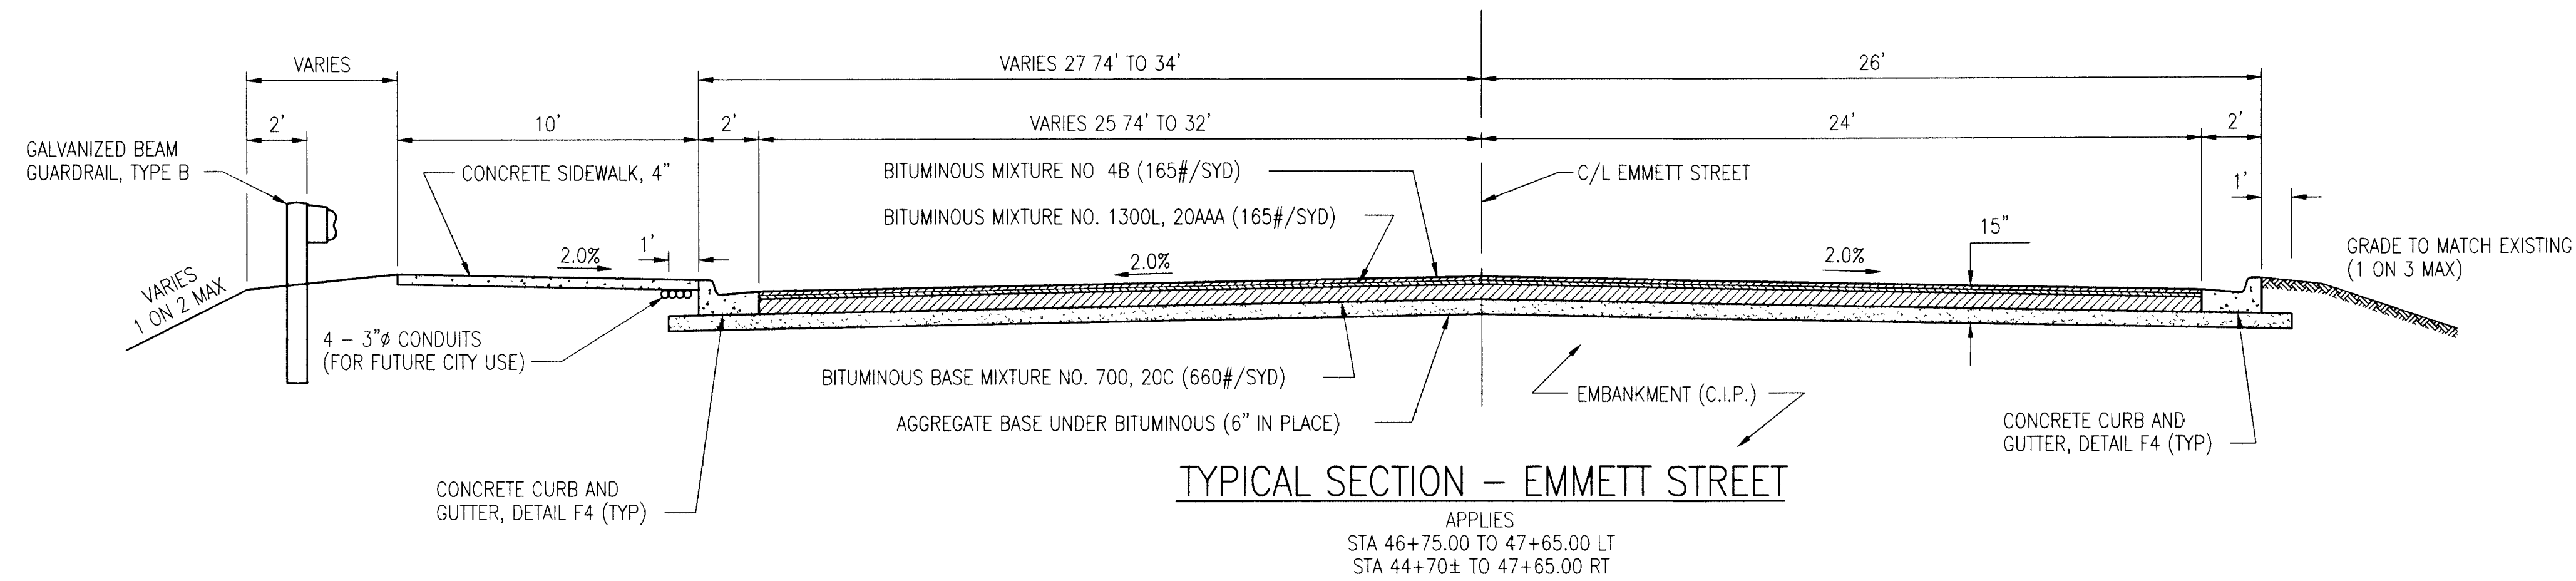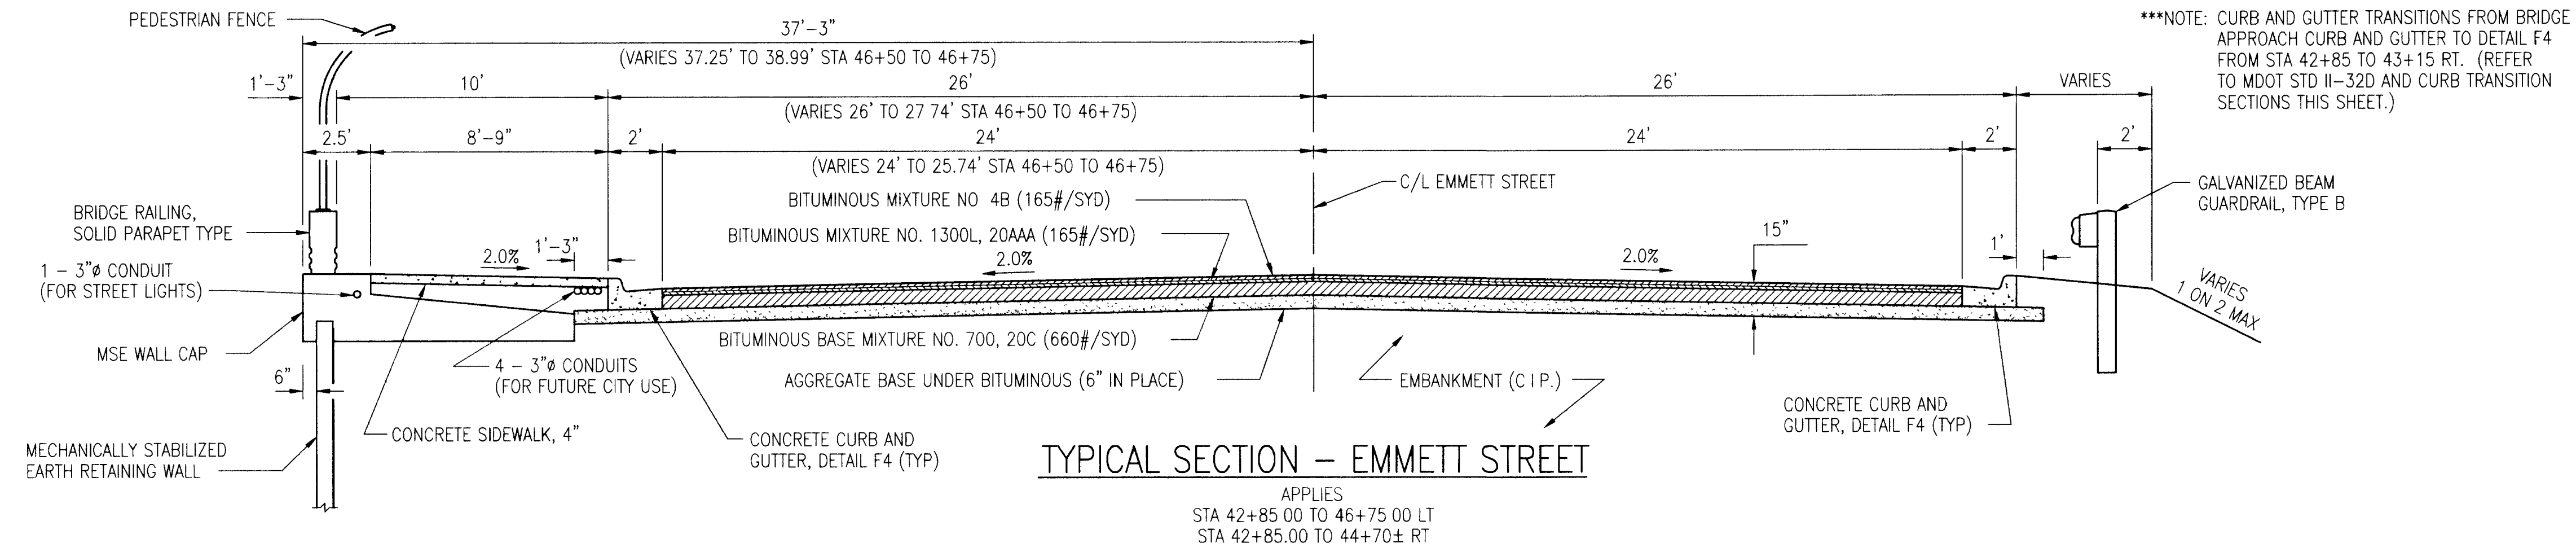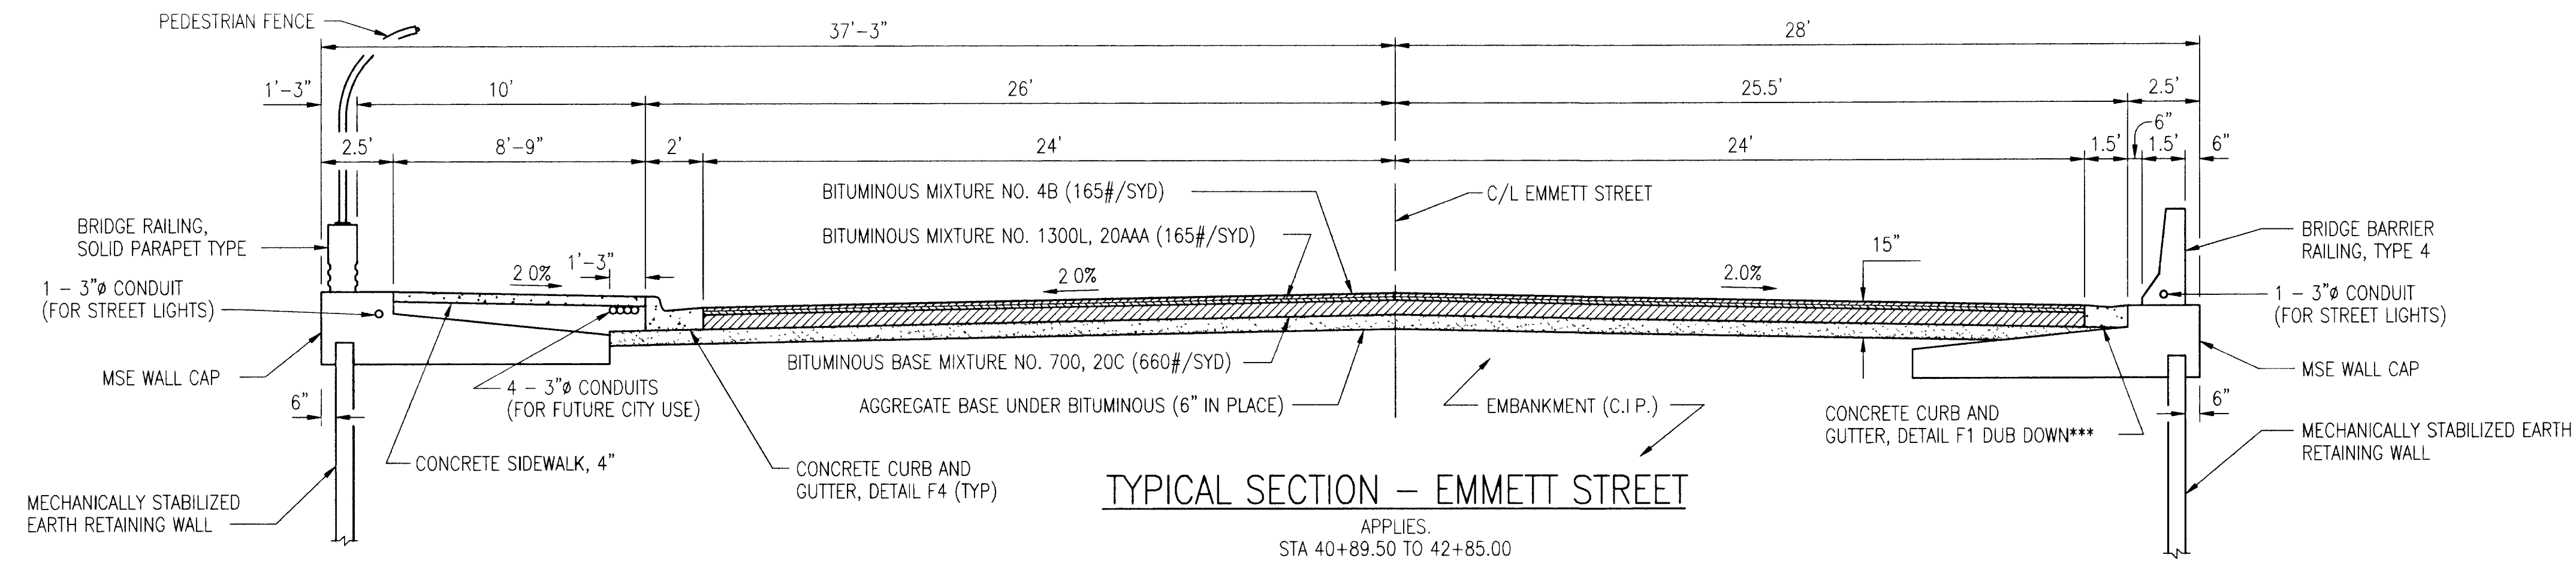

***NOTE: CURB AND GUTTER TRANSITIONS FROM BRIDGE APPROACH CURB AND GUTTER TO DETAIL F4 FROM STA 42+85 TO 43+15 RT. (REFER TO MDOT STD II-32D AND CURB TRANSITION SECTIONS THIS SHEET.)


HH ENGINEERING LTD.
220 BAGLEY AVE., SUITE 500, DETROIT, MICHIGAN 48226
(313) 963-6560

NO.	REVISIONS	BY	DATE



NO.	REVISIONS	BY	DATE

CITY OF BATTLE CREEK
MICHIGAN
EMMETT STREET OVERPASS
AS BUILT TYPICAL SECTIONS

RECORDED BY	DATE
ALH/KBC	03/19/98
DRAWN BY	DATE
KBC	03/19/98
CHECKED BY	DATE
ALH	03/19/98
FILE	EDIT
601TY1	
SCALE	
1" = 4'	
DRAWING	
PROJECT	C9601
AB-2	
SHEET NO	

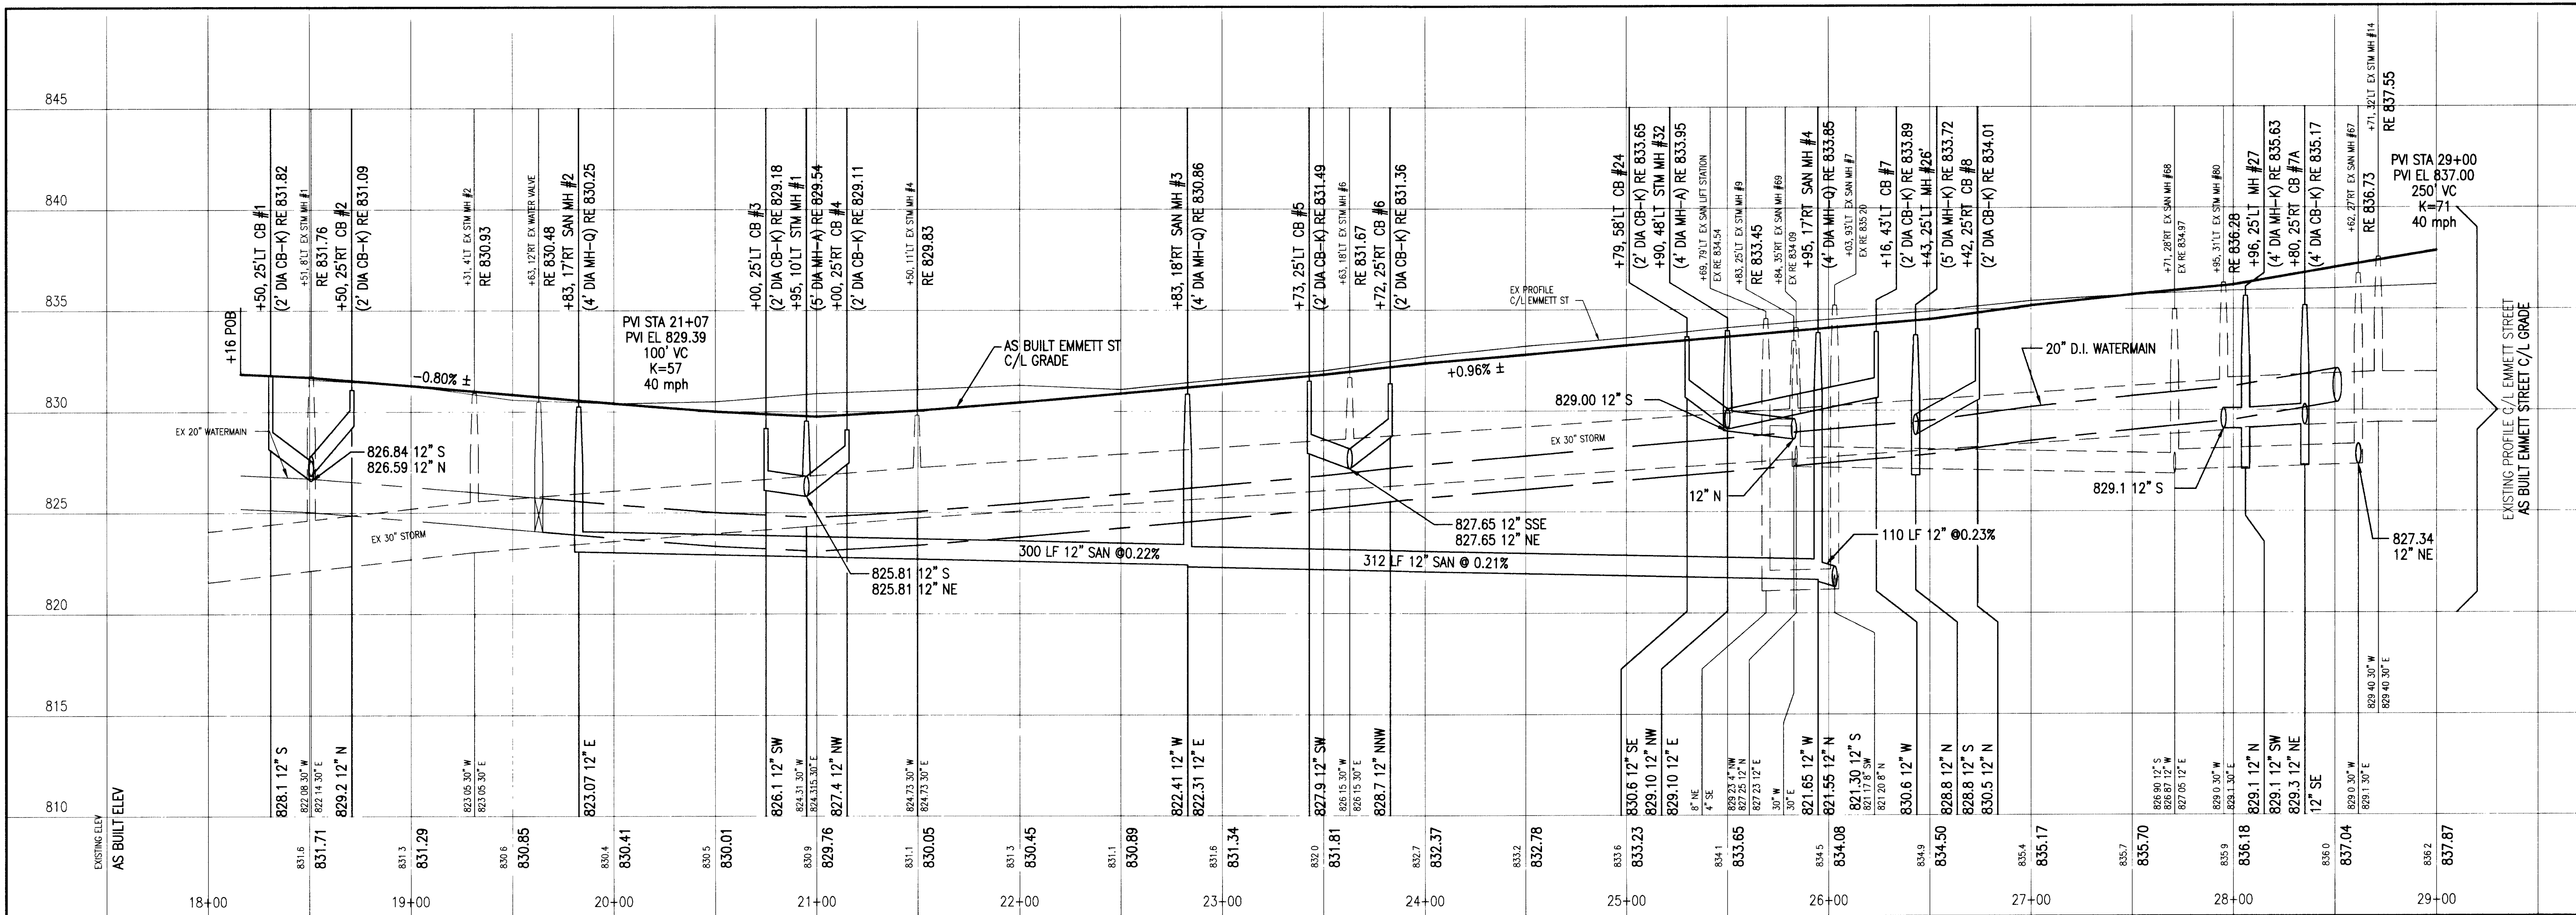

RECORDED BY ALH/KBC	DATE 03/19/98
DRAWN BY KBC	DATE 03/19/98
CHECKED BY ALH	DATE 03/19/98
FILE 601AB1	EDIT
SCALE	$1'' = 40'$ HORIZ. $1'' = 4'$ VERT. DRAWING
PROJECT	C9601
AB-3	
SHEET NO.	

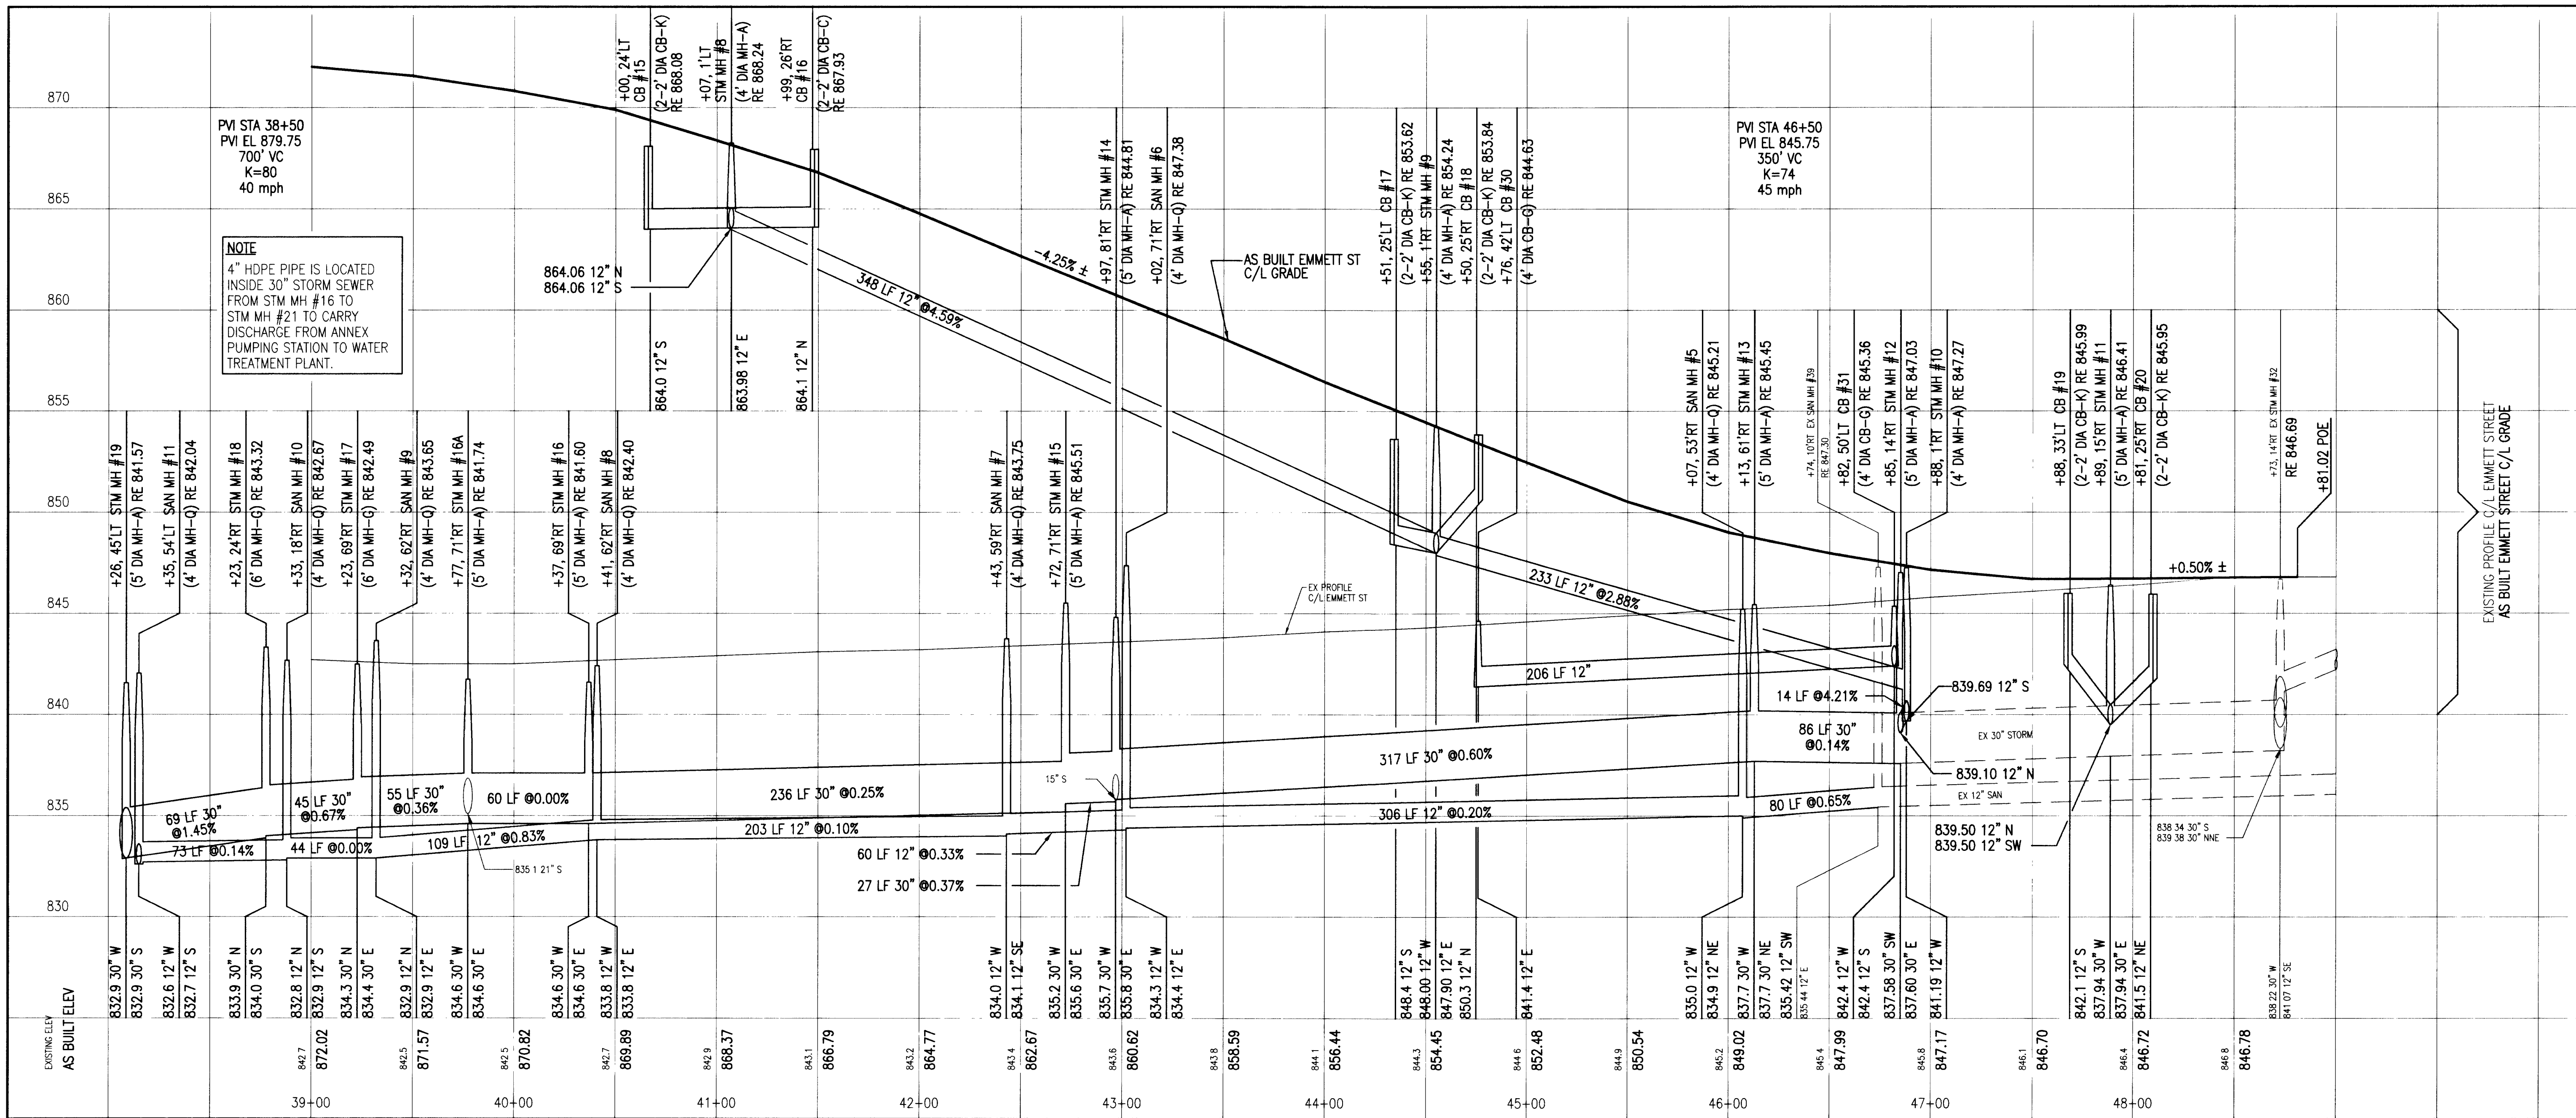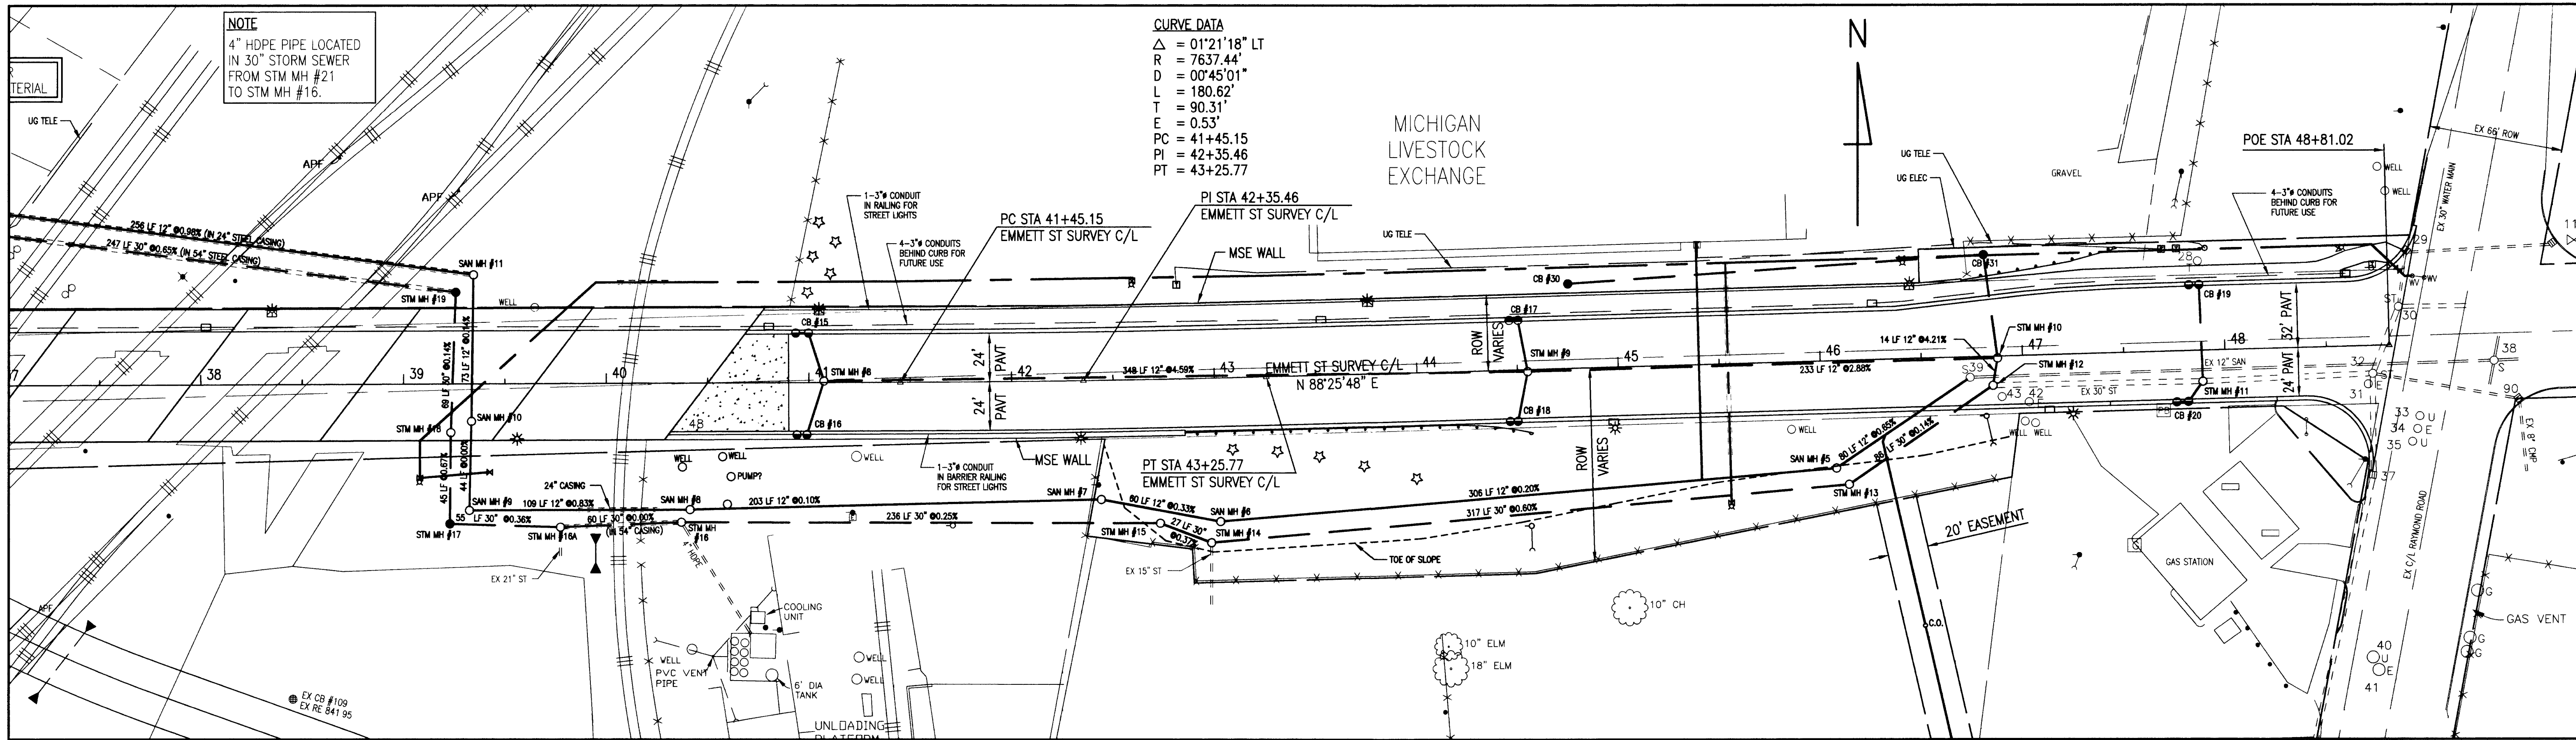

HH
HH ENGINEERING LTD.
220 BAGLEY AVE., SUITE 500, DETROIT, MICHIGAN 48226
(313) 963-6580

NO.	REVISIONS	BY	DATE



REVISED IN ACCORDANCE WITH CONSTRUCTION RECORDS

NO.	REVISIONS	BY	DATE

REVISED IN ACCORDANCE WITH CONSTRUCTION RECORDS

CITY OF BATTLE CREEK
MICHIGAN
EMMETT STREET OVERPASS
AS BUILT STA 39+00 TO P.O.E.

RECORDED BY: ALH/KBC DATE: 03/19/98
DRAWN BY: KBC DATE: 03/19/98
CHECKED BY: ALH DATE: 03/19/98
FILE: 601AB1
SCALE: 1" = 40' HORIZ.
1" = 4' VERT.
PROJECT: C9601
AB-5
SHEET NO.

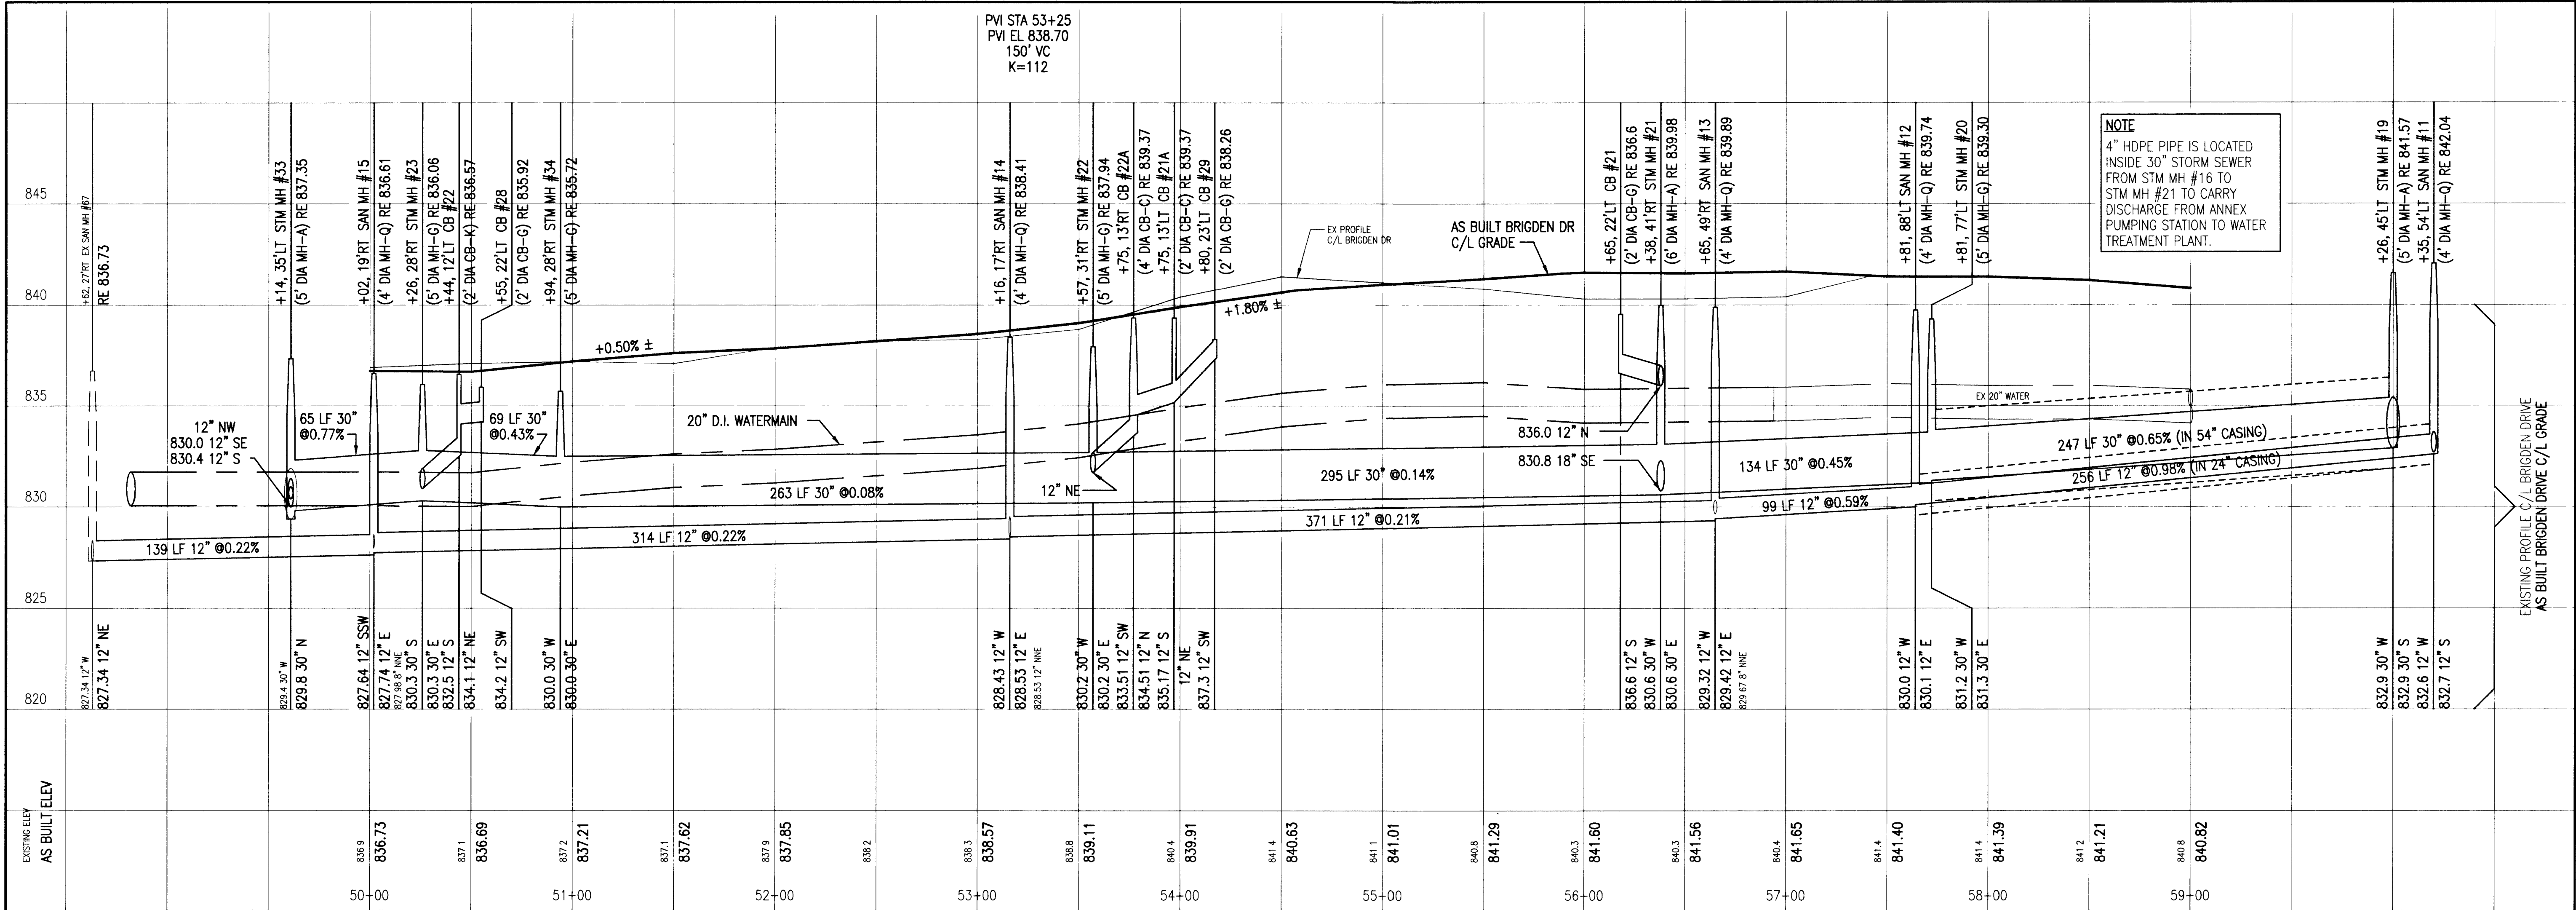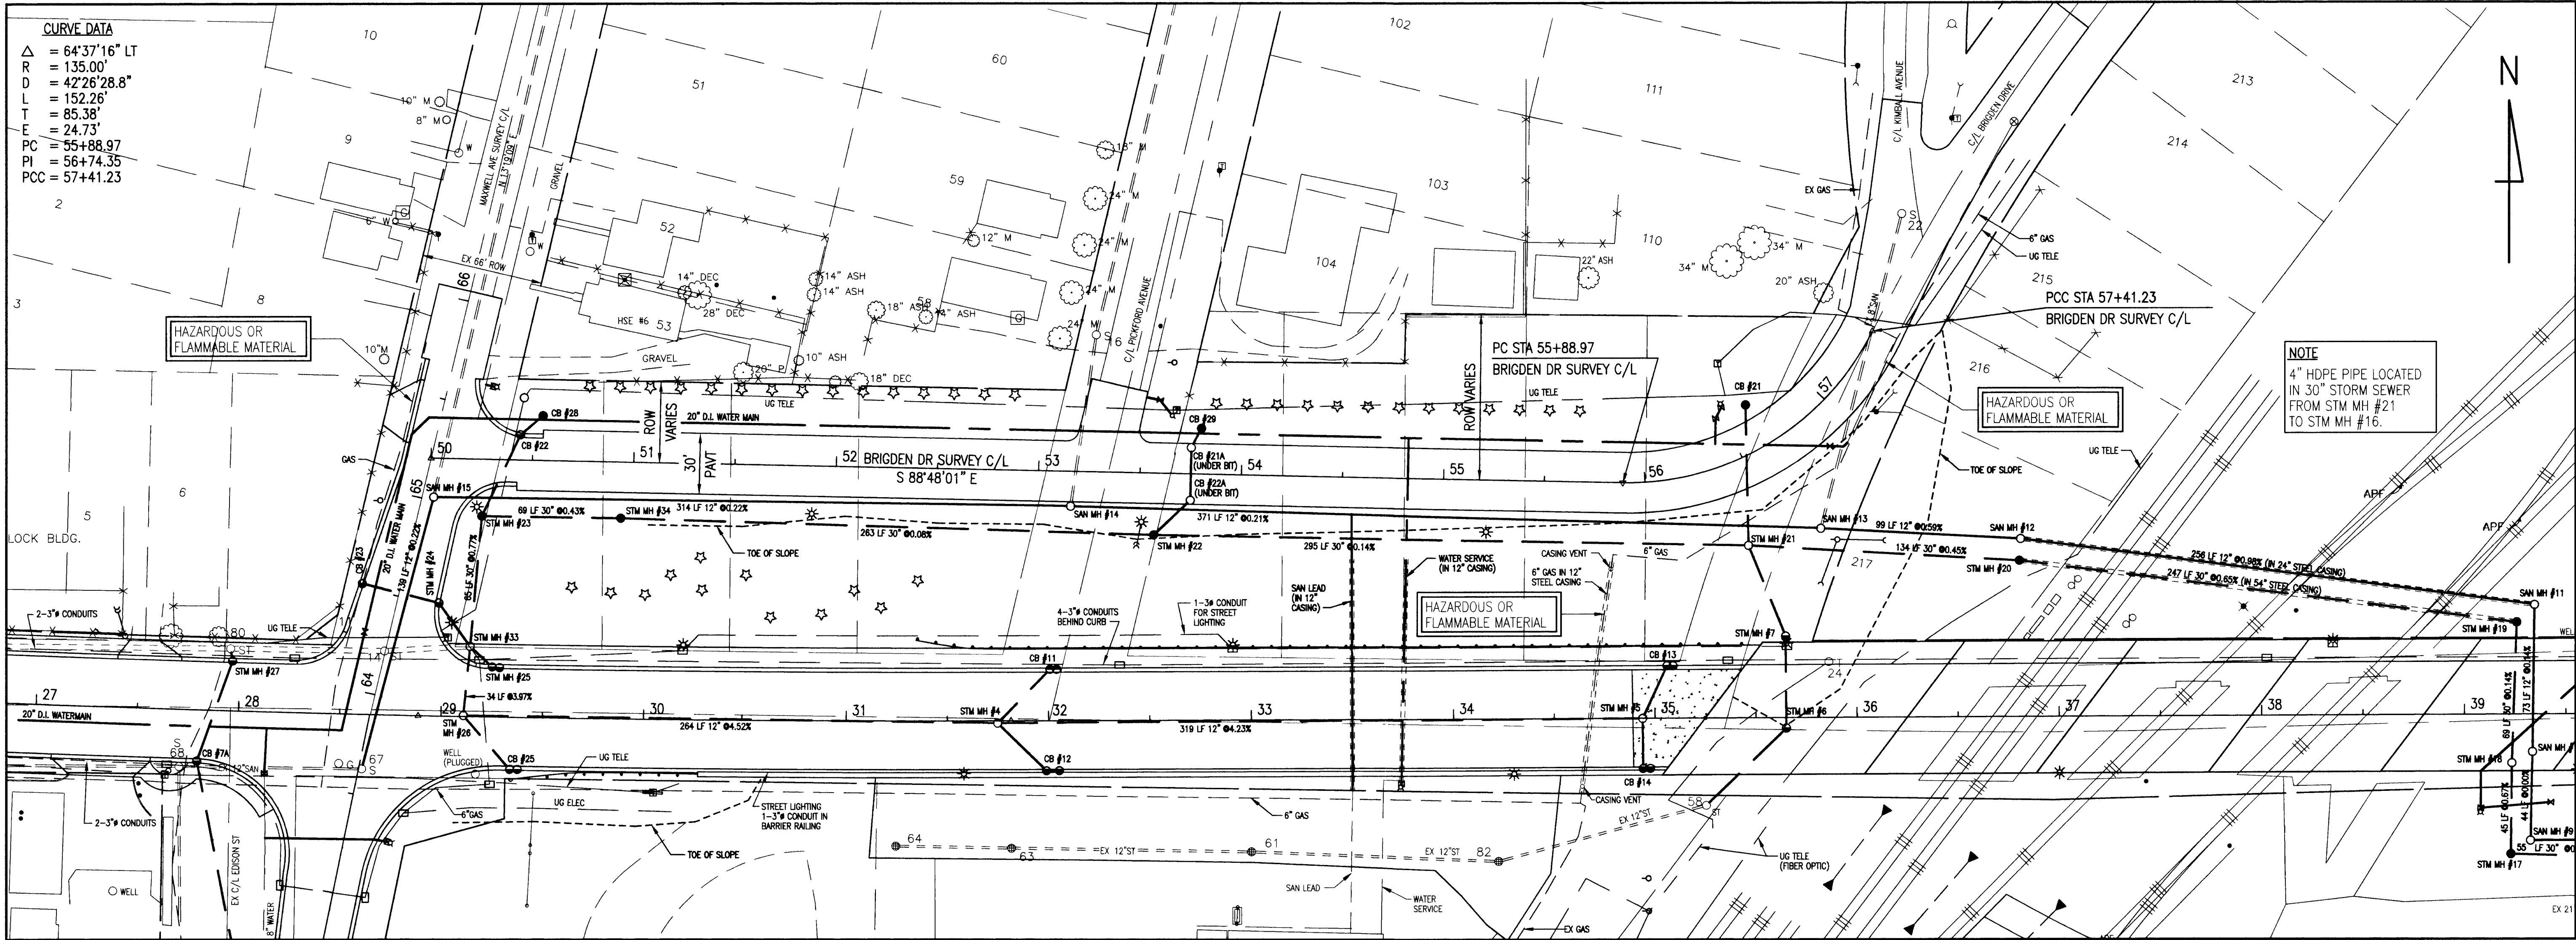

HH
HH ENGINEERING LTD.
SUITE 300, DETROIT, MICHIGAN 48226
(313) 963-8800

NO.	REVISIONS	BY	DATE

NO.	REVISIONS	BY	DATE

CITY OF BATTLE CREEK
MICHIGAN
EMMETT STREET OVERPASS
AS BUILT BRIGDEN DRIVE

RECORDED BY: ALH/KBC DATE: 03/19/98
DRAWN BY: KBC DATE: 03/19/98
CHECKED BY: ALH DATE: 03/19/98
FILE: 801AB1
SCALE: 1" = 40' HORIZ.
1" = 4' VERT.
DRAWING
PROJECT: C9801
AB-6
SHEET NO.