



Williams Communications

Japan Cable Landing Diverse Route

(Point Arena to Sacramento, California)

AFE 4875


Charles Seery, Project Manager
Gary Tabor, Project Construction Superintendent

Spread South 5

January – May 2001

REDLINES


Volume 2 of 2

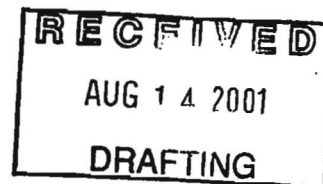

Williams Communications
Santa Rosa Construction Project Office
916 Shiloh Road, Building 1
Windsor, CA 95492
(707) 836-9414 FAX: (707) 836-9462

Spread South 5 (Highway 12) (Renegade)						
Sonoma, Napa & Solano Counties - Alignment Sheets 274-329, 347-411, 1-47 (CNRR)						
Item No	Alignment Sheet	From Station	To Station	GAPS (feet)	Crossing Identification	County
1.11	274 - 286 (sheets in meters)	00+00	41+35	13,563	Highway 116 (longitudinal) (including ten DFG xings: D-Petaluma River-B+A+C+D+E+F+G; D-Sears Point-5; D-Sonoma-3+2)	Sonoma (IRU)
1.11	286 - 329 (sheets in meters)	41+81	155+98	37,448	Highways 116 / 12 / 121 (including 11 DFG xings: D-Sears Point-4+2+2A+1+1A; D/R-Sears Points-3; D-Napa-A+D; D/R-Napa-B+C+E)	Sonoma
1.11	319 - 329 (sheets in meters)	155+98	194+38	12,595	Highways 12 / 121 (longitudinal)	Napa
1.11	347 - 349	636+61	650+98	1,437	Old Sonoma Road (longitudinal)	Napa
1.11	351 - 353	665+95	677+05	1,110	Old Sonoma Road (longitudinal)	Napa
1.11	354 - 355	678+96	686+76	780	Old Sonoma Road (longitudinal)	Napa
1.11	356 - 358	690+17	707+78	1,761	Old Sonoma Road (longitudinal)	Napa
1.11	361 - 362	725+08	727+35	227	Old Sonoma Road (longitudinal)	Napa
1.11	366 - 367	753+61	757+40	379	Old Sonoma Road (longitudinal)	Napa
1.11	371 - 374	784+09	803+57	1,948	Old Sonoma Road (longitudinal) (including DFG xings: D/R-Napa-F+G+H+1; D-Napa-J+K)	Napa
1.11	383 - 393	859+63	914+10	5,447	Foster Road (longitudinal)	Napa
1.11	396	933+72	939+77	605	(including DFG xing: D/R-Napa-11)	Napa
1.11	408 - 411	1002+30	1022+00	1,970	(longitudinal) and Napa River bore	Napa
1.11	1 - 35	1354+00	1765+00	41,100	CNRR (longitudinal) (including 17 DFG xings: D-Cuttings Wharf 3+1A+2A+A+H+G+F; D/R- Cuttings Wharf-3+4+B+E; D-Cordella-AA+A+C+CC; D/R-Cordella-B+D)	Napa
1.11	36 - 47	1765+00	1908+53	14,353	CNRR (longitudinal)	Solano
Duct - Total GAPS: (23.6 mi)				134,723		
DFG Crossings Remaining:				45		
Item # 1.11 - Duct - Total INSTALLED: (4.6 mi)				23,026	15% complete	
Length of spread by alignment sheets:				28.2 miles		

Spread South 6 (CNRR / UPRR) (Tidwell)						
Solano and Yolo Counties - Alignment Sheets 384 - 413 (CNRR) and 413 - 578 (UPRR)						
Item No	Alignment Sheet	From Station	To Station	GAPS (feet)	Crossing Identification	County
1.11	384-413	1596+66	1944+45	34,779	CNRR (longitudinal) (including ten DFG xings: D-Cordella-1, D-Fairfield South-1; D/R-Fairfield South- 2+3+4+4A+5+6+7+8)	Solano
1.11	413	1944+45	1944+60	15	UPRR (begin)	Solano
1.11	523	3257+06	3282+56	2,550	South Fork Putah Creek	Solano
1.11	527	3318+90	3327+95	905	I-80 overpass (City of Davis)	Solano
1.11	543	3508+95	3514+95	600	Mace Blvd	Yolo
1.11	556-567	3643+70	3782+25	13,855	Yolo Bypass	Yolo
1.11	576-578	3882+00	3914+65	3,265	UPRR (longitudinal) to Stillwater Rd in Sacramento	Yolo
Duct - Total GAPS: (10.6 mi)				55,969		
DFG Crossings Remaining:				10		
Duct - Total INSTALLED: (33.3 mi)				175,996	75% complete	
Level 3 Joint Build (1668+45 to 1717+50):				4,905	100% complete	
Fiber - Total INSTALLED: (3.3 mi)						
481 - 496				2766+70 2943+15 17,845	7% complete	
Length of spread by alignment sheets:				43.9 miles		

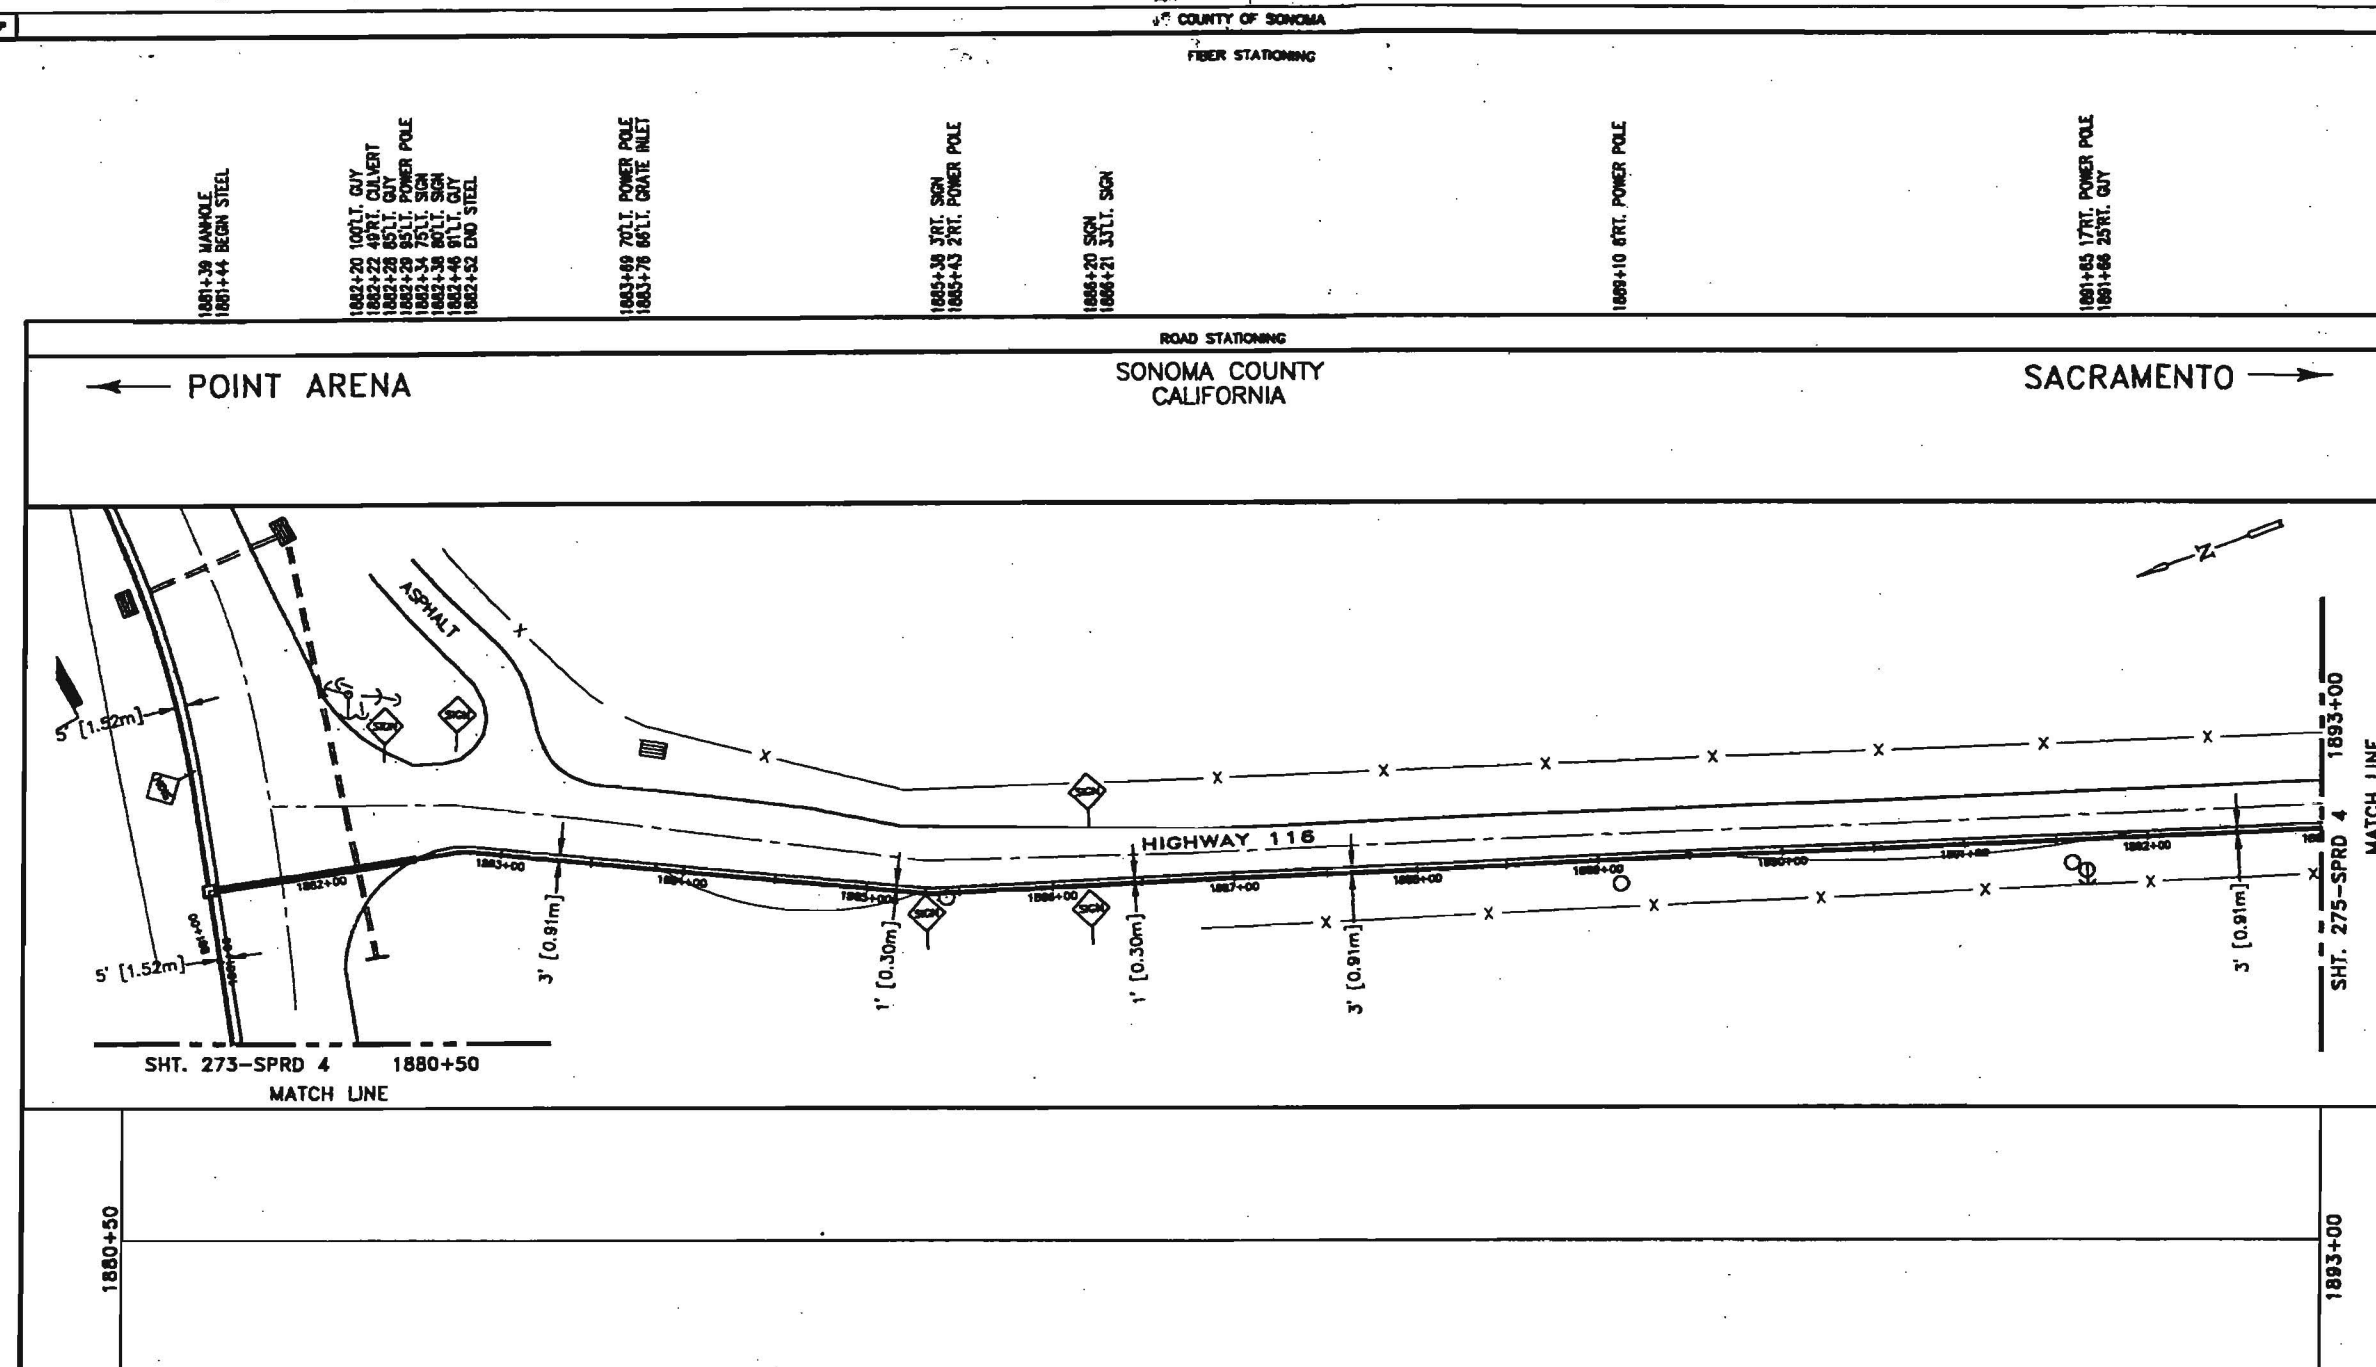


LEGEND

	Interstate Hwy.		Region Site
	U.S. Hwy.		P.O.P./Jct.
	State Hwy.		Manhole Splice
	County Road		Manhole
	RR Mile Mr.		Manhole Splice
	Min. Road Sign		Manhole
	New Fiber Cable		Manhole
	Telephone Line		Water Valve / Meter
	City Limits		Gas Valve / Meter
	R/W Line		Signal Pole
	River/Stream		Fire Hydrant
	Cl. Road		Gas Marker
	Cl. RR Tracks		Gas Marker
	Fence		Fiber Marker
	Oil Pipeline		Water Inlet
	Gas Pipeline		
	Power Line		
	Water Line		
	Sew. Sewer		
	Storm Drain		
	Telephone Line		
	Black Iron Pipe		
	Galvanized Iron Pipe		
	CP		
	Edge of Pavement		
	Edge of Ground		
	Edge of Curb		
	FL		
	Fog Line and/or White Line		

DRAWING DISCLAIMER

FACILITY LOCATIONS ARE GENERAL IN NATURE
WILLIAMS WILL NOT BE HELD ACCOUNTABLE FOR
THE ACCURACY OF THE INFORMATION PROVIDED
ON THESE DRAWINGS.

CABLE FIBER COUNT MFD. TYPE OF GLASS	CABLE DESCRIPTION
CABLE REEL NO.	
SPACE TO SPECIFY CABLE LENGTH & CBL. LENGTH	
BEND RADIUS & TYPE (CORE/SMOOTH/COLOR)	PIPE & BOLDFRAME PLACEMENT
STEEL PIPE SIZE	
PVC	
FUTURE-2	FUTURE UNITS PLACE
FUTURE-3	
FUTURE-4	

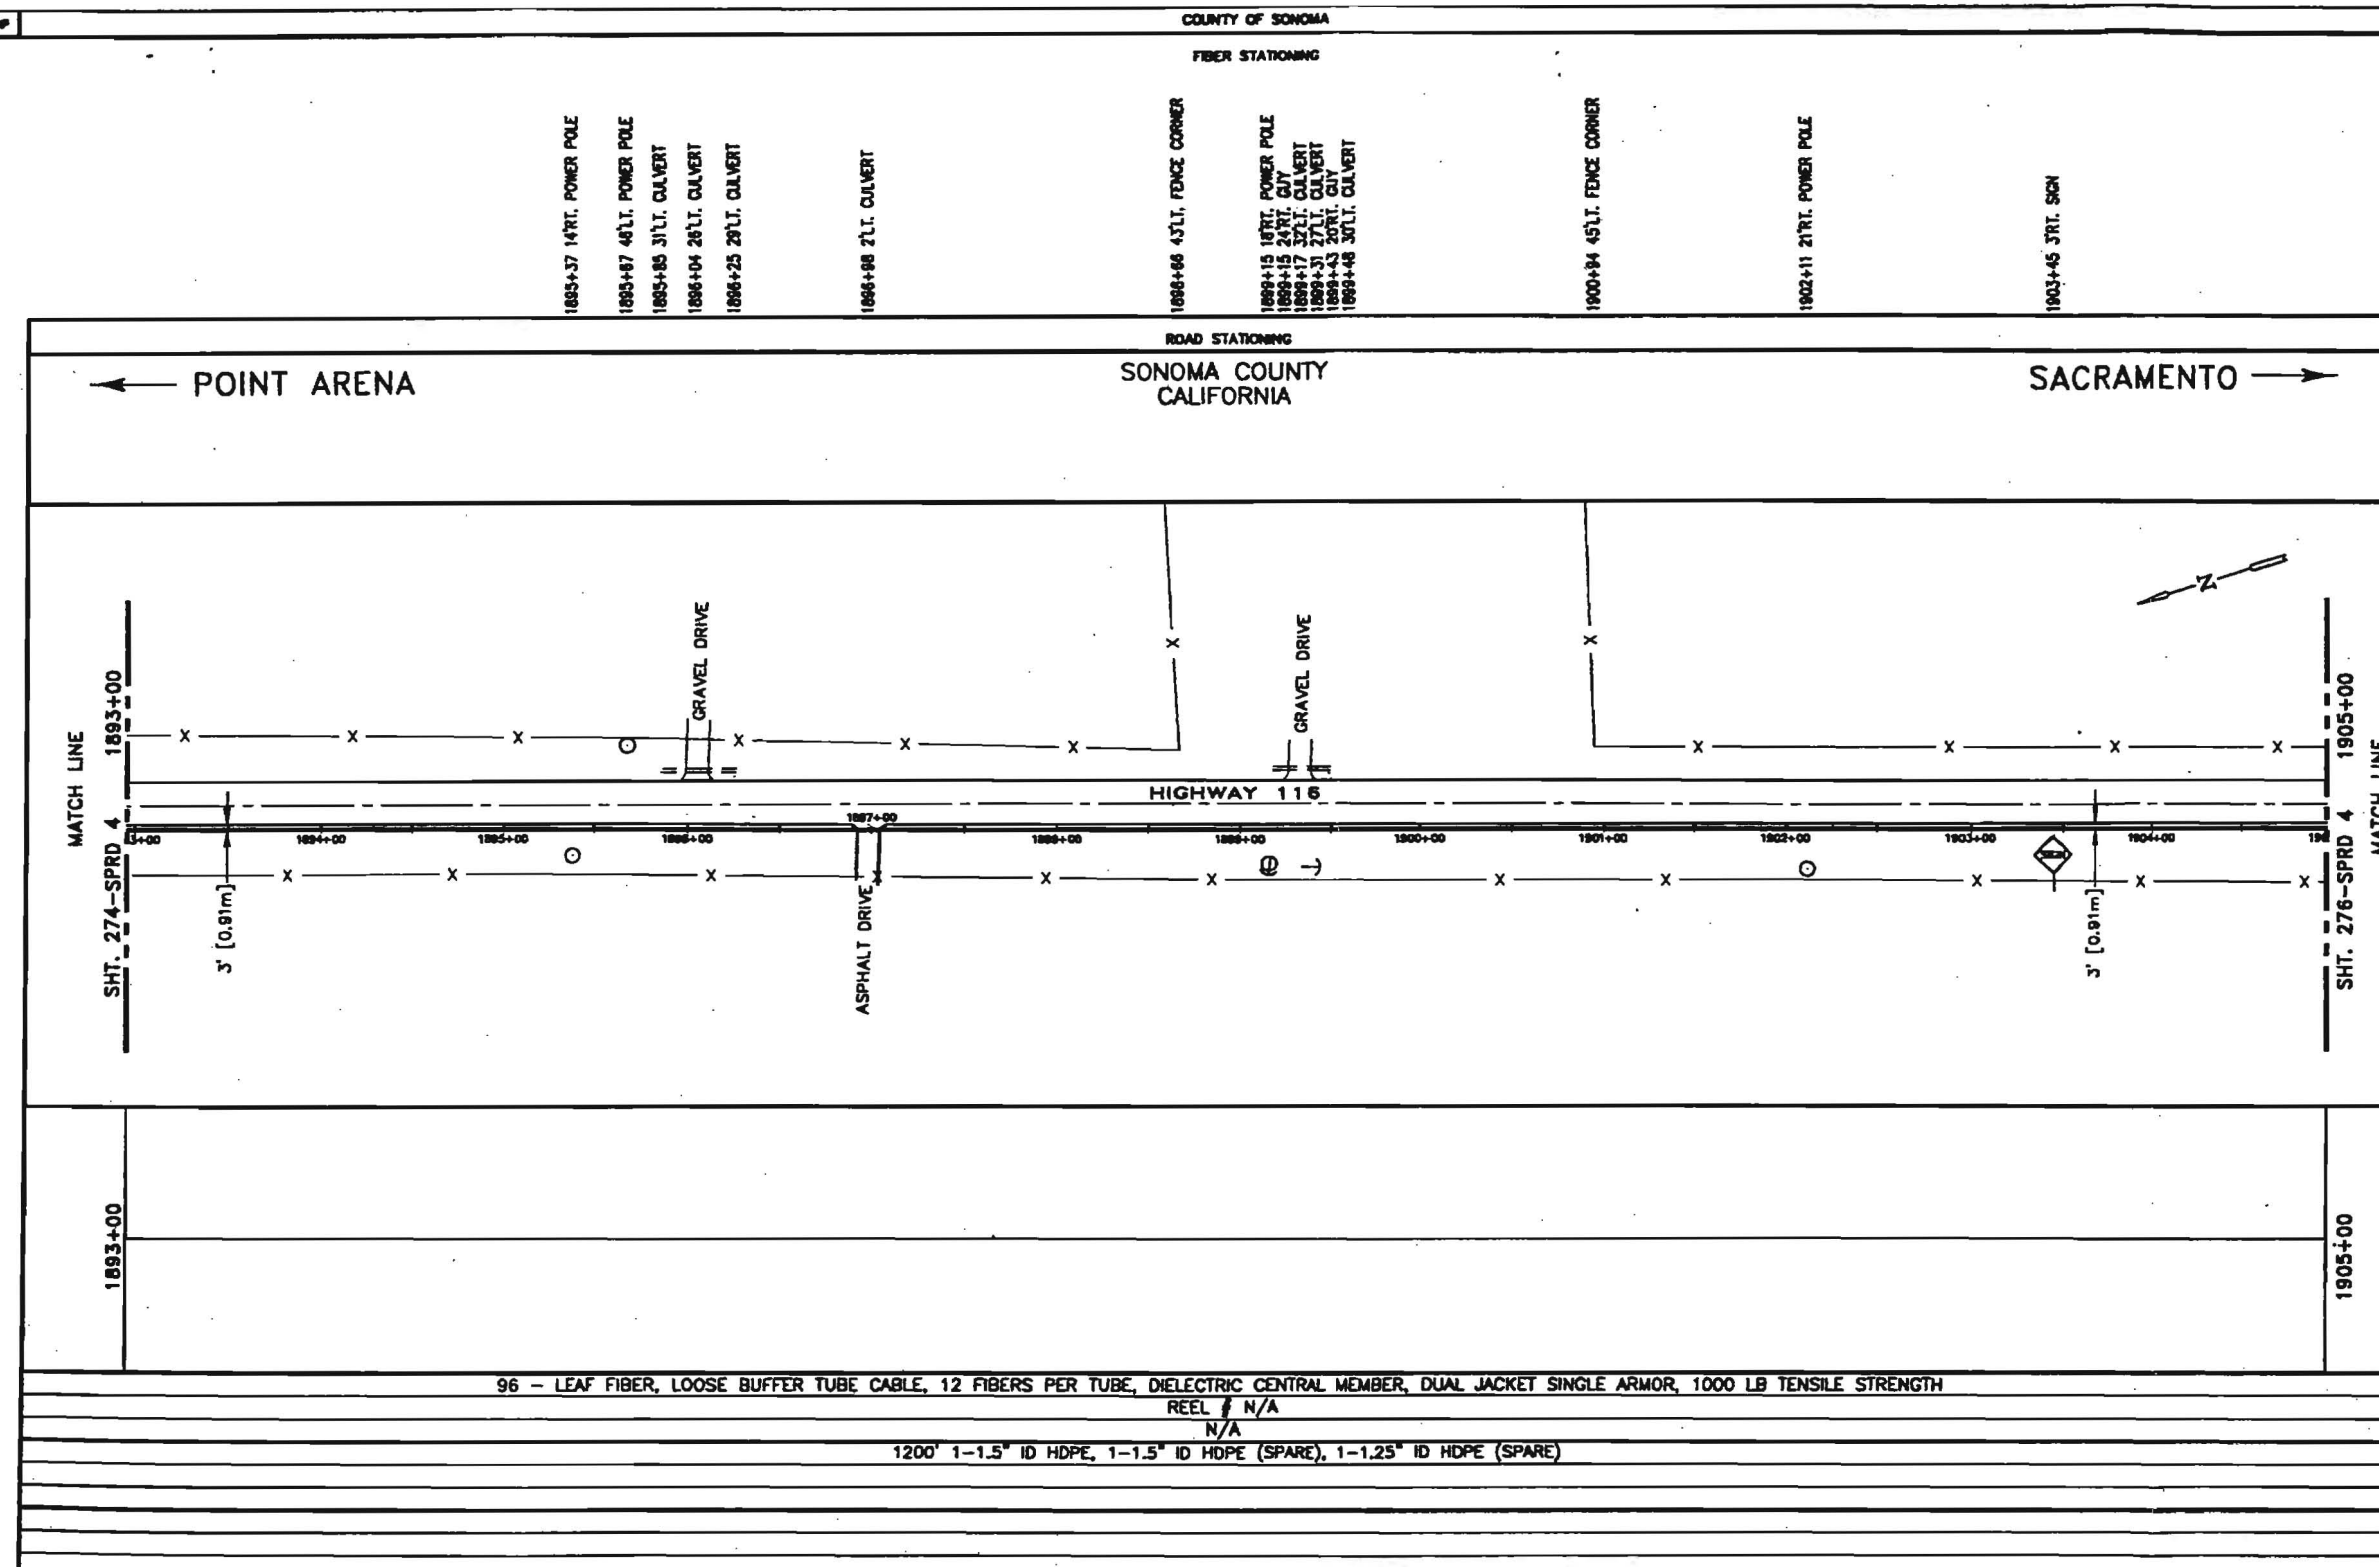

LEGEND

	Interstate Hwy.		Rugby Site
	U.S. Hwy.		P.O.P./Int.
	State Hwy.		Handtruck Spill
	County Road		Handtruck
	RR Mile Mkr.		Handtruck Spill
	Mile. Road Sign		Handtruck
	New Fiber Cable		SS Handtruck
	Telephone Line		Power Pole
	City Limits		Water Valve / M
	R/W Line		Gas Valve / M
	River/Stream		Signal Pole
	CL Road		Fire Hydrant
	CL RR Tracks		Gas Marker
	Fence		Oil Marker
	Oil Pipeline		Fiber Marker
	Gas Pipeline		Water Intake
	Power Line		
	San. Sewer		
	Storm Drain		
	Telephone Line		
	Black Iron Pipe		
	Galvanized Iron Pipe		
	Edge of Pavement		
	Edge of Ground		
	Face of Curb		
	Foot Walk and/or Walk Line		

WILLIAMS
EMERGENCY NOTIFICATION NUMBER
1-800-562-9069

CAUTION

**WILLIAMS LOCATE # FOR
COUNTY, STATE
1-888-845-2255**

**FOREIGN UTILITY LOCATIONS ARE
APPROXIMATE, CONTACT THE LOCAL ONE
CALL AGENCY 48 HOURS PRIOR
TO CONSTRUCTION FOR EXACT
UTILITY LOCATIONS AT :**

1-800-227-2600

DRAWING DISCLAIMER

FACILITY LOCATIONS ARE GENERAL IN NATURE. WILLIAMS WILL NOT BE HELD ACCOUNTABLE FOR THE ACCURACY OF THE INFORMATION PROVIDED ON THESE DRAWINGS.

CONSTRUCTION


[illegible]

CABLE FIBER COUNT MFG. TYPE OF GLASS	CABLE SECTION
CABLE REEL NO.	
SPLICE TO SPLICE CABLE LENGTH & COIL LENGTH	PIPE & HOUSING PLACEMENT
BONDING & TYPE (CONDUCTIVITY/COLOR)	
STEEL PIPE SIZE	FUTURE MARKING PLACEMENT
PVC	
FUTURE-2	
FUTURE-3	

HYUNDAI COMMUNICATIONS GROUP
Network Services

POINT ARENA TO SACRAMENT
CABLE ROUTE

DESIGN BY :	B&V	DATE :	03/10/80
CHECKED BY :	B&V	DATE :	03/10/80
APPROVED BY :		DATE :	
APPROVED BY :		DATE :	
AFE : 4113		LOC. CODE :	
HORIZONTAL SCALE (DWS & PROF) : 1"=100'			
VERTICAL SCALE (DWS) :			
VERTICAL SCALE (PROF) :			
MAP PROJECTION :			
DRAWING NUMBER : SACR-275-SPRD			

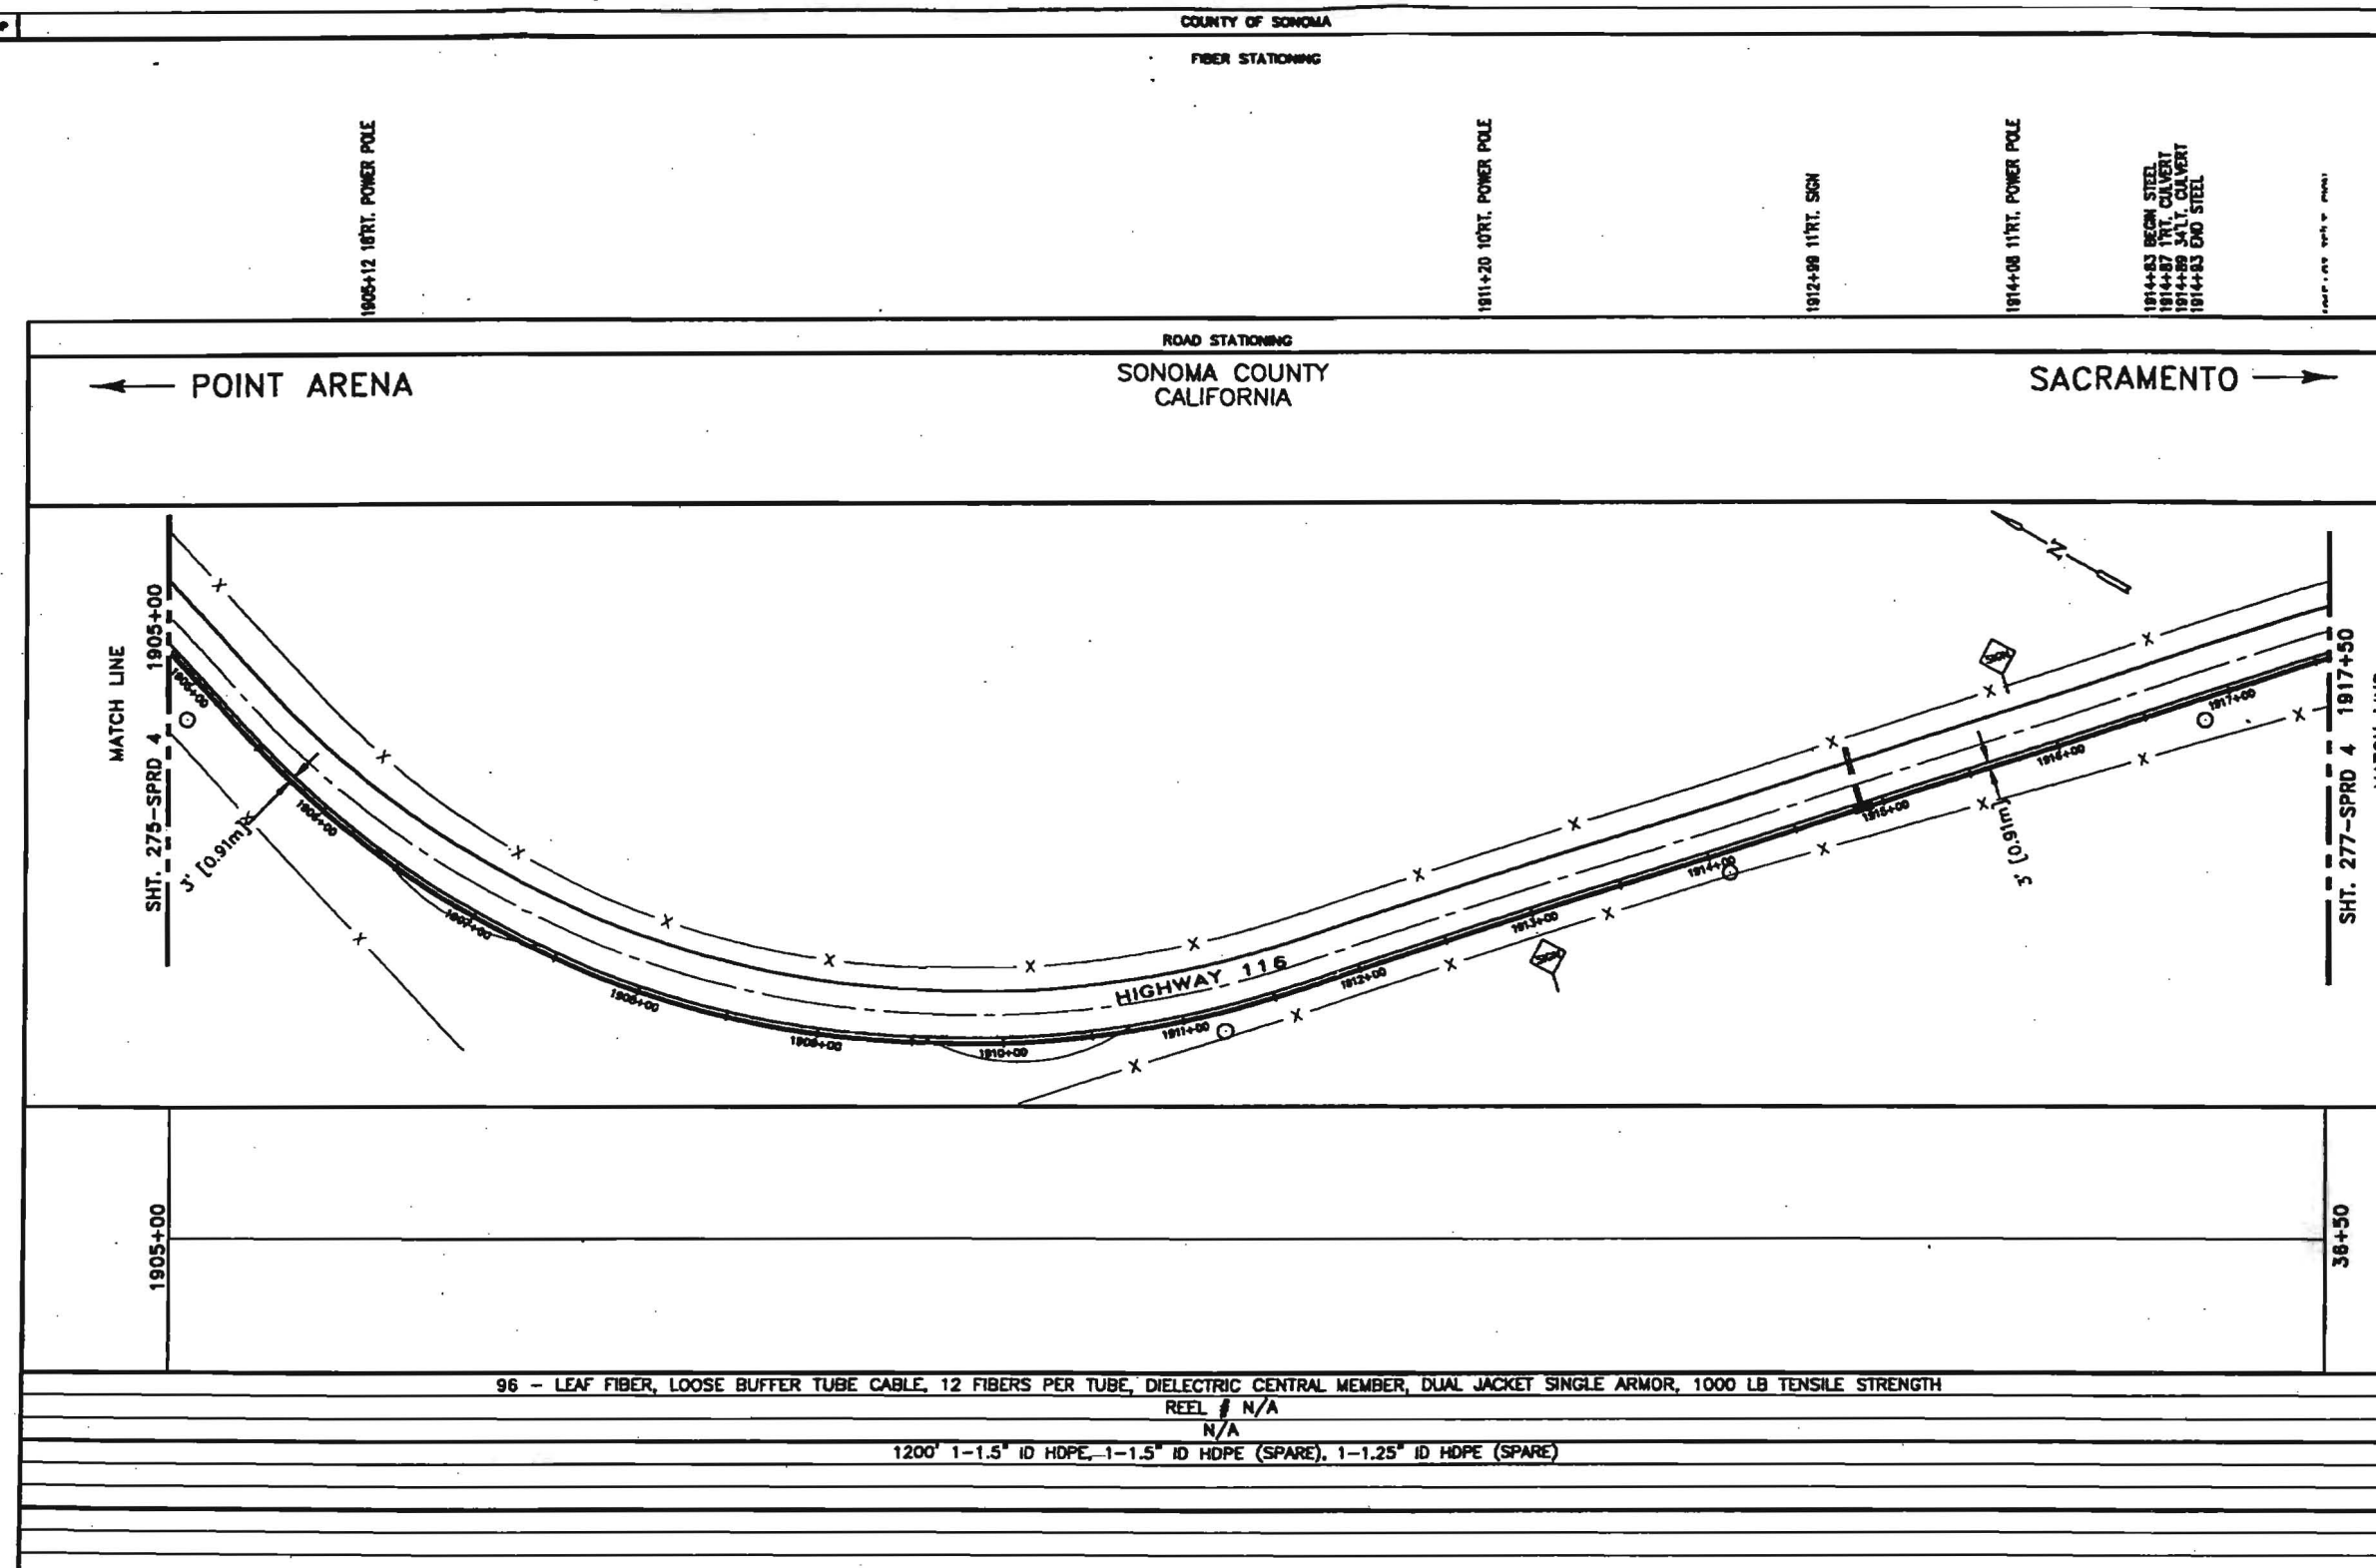

LEGEND

	Interstate Hwy.		Rogue Site
	U.S. Hwy.		P.O.P./Jct.
	State Hwy.		Manhole Splice
	Countryside Hwy.		Manhole
	NH Mile Mar.		Manhole Splice
	Misc. Road Sign		Manhole
	New Fiber Cable		SS Manhole
	Township Line		Pumper Pole
	City Limits		Water Valve / Meter
	R/W Line		Gas Valve / Meter
	River/Stream		Signal Pole
	CL Road		Fire Hydrant
	CL RR Tracks		Gas Marker
	Fence		Oil Marker
	Oil Pipeline		Oil Marker
	Gas Pipeline		Fiber Marker
	Power Line		Fiber Marker
	Water Line		Fiber Marker
	Sewer, Sewer		Fiber Marker
	Storm Drain		Fiber Marker
	Telephone Line		Water Inlet
B.L.F.	Black Iron Pipe		
G.L.F.	Galvanized Iron Pipe		
SP	Edge of Pavement		
EG	Edge of Gravel		
FC	Edge of Curb		
FL	Fog Line and/or White Line		

WILLIAMS
EMERGENCY NOTIFICATION NUMBER
1-800-582-9068

CAUTION
WILLIAMS LOCATE # FOR
COUNTY, STATE
1-888-945-2255

FOREIGN UTILITY LOCATIONS ARE
APPROXIMATE. CONTACT THE LOCAL ONE
CALL AGENCY 48 HOURS PRIOR
TO CONSTRUCTION FOR EXACT
UTILITY LOCATIONS AT :
1-800-227-2600

DRAWING DISCLAIMER

FACILITY LOCATIONS ARE GENERAL IN NATURE
WILLIAMS WILL NOT BE HELD ACCOUNTABLE FOR
THE ACCURACY OF THE INFORMATION PROVIDED
ON THESE DRAWINGS.

CONSTRUCTION

[illegible]


CABLE FEED CODES MFR. TYPE OF GLASS	CABLE SECTION NO.
CABLE SERIAL NO.	
SPACE TO SPACE CABLE LENGTH & COIL LENGTH	PIPE & HANGERS PLACEMENT
UNDERBENT & TYPE (COARSE/SMOOTH/COLOR)	
STEEL PIPE SIZE	FUTURE USE PLACE
PVC	
FUTURE-2	
FUTURE-3	
FUTURE-4	



COMMUNICATIONS GROUP
Network Services

POINT ARENA TO SACRAMENTO
CABLE ROUTE

DESIGNED BY :	B&V	DATE :	03/19/00
CHECKED BY :	B&V	DATE :	03/19/00
APPROVED BY :		DATE :	
APPROVED BY :		DATE :	
AFE : 4113	LOC. CODE :		
HORIZONTAL SCALE (HWS & HPS) : 1"=100'			
VERTICAL SCALE (VWS) :			
VERTICAL SCALE (VPS) :			
MAP PROJECTION :			
DRAWING NUMBER : SACR-276-SPRD			

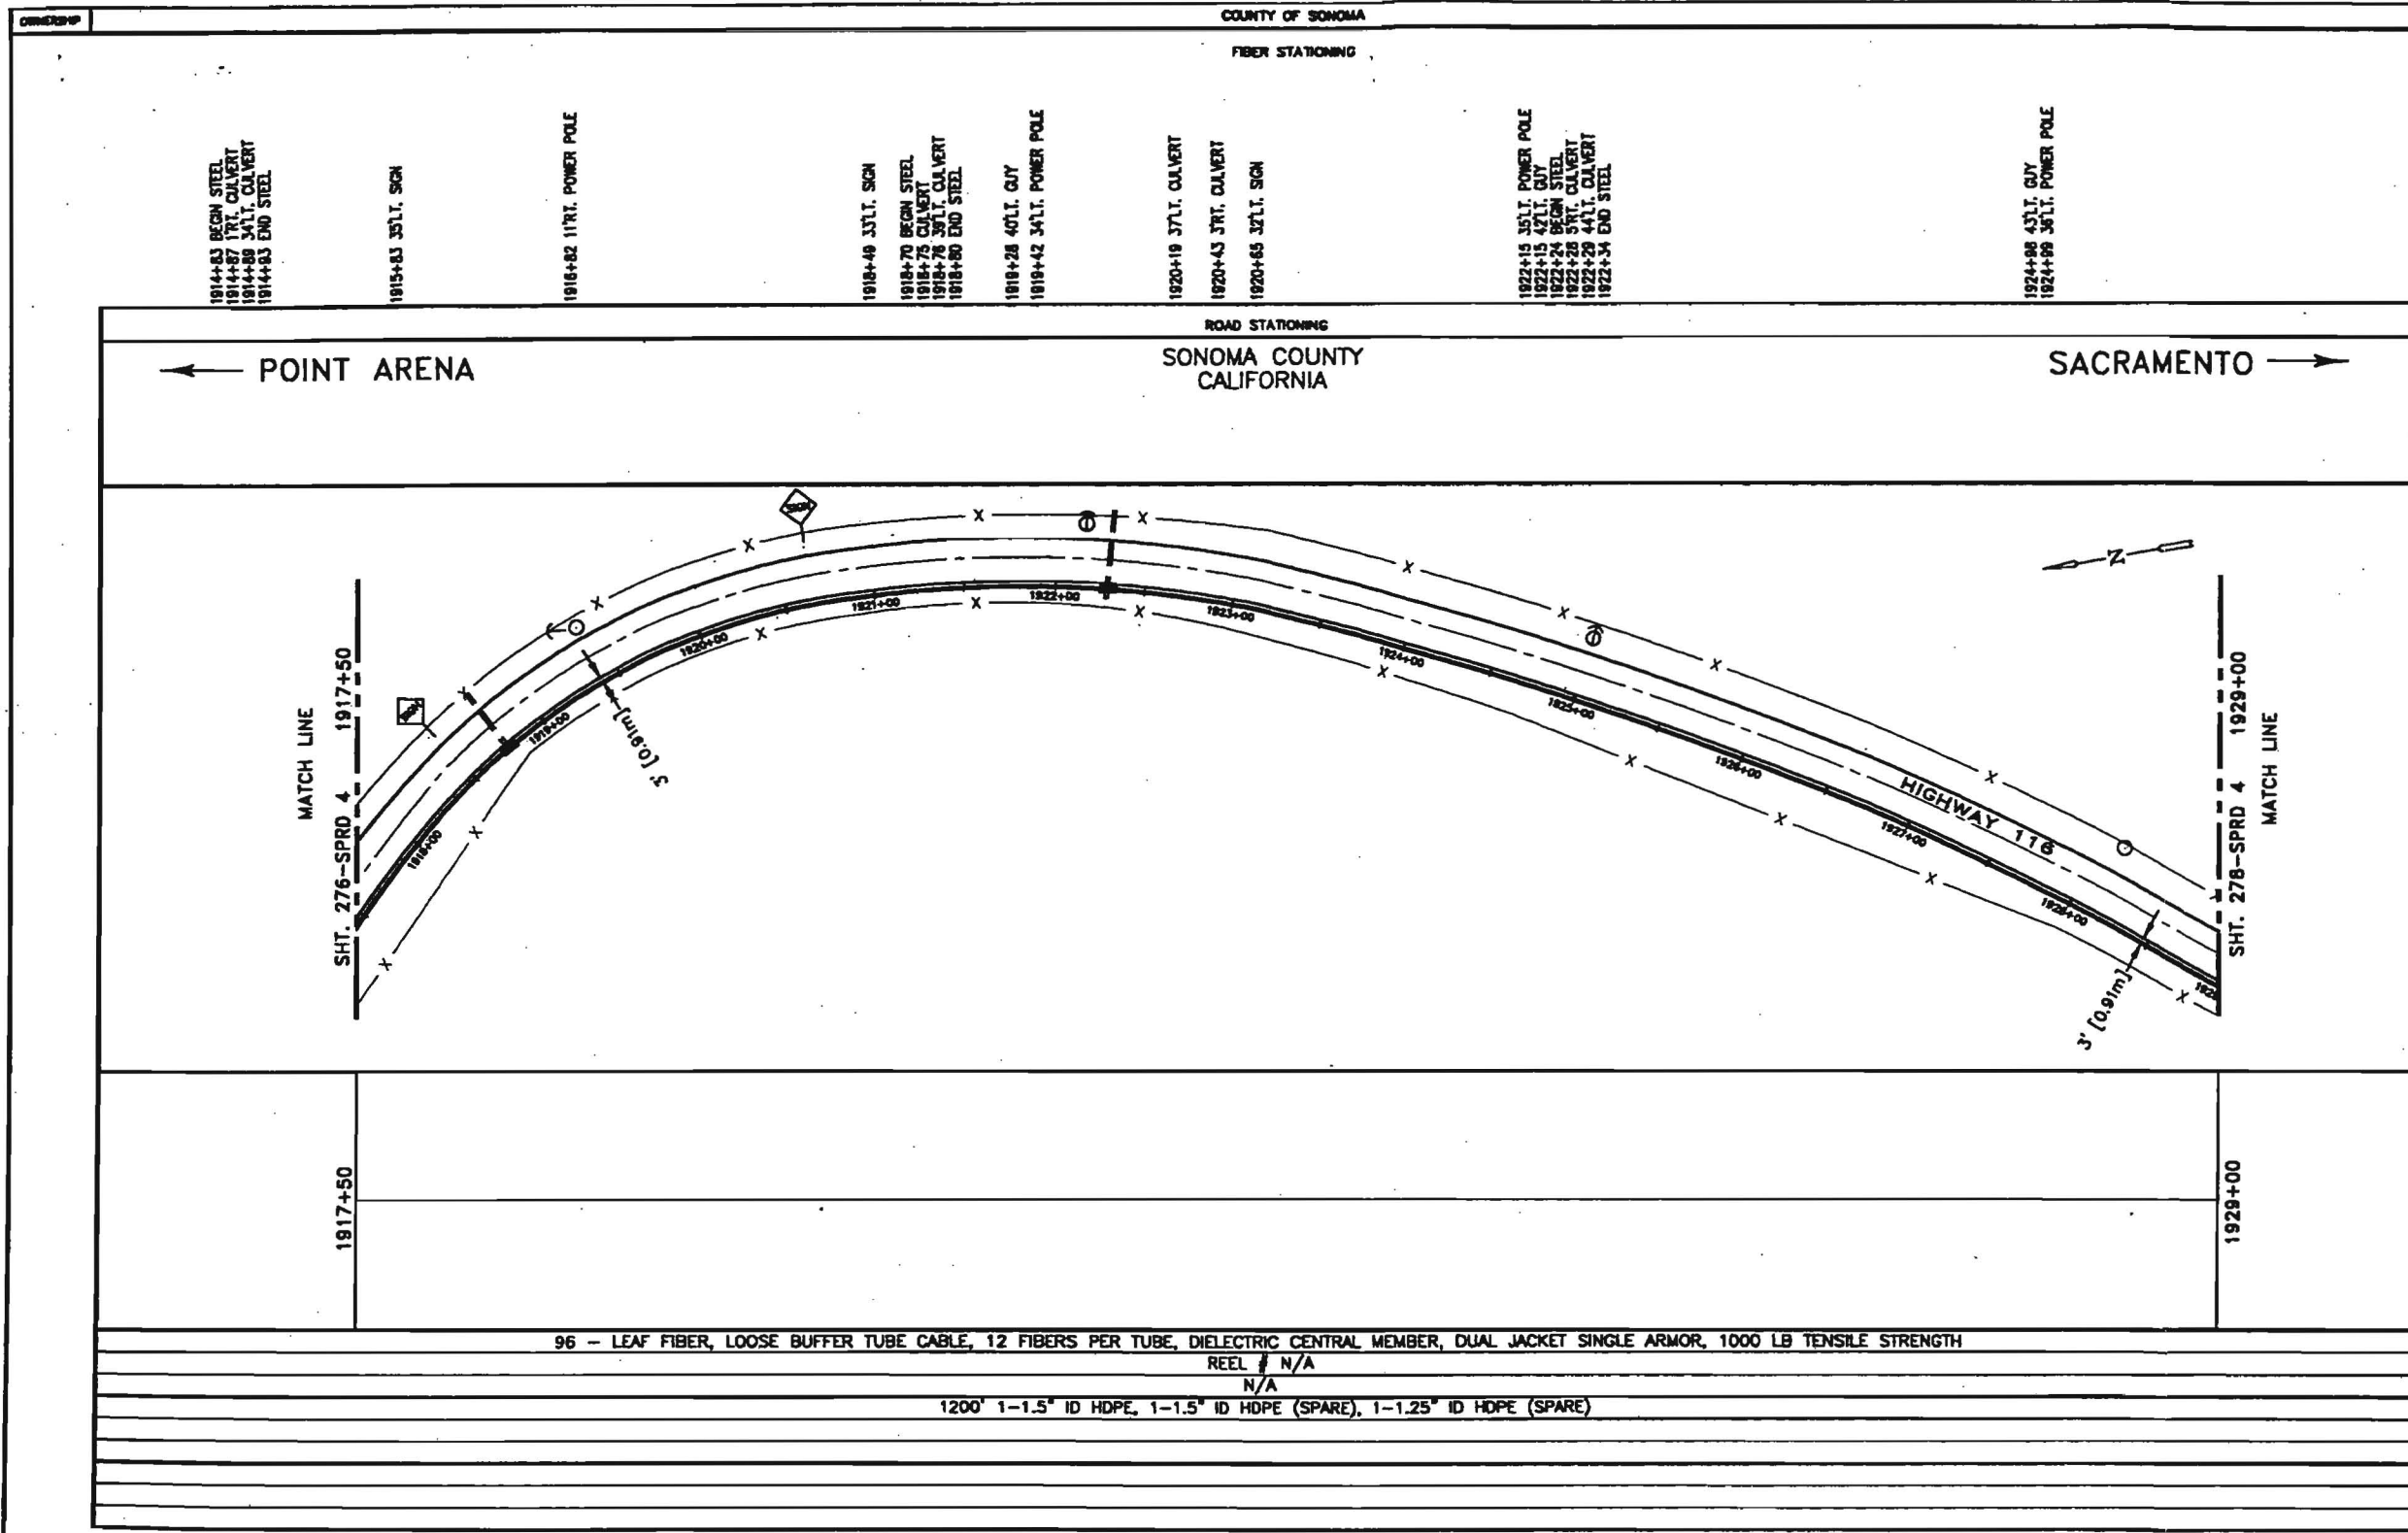

LEGEND

Interstate Hwy.	Range Site
U.S. Hwy.	P.O.P./Jct.
State Hwy.	Handhole Splice
County Road	Handhole Splice
RR Mile Mr.	Handhole
Min. Road Sign	SS Handhole
New Fiber Cable	Power Pole
Township Line	Water Valve / Water
City Limits	Gas Valve / Water
R/W Line	Signal Pole
River/Stream	Fire Hydrant
CL Road	Gas Marker
CL RR Tracks	Oil Marker
Fence	Fiber Marker
Oil Pipeline	Water Inlet
Gas Pipeline	
Power Line	
Water Line	
Sewer	
Storm Drain	
Telephone Line	
Black Iron Pipe	
Galvanized Iron Pipe	
Edge of Pavement	
Edge of Driveway	
Face of Curb	
Fog Line and/or White Line	

WILLIAMS

EMERGENCY NOTIFICATION NUMBER
1-800-582-9069

CAUTION

WILLIAMS LOCATE # FOR
COUNTY, STATE
1-888-945-2255

FOREIGN UTILITY LOCATIONS ARE
APPROXIMATE. CONTACT THE LOCAL ONE
CALL AGENCY 48 HOURS PRIOR
TO CONSTRUCTION FOR EXACT
UTILITY LOCATIONS AT :
1-800-227-2600

DRAWING DISCLAIMER

FACILITY LOCATIONS ARE GENERAL IN NATURE
WILLIAMS WILL NOT BE HELD ACCOUNTABLE FOR
THE ACCURACY OF THE INFORMATION PROVIDED
ON THESE DRAWINGS.

CONSTRUCTION


REV. NO.	DESCRIPTION	BY	DATE
1	COMPLETE DRAWING CHANGES	SDJ	3/27
2	REVISED RUNNING LINE	MW	5/16

CABLE FIBER COUNT MPD TYPE OF GLASS	CABLE
CABLE REEL NO.	DESCRIPTION
SPLICE TO SPLICE CABLE LENGTH & COIL LENGTH	
CONDUIT & TYPE (CONG/SMOOTH/COLOR)	PIPE
STEEL PIPE SIZE	CONDUIT
PVC	PLACEMENT
FUTURE-2	FUTURE
FUTURE-3	UNIT
FUTURE-4	PLACE

COMMUNICATIONS GROUP
Network Services

**POINT ARENA TO SACRAMENTO
CABLE ROUTE**

DESIGNED BY : B&V DATE : 03/18/00
CHECKED BY : B&V DATE : 03/18/00
APPROVED BY : DATE :
DATE : 4113 LOC. CODE :
HORIZONTAL SCALE (PLAN & PROF) : 1"=100'
VERTICAL SCALE (PLAN) :
VERTICAL SCALE (PROF) :
MAP PROJECTION :
DRAWING NUMBER : SACR-277-SPRD 4

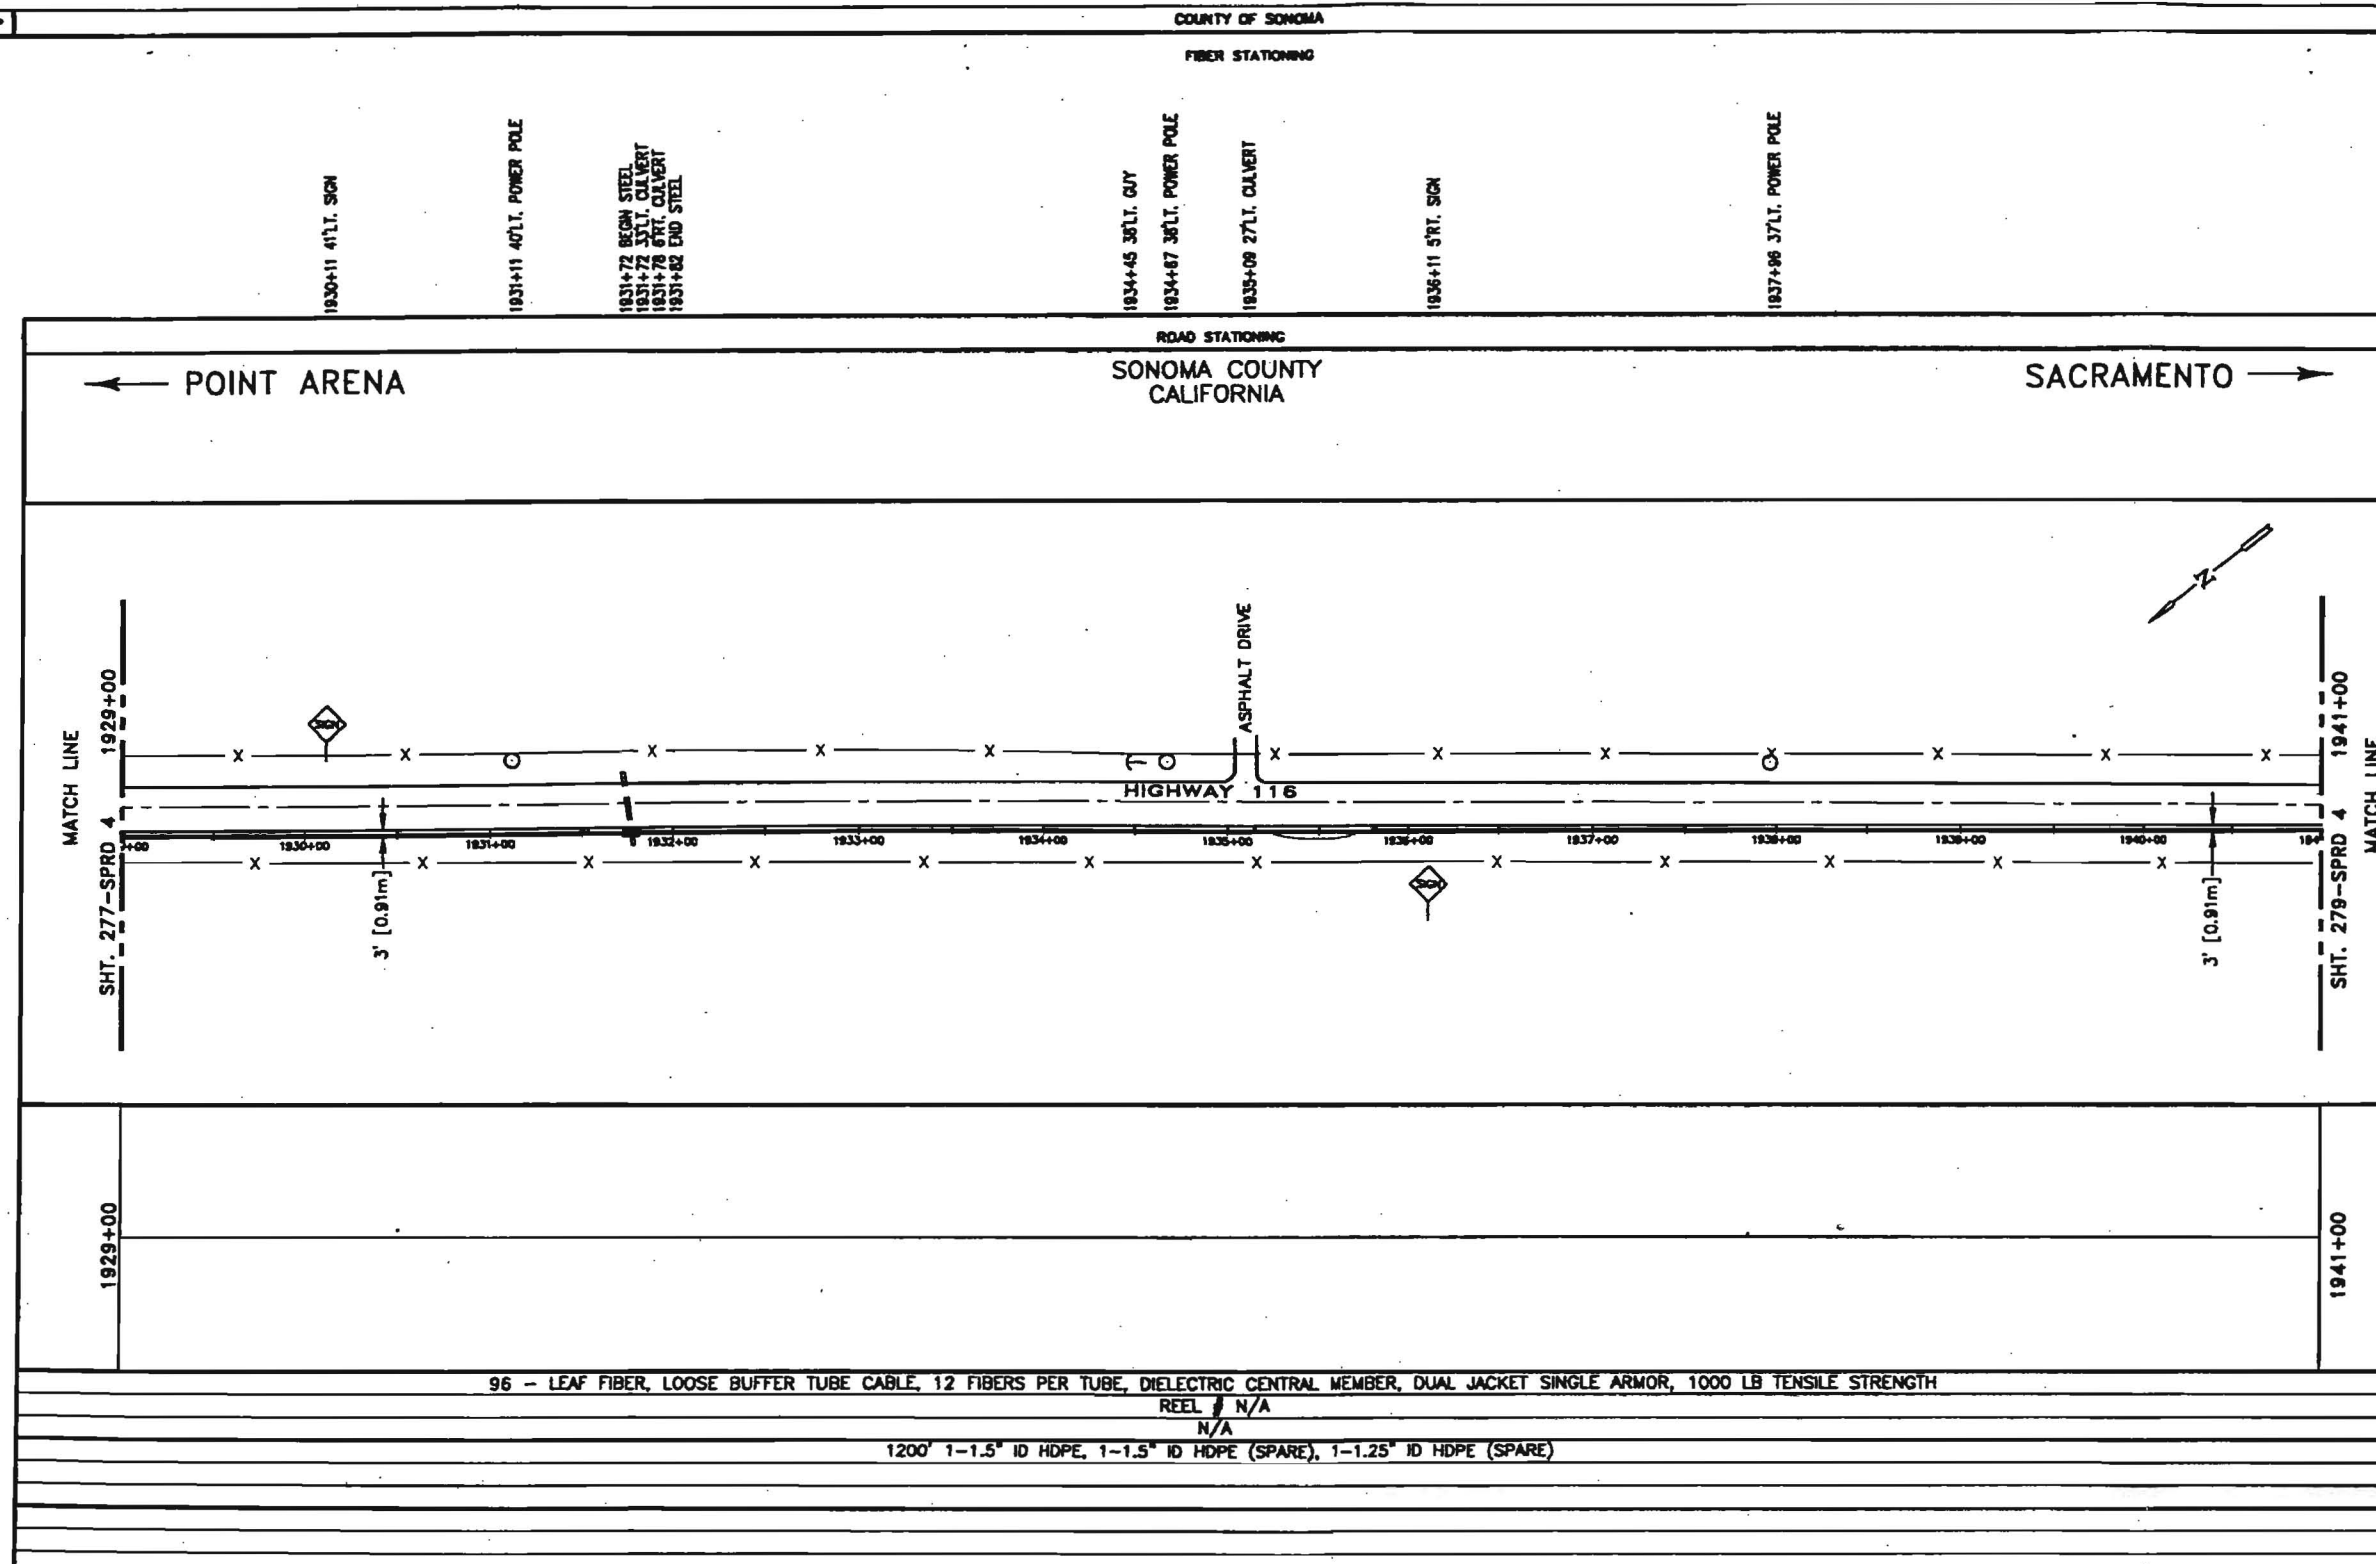

LEGEND

(66)	Interstate Hwy.	[X]	Region Site
(289)	U.S. Hwy.	[P.O.P./Jct.]	P.O.P./Jct.
(11)	State Hwy.	(S)	Manhole Symbols
(12)	Courty Road	(H)	Manhole
(7)	R/R Mile Mar.	(M)	Manhole Symbols
(diamond)	Misc. Road Sign	(N)	Manhole
—	New Fiber Cable	(SS)	Manhole
—	Telephone Line	X	Pump Pits
—	City Limits	(V)	Water Valve / Hy.
—	R/W Line	(G)	Gas Valve / Meter
—	River/Stream	(S)	Signal Pole
—	CL Road	(circle with cross)	Fire Hydrant
—	CL R/R Tracks	(vertical oval)	Gas Marker
—	Fence	(vertical oval)	Oil Marker
—	Oil Pipeline	(rectangle)	Fiber Marker
—	Gas Pipeline	[W.I.]	Water Inlet
—	Power Line		
—	Water Line		
—	Sewer		
—	Shore Drain		
—	Telephone Line		
B.L.P.	Blank Iron Pipe		
G.P.	Galvanized Iron Pipe		
E.P.	Edge of Pavement		
EG	Edge of Ground		
FC	Fans of Curbs		
R.	Fee Lines and/or Waste Line		

WILLIAMS
EMERGENCY NOTIFICATION NUMBER
1-800-582-9069

CAUTION

**WILLIAMS LOCATE & FOR
COUNTY, STATE
1-800-945-2255**

**FOREIGN UTILITY LOCATIONS ARE
APPROXIMATE. CONTACT THE LOCAL ONE
CALL AGENCY 48 HOURS PRIOR
TO CONSTRUCTION FOR EXACT
UTILITY LOCATIONS AT :**

1-800-227-2600

DRAWING DISCLAIMER

FACILITY LOCATIONS ARE GENERAL IN NATURE
WILLIAMS WILL NOT BE HELD ACCOUNTABLE FOR
THE ACCURACY OF THE INFORMATION PROVIDED
ON THESE DRAWINGS.

CONSTRUCTION


[illegible]

CABLE FIBER COUNT MFG. TYPE OF GLASS	CABLE DESIGNATION
CABLE REEL NO.	
SPACE TO SPACE CABLE LENGTH & COIL LENGTH	
INSHEATH & TYPE (COAR/SMOOTH/COLOR)	PIPE & BRIDGEMAN PLACEMENT
STEEL PIPE SIZE	
PVC	
FUTURE-2	FUTURE UNIT PLACE
FUTURE-3	
FUTURE-4	

HYUNDAI COMMUNICATIONS GROUP
Robert Irvine

POINT ARENA TO SACRAMENTO
CABLE ROUTE

DRAWN BY :	B&V	DATE :	03/10/90
CHECKED BY :	B&V	DATE :	03/10/90
APPROVED BY :		DATE :	
APPROVED BY :		DATE :	
A/E : 4113		LOC. CODE :	
HORIZONTAL SCALE (HWS & FWS) : 1"=10'			
VERTICAL SCALE (VWS) :			
VERTICAL SCALE (VWP) :			
S&P PROJECTION :			
DRAWING NUMBER : SACR-278-SPRD			

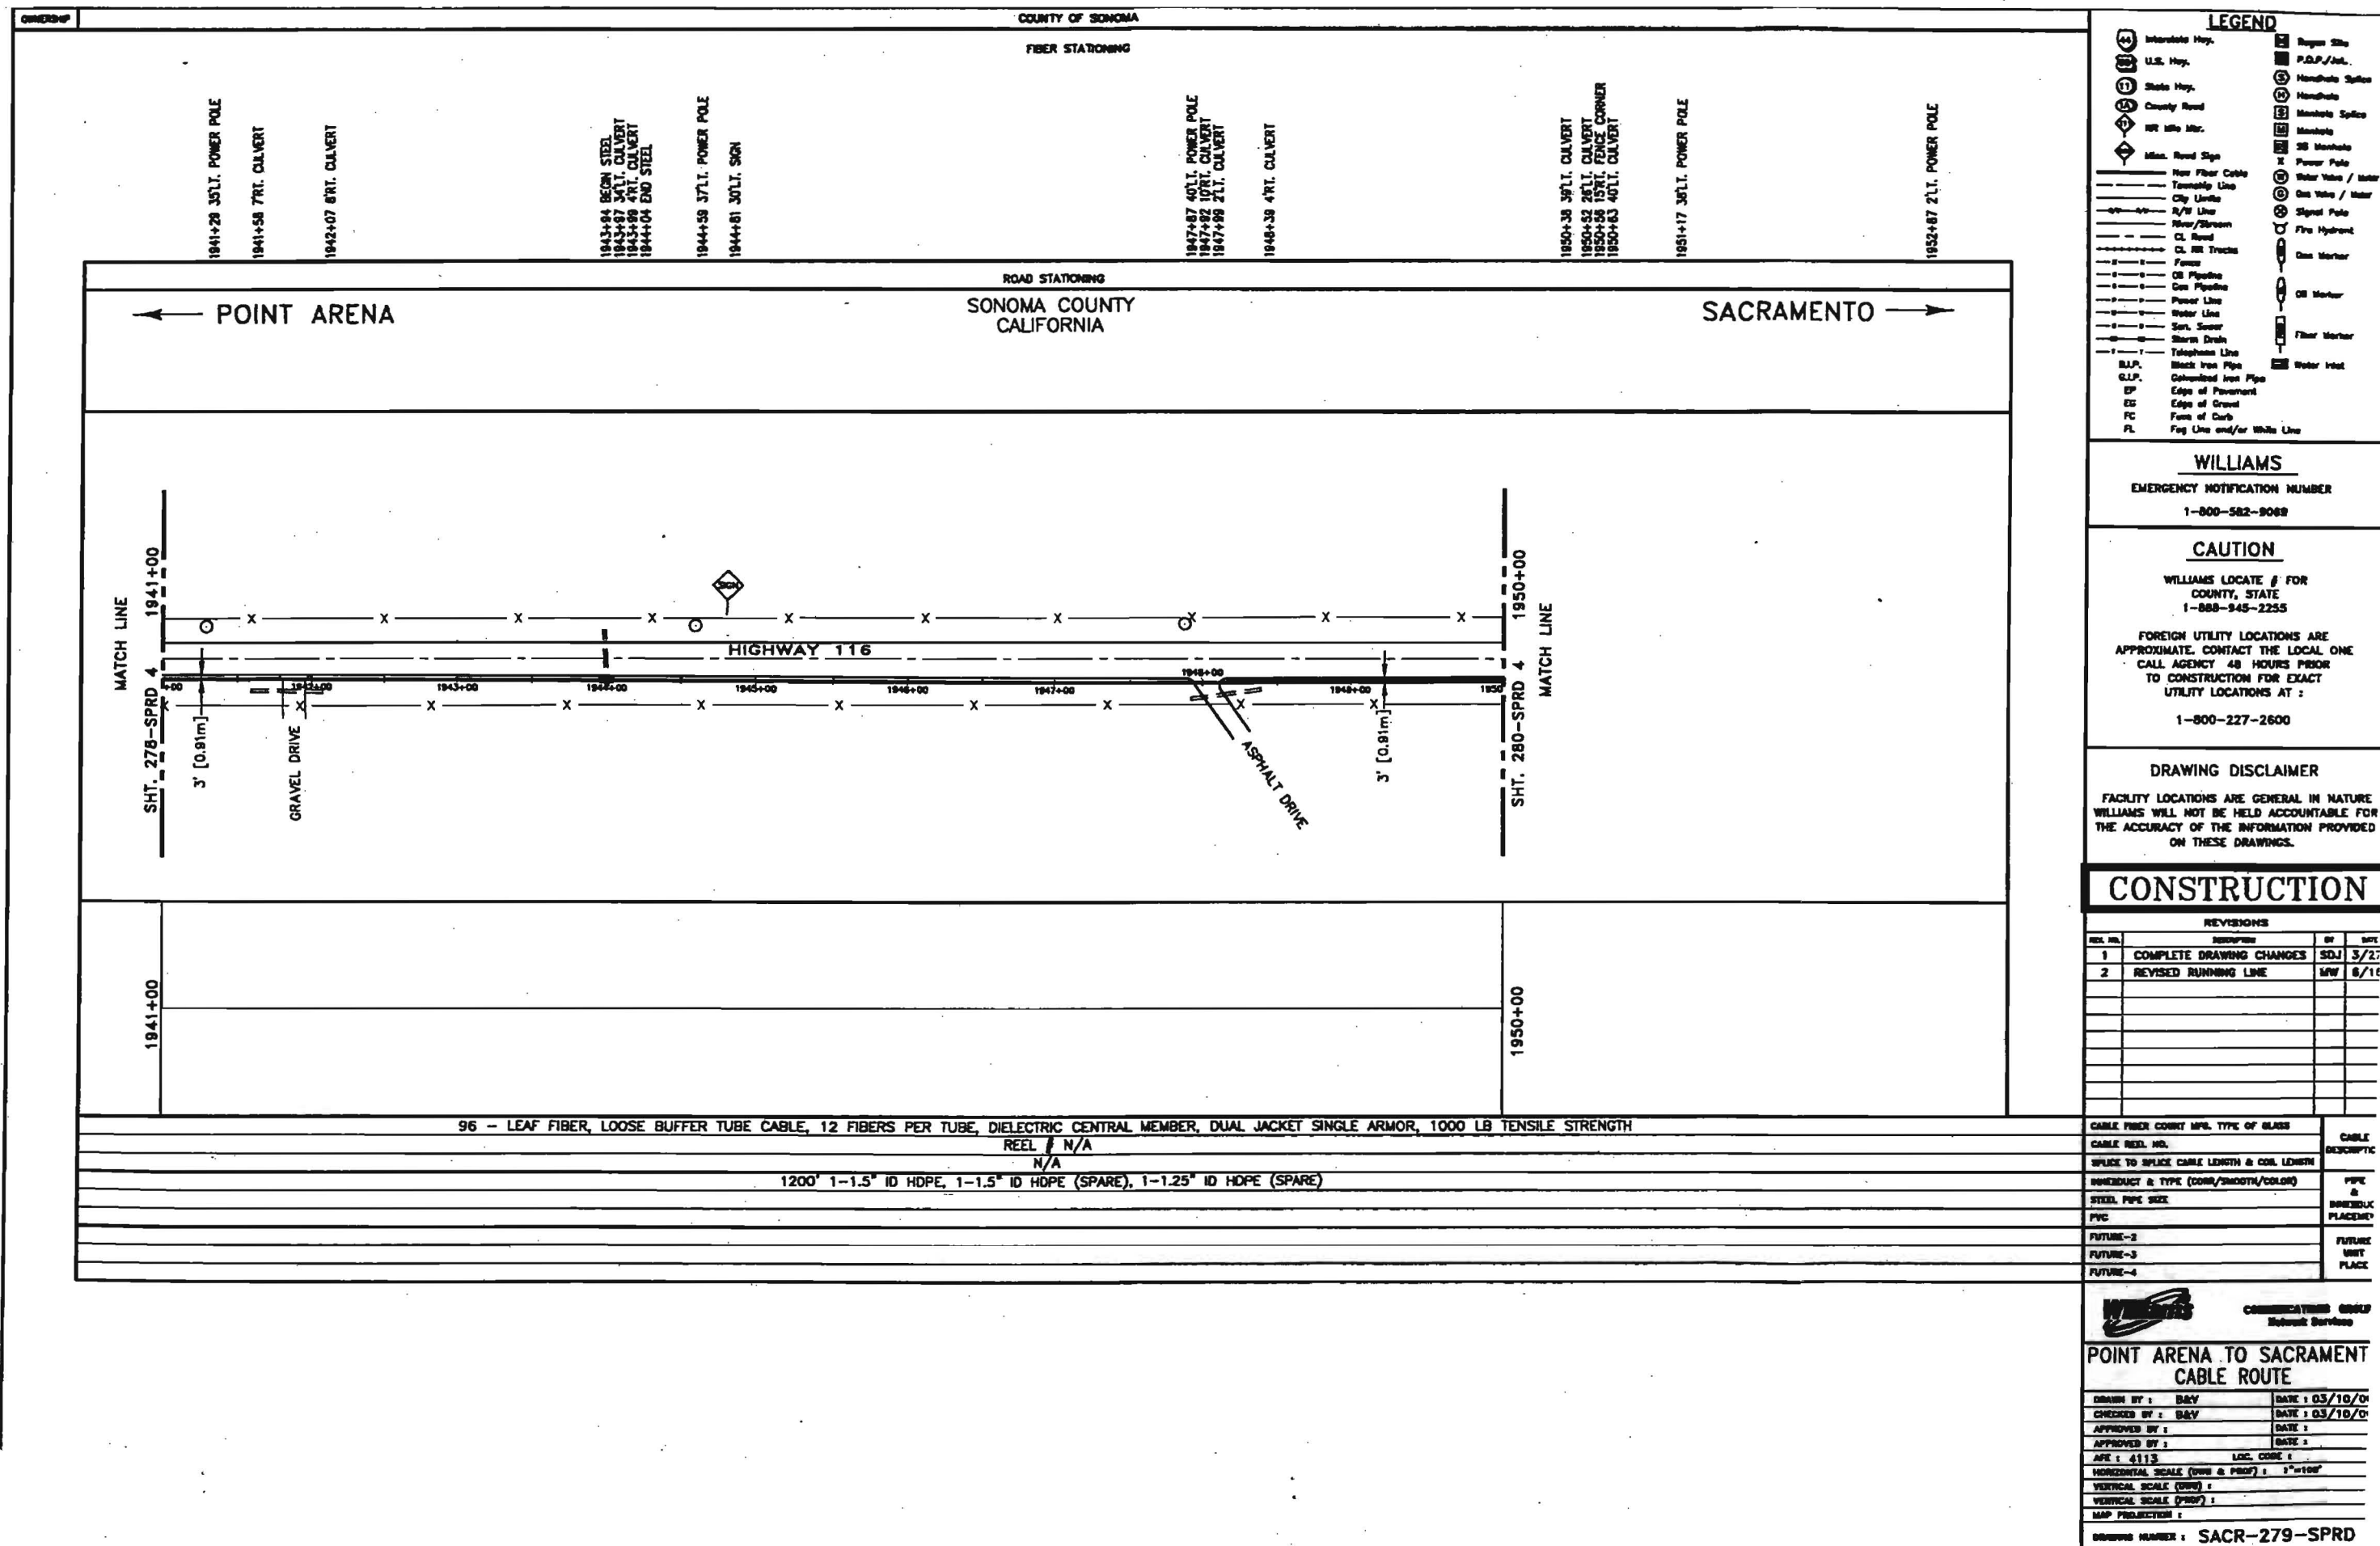

LEGEND	
	Interstate Hwy.
	U.S. Hwy.
	State Hwy.
	County Road
	RT Mile Mkr.
	Min. Road Sign
	New Fiber Cable
	Township Line
	City Limits
	R/W Line
	River/Stream
	CL Road
	CL RR Tracks
	Fence
	Oil Pipeline
	Gas Pipeline
	Power Line
	Water Line
	Sew. Sewer
	Storm Drain
	Telephone Line
	B.I.P.
	G.I.P.
	Edge of Pavement
	Edge of Gravel
	Face of Curb
	Fog Line and/or White Line
	Right of Way
	P.O.P./Jct.
	Handhole
	Manhole Splice
	Manhole
	36 Manhole
	Power Pole
	Water Valve / Meter
	Gas Valve / Meter
	Signal Pole
	Fire Hydrant
	Gas Marker
	Oil Marker
	Fiber Marker
	Water Inlet

WILLIAMS
EMERGENCY NOTIFICATION NUMBER
1-800-582-9089

CAUTION
WILLIAMS LOCATE # FOR
COUNTY, STATE
1-888-945-2255

FOREIGN UTILITY LOCATIONS ARE
APPROXIMATE. CONTACT THE LOCAL ONE
CALL AGENCY 48 HOURS PRIOR
TO CONSTRUCTION FOR EXACT
UTILITY LOCATIONS AT :
1-800-227-2600

DRAWING DISCLAIMER
FACILITY LOCATIONS ARE GENERAL IN NATURE
WILLIAMS WILL NOT BE HELD ACCOUNTABLE FOR
THE ACCURACY OF THE INFORMATION PROVIDED
ON THESE DRAWINGS.

CONSTRUCTION

REVISIONS			
REV. NO.	DESCRIPTION	BY	DATE
1	COMPLETE DRAWING CHANGES	SDJ	3/2/01
2	REVISED RUNNING LINE	MW	6/1/01

CABLE FIBER COUNT, TYPE, TYPE OF GLASS	CABLE DESCRIPTION
CABLE REEL NO.	
SPACE TO SPLICE CABLE LENGTH & COIL LENGTH	PIPE & BONDING PLACEMENT
WELDER/SPICE & TYPE (CONC./SMOOTH/COLOR)	
STEEL PIPE SIZE	FUTURE UNIT PLACE
PVC	
FUTURE-2	FUTURE UNIT PLACE
FUTURE-3	
PIPE WITH BONDING - 4	

COMMUNICATIONS GROUP
Network Services

POINT ARENA TO SACRAMENT CABLE ROUTE

DRAWN BY : BAY DATE : 03/10/01
CHECKED BY : BAY DATE : 03/10/01
APPROVED BY : DATE :
APPROVED BY : DATE :
APR : 4113 LOC. CODE :
HORIZONTAL SCALE (DWG & PROF) : 1"=100'
VERTICAL SCALE (DWG) :
VERTICAL SCALE (PROF) :
MAP PROJECTION :
DRAWING NUMBER : SACR-279-SPRD

0+15.3 PLACE MANHOLE

D+35.2 ROAD SIGN 11.0M RT

0+65.4 WATER INLET 8.1M RT

1+00.9 ROAD SIGN 2.7M RT

1+60.1 POWER POLE 0.4M RT

2+12.2 FIBER MARKING

1

LEGEND

- ### LEGEND
- | | | | |
|--|-----------------------------|--|---------------------|
| | Interstate Hwy. | | Region Site |
| | U.S. Hwy. | | P.O.P./A.L. |
| | State Hwy. | | Handhole Splice |
| | County Road | | Handhole |
| | RR Mile Mtr. | | Handhole Splice |
| | Mile. Road Sign | | Handhole |
| | New River Culvert | | Power Pole |
| | Township Line | | Water Valve / Meter |
| | City Limits | | Gas Valve / Meter |
| | R/W Line | | Signal Pole |
| | River/Stream | | Fire Hydrant |
| | CL Road | | Gas Marker |
| | CL RR Track | | Oil Marker |
| | Fence | | Fiber Marker |
| | Oil Pipeline | | Water Inlet |
| | Gas Pipeline | | |
| | Power Line | | |
| | Water Line | | |
| | Sew. Sewer | | |
| | Storm Drain | | |
| | Telephone Line | | |
| | Slick Iron Pipe | | |
| | Culminated from Pipe | | |
| | Edge of Pavement | | |
| | Edge of Gravel | | |
| | Face of Curb | | |
| | Flag Line end/or White Line | | |

WILLIAMS

EMERGENCY NOTIFICATION NUMBER
1-800-582-8069

CAUTION

**WILLIAMS LOCATE & FOR
COUNTY, STATE
1-888-265-2283**

FOREIGN UTILITY LOCATIONS ARE APPROXIMATE. CONTACT THE LOCAL ONE CALL AGENCY 48 HOURS PRIOR TO CONSTRUCTION FOR EXACT UTILITY LOCATIONS AT :
1-800-227-2600

REVIEWS

[illegible]

96 - LEAF FIBER, LOOSE BUFFER TUBE CABLE, 12 FIBERS PER TUBE, DIELECTRIC CENTRAL MEMBER, DUAL JACKET SINGLE ARMOR, 1000 LB TENSILE STRENGTH

REEL # N/A

N/A

280.5M - 1-38mm ID HDPE, 1-38mm ID HDPE (SPARE), 1-32mm ID HDPE (SPARE)

CABLE FIBER COUNT	WFL. TYPE OF GLASS
100	100
200	200
300	300
10000	10000

CABLE MAIL NO.	
----------------	--

SPICE TO SPICE CABLE LENGTH & COIL L

PRODUCT & TYPE (CONR/SMOOTH/COLOR)	
------------------------------------	--

PRODUCT & TYPE (Company/Shipping Code)	
STAY GREEN 207	

100

FIGURE-2

FIGURE-3

FUTURE-7

..

WYOMING

COMMUNICATIONS GROUP
Network Services

POINT ARENA TO SACRAMENTO
CABLE ROUTE

DESIGNED BY :	SAN	DATE :	09/06/08
---------------	-----	--------	----------

CHECKED BY :	100	DATE : 06/06/00
--------------	-----	-----------------

APPROVED BY :	DATE :

APPROVED BY :	DATE :
AGE :	LOC CODE :

HORIZONTAL SCALE (SW & PTOF) : 1:25.5

VERTICAL SCALE (HWS) : 1:30.5

VERTICAL SCALE (PROF) : 1:30.5


MAP PROJECTION: MAP-PROJECTION


REF ID: A66344

DRAWING NUMBER : PTAR-SACR-274-SF RD 3

.....

REV-0

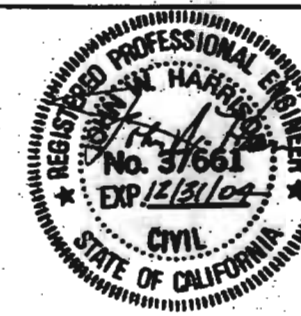

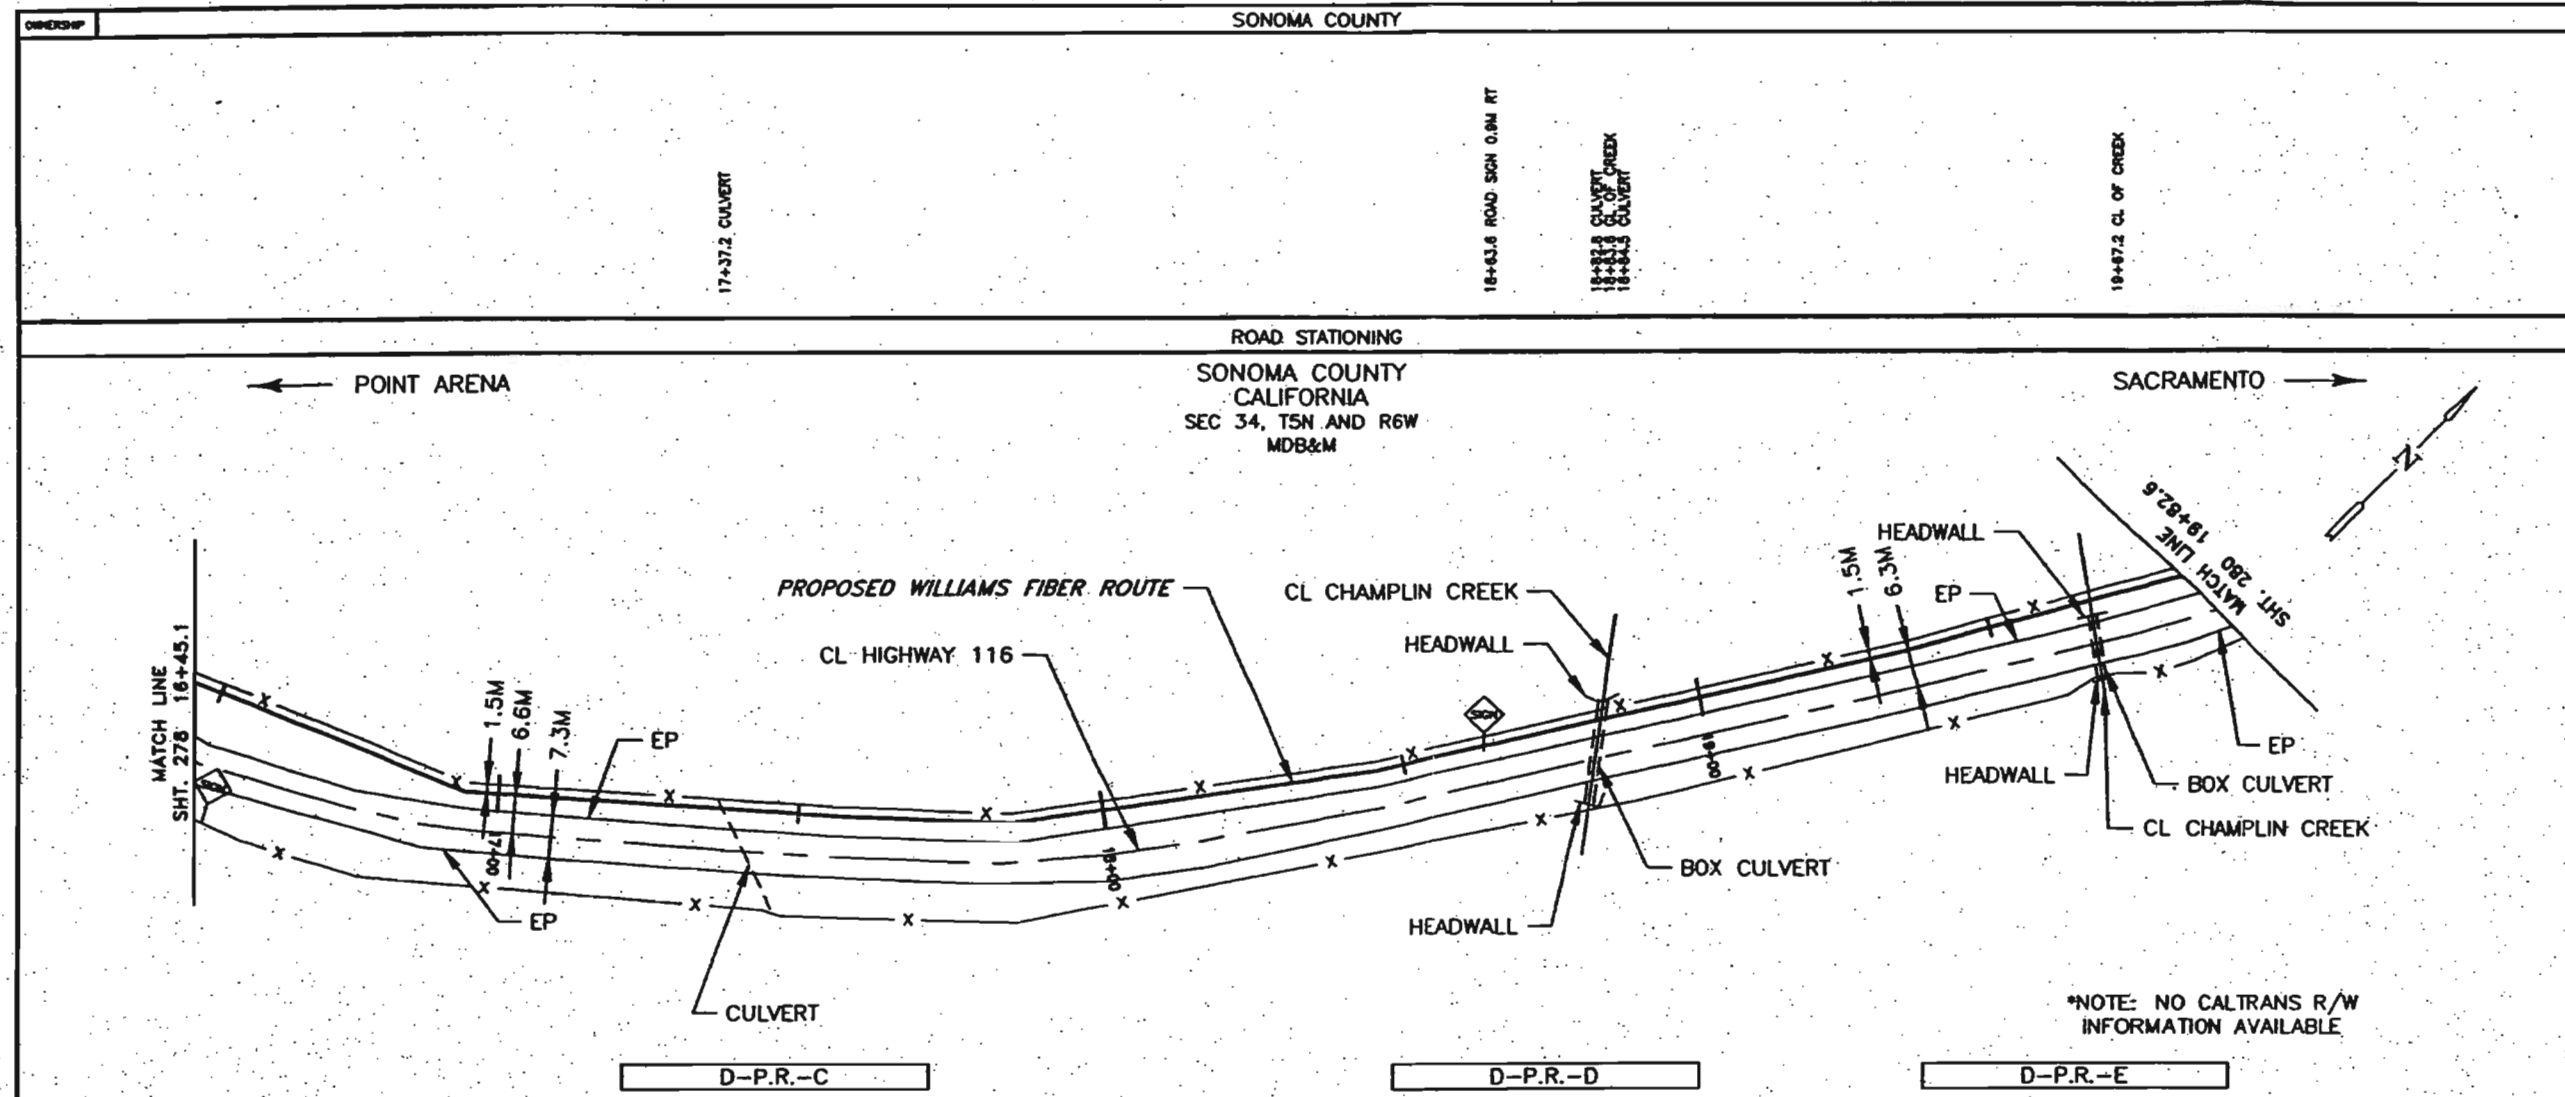

LEGEND	
Interstate Hwy.	Region Site
U.S. Hwy.	P.O.P./Jct.
State Hwy.	Handhole Spline
County Road	Handhole
RR Mile Marker	Handhole Spline
Mile Road Sign	Handhole
New Fiber Cable	25 Handhole
Township Line	Water Valve / Meter
City Limits	Gas Valve / Meter
R/W Line	Signal Pole
Road/Stream	Fire Hydrant
CL Road	Gas Marker
CL RR Tracks	Oil Marker
Fence	Fiber Marker
Oil Pipeline	Water Inlet
Gas Pipeline	
Power Line	
Water Line	
Sun. Sewer	
Storm Drain	
Telephone Line	
Black Iron Pipe	
Galvanized Iron Pipe	
Edge of Pavement	
Edge of Ground	
Face of Cut	
Fog Line and/or White Line	

WILLIAMS
EMERGENCY NOTIFICATION NUMBER
1-800-582-9069

CAUTION
WILLIAMS LOCATE # FOR
COUNTY, STATE
1-800-256-2283

FOREIGN UTILITY LOCATIONS ARE
APPROXIMATE. CONTACT THE LOCAL ONE
CALL AGENCY 48 HOURS PRIOR
TO CONSTRUCTION FOR EXACT
UTILITY LOCATIONS AT :
1-800-227-2600

REVISIONS			
REV. NO.	DESCRIPTION	BY	DATE
0	PERMIT	KCN	01/24


16+45.1		19+82.6
96 - LEAF FIBER, LOOSE BUFFER TUBE CABLE, 12 FIBERS PER TUBE, DIELECTRIC CENTRAL MEMBER, DUAL JACKET SINGLE ARMOR, 1000 LB TENSILE STRENGTH		
REEL # N/A		
N/A		
337.5M - 1-38mm ID HDPE, 1-38mm ID HDPE (SPARE), 1-32mm ID HDPE (SPARE)		
SPELCE TO SPELCE CABLE LENGTH & COIL LENGTH		
SPELCE & TYPE (CON/SHOWN/COLOR)		
SPELCE PIPE SIZE		
PVC		
FURROW-2		
FURROW-3		
FURROW-4		

COMMUNICATIONS GROUP
Network Services

POINT ARENA TO SACRAMENTO
CABLE ROUTE

DRAWN BY : SMH
CHECKED BY : KCB
APPROVED BY :
DATE : 06/05/00
DATE : 06/05/00
DATE :
DATE :

SCALE : 4075
LOC. CODE : 000001
HORIZONTAL SCALE (DWG & PROF) : 1:30.3
VERTICAL SCALE (DWG) : 1:30.3
VERTICAL SCALE (PROF) : 1:30.3
MAP PROJECTION : MAP-PROJECTION
DRAWING NUMBER : PTAR-SACR-279-SPRD 5

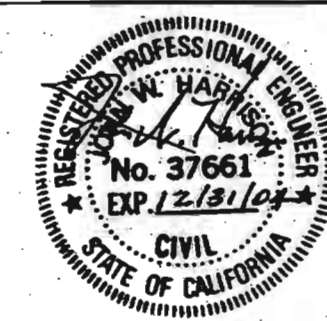

28480 8 BOW SIGN 2 5M BT

SONOMA COUNTY
CALIFORNIA
SEC 27, T5N AND R6W
MDB&M

SACRAMENTO



	Interstate Hwy.		Region Site
	U.S. Hwy.		P.O.P./Jct.
	State Hwy.		Manhole
	County Road		Manhole
	RR Mile Mar.		Manhole
	Mile. Road Sign		Power Pole
	New Fiber Cable		Water Valve / Meter
	Turnaway Line		Gas Valve / Meter
	City Limits		Signal Pole
	R/W Line		Fire Hydrant
	R/W/Stream		Gas Marker
	CL Road		Oil Marker
	CL RR Tracks		Fluor Marker
	Fence		Water Inlet
	Oil Pipeline		
	Gas Pipeline		
	Power Line		
	Water Line		
	San. Sewer		
	Storm Drain		
	Telephone Line		
	Black Iron Pipe		
	Culverted Iron Pipe		
	Edge of Pavement		
	Edge of Ground		
	Edge of Curb		
	Fog Line and/or White Line		


EMERGENCY NOTIFICATION NUMBER
1-800-582-9069

WILLIAMS LOCATE # FOR
COUNTY, STATE
1-888-265-2283


FOREIGN UTILITY LOCATIONS ARE
APPROXIMATE. CONTACT THE LOCAL ONE
CALL AGENCY 48 HOURS PRIOR
TO CONSTRUCTION FOR EXACT
UTILITY LOCATIONS AT :
1-800-227-2600

[illegible]

CABLE FIBER COUNT MFG. TYPE OF GLASS	CABLE DESCRIPTION
CABLE REEL NO.	
SPACE TO SPACE CABLE LENGTH & CBL. LENGTH	PIPE & SUBSTRUCT PLACEMENT
MANHOLE & TYPE (CONC./SMOOTH/COLOID)	
STEEL PIPE SIZE	
PVC	
FUTURE-2	FUTURE USE PLACE
FUTURE-3	
FUTURE-4	

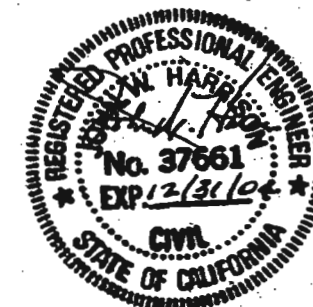

DRAWN BY :	SAH	DATE :	06/06/90
CHECKED BY :	KDD	DATE :	06/06/90
APPROVED BY :		DATE :	
APPROVED BY :		DATE :	
AGE :	4075	LOC. CODE :	000001
HORIZONTAL SCALE (HWS & HWS') :	1:30.5		
VERTICAL SCALE (VWS) :	1:30.5		
VERTICAL SCALE (VWS') :	1:30.5		
MAP PROJECTION : MAP-PROJECTION			
DRAWING NUMBER : PTAR-SACR-281-SPRD 5			

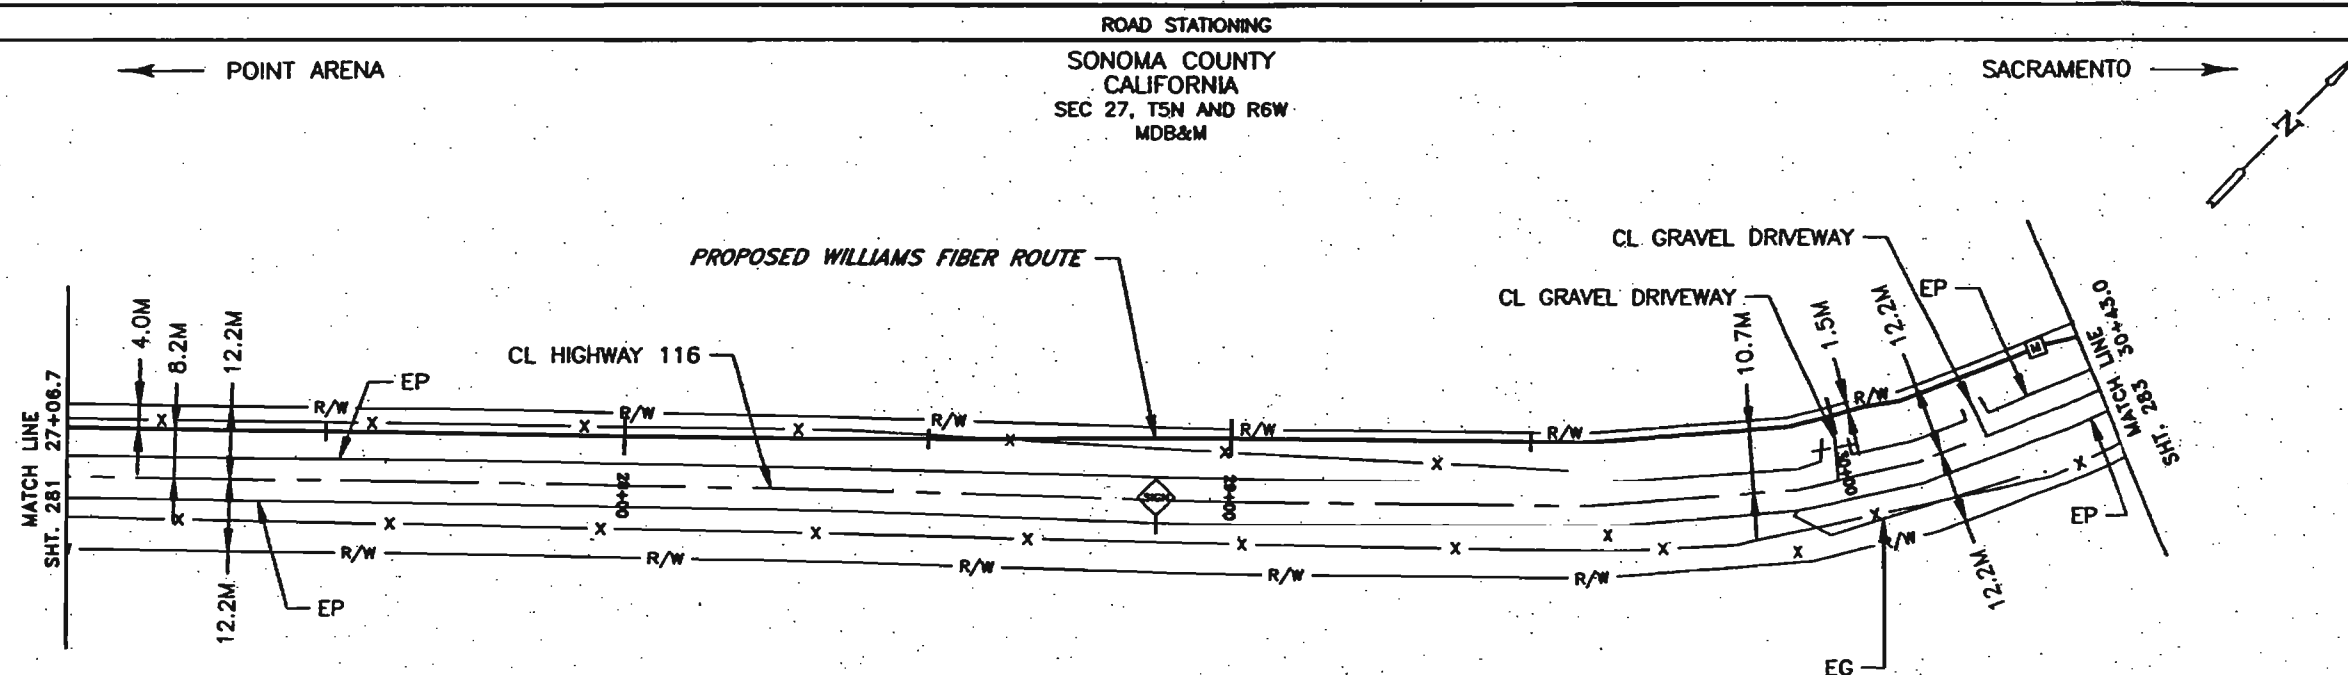

LEGEND

	Interstate Hwy.		Region Site
	U.S. Hwy.		P.O.P./Jct.
	State Hwy.		Marshall Splice
	County Road		Manhole
	RR Mile Mkr.		Marshall Splice
	Manhole		Manhole
	Misc. Road Sign		33 Manhole
	New Fiber Cable		Power Pole
	Township Line		Water Valve / Meter
	City Limits		Gas Valve / Meter
	R/W Line		Signal Pole
	River/Stream		Fire Hydrant
	CL Road		Gas Marker
	CL RR Tracks		Oil Marker
	Fence		Fiber Marker
	Gas Pipeline		Water Meter
	Gas Pipeline		Water Meter
	Power Line		Water Meter
	Water Line		Water Meter
	San. Sewer		Water Meter
	Storm Drain		Water Meter
	Telephone Line		Water Meter
	Black Iron Pipe		Water Meter
	Galvanized Iron Pipe		Water Meter
	Edge of Pavement		Water Meter
	Edge of Gravel		Water Meter
	Face of Curve		Water Meter
	Fog Line and/or White Line		Water Meter

WILLIAMS

EMERGENCY NOTIFICATION NUMBER
1-800-582-9069

CAUTION

WILLIAMS LOCATE / FOR
COUNTY, STATE
1-888-265-2283

FOREIGN UTILITY LOCATIONS ARE APPROXIMATE. CONTACT THE LOCAL ONE CALL AGENCY 48 HOURS PRIOR TO CONSTRUCTION FOR EXACT UTILITY LOCATIONS AT :
1-800-227-2600

[illegible]

CABLE FIBER COUNT MFL TYPE OF GLASS	CABLE
CABLE REEL NO.	RECEIPT
SPICE TO SPICE CABLE LENGTH & CBL. LENGTH	
INDEXING & TYPE (CORE/SMOOTH/COLOR)	PPE
SHEEL PPE SIZE	INDICATING
PVC	PLACEMENT
FFURE-2	
FFURE-3	FUTURE
FFURE-4	USE
	PLACE

96 - LEAF FIBER, LOOSE BUFFER TUBE CABLE, 12 FIBERS PER TUBE, DIELECTRIC CENTRAL MEMBER, DUAL JACKET SINGLE ARMOR, 1000 LB TENSILE STRENGTH

REEL # N/A
N/A

336.3M - 1-38mm ID HDPE, 1-38mm ID HDPE (SPARE), 1-32mm ID HDPE (SPARE)



COMMUNICATIONS GROUP
Network Services


POINT ARENA TO SACRAMENTO
CABLE ROUTE

DRAWN BY :	SM	DATE :	06/06/00
CHECKED BY :	K30	DATE :	06/06/00
APPROVED BY :		DATE :	
APPROVED BY :		DATE :	
ATE :	4575	LOC. CODE :	000001
HORIZONTAL SCALE (DWG & PROF) :	1:20.5		
VERTICAL SCALE (DWG) :	1:20.5		
VERTICAL SCALE (PROF) :	1:20.5		
MAP PROJECTION :	MAP-PROJECTION		
DRAWING NUMBER : PTP-SACR-282-SPRD 5			

DRAWING NUMBER : PTAR-SACR-282-SPRD 5



SONOMA COUNTY					
30+48.9 POWER POLE 1.7M LT 30+54.4 R/L CHANGE	31+08.4 POWER POLE 0.4M LT	31+55.3 CULVERT	31+78.0 POWER POLE 2.4M LT	32+34.8 POWER POLE 1.0M RT	33+29.9 POWER POLE 8.5M RT 33+35.9 GUY WIRE 10.0M RT

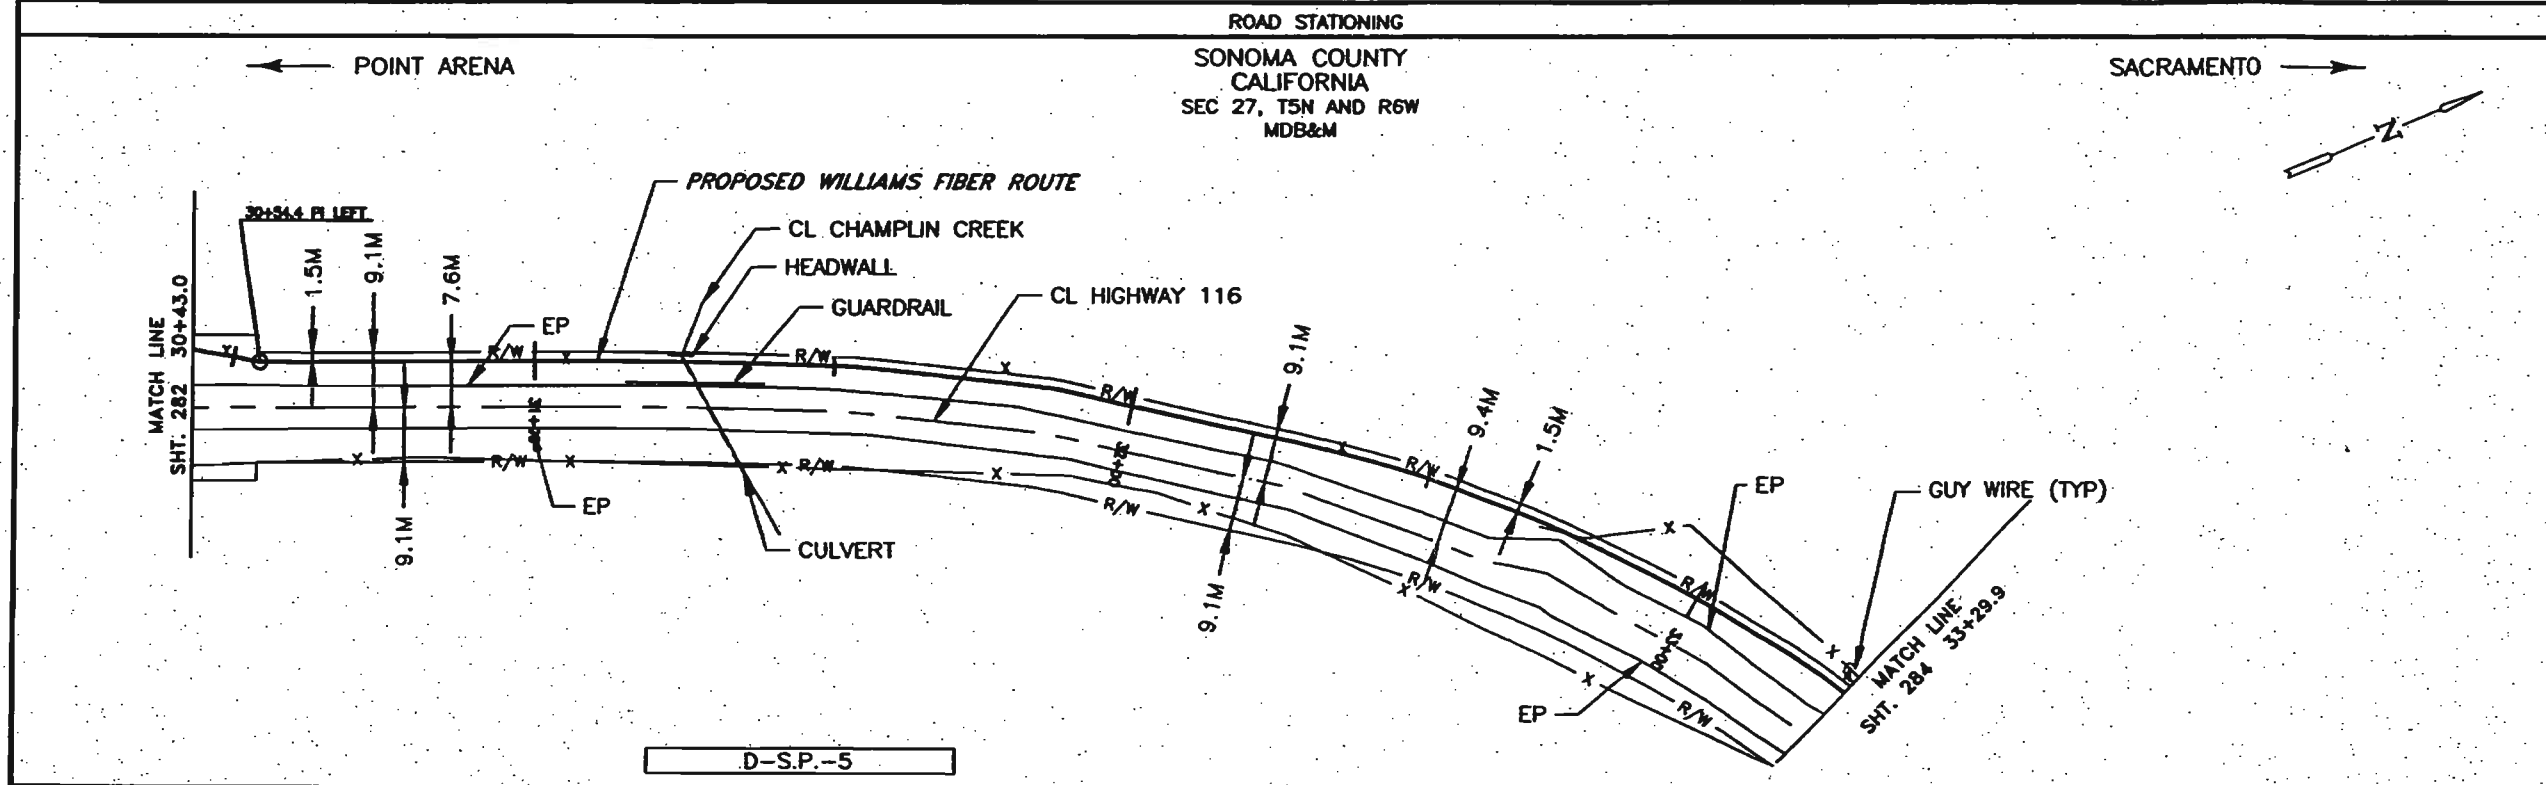

30+43.0		33+29.9
---------	--	---------

96 - LEAF FIBER, LOOSE BUFFER TUBE CABLE, 12 FIBERS PER TUBE, DIELECTRIC CENTRAL MEMBER, DUAL JACKET SINGLE ARMOR, 1000 LB TENSILE STRENGTH	
REEL # N/A	
N/A	
286.9M - 1-38mm ID HDPE, 1-38mm ID HDPE (SPARE), 1-32mm ID HDPE (SPARE)	

LEGEND	
(M) Interstate Hwy	Regen Site
(S) U.S. Hwy	P.O.P./Jct.
(ST) State Hwy	Handhole Splice
(C) County Road	Handhole
(R) RR Mile Mkr.	Handhole Splice
(X) Min. Road Sign	SS Handhole
--- New Fiber Cable	Water Valve / Water
--- Turnback Line	Gas Valve / Water
--- City Limits	Signed Pole
--- R/W Line	Fire Hydrant
--- Water/Stream	Gas Marker
--- CL Road	Oil Marker
--- CL RR Tracks	Fiber Marker
--- Fence	Water Inlet
--- Oil Pipeline	
--- Gas Pipeline	
--- Power Line	
--- Water Line	
--- Gas Sewer	
--- Storm Drain	
--- Telephone Line	
B.I.P.	Block Iron Pipe
G.I.P.	Galvanized Iron Pipe
EP	Edge of Pavement
ES	Edge of Ground
FC	Face of Curb
FL	Fog Line and/or White Line


WILLIAMS
EMERGENCY NOTIFICATION NUMBER
1-800-582-9089

CAUTION
WILLIAMS LOCATE # FOR
COUNTY, STATE
1-888-265-2283

FOREIGN UTILITY LOCATIONS ARE
APPROXIMATE. CONTACT THE LOCAL ONE
CALL AGENCY 48 HOURS PRIOR
TO CONSTRUCTION FOR EXACT
UTILITY LOCATIONS AT :
1-800-227-2600

REVISIONS			
REV. NO.	DESCRIPTION	BY	DATE
0	PERMIT	KSH	11/04

CABLE FIBER COUNT MFG. TYPE OF GLASS	CABLE DESCRIPTION
CABLE REEL NO.	
SPLICE TO SPLICE CABLE LENGTH & COIL LENGTH	PVC & BINDER/PLACEMENT
BINDER/TYPE (CON/SAND/AC/CLON)	
STEEL PIPE SIZE	FUTURE USE/PLACE
PVC	
FUTURE-2	
FUTURE-3	
FUTURE-4	

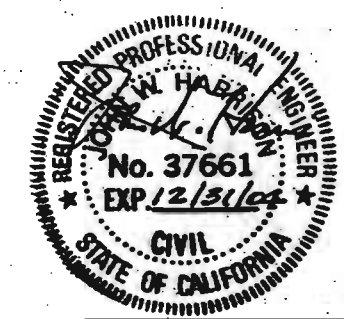

COMMUNICATIONS GROUP Network Services	
POINT ARENA TO SACRAMENTO CABLE ROUTE	
DRAWN BY : SH	DATE : 05/05/00
CHECKED BY : KSH	DATE : 05/04/00
APPROVED BY :	DATE :
APPROVED BY :	DATE :
AFE : 4875	LOC. CODE : 000001
HORIZONTAL SCALE (HWS & PROF) : 1:30.5	
VERTICAL SCALE (VWS) : 1:30.5	
VERTICAL SCALE (PWS) : 1:30.5	
MAP PROJECTION : MAP-PROJECTION	
DRAWING NUMBER : PTAR-SACR-283-SPRD 5	

REV-0

SONOMA COUNTY

33+80.3 GAS MARKER 2.4M RT


34+14.1 POWER POLE 0.2M LT

34+89.8 R/L CHANGE
34+89.8 POWER POLE 0.9M LT

35+11.0 R/L CHANGE

36+86.7 POWER POLE 1.1M LT

36+72.5 POWER POLE 0.7M LT

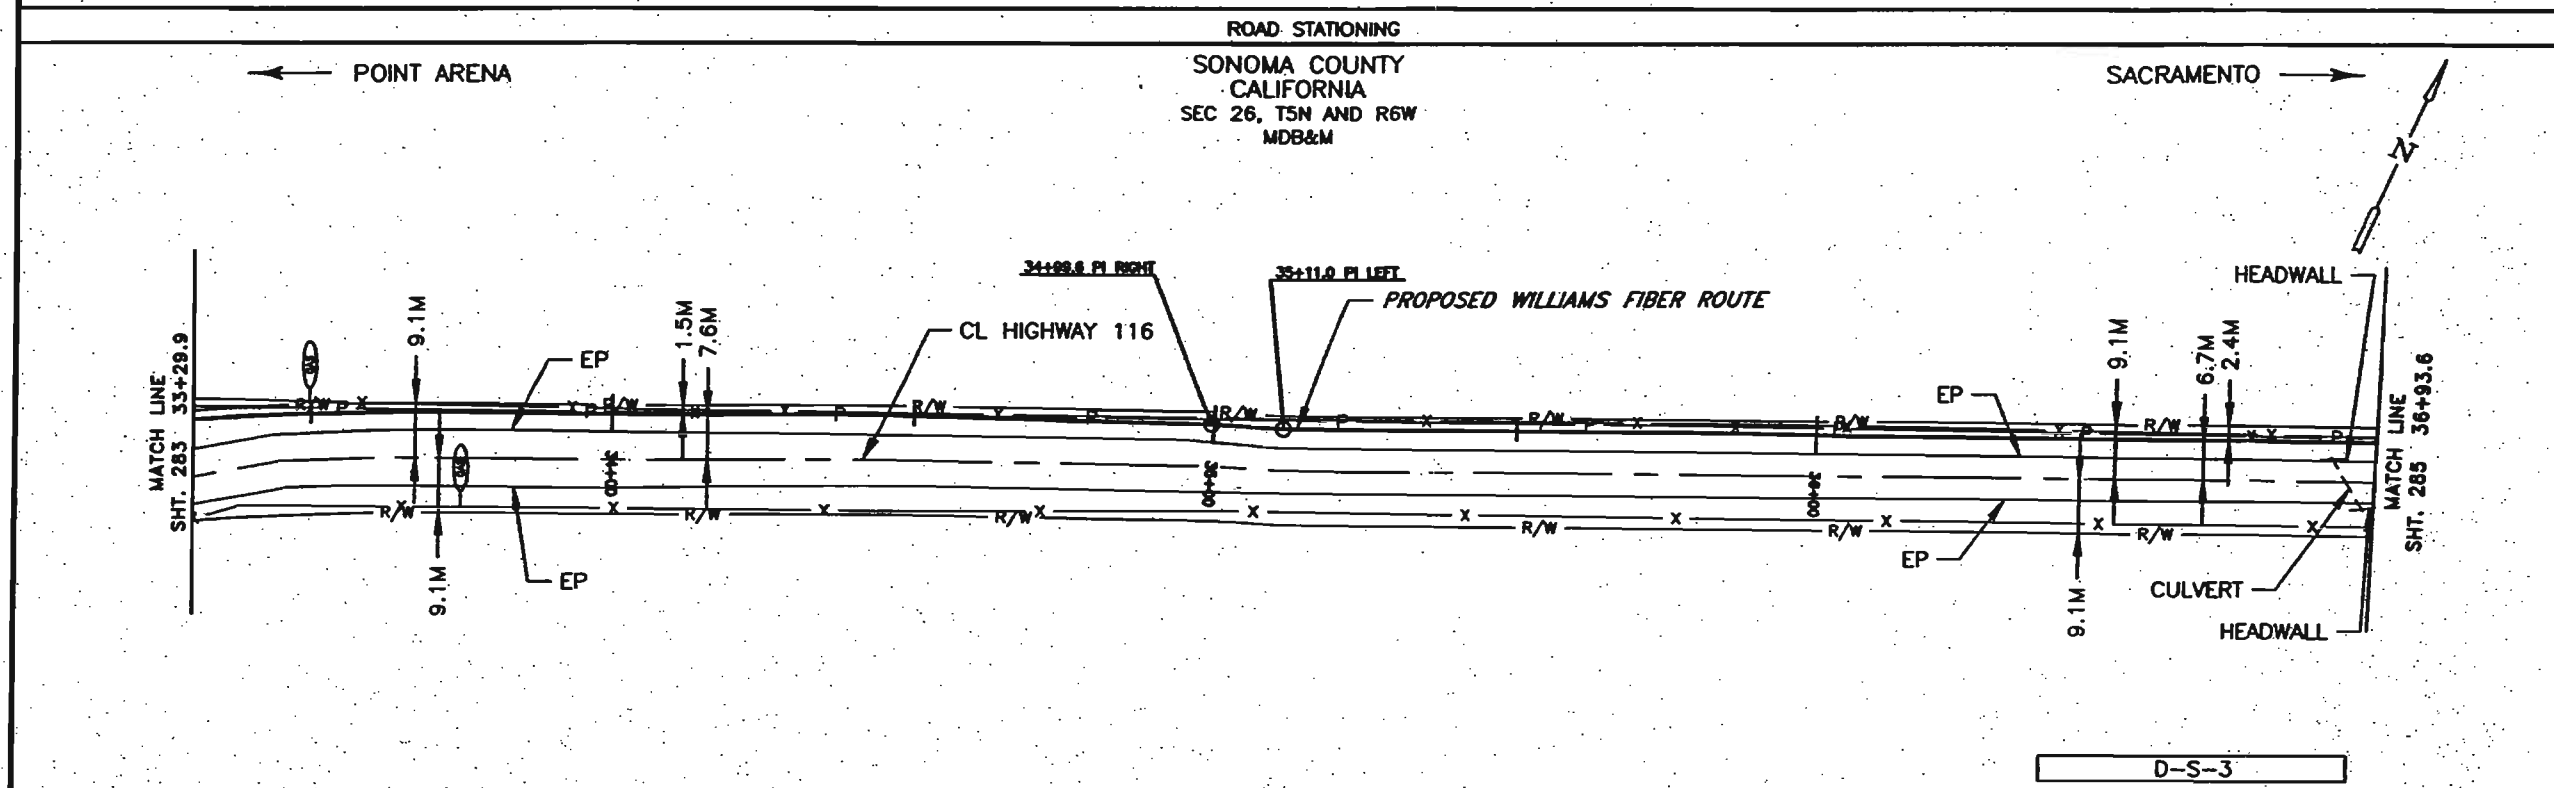

33+29.9		36+93.6
---------	--	---------

96 - LEAF FIBER, LOOSE BUFFER TUBE CABLE, 12 FIBERS PER TUBE, DIELECTRIC CENTRAL MEMBER, DUAL JACKET SINGLE ARMOR, 1000 LB TENSILE STRENGTH
REEL # N/A
N/A
363.7M - 1-38mm ID HDPE, 1-38mm ID HDPE (SPARE), 1-32mm ID HDPE (SPARE)

LEGEND

	Interstate Hwy		Right of Way
	U.S. Hwy		P.O.P./Jct
	State Hwy		Handhole Splice
	County Road		Handhole
	RR Mile Mar.		Markhole Splice
	Misc. Road Sign		Markhole
	New Fiber Cable		SS Markhole
	Trenching Line		Power Pole
	City Limits		Water Valve / Meter
	R/W Line		Gas Valve / Meter
	River/Stream		Signal Pole
	CL Road		Fire Hydrant
	CL RR Tracks		Gas Marker
	Fence		Oil Marker
	Oil Pipeline		Fiber Marker
	Gas Pipeline		Water Inlet
	Power Line		
	Water Line		
	San. Sewer		
	Storm Drain		
	Telephone Line		
	Black Iron Pipe		
	Culverted Iron Pipe		
	Edge of Pavement		
	Edge of Ground		
	Face of Curb		
	Fog Line and/or White Line		

WILLIAMS

EMERGENCY NOTIFICATION NUMBER

1-800-582-9069

CAUTION

WILLIAMS LOCATE # FOR COUNTY, STATE


1-888-263-2283

FOREIGN UTILITY LOCATIONS ARE APPROXIMATE. CONTACT THE LOCAL ONE CALL AGENCY 48 HOURS PRIOR TO CONSTRUCTION FOR EXACT UTILITY LOCATIONS AT :

1-800-227-2600

REV. NO.	DESCRIPTION	BY	DATE
0	PERMIT	KSM	11/14/00

CABLE FIBER COUNT MFR. TYPE OF GLASS	CABLE DESCRIPTION
CABLE REEL NO.	
SPICE TO SPICE CABLE LENGTH & COIL LENGTH	
MANUFACT & TYPE (CONC./MASONRY/COLOR)	PIPE & MANHOLE PLACEMENT
SHIELD PIPE SIZE	
PVC	
FUTURE-2	FUTURE USE PLACE
FUTURE-3	
FUTURE-4	

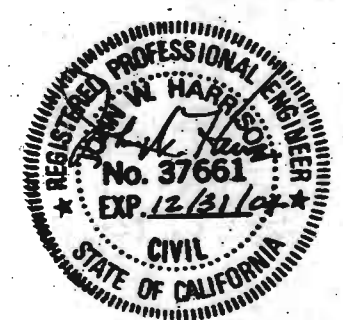

COMMUNICATIONS GROUP
Network Services

POINT ARENA TO SACRAMENTO
CABLE ROUTE

DRAWN BY : SAM	DATE : 09/06/00
CHECKED BY : KSM	DATE : 09/06/00
APPROVED BY :	DATE :
DATE :	
AGE : 4575	LOC. CODE : 000001
HORIZONTAL SCALE (HWS & PWS) : 1"=100.0	
VERTICAL SCALE (PWS) : 1"=100.0	
VERTICAL SCALE (PWS) : 1"=100.0	
MAP PROJECTION : MAP-PROJECTION	
DRAWING NUMBER : PTAR-SACR-284-SPRD 5	

OWNERSHIP SONOMA COUNTY

37+06.7 GAS MARKER 0.9M LT

37+58.9 POWER POLE 0.7M LT


38+05.1 ROAD SIGN 12.3M RT
38+08.4 PLAZA MANHOLE

38+38.4 GUY WIRE 0.3M LT
38+44.5 POWER POLE 1.0M LT

38+44.1 GUY WIRE 14.8M RT
38+48.3 POWER POLE 14.0M RT
38+54.3 GUY WIRE 0.3M RT

40+00.6 ROAD SIGN 0.6M RT

40+30.0 R/L CHANGE

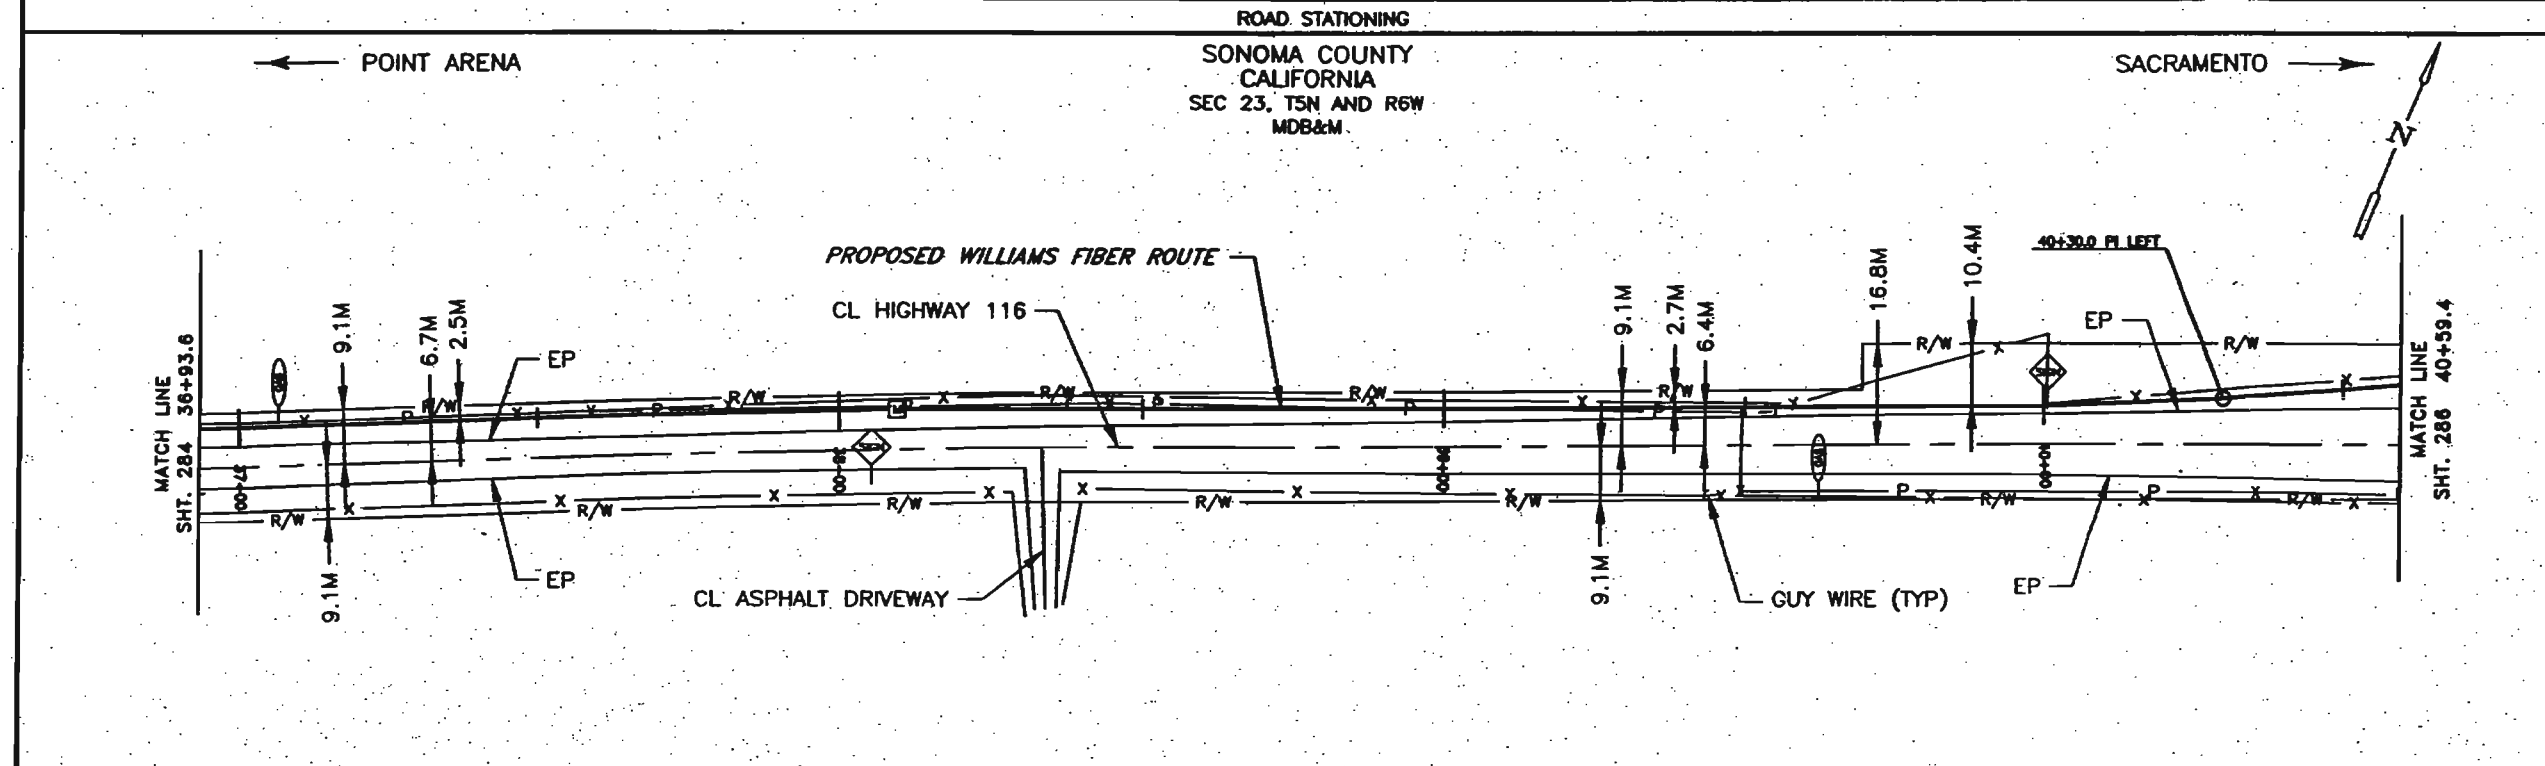

36+93.6		40+59.4
---------	--	---------

96 - LEAF FIBER, LOOSE BUFFER TUBE CABLE, 12 FIBERS PER TUBE, DIELECTRIC CENTRAL MEMBER, DUAL JACKET SINGLE ARMOR, 1000 LB TENSILE STRENGTH	
REEL # N/A	
N/A	
365.8M - 1-38mm ID HDPE, 1-38mm ID HDPE (SPARE), 1-32mm ID HDPE (SPARE)	

LEGEND

66	Interstate Hwy.	2	Regen Sign
26	U.S. Hwy.	3	P.O.P./Jct.
1	State Hwy.	4	Handhole Splice
1A	County Road	5	Handhole
1B	RR Mile Mkr.	6	Handhole Splice
1C	Misc. Road Sign	7	Handhole
2	New Fiber Cable	8	SS Handhole
3	Telephone Line	9	Water Valve / Meter
4	City Utility	10	Gas Valve / Meter
5	R/W Line	11	Signal Pole
6	River/Stream	12	Fire Hydrant
7	CL Road	13	Gas Marker
8	CL RT Tracks	14	Oil Marker
9	Fence	15	Fiber Marker
10	Oil Pipeline	16	Water Inlet
11	Gas Pipeline		
12	Power Line		
13	Water Line		
14	San. Sewer		
15	Storm Drain		
16	Telephone Line		
17	Black Iron Pipe		
18	Overhead Iron Pipe		
19	Edge of Pavement		
20	Edge of Ground		
21	Face of Curb		
22	Fog Line and/or White Line		

WILLIAMS

EMERGENCY NOTIFICATION NUMBER

1-800-582-9069

CAUTION

WILLIAMS LOCATE # FOR COUNTY, STATE


1-888-265-2283

FOREIGN UTILITY LOCATIONS ARE APPROXIMATE. CONTACT THE LOCAL ONE CALL AGENCY 48 HOURS PRIOR TO CONSTRUCTION FOR EXACT UTILITY LOCATIONS AT:

1-800-227-2600

REVISIONS		
REV. NO.	DESCRIPTION	BY DATE
0	PERMIT	KCN 01/14

CABLE FIBER COUNT MFG. TYPE OF GLASS	CABLE
CABLE REEL NO.	DESCRIPTION
SPLICE TO SPLICE CABLE LENGTH & COIL LENGTH	
UNDERDUCT & TYPE (CONC./SHADOW/COLOR)	PIPE
STEEL PIPE SIZE	UNDERDUCT
PVC	PLACEMENT
FURROW-2	FURROW
FURROW-3	USE
FURROW-4	PLACE

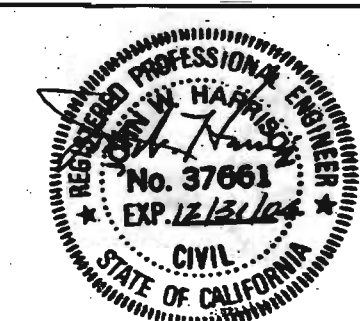

COMMUNICATIONS GROUP
Network Services

POINT ARENA TO SACRAMENTO
CABLE ROUTE

DRAWN BY: SAN	DATE: 08/06/00
CHECKED BY: KSO	DATE: 08/06/00
APPROVED BY:	DATE:
DATE:	DATE:
DATE:	DATE:

SCALE: 4079 LOC. CODE: 000001

HORIZONTAL SCALE (DWG & PROF): 1:30.0


VERTICAL SCALE (DWG): 1:30.0

VERTICAL SCALE (PROF): 1:30.0

MAP PROJECTION: NAD-83

DRAWING NUMBER: PTAR-SACR-285-SPRD 5

STATE OF CALIFORNIA							
41+83.4 R/L CHANGE	41+87.4 BEGIN DIRECTIONAL DRILL	41+88.3 END DIRECTIONAL DRILL	42+13.4 CL OF ROAD	42+27.4 EDGE OF PAVEMENT	42+28.4 END DIRECTIONAL DRILL	42+36.7 ROAD SOH 8.6M LT	42+44.5 R/L CHANGE
				42+99.7 POWER POLE 13.7M RT		43+47.5 POWER POLE 13.4M RT	
						43+54.5 CULVERT	43+58.5 CL OF CREEK
						43+63.8 CULVERT	
						44+02.8 POWER POLE 12.2M RT	

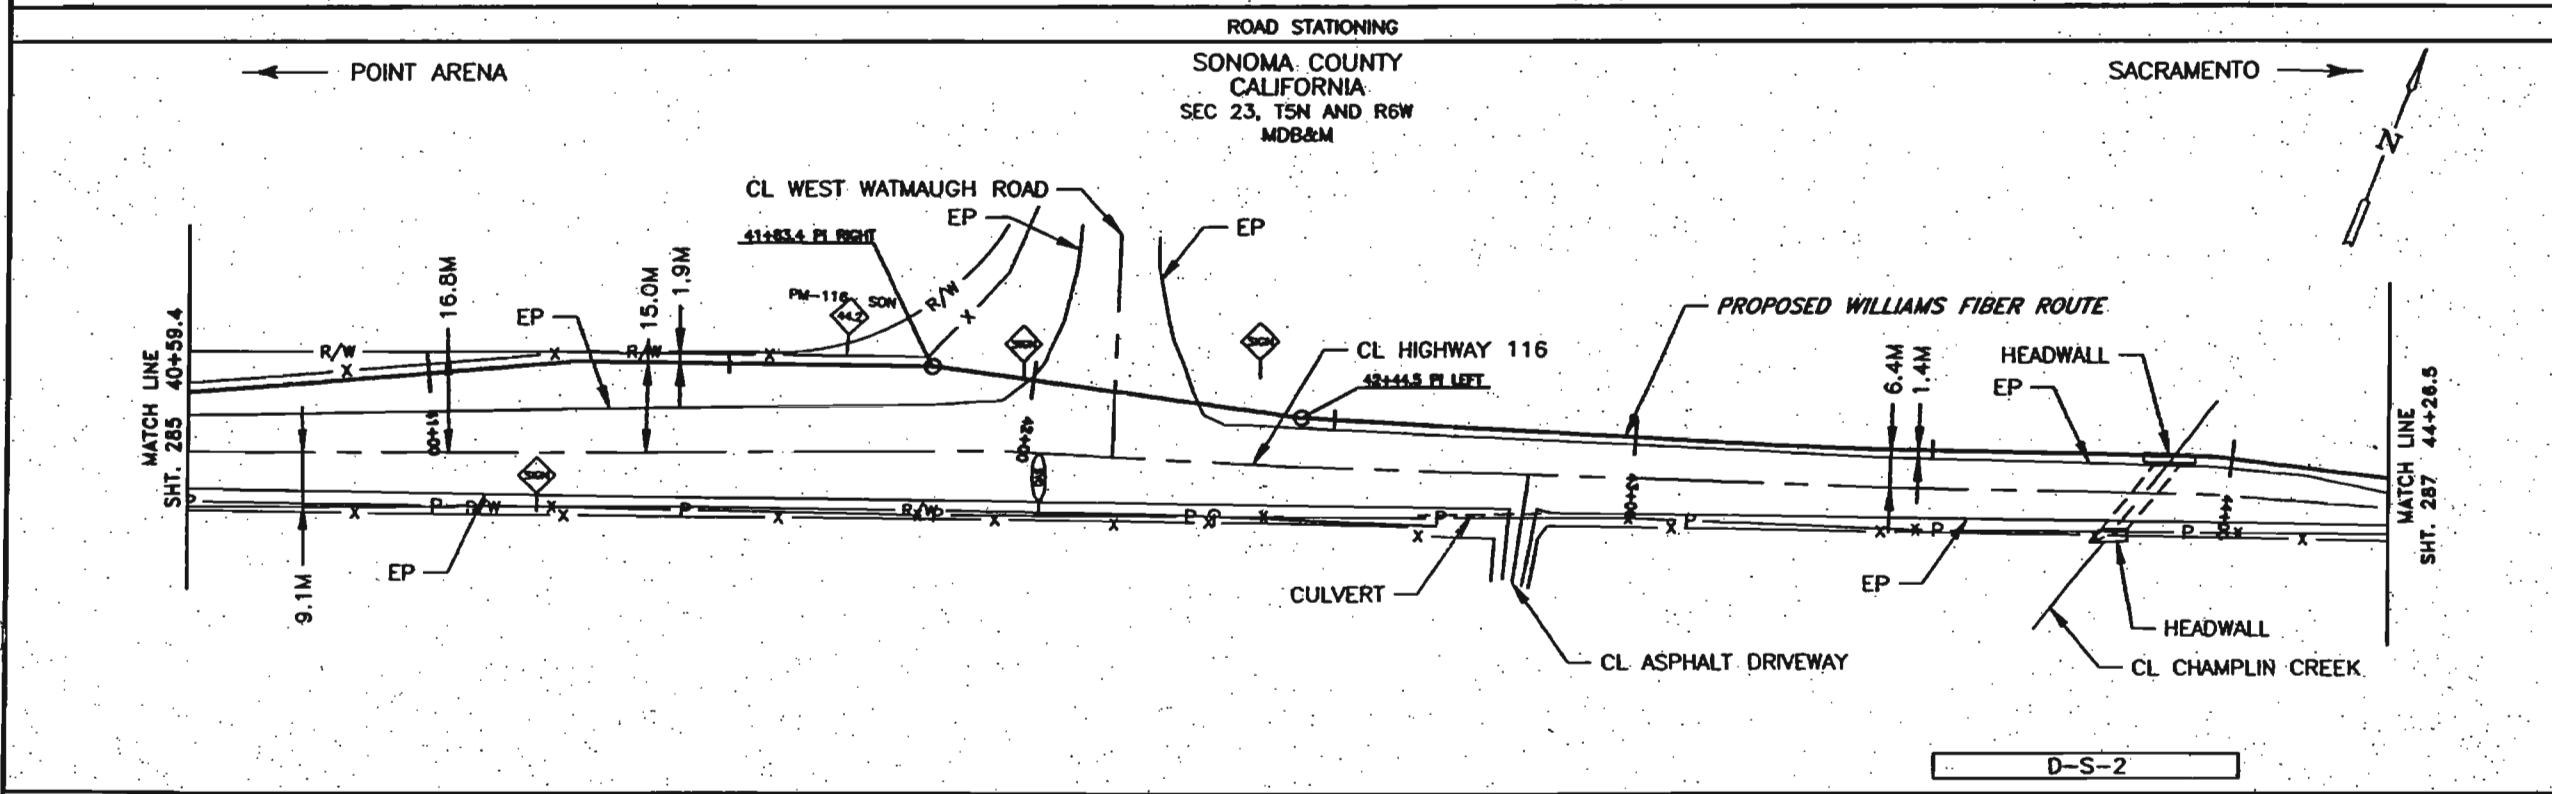

LEGEND	
Interstate Hwy.	Region Site
U.S. Hwy.	F.O.P./Jct.
State Hwy.	Handhole Splice
County Road	Handhole
RR Mile Mr.	Handhole Splice
Water Road Sign	Handhole
New Fiber Cable	SS Handhole
Township Line	Power Pole
City Limits	Water Valve / Meter
R/W Line	Gas Valve / Meter
River/Stream	Signal Pole
CL Road	Fire Hydrant
CL RR Tracks	Gas Marker
Fence	Oil Marker
Oil Pipeline	Oil Marker
Gas Pipeline	Fiber Marker
Power Line	Water Inlet
San. Sewer	
Storm Drain	
Telephone Line	
BLP.	Black Iron Pipe
CLP.	Galvanized Iron Pipe
EP	Edge of Pavement
ES	Edge of Ground
FC	Face of Curb
FL	Fog Line and/or White Line

WILLIAMS
EMERGENCY NOTIFICATION NUMBER
1-800-582-9089

CAUTION
WILLIAMS LOCATE # FOR
COUNTY, STATE
1-888-263-2283

FOREIGN UTILITY LOCATIONS ARE
APPROXIMATE. CONTACT THE LOCAL ONE
CALL AGENCY 48 HOURS PRIOR
TO CONSTRUCTION FOR EXACT
UTILITY LOCATIONS AT :
1-800-227-2600

40+59.4		44+26.5
---------	--	---------

96 - LEAF FIBER, LOOSE-BUFFER TUBE CABLE, 12 FIBERS PER TUBE, DIELECTRIC CENTRAL MEMBER, DUAL JACKET SINGLE ARMOR, 1000 LB TENSILE STRENGTH	
REEL # N/A	
N/A	
367.1M - 1-38mm ID HDPE, 1-38mm ID HDPE (SPARE), 1-32mm ID HDPE (SPARE)	

REVISIONS			
REV. NO.	DESCRIPTION	BY	DATE
0	PERMIT	KSH	01/14

COMMUNICATIONS GROUP
Network Services


**POINT ARENA TO SACRAMENTO
CABLE ROUTE**

DRAWN BY : SAM	DATE : 06/04/00
CHECKED BY : KSH	DATE : 06/05/00
APPROVED BY :	DATE :
APPROVED BY :	DATE :

A/E : 4073 LOC. CODE : 000001

HORIZONTAL SCALE (DWG & PROF) : 1:30.5
VERTICAL SCALE (DWG) : 1:30.5
VERTICAL SCALE (PROF) : 1:30.5
MAP PROJECTION : MAP-PROJECTION

DRAWING NUMBER : PTAR-SACR-286-SPRD 5

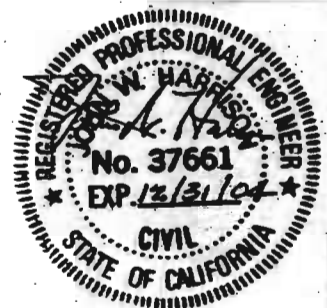

OWNERSHIP

SONOMA COUNTY

44+88.7 ROAD SON 0.3M LT

44+87.2 ROAD SON 4.2M LT

44+88.0 ROAD SON 8.2M RT

45+00.7 POWER POLE 8.3M RT

45+71.3 PLACE MANHOLE

45+88.0 EDGE OF PAVEMENT

45+92.9 ROAD SON 7.4M RT

46+00.8 GUY WIRE 8.3M RT

46+06.6 POWER POLE 0.5M LT

46+07.9 POWER POLE 7.8M RT

46+28.1 EDGE OF PAVEMENT

46+33.9 ROAD SON 4.8M LT

46+46.3 GUY WIRE 0.2M RT

46+46.3 POWER POLE 0.2M LT

46+46.8 GUY WIRE 2.9M LT

46+82.1 POWER POLE 9.2M RT

46+88.6 GUY WIRE 9.1M RT

47+10.4 POWER POLE 6.2M LT

47+17.2 ROAD SON 8.8M RT


47+38.3 POWER POLE 9.8M RT

ROAD STATIONING
SONOMA COUNTY
CALIFORNIA
SEC 23, T5N AND R6W
MDB&M

POINT ARENA

SACRAMENTO

D/R-SONOMA-1

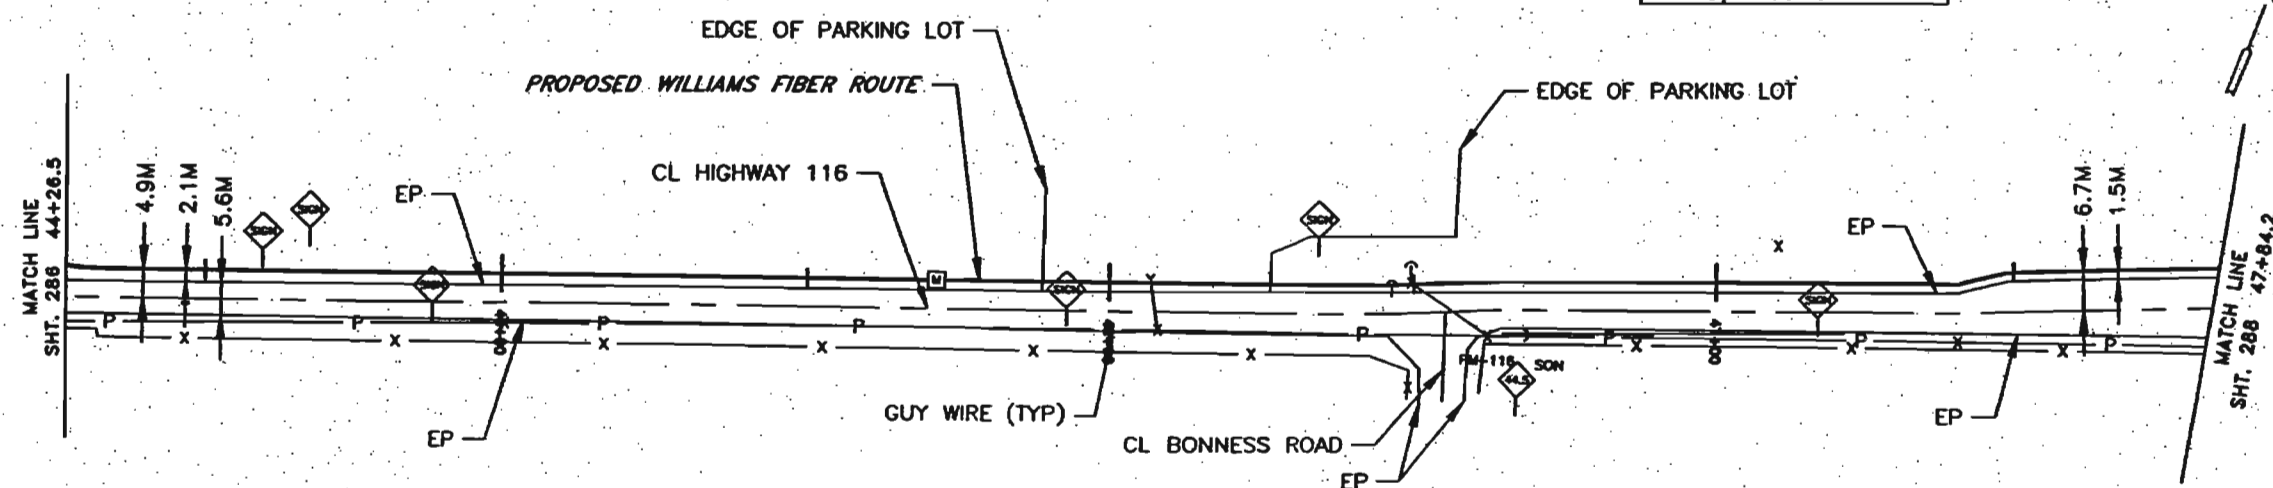

*NOTE: NO CALTRANS R/W
INFORMATION AVAILABLE

LEGEND

- Interstate Hwy
- U.S. Hwy
- State Hwy
- County Road
- RR Mile Mr.
- Min. Road Sign
- New Fiber Cable
- Telephone Line
- City Limits
- R/W Line
- River/Stream
- CL Road
- CL RR Tracks
- Fence
- CR Pipeline
- Gas Pipeline
- Power Line
- Water Line
- Son. Street
- Storm Drain
- Telephone Line
- Break into Pipe
- CL.P. Culminated into Pipe
- EP Edge of Pavement
- ES Edge of Shoulder
- FC Face of Curb
- FL Fog Line and/or White Line
- Regen Site
- P.O.P./Jct.
- Manhole Splice
- Manhole
- Manhole Splice
- SS Manhole
- Power Pole
- Water Valve / Meter
- Gas Valve / Meter
- Signal Pole
- Pole Hydrant
- Gas Marker
- CR Marker
- Fiber Marker
- Water Inlet

WILLIAMS

EMERGENCY NOTIFICATION NUMBER
1-800-582-9089

CAUTION

WILLIAMS LOCATE # FOR
COUNTY, STATE
1-888-265-2283
FOREIGN UTILITY LOCATIONS ARE
APPROXIMATE. CONTACT THE LOCAL ONE
CALL AGENCY 48 HOURS PRIOR
TO CONSTRUCTION FOR EXACT
UTILITY LOCATIONS AT :
1-800-227-2600

REVISIONS

REV. NO.	DESCRIPTION	BY	DATE
0	PERMIT	KCN	11/14

96 - LEAF FIBER, LOOSE BUFFER TUBE CABLE, 12 FIBERS PER TUBE, DIELECTRIC CENTRAL MEMBER, DUAL JACKET SINGLE ARMOR, 1000 LB TENSILE STRENGTH

REEL # N/A

N/A

357.7M - 1-38mm ID HDPE, 1-38mm ID HDPE (SPARE), 1-32mm ID HDPE (SPARE)

CABLE FIBER COUNT MFL TYPE OF GLASS	CABLE
CABLE REEL NO.	DESCRIPTION
SPLICE TO SPLICE CABLE LENGTH & COIL LENGTH	
SHIELDING & TYPE (CONC/SHIELD/COLOR)	PIPE & SHIELDING
STEEL PIPE SIZE	
PVC	
FUTURE-2	FUTURE
FUTURE-3	USE
FUTURE-4	PLACE




COMMUNICATIONS GROUP
Network Services

POINT ARENA TO SACRAMENTO
CABLE ROUTE

DRAWN BY : MFW	DATE : 06/04/00
CHECKED BY : KCB	DATE : 06/06/00
APPROVED BY :	DATE :
APPROVED BY :	DATE :
AFE : 4875	LIC. CODE : 600004
HORIZONTAL SCALE (HWS & PROF) :	1:30.5
VERTICAL SCALE (HWS) :	1:30.5
VERTICAL SCALE (PROF) :	1:30.5
MAP PROJECTION :	MAP-PROJECTION
DRAWING NUMBER :	PTAR-SACR-287-SPRD 5

REV-0

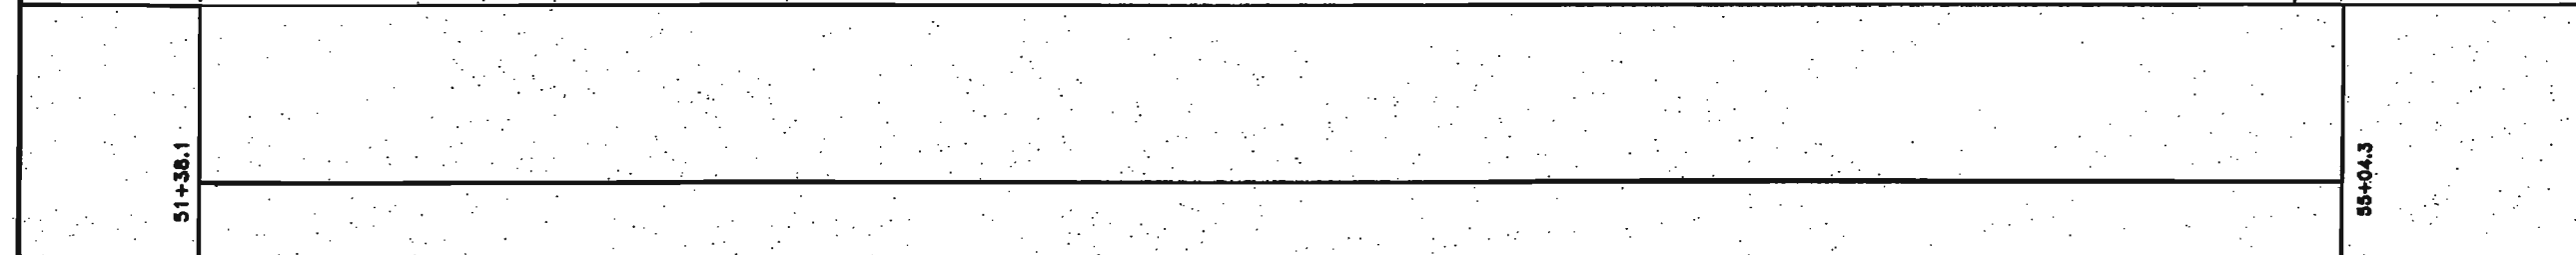

96	- LEAF FIBER, LOOSE BUFFER TUBE CABLE, 12 FIBERS PER TUBE, DIELECTRIC CENTRAL MEMBER, DUAL JACKET SINGLE ARMOR, 1000 LB TENSILE STRENGTH
	REEL # N/A
	N/A
	366.2M - 1-38mm ID HDPE, 1-38mm ID HDPE (SPARE), 1-32mm ID HDPE (SPARE)

LEGEND

 Interstate Hwy.	 Rights Site
 U.S. Hwy.	 P.D./Jct.
 State Hwy.	 Hardshale Spillins
 County Road	 Hardshale
 RR Mile Marker	 Hardshale Spillins
 Mtn. Road Sign	 Hardshale
 New Fire Cuts	 SS Hardshale
 Tunnel Line	 Power Pole
 City Limits	 Water Valve / Water
 R/W Line	 Gas Valve / Water
 River/Stream	 Signal Pole
 CL Road	 Fire Hydrant
 CL RR Tracks	 Gas Marker
 Fences	 Oil Marker
 Oil Pipeline	 Oil Marker
 Gas Pipeline	 Fiber Marker
 Power Line	 Water Inlet
 Water Line	
 San. Sewer	
 Storm Drain	
 Telephone Line	
 Black Iron Pipe	
 Galvanized Iron Pipe	
 Edge of Pavement	
 Edge of Gravel	
 Face of Cut	
 Fog Line and/or White Line	

WILLIAMS
EMERGENCY NOTIFICATION NUMBER
1-800-582-9069

CAUTION

**WILLIAMS LOCATE # FOR
COUNTY, STATE
1-800-283-2283**



**FOREIGN UTILITY LOCATIONS ARE
APPROXIMATE. CONTACT THE LOCAL ONE
CALL AGENCY 48 HOURS PRIOR
TO CONSTRUCTION FOR EXACT
UTILITY LOCATIONS AT :**

1-800-227-2600

[illegible]

CABLE FIBER COUNT MFG. TYPE OF GLASS		
CABLE SERIAL NO.		CABLE DESCRIPTION
SPlice TO SPlice CABLE LENGTH & CBL. LENGTH		
INNERJECT & TYPE (CORN/SHOOT/COLD)		PIPE &
STEEL PIPE SIZE		INNERJECT PLACEMENT
PVC		
FUTURE-2		
FUTURE-3		FUTURE PIPE PLACE
FUTURE-4		

		COMMUNICATIONS GROUP Network Services	
POINT ARENA TO SACRAMENTO CABLE ROUTE			
DRAWN BY : MTW		DATE : 08/04/90	
CHECKED BY : KGB		DATE : 08/04/90	
APPROVED BY :		DATE :	
APPROVED BY :		DATE :	
AFE : 4575		LOC. CODE : 000001	
HORIZONTAL SCALE (HWS & PSW) :		1:20.5	
VERTICAL SCALE (VWS) :		1:30.5	
VERTICAL SCALE (VPS) :		1:30.5	
MAP PROJECTION : MAP-PROJECTION			
DRAWING NUMBER : PTAR-SACR-289-SPRD 5			

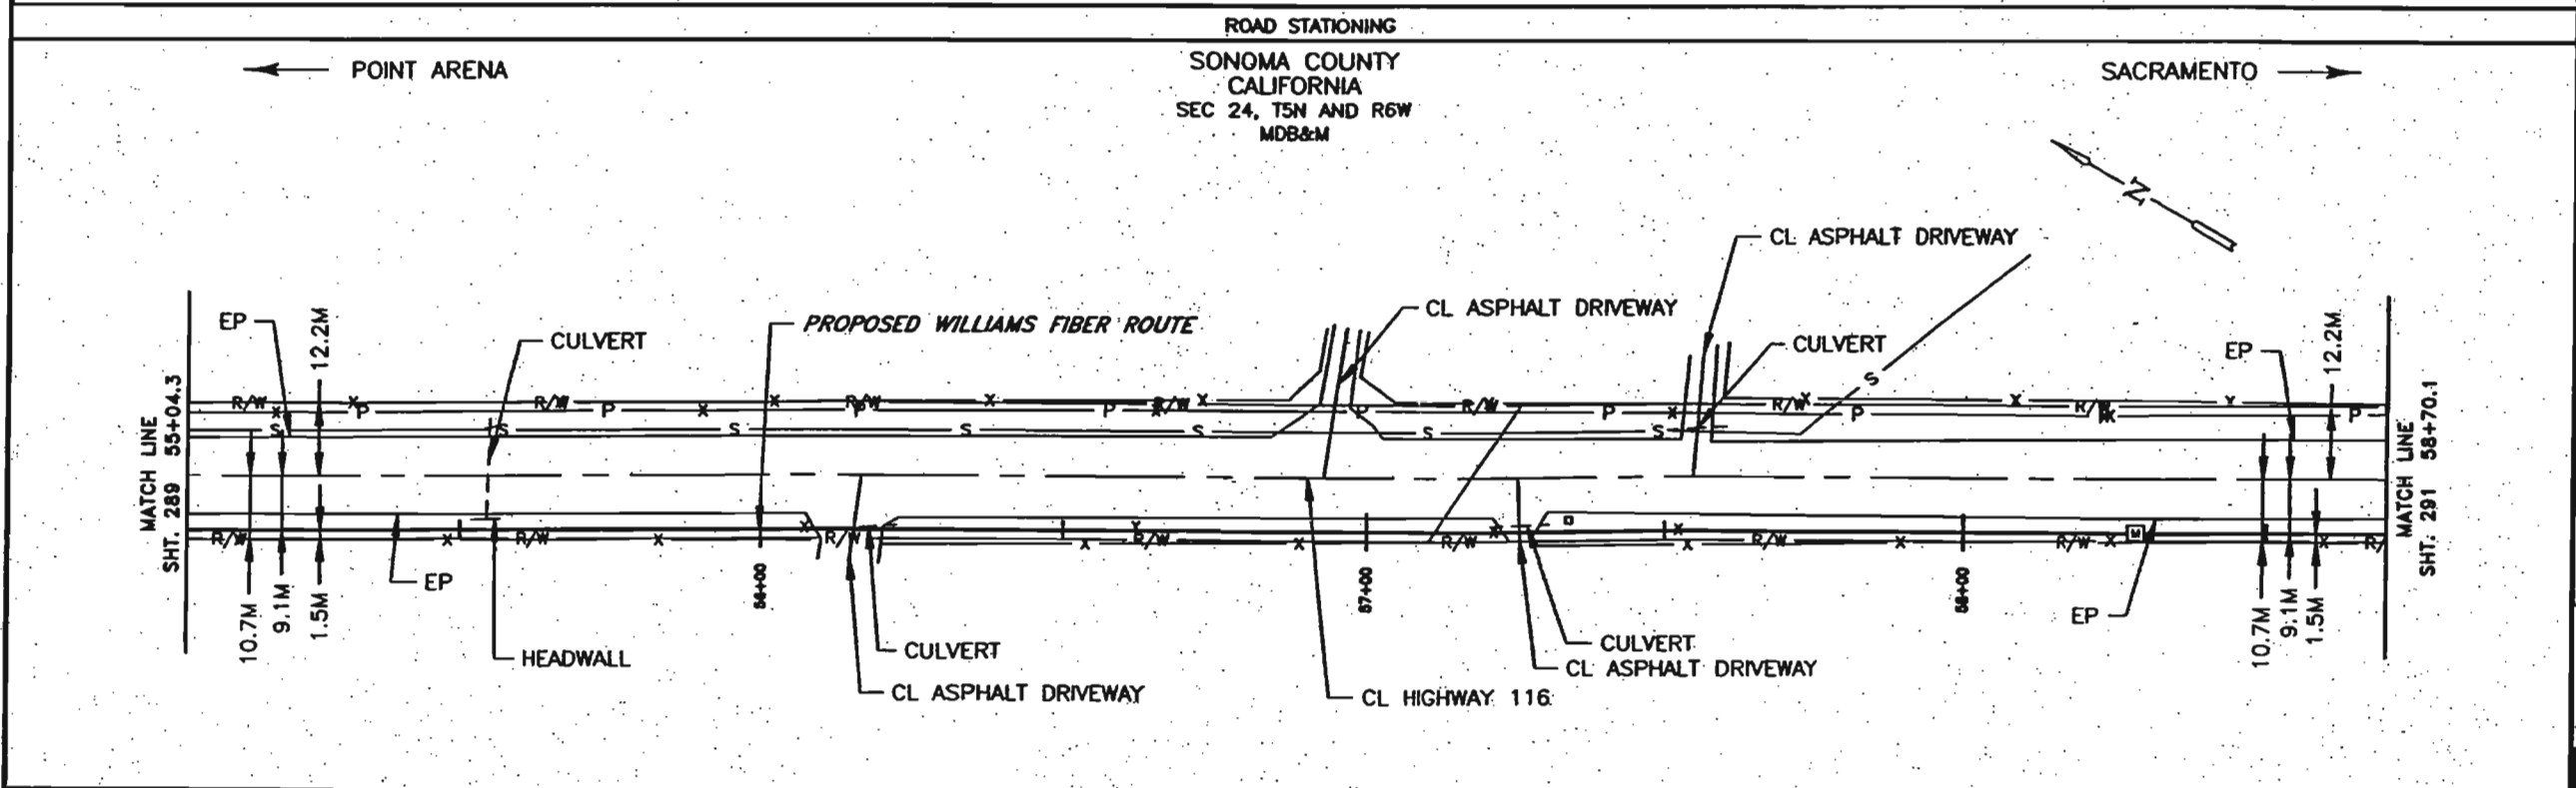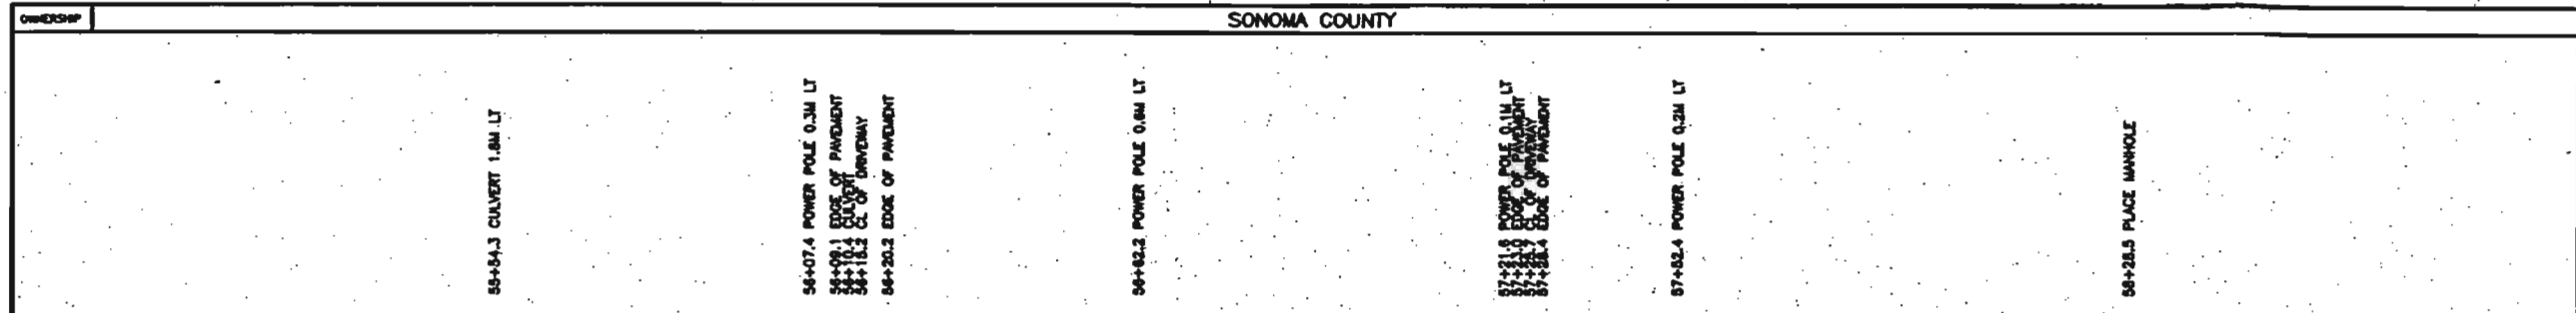

LEGEND

44	Interstate Hwy.	2	Regen Site
54	U.S. Hwy.	3	P.O.P./Jct.
1	State Hwy.	5	Handhole Splice
4	County Road	10	Handhole
4	RR Mile Mkr.	11	Handhole Splice
4	Misc. Road Sign	12	Handhole
	New Fiber Cable	13	SS Handhole
	Yardstick Line	14	Power Pole
	City Limits	15	Water Valve / Meter
	R/W Line	16	Gas Valve / Meter
	River/Stream	17	Signal Pole
	CL Road	18	Fire Hydrant
	CL RR Tracks	19	Gas Marker
	CL Pipeline	20	Oil Marker
	Power Line	21	Fiber Marker
	Water Line	22	Water Inlet
	San. Sewer		
	Storm Drain		
	Telephone Line		
BLP	Black Iron Pipe		
CLP	Corrugated Iron Pipe		
EP	Edge of Pavement		
EG	Edge of Gravel		
FC	Face of Curb		
FL	Fog Line and/or White Line		

WILLIAMS
EMERGENCY NOTIFICATION NUMBER
1-800-582-9069

CAUTION
WILLIAMS LOCATE # FOR COUNTY, STATE
1-888-265-2283

FOREIGN UTILITY LOCATIONS ARE APPROXIMATE. CONTACT THE LOCAL ONE CALL AGENCY 48 HOURS PRIOR TO CONSTRUCTION FOR EXACT UTILITY LOCATIONS AT :
1-800-227-2600

55+04.3		58+70.1
---------	--	---------

96 -- LEAF FIBER, LOOSE BUFFER TUBE CABLE, 12 FIBERS PER TUBE, DIELECTRIC CENTRAL MEMBER, DUAL JACKET SINGLE ARMOR, 1000 LB TENSILE STRENGTH	
REEL # N/A	
N/A	
365.8M -- 1-38mm ID HDPE, 1-38mm ID HDPE (SPARE), 1-32mm ID HDPE (SPARE)	

REVISIONS			
REV. NO.	DESCRIPTION	BY	DATE
0	PERMIT	KSM	11/14




CABLE FIBER CORD MFG. TYPE OF GLASS	
CABLE REEL NO.	
SPICE TO SPICE CABLE LENGTH & COIL LENGTH	
DIRECTORY & TYPE (CONC./WOOD/COLOR)	
STEEL PIPE SIZE	
PVC	
FUTURE-2	
FUTURE-3	
FUTURE-4	



COMMUNICATIONS GROUP
Network Services

POINT ARENA TO SACRAMENTO CABLE ROUTE

DRAWN BY : MTD	DATE : 09/06/00
CHECKED BY : KSM	DATE : 09/06/00
APPROVED BY : KSM	DATE :
APPROVED BY : KSM	DATE :
DATE : 09/06/00	LOC. CODE : 090001
HORIZONTAL SCALE (DWG & PROF) : 1:30.3	
VERTICAL SCALE (DWG) : 1:30.3	
VERTICAL SCALE (PROF) : 1:30.3	
MAP PROJECTION : MAP-PROJECTION	
DRAWING NUMBER : PTAR-SACR-290-SPRD 5	

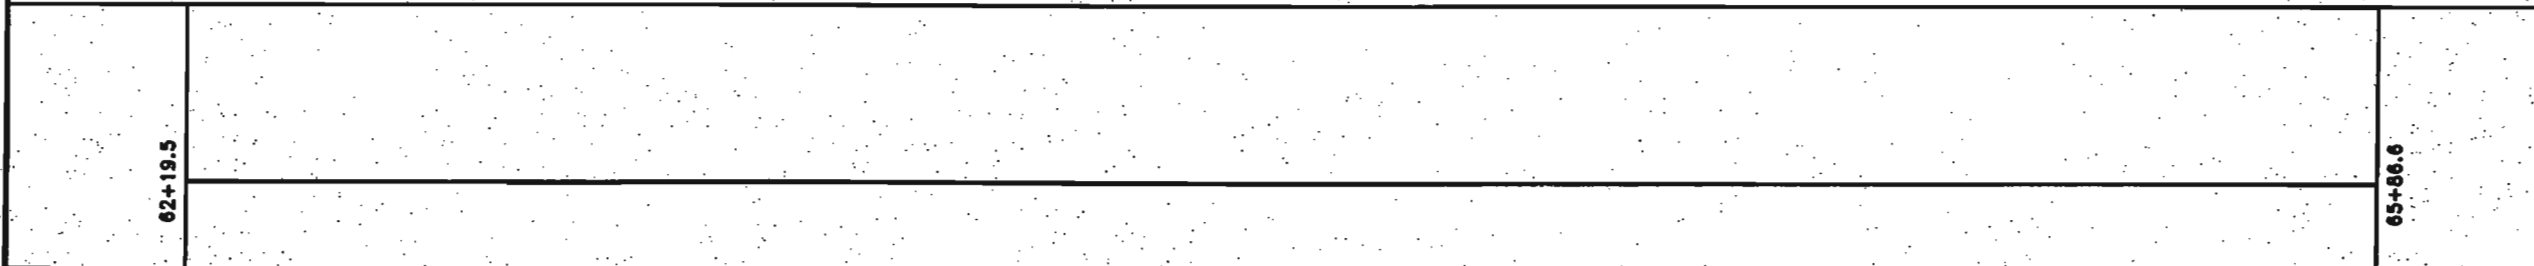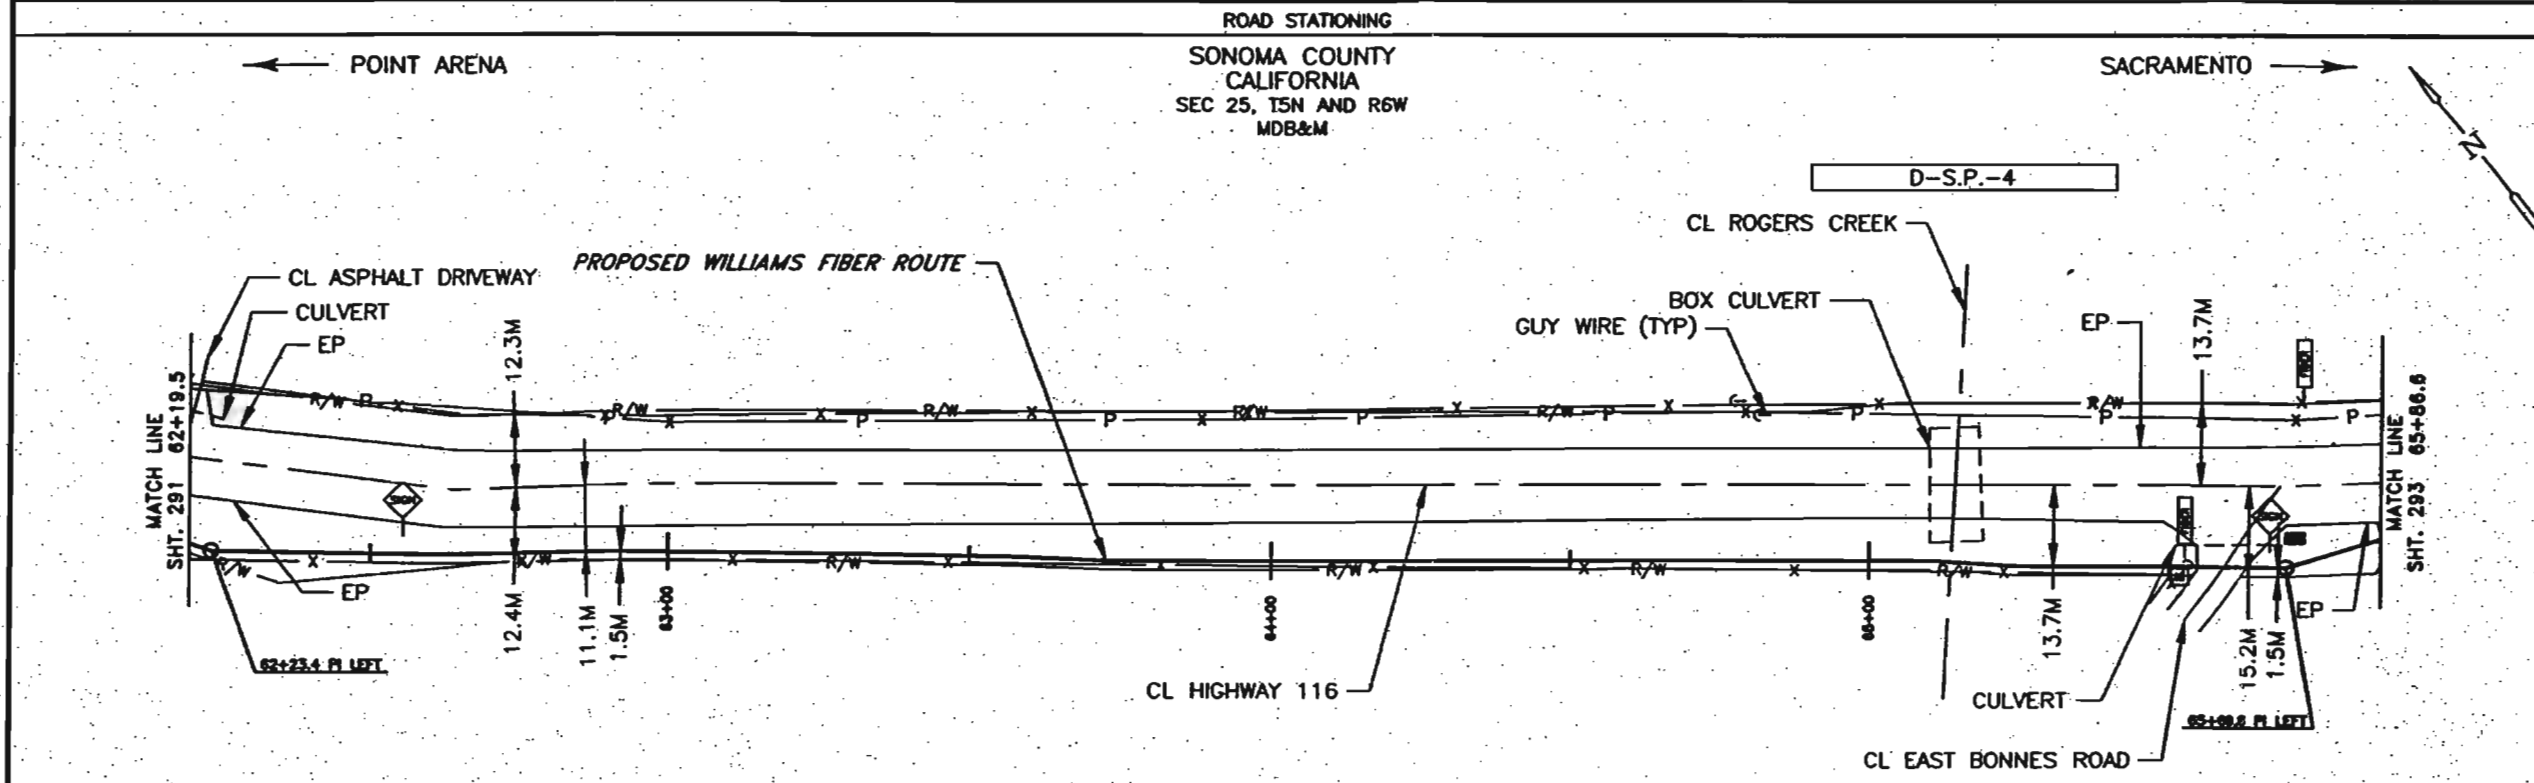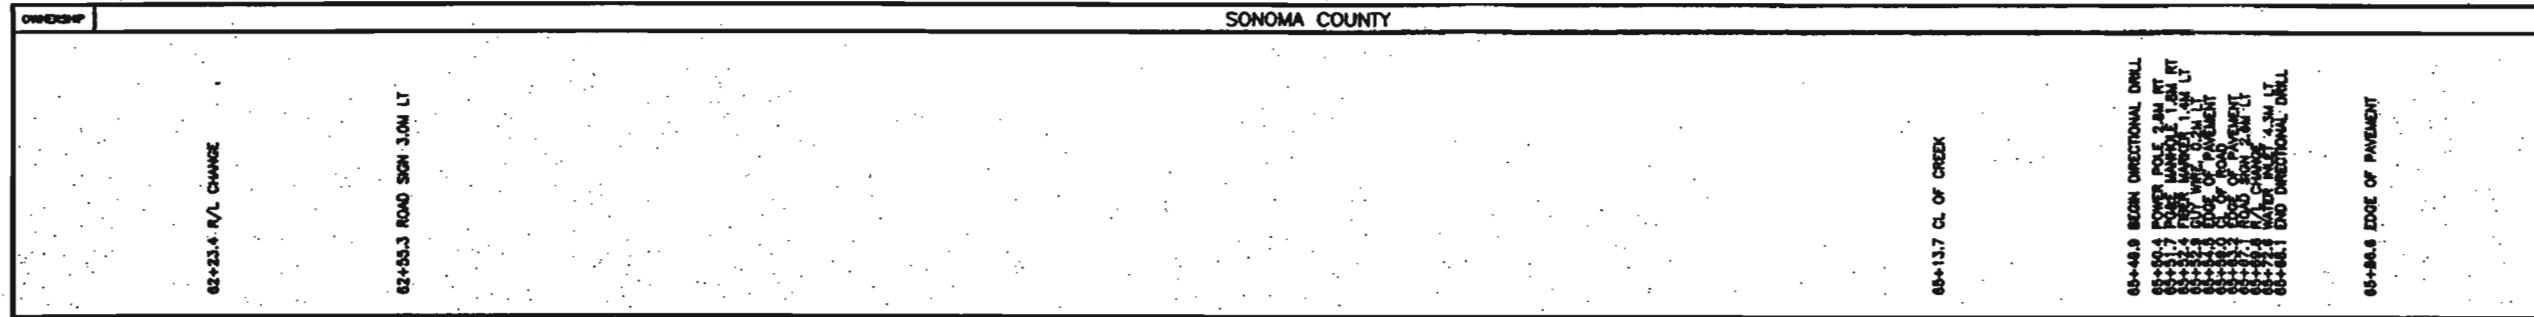

LEGEND

Interstate Hwy	Region Site
U.S. Hwy	P.O.P./Jct.
State Hwy	Handhole Splice
County Road	Handhole
RR	Handhole Splice
Min. Road Sign	Handhole
New Fiber Cable	SS Handhole
Township Line	Power Pole
City Limits	Water Valve / Meter
R/W Line	Gas Valve / Meter
Road/Stream	Signal Pole
CL Road	Fire Hydrant
CL RR Tracks	Gas Marker
Fence	Oil Marker
Oil Pipeline	Oil Marker
Gas Pipeline	Fiber Marker
Power Line	Water Inlet
Sew. Sewer	
Storm Drain	
Telephone Line	
Black Iron Pipe	
Galvanized Iron Pipe	
Edge of Pavement	
Edge of Gravel	
Face of Curb	
Fog Line and/or White Line	

WILLIAMS
EMERGENCY NOTIFICATION NUMBER
1-800-582-9089


CAUTION
WILLIAMS LOCATE & FOR COUNTY, STATE
1-888-265-2283

FOREIGN UTILITY LOCATIONS ARE APPROXIMATE. CONTACT THE LOCAL ONE CALL AGENCY 48 HOURS PRIOR TO CONSTRUCTION FOR EXACT UTILITY LOCATIONS AT:
1-800-227-2600

REVISIONS

REV. NO.	DESCRIPTION	BY	DATE
0	PERMIT	KSH	11/14

CABLE FIBER COUNT MFG. TYPE OF GLASS	CABLE DESCRIPTION
CABLE REEL NO.	
SPLICE TO SPLICE CABLE LENGTH & CABLE LENGTH	
UNDERBUILT & TYPE (CONC./WOOD/CLON)	PVE & UNDERBUILT PLACEMENT
STEEL PIPE SIZE	
PVC	
FUTURE-2	FUTURE USE PLACE
FUTURE-3	
FUTURE-4	

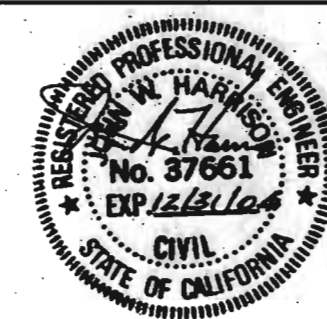



COMMUNICATIONS GROUP
Network Services

POINT ARENA TO SACRAMENTO CABLE ROUTE

DRAWN BY: WTW	DATE: 09/04/00
CHECKED BY: KSH	DATE: 09/04/00
APPROVED BY:	DATE:
APPROVED BY:	DATE:
DATE:	
DATE:	

MAP PROJECTION: MAP-PROJECTION

DRAWING NUMBER: PTAR-SACR-292-SPRD 5

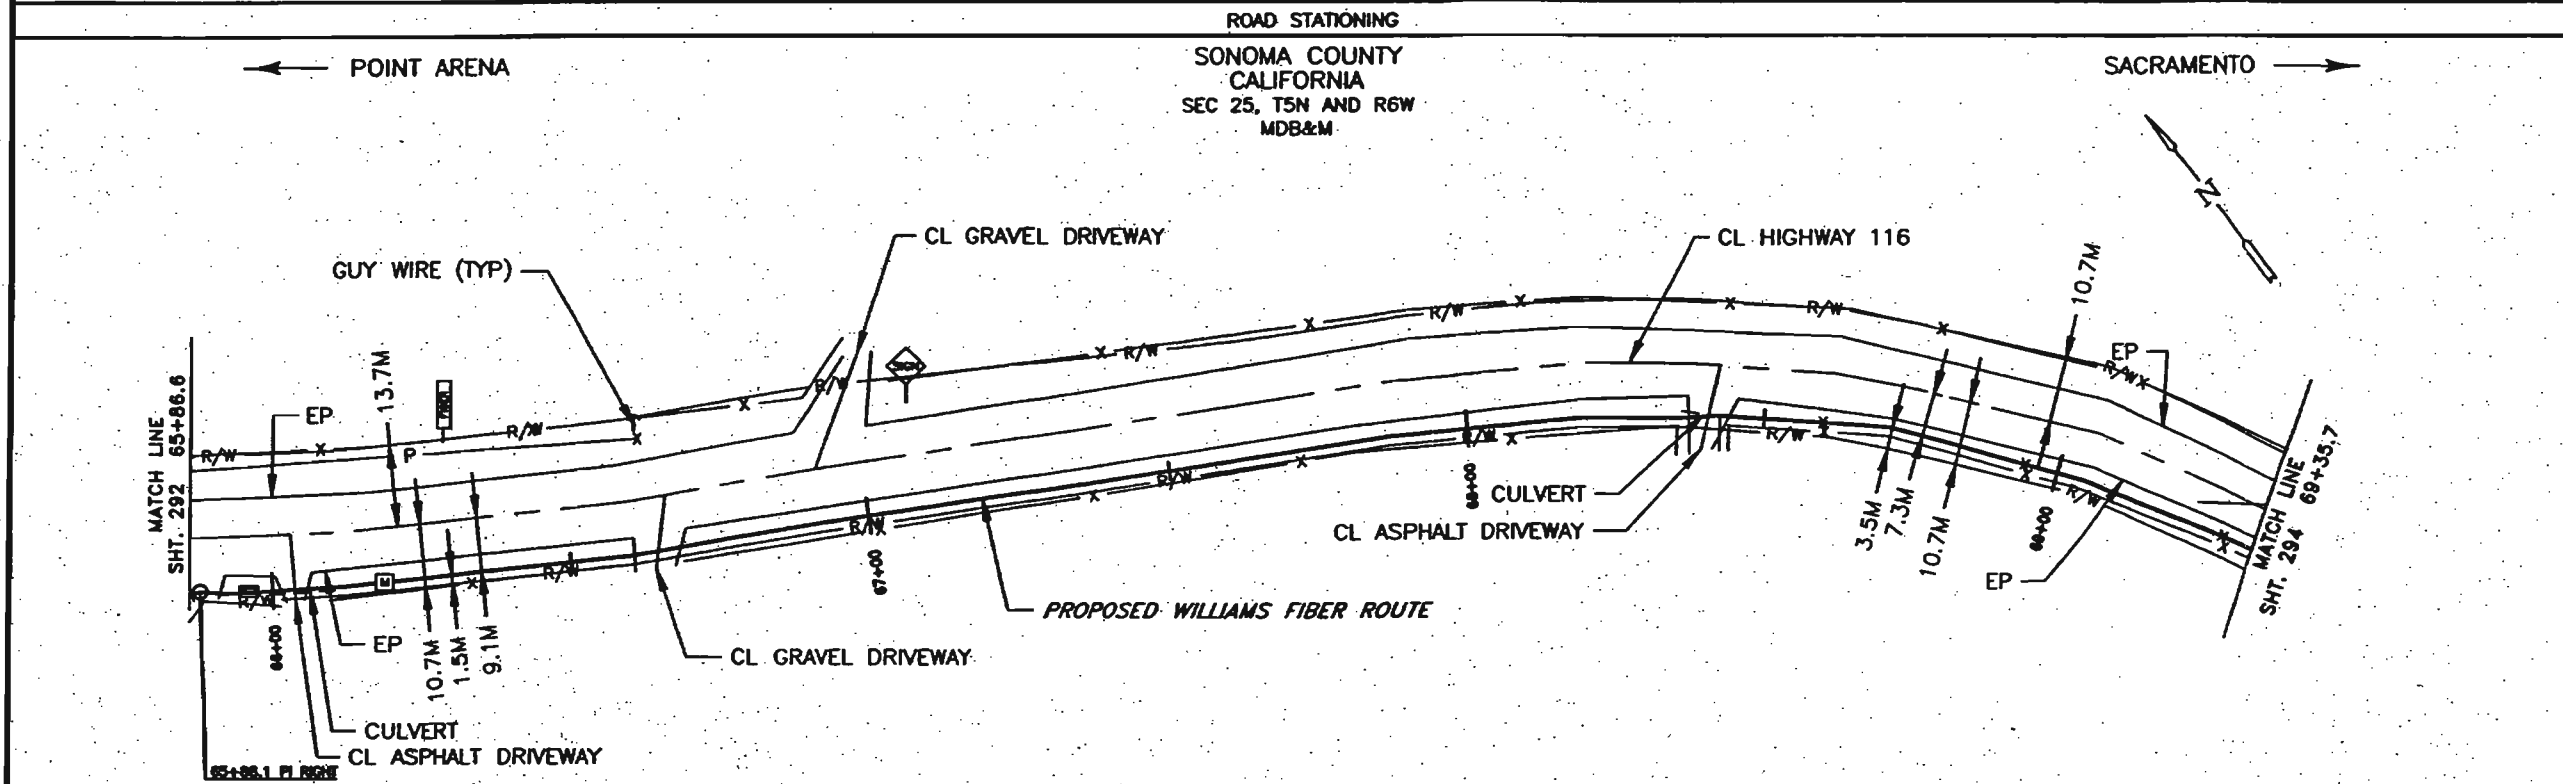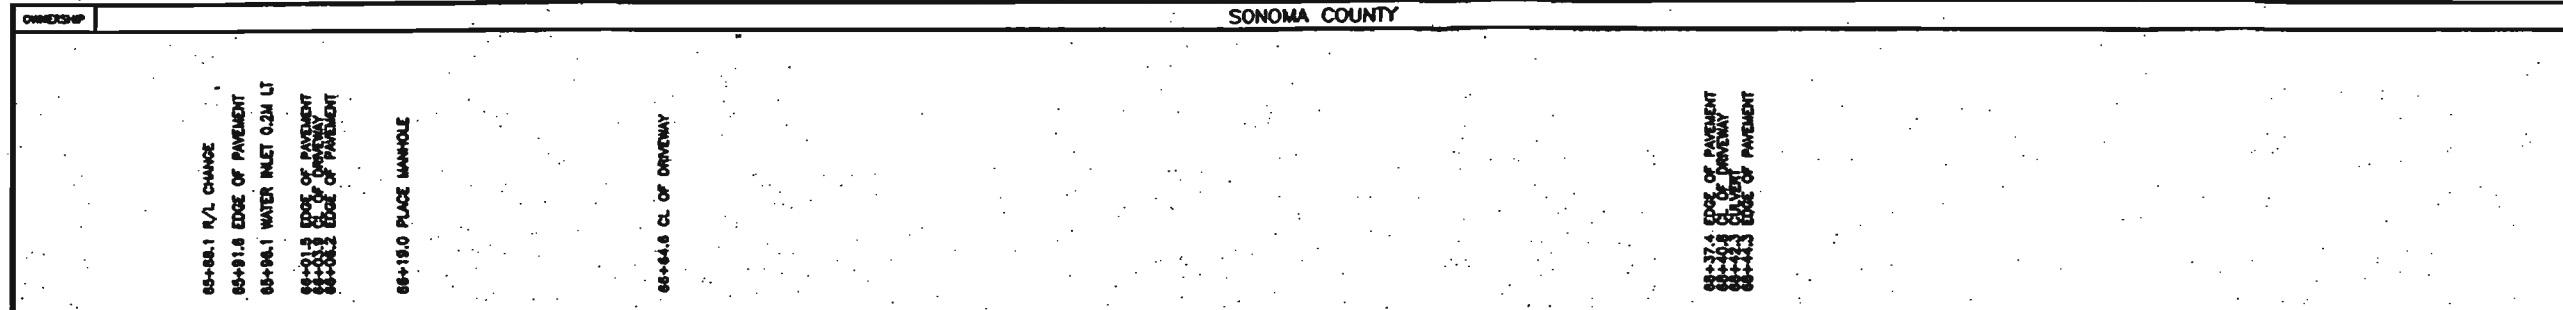

LEGEND

	Interstate Hwy.		Regen Site
	U.S. Hwy.		P.O.P./Jct.
	State Hwy.		Manhole Splice
	County Road		Manhole
	R/W Mile		Manhole Splice
	Mile Road Sign		Manhole
	New Fiber Cable		SS Manhole
	Township Line		Power Pole / Water
	City Limits		Water Valve / Water
	R/W Line		Gas Valve / Water
	River/Stream		Signal Pole
	CL Road		Fire Hydrant
	CL RR Tracks		Gas Marker
	Fence		Oil Marker
	Oil Pipeline		Water Inlet
	Gas Pipeline		
	Power Line		
	Water Line		
	San. Sewer		
	Storm Drain		
	Telephone Line		
	Blank Iron Pipe		
	Coated Iron Pipe		
	Edge of Pavement		
	Edge of Gravel		
	Face of Cutb		
	Flag Line and/or White Line		

WILLIAMS
EMERGENCY NOTIFICATION NUMBER
1-800-582-9069

CAUTION

**WILLIAMS LOCATE # FOR
COUNTY, STATE
1-888-285-2283**


**FOREIGN UTILITY LOCATIONS ARE
APPROXIMATE. CONTACT THE LOCAL ONE
CALL AGENCY 48 HOURS PRIOR
TO CONSTRUCTION FOR EXACT
UTILITY LOCATIONS AT :**


1-800-227-2600

[illegible]

CABLE FIBER COUNT INFO. TYPE OF GLASS	CABLE RECEIPT#
CABLE REEL NO.	
SPACE TO SPACE CABLE LENGTH & COIL LENGTH	PIPE & INSTRUMENT PLACEMENT
INSTRUMENT & TYPE (COLOR/SMOOTH/COLOR)	
STEEL PIPE SIZE	FUTURE PIPE PLACES
PVC	
FUTURE-2	
FUTURE-3	
FUTURE-4	

WTEC		COMMUNICATIONS GROUP Network Services	
POINT ARENA TO SACRAMENTO CABLE ROUTE			
DESIGNED BY :	MTW	DATE :	08/08/08
CHECKED BY :	KDB	DATE :	08/08/08
APPROVED BY :		DATE :	
APPROVED BY :		DATE :	
SITE :	4875	LOC. CODE :	004801
HORIZONTAL SCALE (HWS & PROJ) :		1:30.5	
VERTICAL SCALE (VWS) :		1:30.5	
VERTICAL SCALE (PROJ) :		1:30.5	
MAP PROJECTION : MAP-PROJECTION			
DRAWING NUMBER : PTAR-SACR-293-SPRD 5			

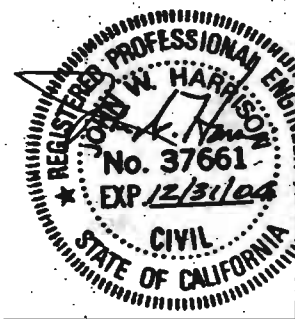

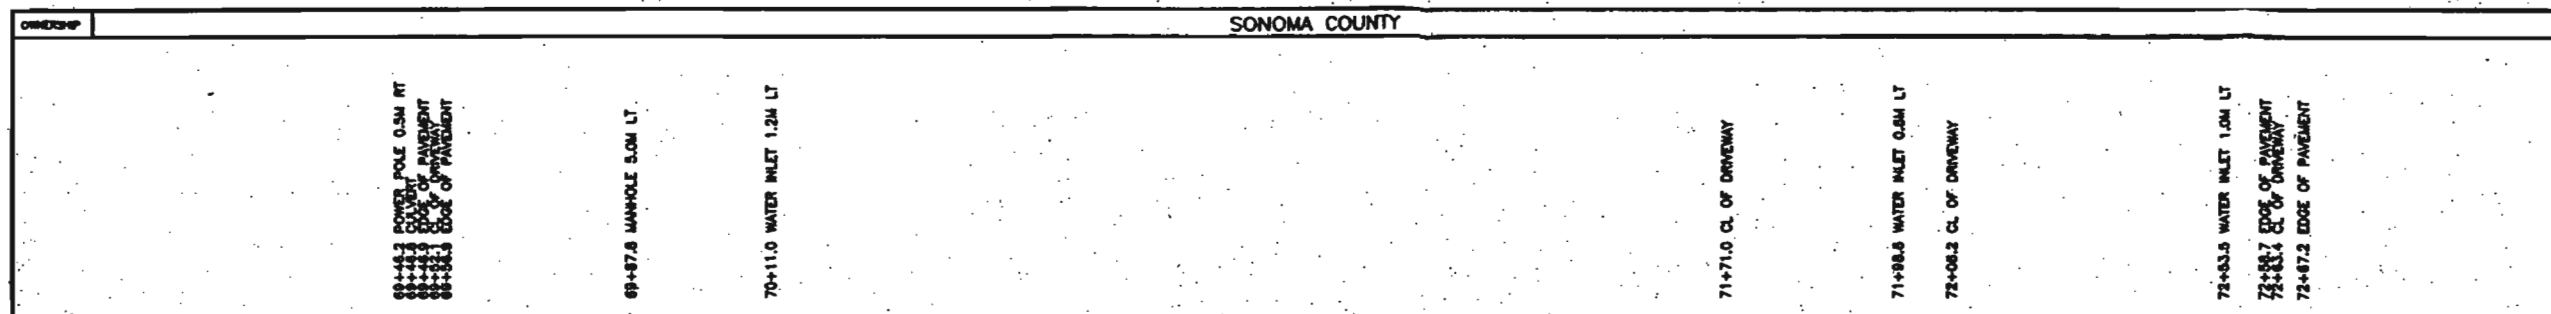


LEGEND	
Interstate Hwy.	Regen Site
U.S. Hwy.	P.O.P./Jct.
State Hwy.	Handhole Split
County Road	Handhole
RR Mls. Mtr.	Handhole Split
Min. Road Slip	25 Handhole
New Floor Cable	Power Pole
Trenching Line	Water Valve / Meter
City Limit	Gas Valve / Meter
R/W Line	Signal Pole
Road/Stream	Fire Hydrant
CL Road	Gas Marker
CL RR Tracks	Oil Marker
Fence	Oil Marker
Oil Pipeline	Fiber Marker
Gas Pipeline	Water Inlet
Power Line	
Water Line	
San. Sewer	
Storm Drain	
Telephone Line	
BLP	
ELP	
Submerged Iron Pipe	
Edge of Pavement	
ES	
Edge of Road	
FC	
Face of Cut	
FL	
Fog Line and/or White Line	

WILLIAMS
 EMERGENCY NOTIFICATION NUMBER
 1-800-582-9089

CAUTION
 WILLIAMS LOCATE & FOR
 COUNTY, STATE
 1-888-263-2283


FOREIGN UTILITY LOCATIONS ARE
 APPROXIMATE. CONTACT THE LOCAL ONE
 CALL AGENCY 48 HOURS PRIOR
 TO CONSTRUCTION FOR EXACT
 UTILITY LOCATIONS AT :
 1-800-227-2600

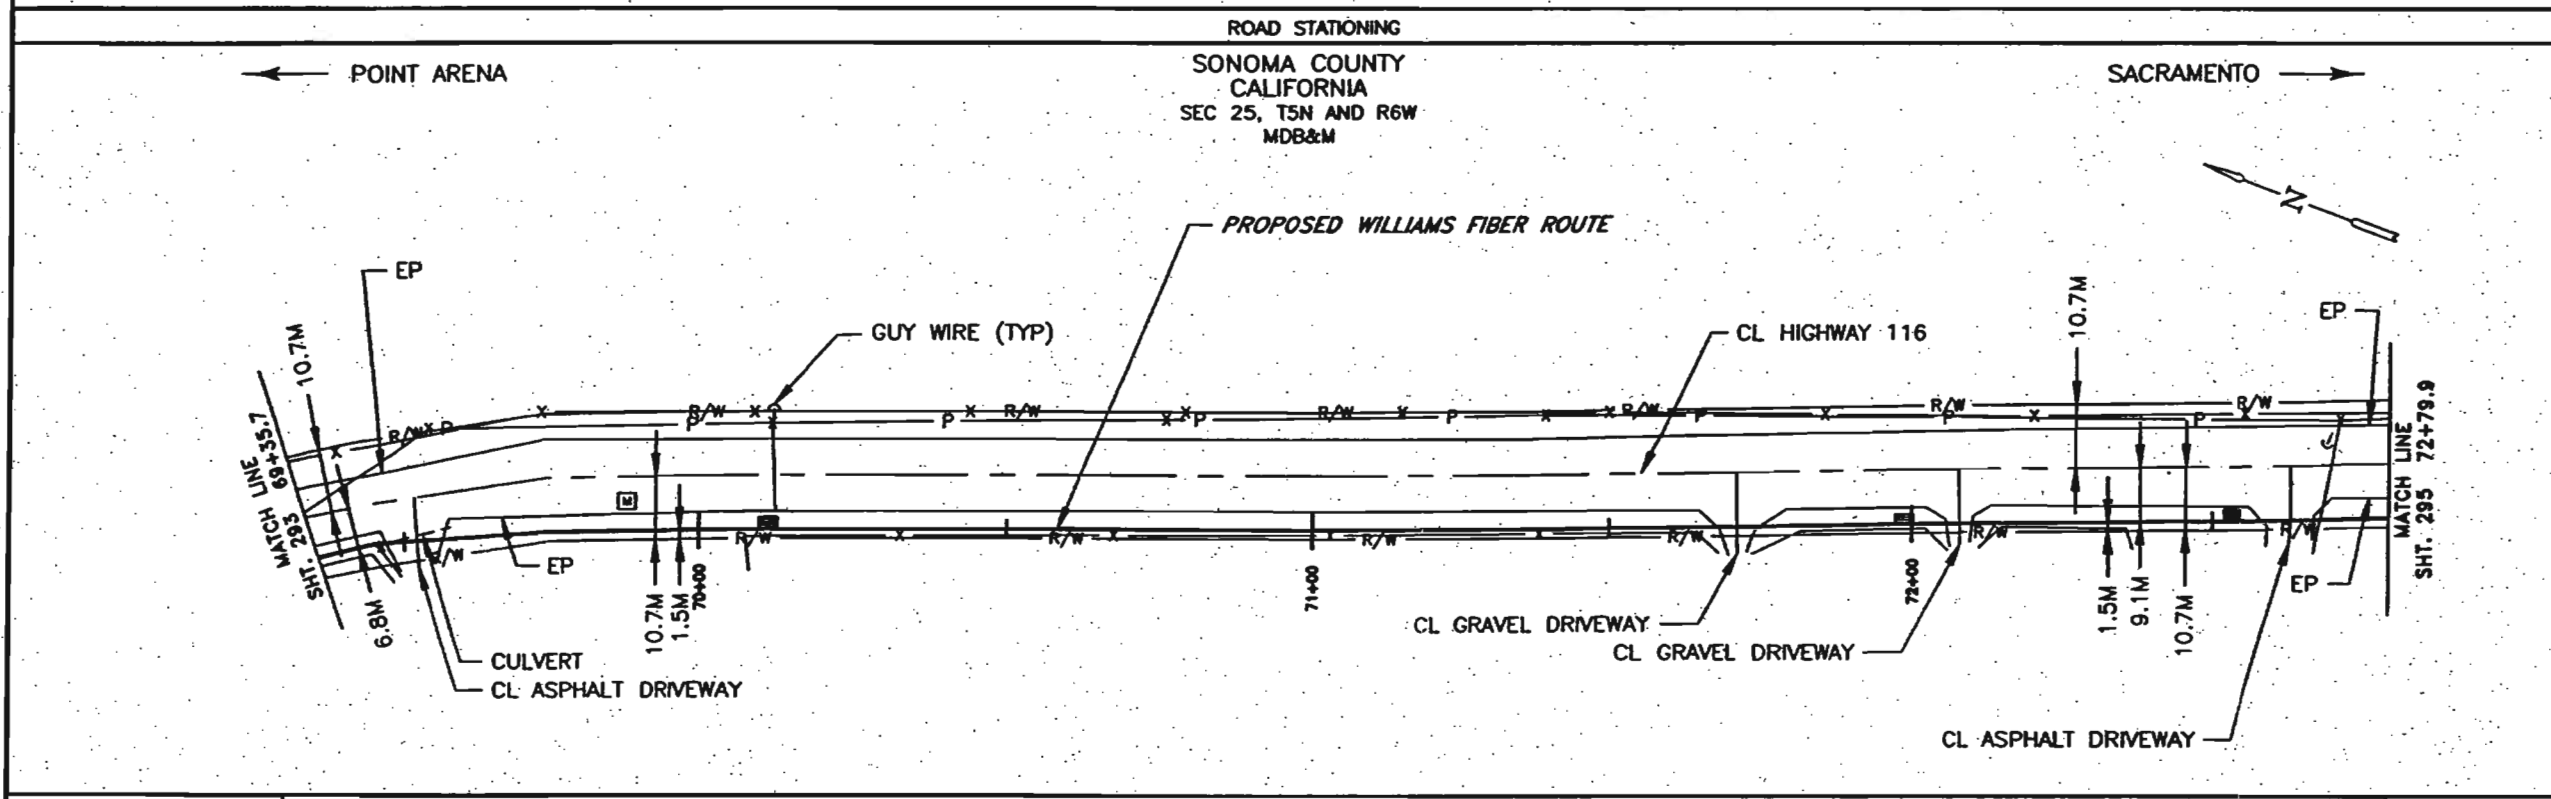

REVISIONS			
REV. NO.	DESCRIPTION	BY	DATE
0	PERMIT	KSH	01/24/04

69+35.7		72+79.9
---------	--	---------

96 - LEAF FIBER, LOOSE BUFFER TUBE CABLE, 12 FIBERS PER TUBE, DIELECTRIC CENTRAL MEMBER, DUAL JACKET SINGLE ARMOR, 1000 LB TENSILE STRENGTH	CABLE FIBER COUNT MFG. TYPE OF GLASS	CABLE
REEL # N/A	CABLE REEL NO.	DESCRIPTION
N/A	SPICE TO SPICE CABLE LENGTH & CABLE LENGTH	
344.2M - 1-38mm ID HDPE, 1-38mm ID HDPE (SPARE), 1-32mm ID HDPE (SPARE)	DIMENSION & TYPE (CONC./WOOD/COLOID)	PIPE &
	SHELL PIPE SIZE	APPROXIMATE
	PVC	PLACEMENT
	FUTURE-2	FUTURE
	FUTURE-3	USE
	FUTURE-4	PLACE

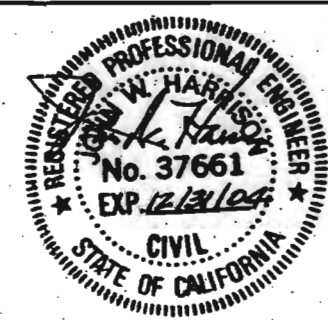

COMMUNICATIONS GROUP
 Network Services




POINT ARENA TO SACRAMENTO CABLE ROUTE

DRAWN BY : AJ	DATE : 06/04/00
CHECKED BY : KSH	DATE : 06/06/00
APPROVED BY :	DATE :
APPROVED BY :	DATE :

APE : 2875 LOC. CODE : 000001

HORIZONTAL SCALE (PUB & PROF) : 1:30.3
 VERTICAL SCALE (PUB) : 1:30.3
 VERTICAL SCALE (PROF) : 1:30.3
 MAP PROJECTION : NAD-PROJECTION

DRAWING NUMBER : PTAR-SACR-294-SPRD 5

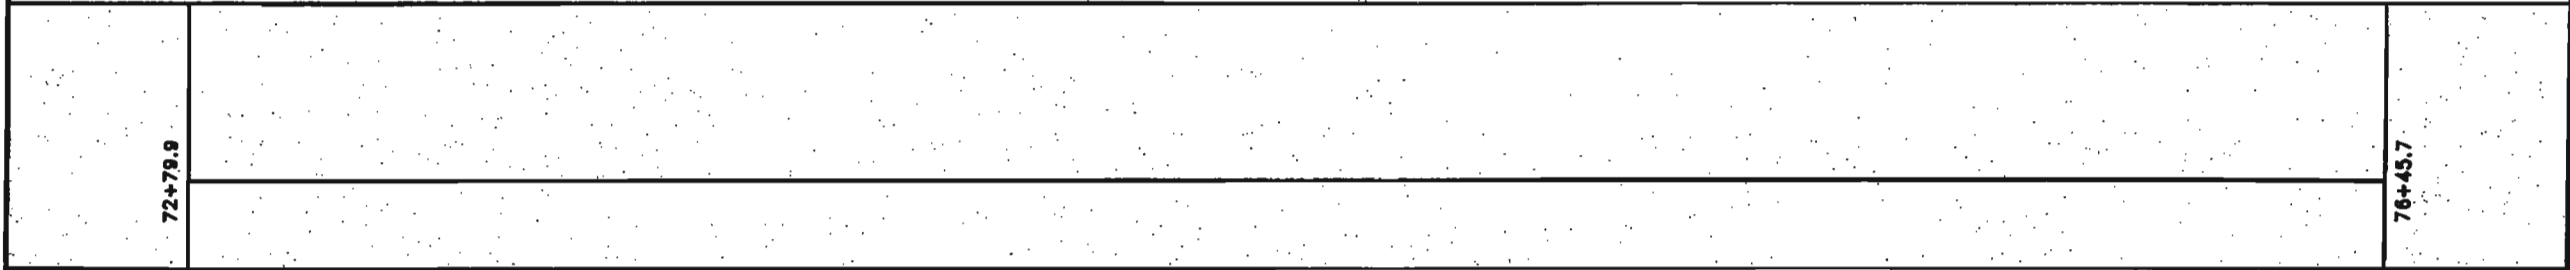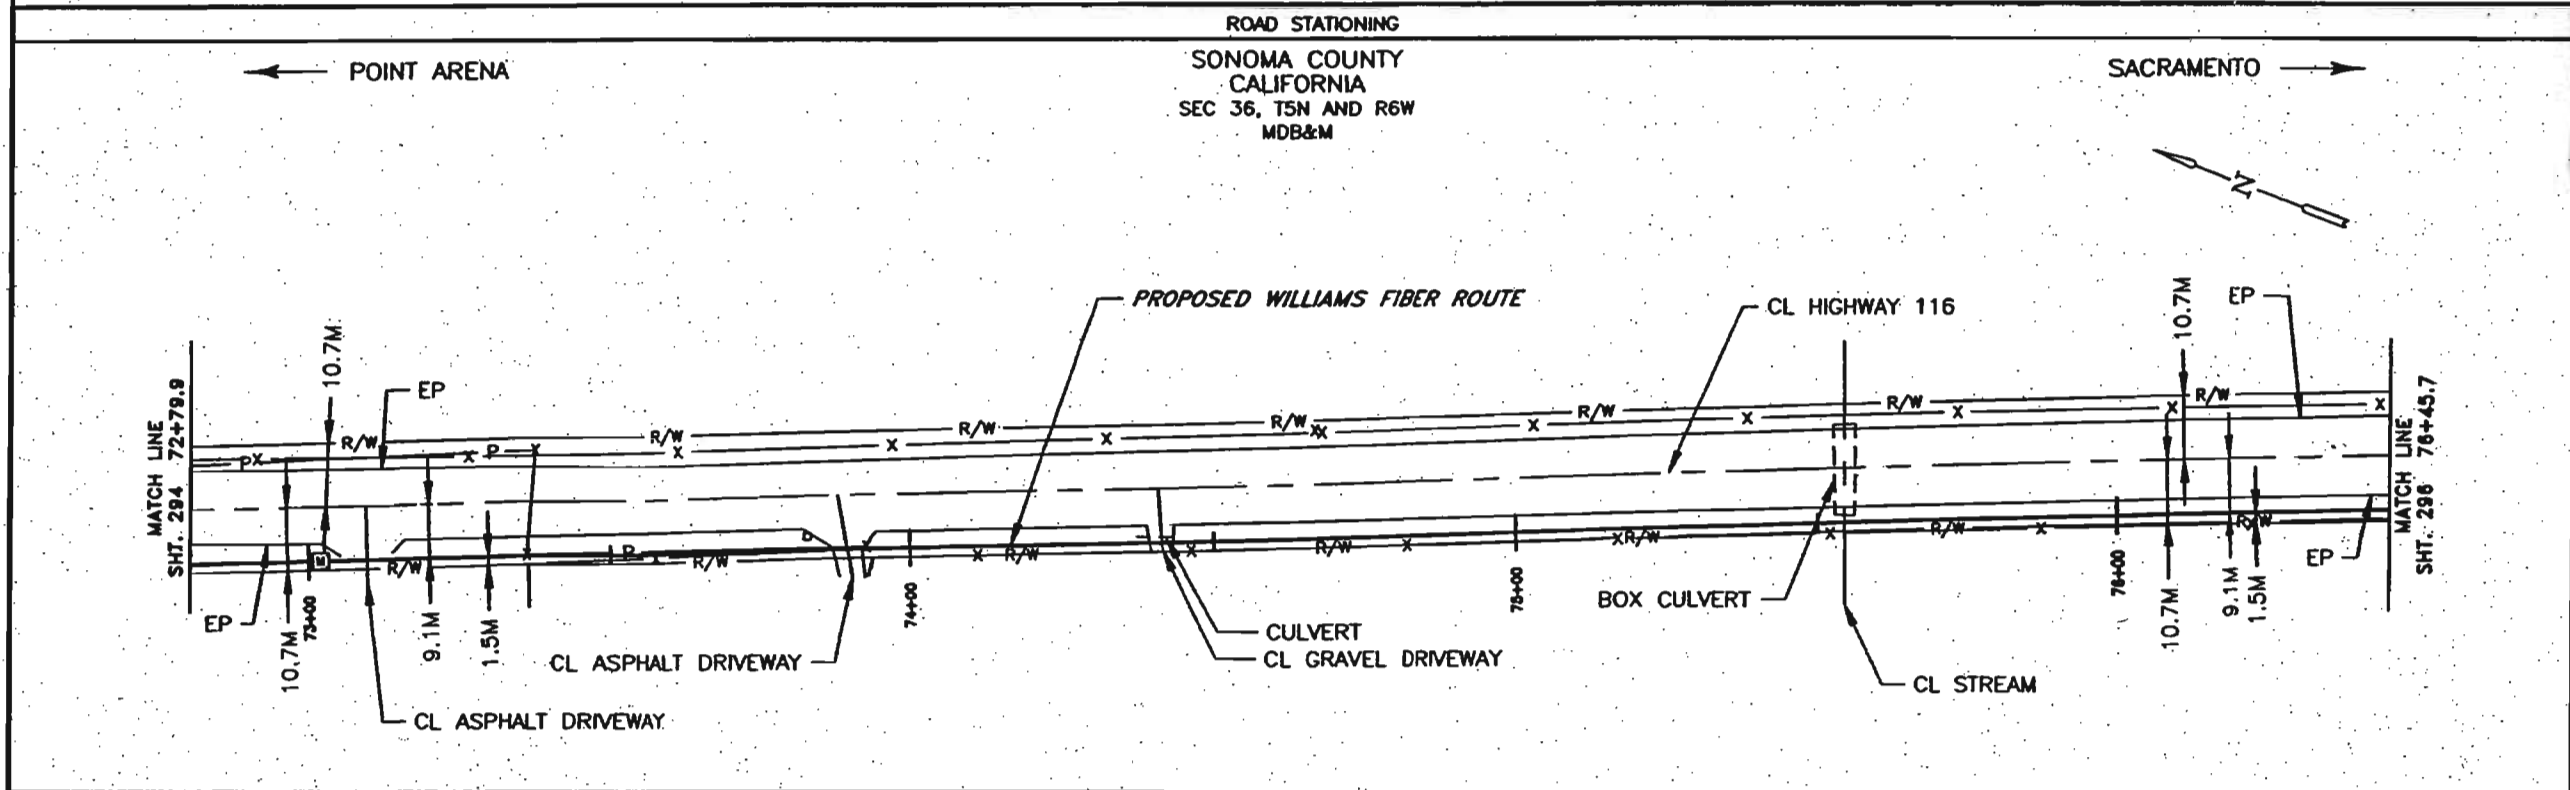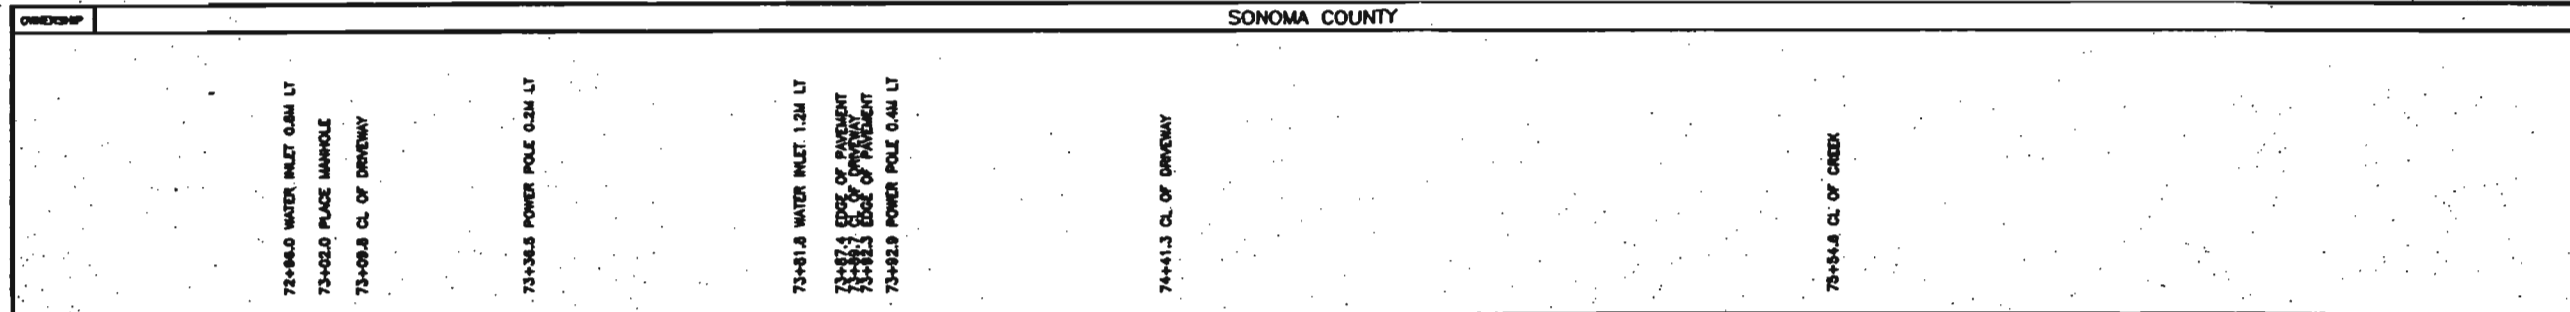

LEGEND	
Interstate Hwy	Regen Site
U.S. Hwy	P.O.P./Jct
State Hwy	Handhole Splice
County Road	Handhole
RR Mile Mar.	Handhole Splice
Min. Road Sign	Handhole
New Fiber Cable	SS Handhole
Tramway Line	Power Pole
City Limits	Water Valve / Meter
R/W Line	Gas Valve / Meter
River/Stream	Signal Pole
CL Road	Fire Hydrant
CL RR Tracks	Gas Marker
Fence	Oil Marker
Oil Pipeline	Oil Marker
Gas Pipeline	Fiber Marker
Power Line	Water Inlet
Water Line	
Sew. Line	
Storm Drain	
Telephone Line	
Black Iron Pipe	
Galvanized Iron Pipe	
EP	Edge of Pavement
EC	Edge of Ground
FC	Face of Curb
FL	Fog Line and/or White Line

WILLIAMS
EMERGENCY NOTIFICATION NUMBER
1-800-582-9069

CAUTION
WILLIAMS LOCATE & FOR
COUNTY, STATE
1-888-265-2283

FOREIGN UTILITY LOCATIONS ARE
APPROXIMATE. CONTACT THE LOCAL ONE
CALL AGENCY 48 HOURS PRIOR
TO CONSTRUCTION FOR EXACT
UTILITY LOCATIONS AT:
1-800-227-2600

REVISIONS			
REV. NO.	DESCRIPTION	BY	DATE
0	PERMIT	KSH	01/14

CABLE FIBER COUNT	TYPE OF GLASS	CABLE
CABLE REEL NO.		DESCRIPTION
SPLICE TO SPLICE CABLE LENGTH & COIL LENGTH		
UNDERDUCT & TYPE (CONDUIT/SPOOLING/COLOR)		TYPE & UNDERDUCT
STEEL PIPE SIZE		PLACEMENT
PVC		
FUTURE-2		FUTURE
FUTURE-3		USE
FUTURE-4		PLACE

COMMUNICATIONS GROUP
Network Services

POINT ARENA TO SACRAMENTO
CABLE ROUTE


DRAWN BY: ALJ DATE: 05/04/00
CHECKED BY: KSH DATE: 05/04/00
APPROVED BY: DATE:
APPROVED BY: DATE:
ATE: 4075 LOC. CODE: 000001
HORIZONTAL SCALE (HWS & PROF): 1:30.5
VERTICAL SCALE (HWS): 1:30.5
VERTICAL SCALE (PROF): 1:30.5
MAP PROJECTION: MAP-PROJECTION
DRAWING NUMBER: PTAR-SACR-295-SPRD 5



25-02.0 PLACE MANHOLE

SONOMA COUNTY
CALIFORNIA
SEC 31, T31 AND R5W
MDB&M

SACRAMENTO

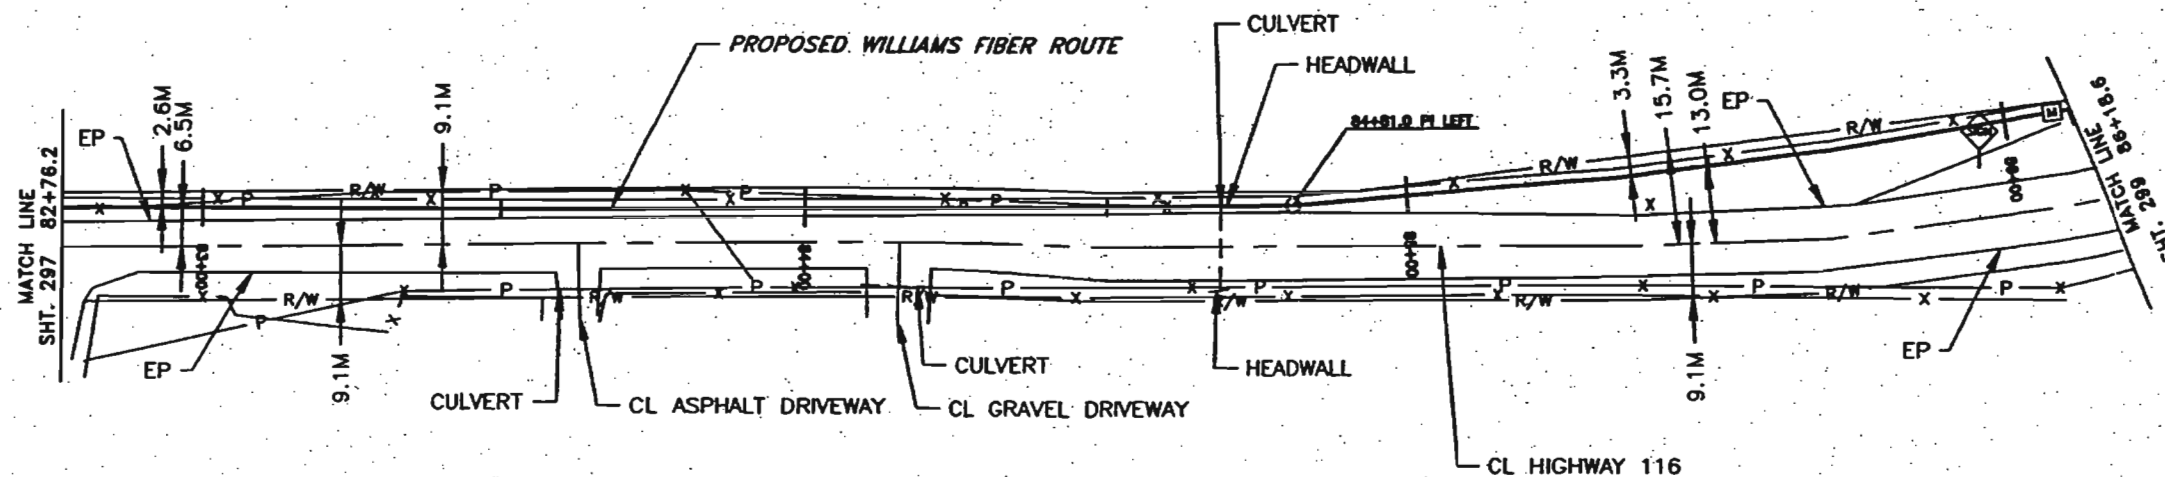

82+76.2

0-65788

N/A

342.4M - 1-38mm ID HDPE, 1-38mm ID HDPE (SPARE), 1-32mm ID HDPE (SPARE)

LEGEND

	Mileage Mark		Regain Site
	U.S. Hwy.		P.O.P./Jct.
	State Hwy.		Marine Splice
	County Road		Hwy
	RR Mile Mkr.		Marine Splice
	Misc. Road Sign		SS Mileage
	New Fiber Cable		Power Pole
	Twisted Line		Water Valve / Meter
	City Limits		Gas Valve / Meter
	R/W Line		Signal Pole
	River/Stream		Fire Hydrant
	CL Road		Gas Marker
	CL RR Tracks		Oil Marker
	Fence		Water Marker
	Oil Pipeline		Water Inlet
	Gas Pipeline		
	Power Line		
	Water Line		
	Sun. Sensor		
	Stream Bridge		
	Telephone Line		
	Black Iron Pipe		
	Galvanized Iron Pipe		
	Edge of Pavement		
	Edge of Gravel		
	Flare of Curb		
	Fog Line and/or White Line		

1-800-582-9069

FOREIGN UTILITY LOCATIONS ARE APPROXIMATE. CONTACT THE LOCAL ONE CALL AGENCY 48 HOURS PRIOR TO CONSTRUCTION FOR EXACT UTILITY LOCATIONS AT :

1-800-227-2600

[illegible]

FUTURE-6

COMMUNICA

Figure 1

POINT ARENA TO SAC

POINT ARENA TO SACK
CABLE PONT

CABLE ROUTE

DRAWN BY : ALI	5
-----------------------	---

CHECKED BY :	EDG
APPROVED BY :	

APPROVED BY: _____

AFE :	4873	LOC. CODE :
-------	------	-------------


HORIZONTAL SCALE (DWG & PROF) : 1:20

VERTICAL SCALE (HWS) : 1:30.5


MAP PROJECTION : MAP-PROJECTION

DRAWING NUMBER : PTAR-SACR-29

REV-0

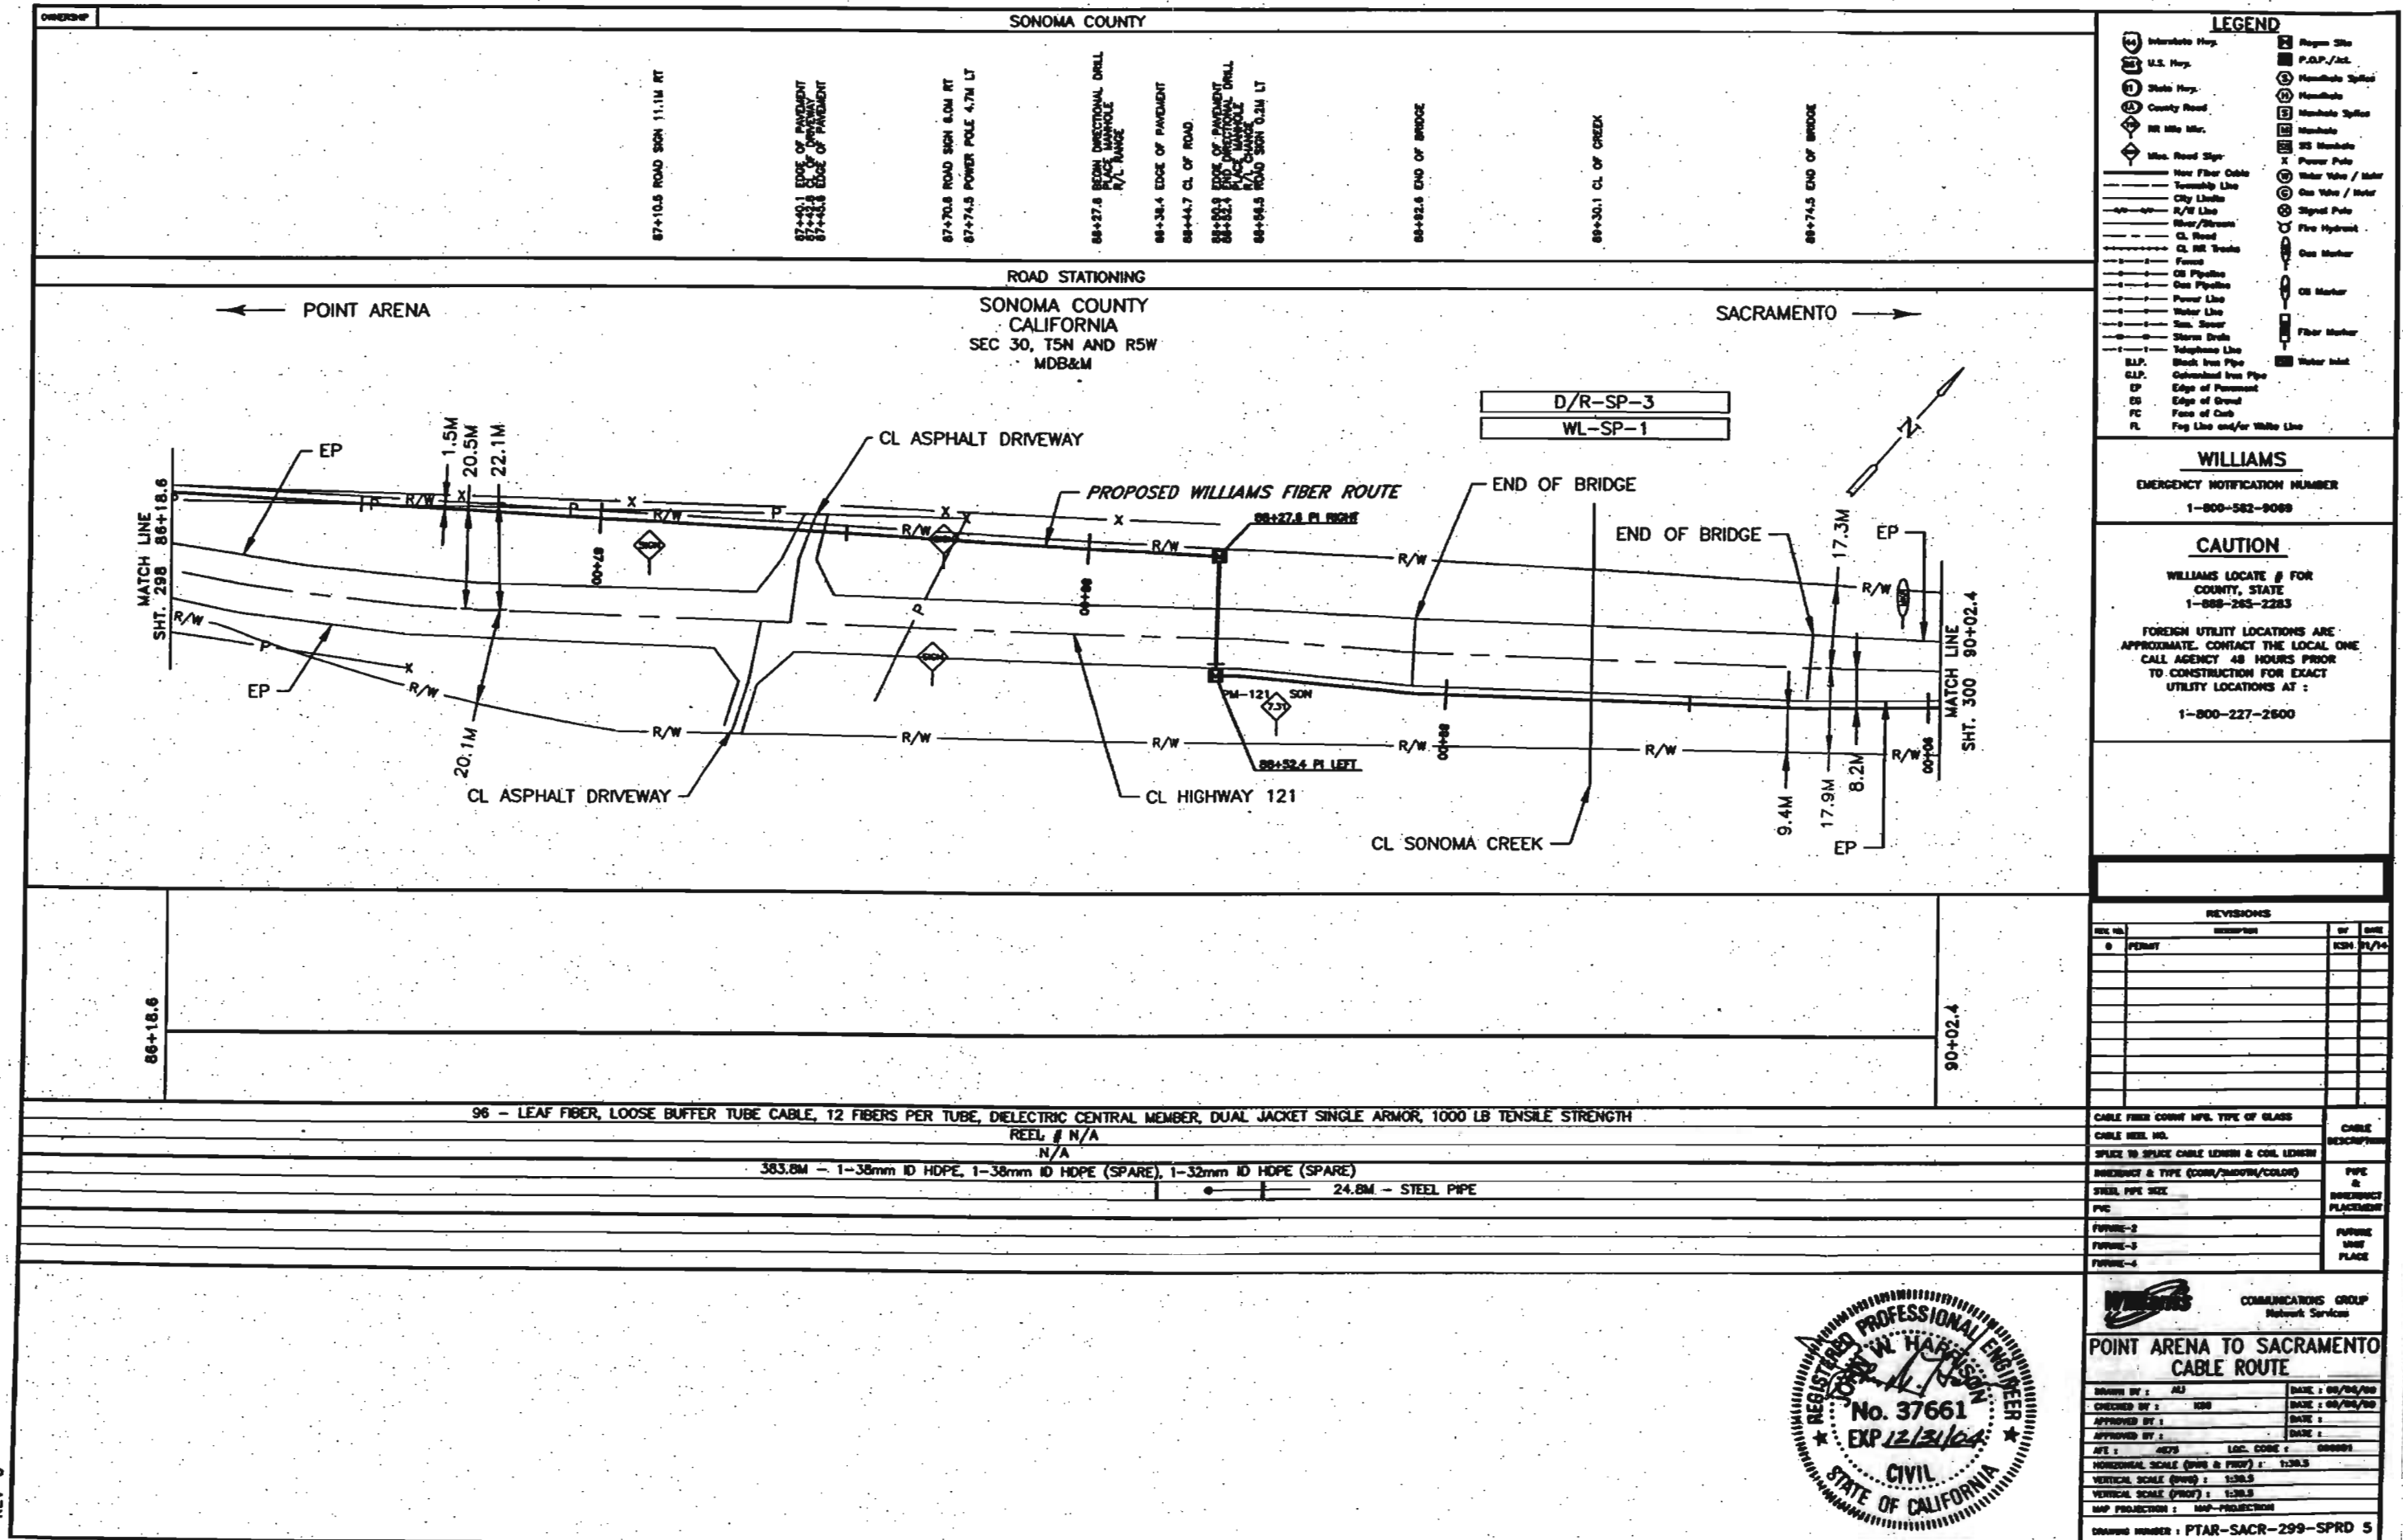

SONOMA COUNTY					
97+07.7 POWER POLE 1.0M RT	97+44.0 CULVERT 0.6M LT	97+48.9 ROAD SIGN 0.1M RT	97+50.3 ROAD SIGN 12.0M LT	97+58.9 ROAD SIGN 1.0M LT	98+02.1 CL OF DRIVEWAY
				98+10.3 POWER POLE 0.2M LT	98+18.4 ROAD SIGN 13.0M LT
					98+19.5 POWER POLE 1.0M RT

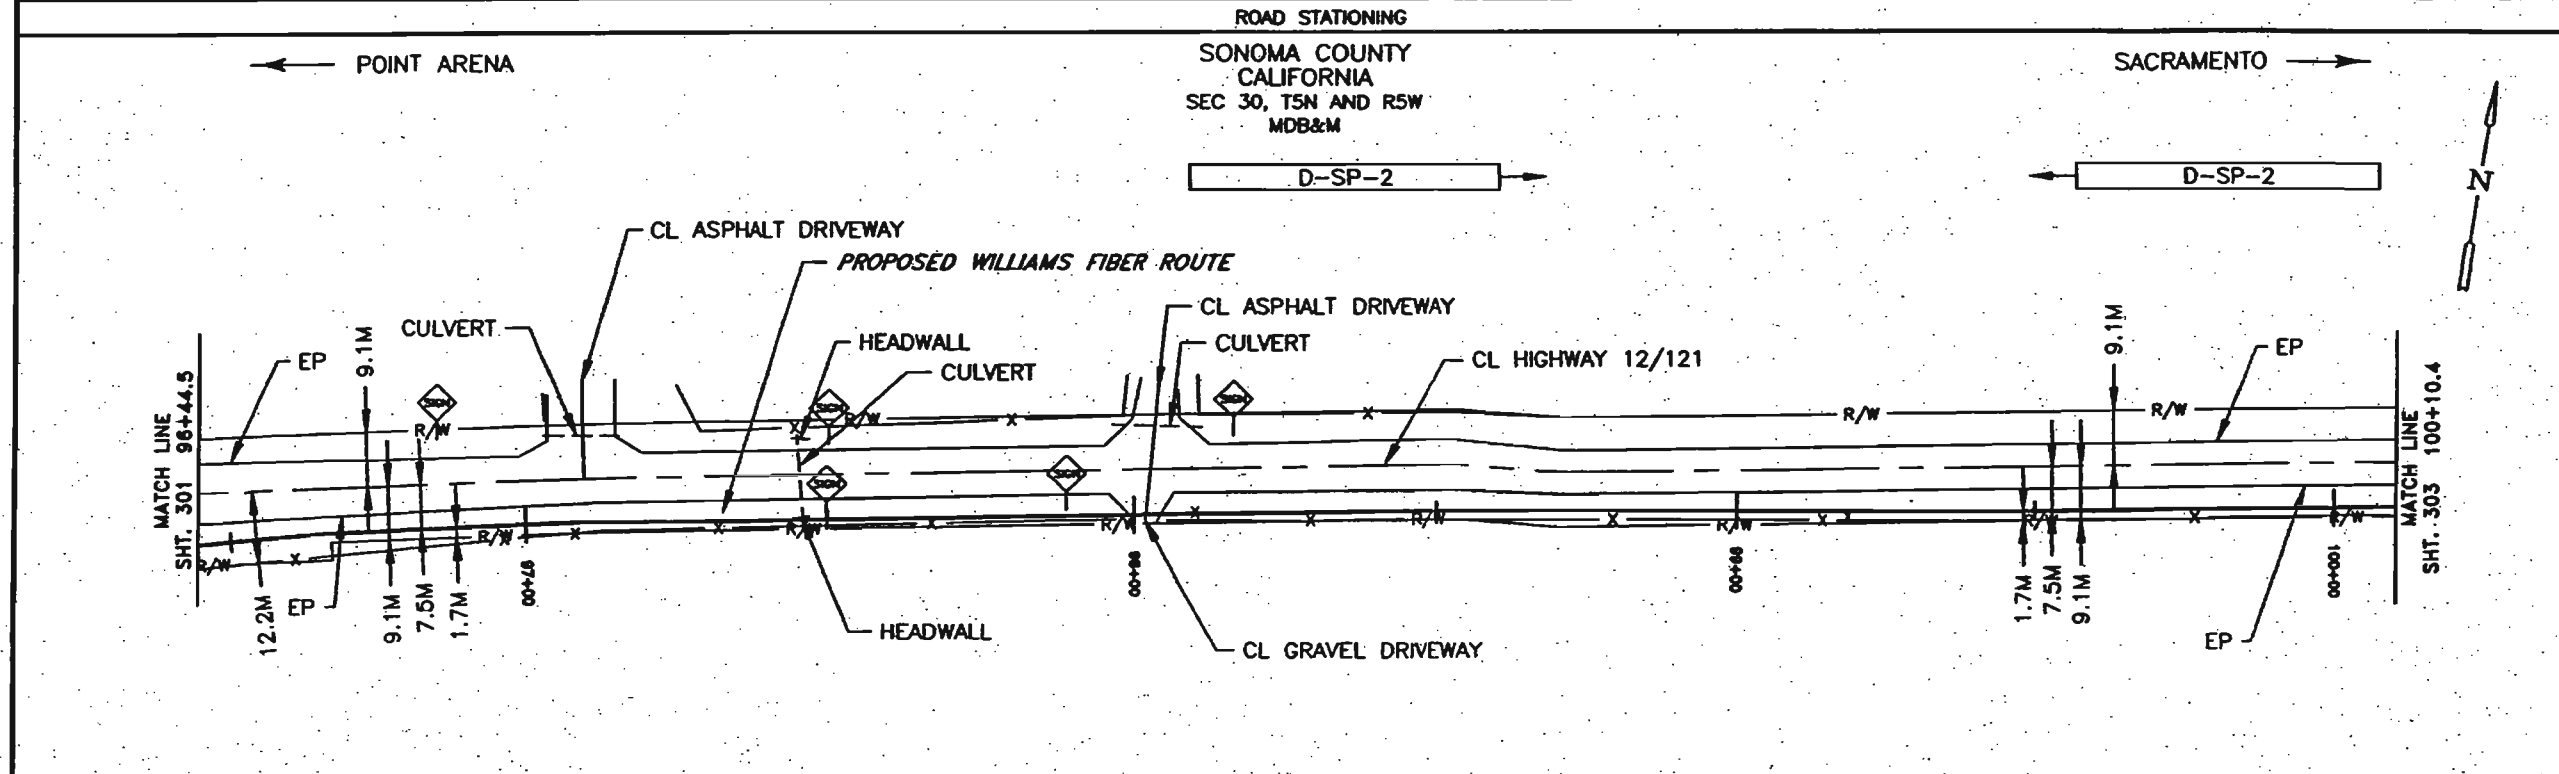

96+44.5		100+10.4
---------	--	----------

96 - LEAF FIBER, LOOSE BUFFER TUBE CABLE, 12 FIBERS PER TUBE, DIELECTRIC CENTRAL MEMBER, DUAL JACKET SINGLE ARMOR, 1000 LB TENSILE STRENGTH	
REEL # N/A	
N/A	
365.9M - 1-38mm ID HDPE, 1-38mm ID HDPE (SPARE), 1-32mm ID HDPE (SPARE)	

LEGEND	
Interstate Hwy.	Regen Site
U.S. Hwy.	P.O.P./Jct.
State Hwy.	Handhole Splice
County Road	Handhole
RR Mile Mkr.	Handhole Splice
Misc. Road Sign	Handhole
New Fiber Cable	25' Handhole
Township Line	Power Pole
City Limits	Water Valve / Meter
R/W Line	Gas Valve / Meter
Road/Stream	Signal Pole
CL Road	Fire Hydrant
CL RR Tracks	Gas Marker
Form	Oil Marker
Oil Pipeline	Oil Marker
Gas Pipeline	
Power Line	
Water Line	
San. Sewer	
Storm Drain	
Telephone Line	
Black Iron Pipe	
Galvanized Iron Pipe	
Edge of Pavement	
Edge of Gravel	
Face of Curb	
Fog Line and/or White Line	


WILLIAMS
EMERGENCY NOTIFICATION NUMBER
1-800-582-9089

CAUTION
WILLIAMS LOCATE # FOR COUNTY, STATE
1-888-265-2283

FOREIGN UTILITY LOCATIONS ARE APPROXIMATE. CONTACT THE LOCAL ONE CALL AGENCY 48 HOURS PRIOR TO CONSTRUCTION FOR EXACT UTILITY LOCATIONS AT :
1-800-227-2600

REVISIONS			
REV. NO.	DESCRIPTION	BY	DATE
0	PERMIT	KCN	11/14

CABLE FIBER COUNT, MFG. TYPE OF GLASS	CABLE DESCRIPTION
CABLE REEL NO.	
SPICE TO SPICE CABLE LENGTH & COIL LENGTH	
BUNDLE & TYPE (COIL/SHOWN/COLOR)	PIPE & DIMENSIONS
STEEL PIPE SIZE	PLACEMENT
PVC	
FUTURE-2	FUTURE USE PLACE
FUTURE-3	
FUTURE-4	

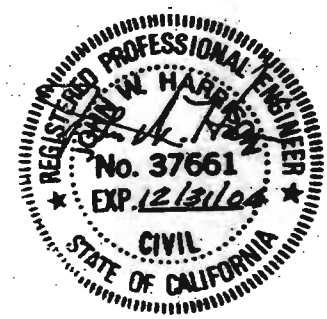

COMMUNICATIONS GROUP Network Services	
POINT ARENA TO SACRAMENTO CABLE ROUTE	
DRAWN BY : ALJ	DATE : 09/05/00
CHECKED BY : KNO	DATE : 09/06/00
APPROVED BY :	DATE :
DATE :	DATE :
ATE : 4575	LOC. CODE : 000001
HORIZONTAL SCALE (DWG & PROF) : 1:50.0	
VERTICAL SCALE (DWG) : 1:50.0	
VERTICAL SCALE (PROF) : 1:50.0	
MAP PROJECTION : MAP-PROJECTION	
DRAWING NUMBER : PTAR-SACR-302-SPRD 5	

00-243 POWER POLI 0.94 BT

100+40.2 ROAD SIGN 2.9M LT

100+82.0 POWER POLY 0.9M RT

101+21:1 PLACE MANHOLE

101+41A POWER POLE 0.7M BT

101+56.9 CL OF CROCK

101+78.4 EDGE OF PAVEMENT

101+83.8 CL OF DRIVEWAY

101+89.1 EDGE OF PAVEMENT

102+02.9 POWER POLE 0.9M RT

103+07.1 R/L CHANGE 1040 3240 2.5W BT

103+43.7 POWER POLE 2.4M FT
03+43.7 2.4M FT

102+42.1 PULL BOX 1.7M RT

9:08 + 201
102 + 813
RAILROAD TRACK
DOWNHILL TRACK

102+89.9 RAILROAD TRACK

102+81.9 FIBER MARKER 6.8M RT
102+81.9 POWER POLL 6.8M RT

102+88.2 CULVERT

02+77-101

103-319 POWER POLE 0.2M LT

LEGEND

- ### LEGEND
- | | | | |
|--|----------------------------|--|---------------------|
| | Interstate Hwy. | | Agent Site |
| | U.S. Hwy. | | P.D.P./Acc. |
| | State Hwy. | | Handhole Splice |
| | County Road | | Handhole |
| | RR Mile Mkr. | | Manhole Splice |
| | Mile Road Sign | | Manhole |
| | New Floor Ceiling | | Power Pole |
| | Trenching Line | | Water Valve / Meter |
| | City Limits | | Gas Valve / Meter |
| | P/W Line | | Signal Pole |
| | River/Stream | | Fire Hydrant |
| | C. Road | | Gas Marker |
| | CR. Road | | Oil Marker |
| | Fence | | Fiber Marker |
| | Gas Pipeline | | Water Inlet |
| | Power Line | | |
| | Water Line | | |
| | San. Sewer | | |
| | Storm Drain | | |
| | Sanitation Pipe | | |
| | Storm Drain Pipe | | |
| | Edge of Pavement | | |
| | Edge of Ground | | |
| | Face of Curb | | |
| | FL | | |
| | Fog Line and/or White Line | | |

WILLIAMS

EMERGENCY NOTIFICATION NUMBER


1-800-582-9069

CAUTION

WILLIAMS LOCATE # FOR
COUNTY, STATE
1-800-265-2283

FOREIGN UTILITY LOCATIONS ARE APPROXIMATE. CONTACT THE LOCAL ONE CALL AGENCY 48 HOURS PRIOR TO CONSTRUCTION FOR EXACT UTILITY LOCATIONS AT :

1-800-227-2600

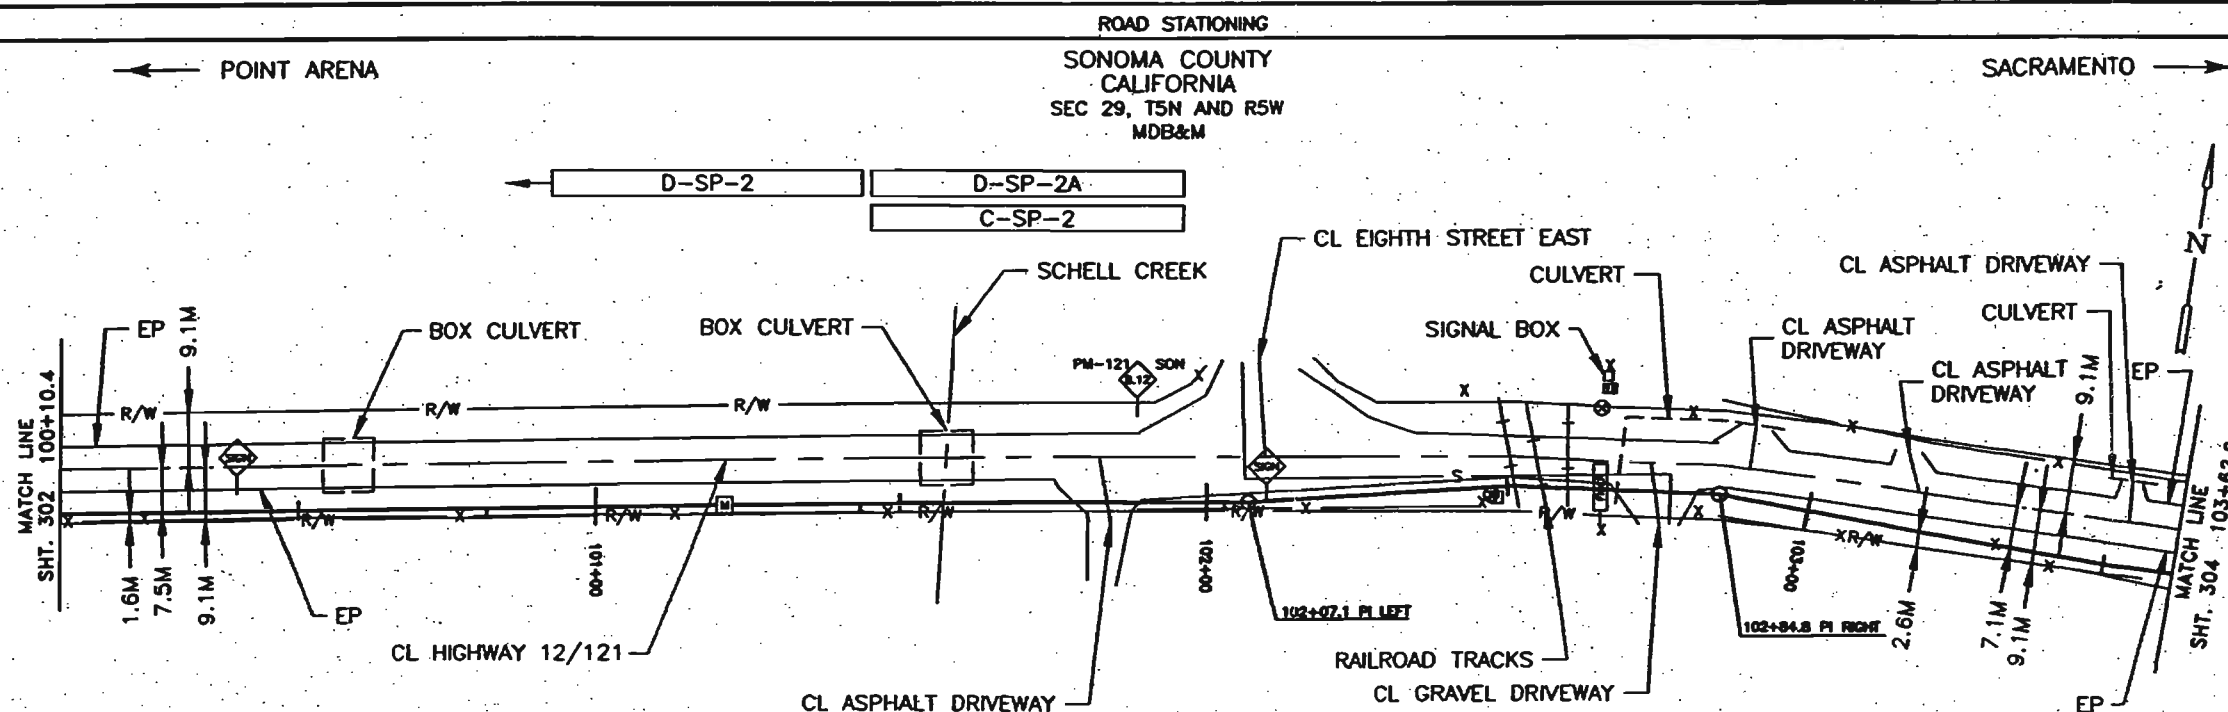

100+10.4.

107,000

96 - LEAF FIBER LOOSE BUFFER TUBE CABLE 12 FIBERS PER TUBE DIELECTRIC CENTRAL MEMBER DUAL JACKET SINGLE ARMOR 1000 LB TENSILE STRENGTH


REEL # N/A

N/A

351.8M - 1-38mm ID HDPE, 1-38mm ID HDPE (SPARE), 1-32mm ID HDPE (SPARE)

[illegible]

CABLE FIXER COUNT MFG. TYPE OF GLASS	CABLE
CABLE REEL NO.	WELDER
SPACE TO SPLIT CABLE LENGTH & COIL LENGTH	
INSTRUCT & TYPE (COIL/SHADOW/COLOR)	PIPE &
SWEL PIPE SIZE	SHIMMER
PVC	PLACED
FUTURE-2	
FUTURE-3	FUTURE
FUTURE-4	WAY
	PLACE

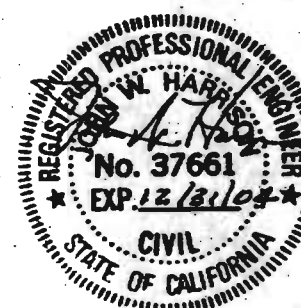

COMMUNICATIONS GROUP
Network Services

POINT ARENA TO SACRAMENTO CABLE ROUTE

DRAWN BY :	ALJ	DATE :	06/04/92
CHECKED BY :	238	DATE :	06/04/92
APPROVED BY :		DATE :	
APPROVED BY :		DATE :	
AGE :	4075	LOC. CODE :	000004
HORIZONTAL SCALE (MM & FOOT) :		1:30.5	
VERTICAL SCALE (MM) :		1:30.5	
VERTICAL SCALE (FEET) :		1:30.5	
MAP PROJECTION : NAD-PROJECTION			
Drawing NUMBER : PTAR-SACR-303-SPRD 5			

LEGEND

	Interstate Hwy.		Region Site
	U.S. Hwy.		P.O.P./Jct.
	State Hwy.		Handcable Splice
	County Road		Handcable
	MI Mile Mkr.		Manhole Splice
	Miles Road Sign		Manhole
	New Fiber Cable		XS Manhole
	Telephone Line		Power Pole
	City Limits		Water Valve / Meter
	H/W Line		Gas Valve / Meter
	River/Stream		Signal Pole
	CL Road		Fire Hydrant
	CL RR Tracks		Gas Marker
	Fence		Oil Marker
	CL Pipeline Gas Piping		Fiber Marker
	Power Line		Water Inlet
	Water Line		
	San. Sewer		
	Storm Drain		
	Telephone Line		
	BLP		
	G.L.P.		
	EP		
	ED		
	FC		
	Fog Line and/or White Line		

WILLIAMS
EMERGENCY NOTIFICATION NUMBER
1-800-582-9089


CAUTION

WILLIAMS LOCATE ® FOR
COUNTY, STATE
1-888-265-2283

FOREIGN UTILITY LOCATIONS ARE
APPROXIMATE. CONTACT THE LOCAL ONE
CALL AGENCY 48 HOURS PRIOR
TO CONSTRUCTION FOR EXACT
UTILITY LOCATIONS AT :
1-800-227-2600

[illegible]

WV Networks		COMMUNICATIONS GROUP Network Services	
POINT ARENA TO SACRAMENTO CABLE ROUTE			
DESIGNED BY :	MTW	DATE :	09/04/09
CHECKED BY :	KSB	DATE :	09/04/09
APPROVED BY :		DATE :	
APPROVED BY :		DATE :	
A/E :	4075	L.O.C. CODE :	000001
HORIZONTAL SCALE (SPRD & PROJ) :		1:30.5	
VERTICAL SCALE (VNG) :		1:30.5	
VERTICAL SCALE (PROJ) :		1:30.5	
MAP PROJECTION : MAP-PROJECTION			
DRAWING NUMBER : PTAR-SACR-304-SPRD 5			

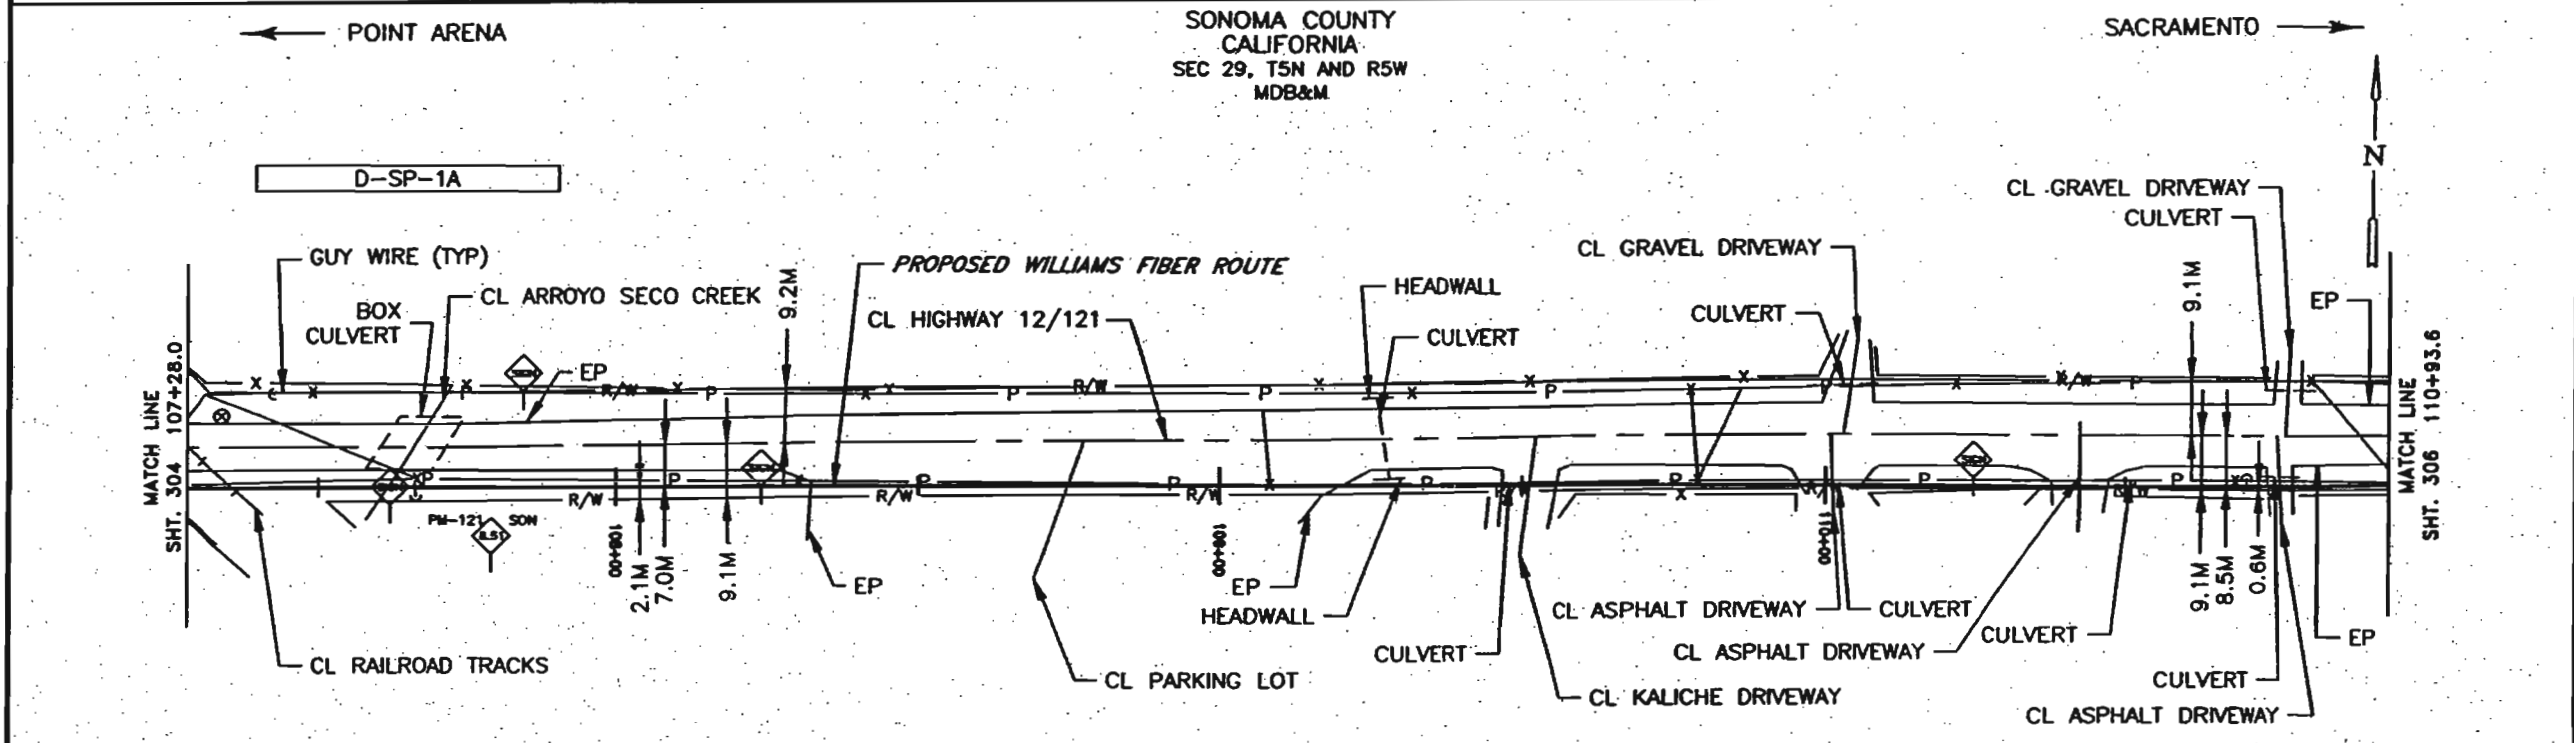

107+28.0		
		110+83.6

96	LEAF FIBER, LOOSE BUFFER TUBE CABLE, 12 FIBERS PER TUBE, DIELECTRIC CENTRAL MEMBER, DUAL JACKET SINGLE ARMOR, 1000 LB TENSILE STRENGTH
	REEL # N/A
	N/A
	365.6M - 1-38mm ID HDPE, 1-38mm ID HDPE (SPARE), 1-32mm ID HDPE (SPARE)

A circular professional engineer seal for the State of California. The outer ring contains the text "REGISTERED PROFESSIONAL ENGINEER" at the top and "STATE OF CALIFORNIA" at the bottom, separated by two stars. The center of the seal contains the name "W. HARRIS" at the top, the number "No. 37661" in the middle, and the expiration date "EXP. 12/31/04" at the bottom. The word "CIVIL" is written below the expiration date. A signature, possibly "W. Harris", is written across the seal, overlapping the name and number.

[illegible]

118+22.1 EDGE OF PAVEMENT
118+34.3 CL OF DRIVEWAY
118+35.6 EDGE OF PAVEMENT
118+55.3 POWER POLE 1.4M LT
118+57.0 EDGE OF PAVEMENT
118+82.9 CL OF DRIVEWAY
118+88.3 EDGE OF PAVEMENT

119+15.8 EDGE OF PAVEMENT
119+21.0 CL OF DRIVEWAY
119+23.8 EDGE OF PAVEMENT
119+26.9 POWER POLE 1.3M LT

119+88.1 POWER POLE 1.7M LT
119+89.6 EDGE OF PAVEMENT
119+92.0 CL OF DRIVEWAY
119+94.1 EDGE OF PAVEMENT
119+99.6 PLACE MANHOLE

120+11.4 ROAD SIGN 1.5M L7

120+38.9 POWER POLE 1.3M LT

120+56.6 CULVERT

120+83.1 GUY WIRE 0.7M LT
120+87.5 POWER POLE 0.7M LT


[illegible]

ROAD STATIONING

SONOMA COUNTY
CALIFORNIA
SEC 29, TN5 AND R5W
MDB&M

POINT ARENA

SACRAMENTO

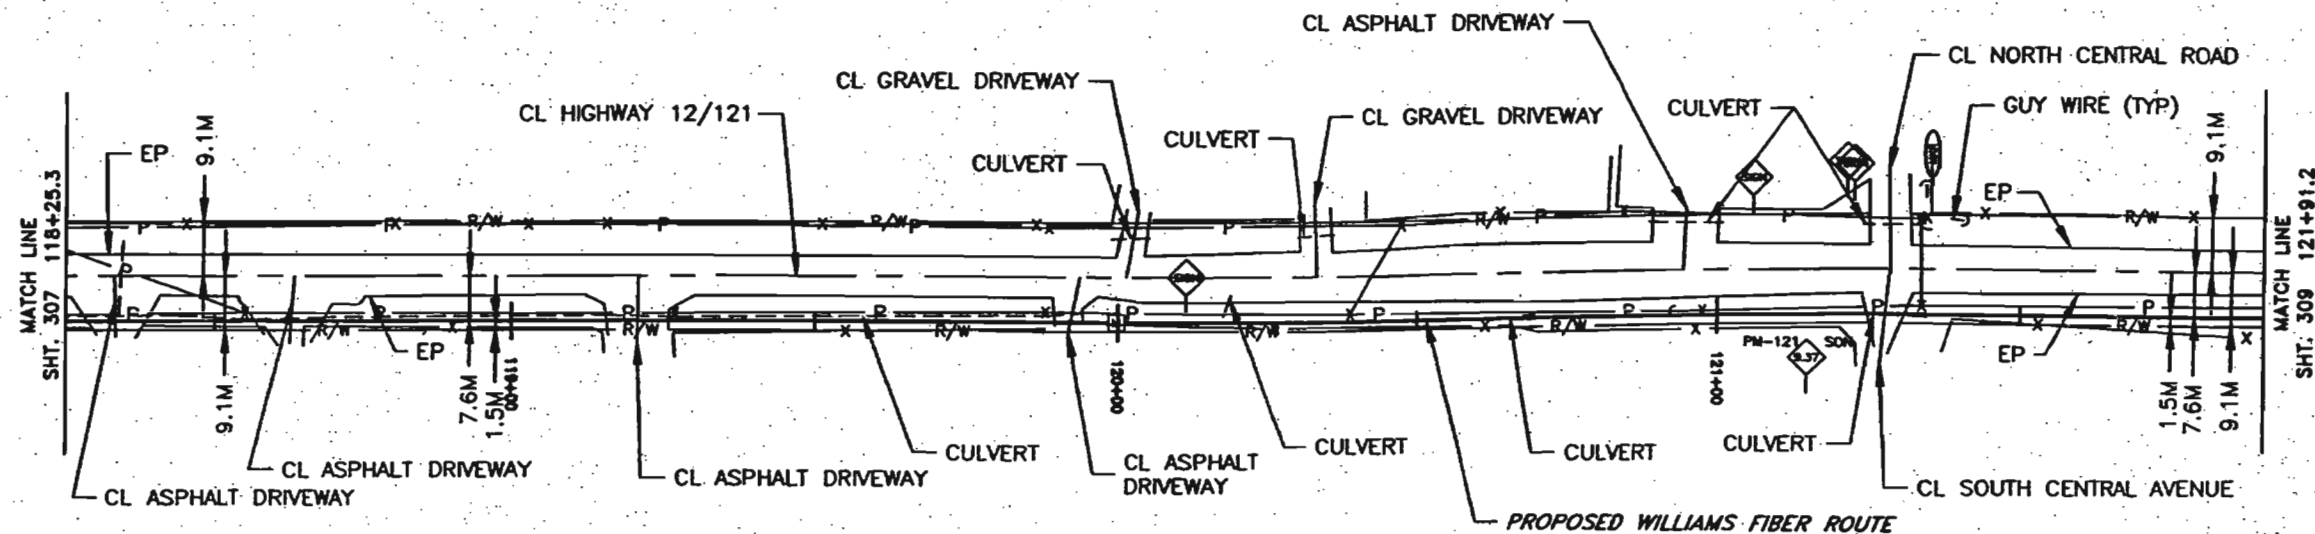

118+25.3

121+91.2

96 - LEAF FIBER, LOOSE BUFFER TUBE CABLE, 12 FIBERS PER TUBE, DIELECTRIC CENTRAL MEMBER, DUAL JACKET SINGLE ARMOR, 1000 LB TENSILE STRENGTH

REEL- # N/A
N/A

365.9M - 1-38mm ID HDPE, 1-38mm ID HDPE (SPARE), 1-32mm ID HDPE (SPARE)

LEGEND

- | | | | |
|--|-----------------------------|--|---------------------|
| | Interstate Hwy. | | Range Site |
| | U.S. Hwy. | | P.O.P. / Int. |
| | State Hwy. | | Handhole |
| | County Road | | Handhole |
| | RR Mile Mkr. | | Handhole |
| | Mile Road Sign | | Handhole |
| | Newly Fiber Cable | | Power Pole |
| | Telephone Line | | Water Valve / Water |
| | City Limits | | Gas Valve / Water |
| | R/W Line | | Signal Pole |
| | River/Stream | | Fire Hydrant |
| | CL Road | | Gas Marker |
| | CL RR Tracks | | Oil Marker |
| | Fence | | Fiber Marker |
| | Oil Pipeline | | Water Intake |
| | Gas Pipeline | | |
| | Power Line | | |
| | Water Line | | |
| | Sew. Sewer | | |
| | Storm Drain | | |
| | Telephone Line | | |
| | Blank Iron Pipe | | |
| | G.I.P. | | |
| | Edge of Pavement | | |
| | Edge of Ground | | |
| | Face of Curb | | |
| | Flag Line and/or White Line | | |

WILLIAMS

EMERGENCY NOTIFICATION NUMBER
1-800-582-9069

CAUTION

WILLIAMS LOCATE # FOR
COUNTY, STATE.
1-888-265-2283

FOREIGN UTILITY LOCATIONS ARE APPROXIMATE. CONTACT THE LOCAL ONE CALL AGENCY 48 HOURS PRIOR TO CONSTRUCTION FOR EXACT UTILITY LOCATIONS AT :
1-800-227-2600

REVISIONS

[illegible]

CABLE FIBER COUNT MFG. TYPE OF GLASS	CABLE DESCRIPTION
CABLE REEL NO.	
SPACE TO SPlice CABLE (DOWN & COIL, AROUND)	PIPE & INTERFECT PLACEMENT
INTERFECT & TYPE (CONJ./ROOM/COLOR)	
STEEL PIPE SIZE	
PVC	
FUTURE-2	FUTURE USE PLACE
FUTURE-3	
FUTURE-4	



INTELLIGENCE COMMUNICATIONS GROUP
Network Services

POINT ARENA TO SACRAMENTO
CABLE ROUTE

DRAWN BY : MEV		DATE : 05/04/00
CHECKED BY : K20		DATE : 05/04/00
APPROVED BY :		DATE :
APPROVED BY :		DATE :
AFE : 4076	LOC. CODE : 000001	
HORIZONTAL SCALE (HWS & PROF) : 1:30.3		
VERTICAL SCALE (VWS) : 1:30.3		
VERTICAL SCALE (VWS) : 1:30.3		
MAP PROJECTION : MAP-PROJECTION		
DRAWING NUMBER : PTAR-SACR-308-SPRD 5		

OVERSHEET

SONOMA COUNTY

121+98.3 ROAD SIGN 1.0M LT
122+02.9 POWER POLE 1.2M LT
122+09.4 EDGE OF PAVEMENT
122+11.1 CL OF DRIVEWAY
122+12.3 EDGE OF PAVEMENT
122+13.3 CULVERT

122+34.9 ROAD SIGN 13.5M LT

122+55.9 EDGE OF PAVEMENT
122+61.0 CL OF DRIVEWAY
122+65.3 EDGE OF PAVEMENT
122+68.3 POWER POLE 1.2M LT

123+24.3 POWER POLE 0.9M LT
123+25.3 GUY WIRE 0.5M LT

123+65.7 CL OF DRIVEWAY

124+02.3 POWER POLE 4.0M RT



124+22.7 GUY WIRE 13.0M LT
124+23.7 ROAD SIGN 1.2M LT
124+24.7 ROAD SIGN 1.2M LT

ROAD STATIONING

SONOMA COUNTY
CALIFORNIA
SEC 28, T5N AND R5W
MDB&M

POINT ARENA

SACRAMENTO

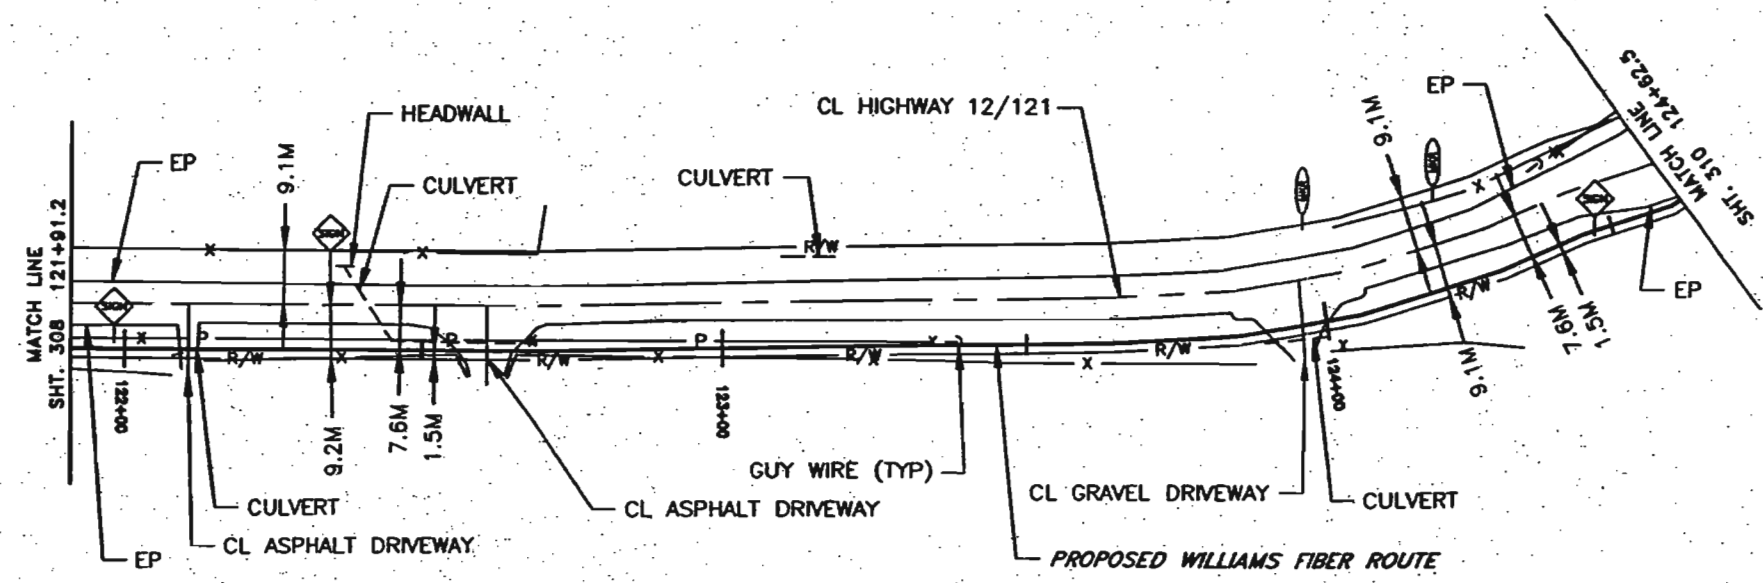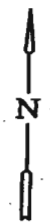

LEGEND

- | | |
|-----------------|----------------------------|
| Wettable Map | Regen Site |
| U.S. Hwy. | P.O.P./Jct. |
| State Hwy. | Handhole Splice |
| County Road | Handhole |
| RR Mile Mar. | Handhole Splice |
| Mile Road Sign | Handhole |
| New Fiber Cable | SS Handhole |
| Township Line | Power Pole |
| City Limits | Water Valve / Meter |
| R/W Line | Gas Valve / Meter |
| Road/Stream | Signal Pole |
| CL Road | Fire Hydrant |
| CL RR Tracks | Gas Marker |
| Fence | OS Marker |
| OS Pipeline | OS Marker |
| Gas Pipeline | Fiber Marker |
| Power Line | Water Inlet |
| Water Line | |
| San. Sewer | |
| Storm Drain | |
| Telephone Line | |
| BLP. | Black Iron Pipe |
| CLP. | Galvanized Iron Pipe |
| EP | Edge of Pavement |
| ES | Edge of Shoulder |
| FC | Face of Curb |
| FL | Fog Line and/or White Line |

WILLIAMS

EMERGENCY NOTIFICATION NUMBER
1-800-582-9069

CAUTION

WILLIAMS LOCATE # FOR
COUNTY, STATE
1-888-265-2283

FOREIGN UTILITY LOCATIONS ARE
APPROXIMATE. CONTACT THE LOCAL ONE
CALL AGENCY 48 HOURS PRIOR
TO CONSTRUCTION FOR EXACT
UTILITY LOCATIONS AT :
1-800-227-2600

REVISIONS

REV. NO.	DESCRIPTION	BY	DATE
0	PERMIT	ICM	01/14

96 - LEAF FIBER, LOOSE BUFFER TUBE CABLE, 12 FIBERS PER TUBE, DIELECTRIC CENTRAL MEMBER, DUAL JACKET SINGLE ARMOR, 1000 LB TENSILE STRENGTH

REEL # N/A

271.3M - 1-38mm ID HDPE, 1-38mm ID HDPE (SPARE), 1-32mm ID HDPE (SPARE)


CABLE FIBER COUNT MFG. TYPE OF GLASS	CABLE DESCRIPTION
CABLE REEL NO.	
SPLICE TO SPLICE CABLE LENGTH & CABLE LENGTH	
INVERTED & TYPE (CONC/BRICK/CONC)	PIPE & INVERTED PLACEMENT
STEEL PIPE SIZE	
PVC	
FUTURE-2	FUTURE DATE PLACE
FUTURE-3	
FUTURE-4	



COMMUNICATIONS GROUP
Network Services

**POINT ARENA TO SACRAMENTO
CABLE ROUTE**

DRAWN BY : MTV	DATE : 05/06/00
CHECKED BY : KSB	DATE : 05/06/00
APPROVED BY :	DATE :
APPROVED BY :	DATE :
APP. : 4575	LOC. CODE : 000001
HORIZONTAL SCALE (HWS & FWS) : 1:38.5	
VERTICAL SCALE (VWS) : 1:38.5	
VERTICAL SCALE (VWS) : 1:38.5	
MAP PROJECTION : MAP-PROJECTION	
DRAWING NUMBER : PTAR-SACR-309-SPRD 5	

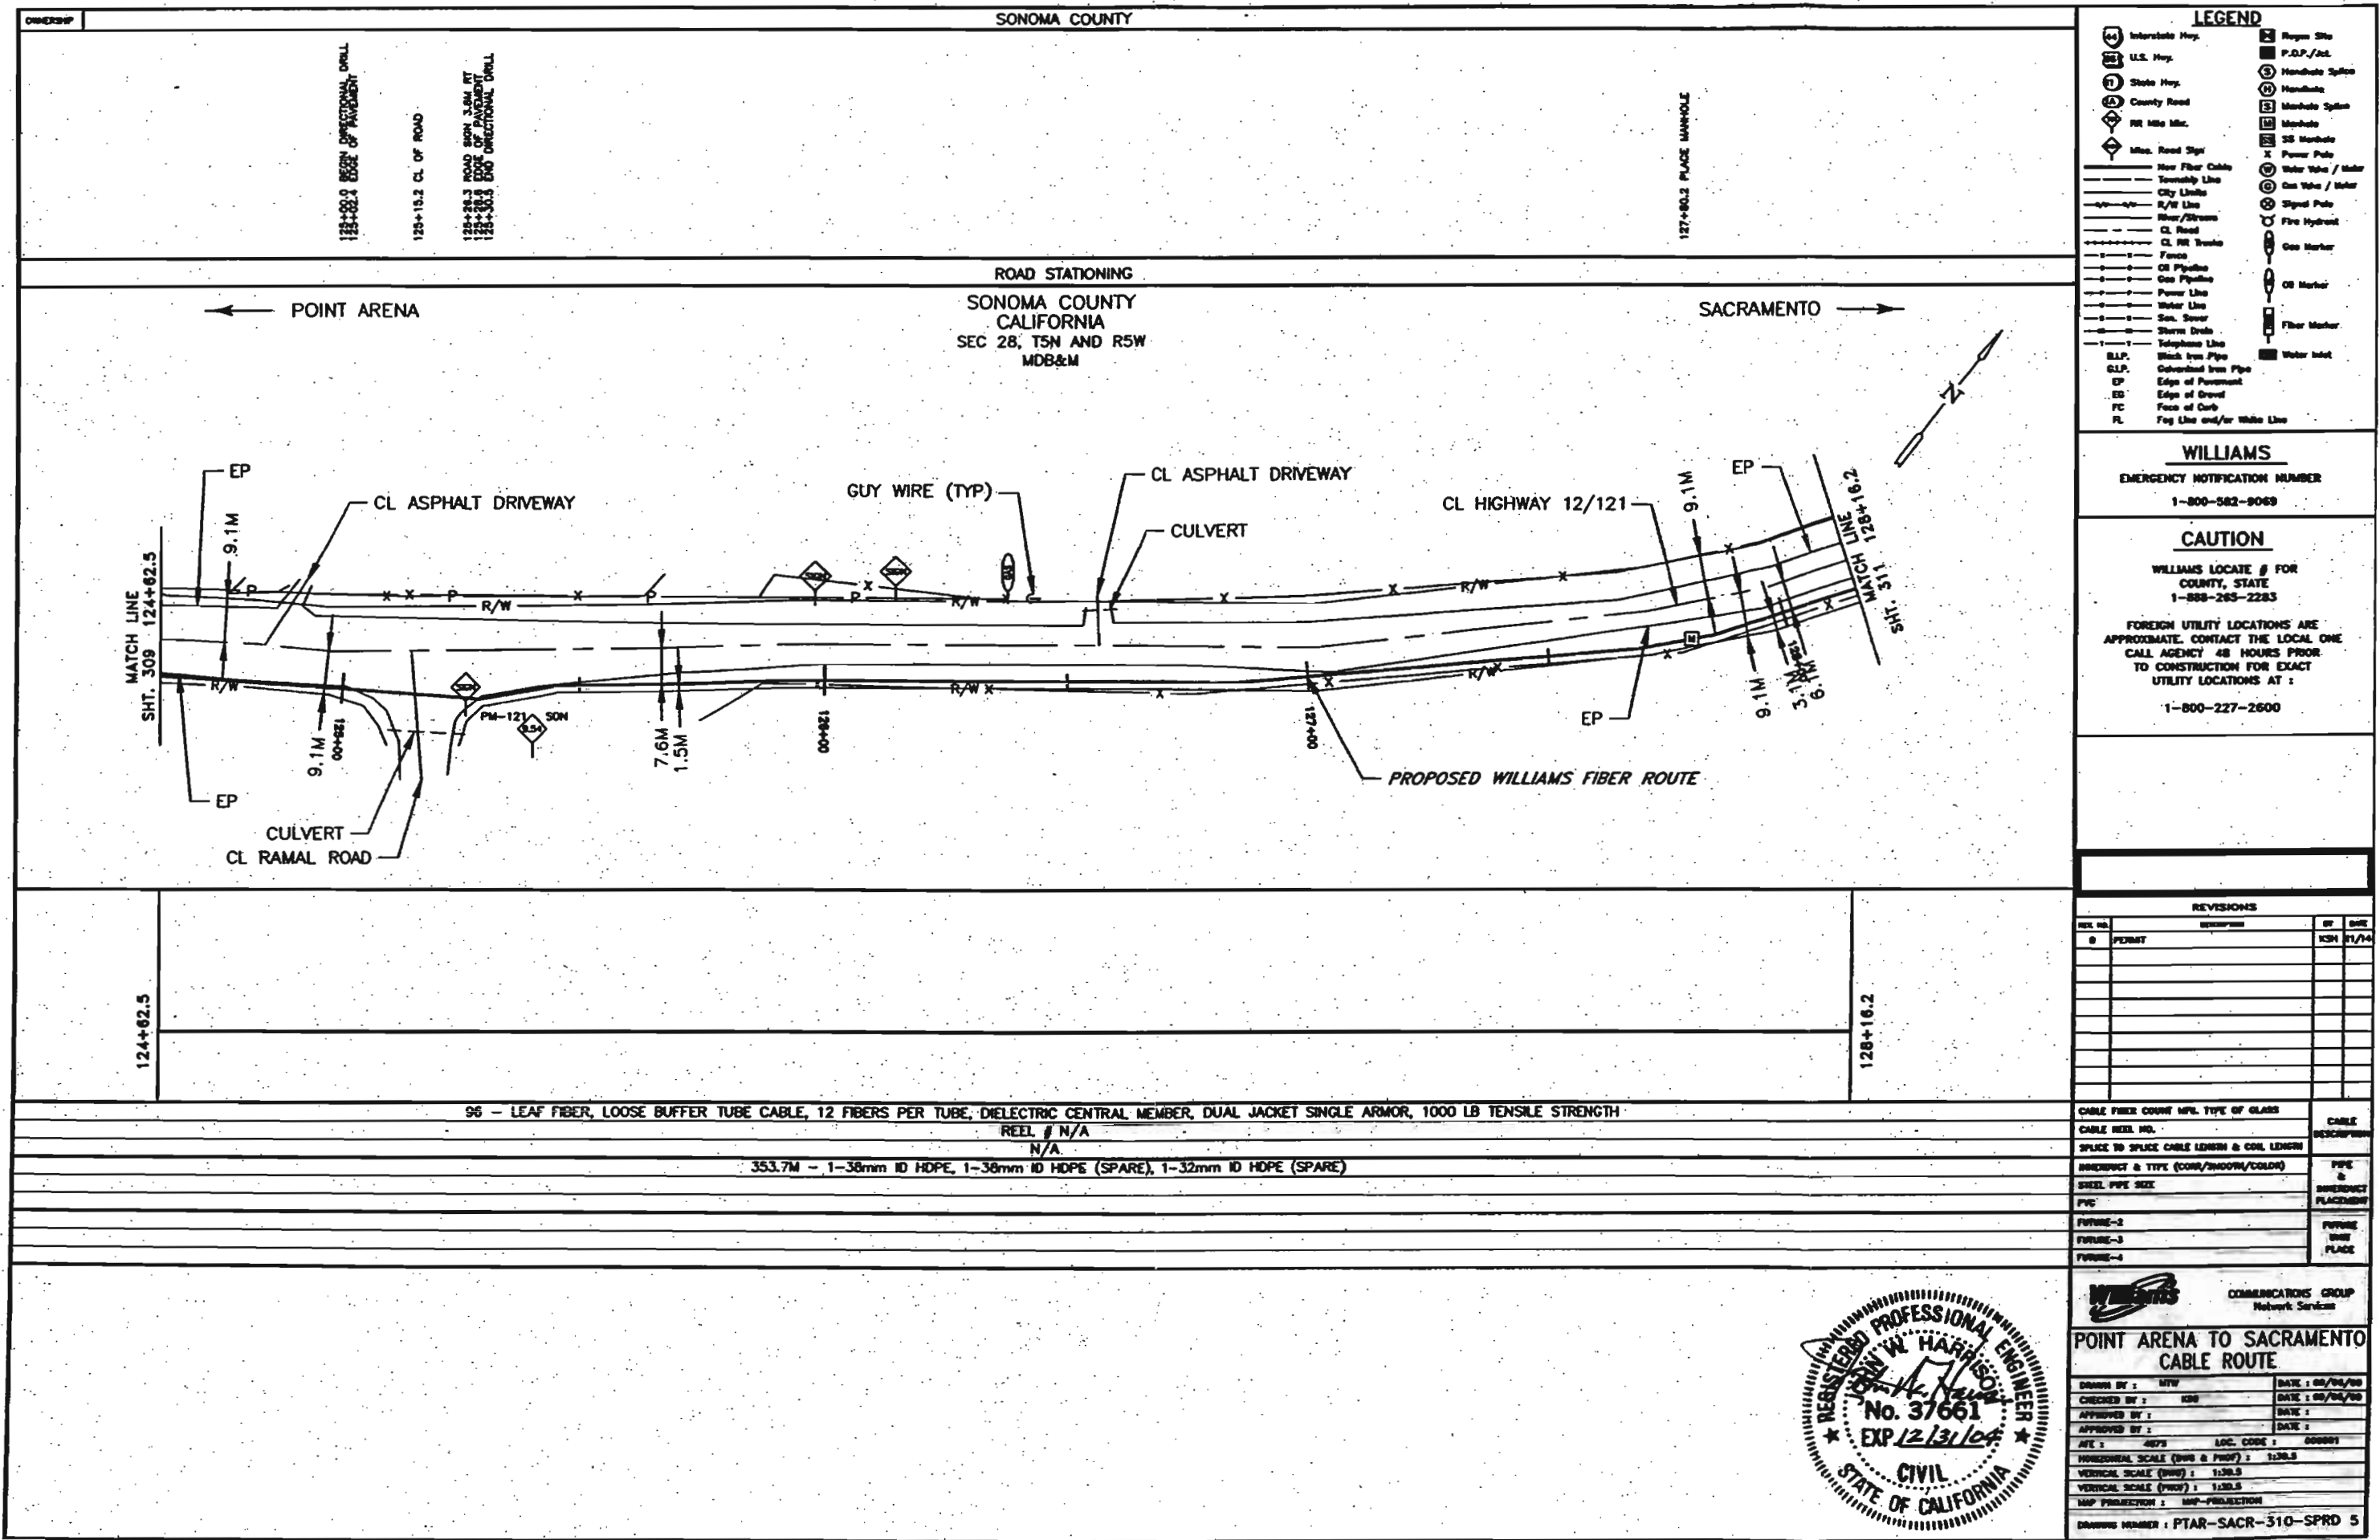

LEGEND	
	Interstate Hwy.
	U.S. Hwy.
	State Hwy.
	County Road
	RR Mile Marker
	Mile Road Sign
	New Floor Cable
	Trenching Line
	City Limits
	R/W Line
	River/Stream
	CL Road
	CL RR Track
	Fence
	Oil Pipeline
	Gas Pipeline
	Power Line
	Water Line
	San. Sewer
	Storm Drain
	Telephone Line
	Black Iron Pipe
	Galvanized Iron Pipe
	Edge of Pavement
	Edge of Gravel
	Face of Curb
	Fog Line and/or White Line
	Regen Site
	Handhole Spline
	Handhole
	Manhole Spline
	Manhole
	SS Manhole
	Power Pole
	Water Valve / Meter
	Gas Valve / Meter
	Signal Pole
	Fire Hydrant
	Gas Marker
	Oil Marker
	Fiber Marker
	Water Inlet

WILLIAMS
EMERGENCY NOTIFICATION NUMBER
1-800-582-9069

CAUTION
WILLIAMS LOCATE # FOR
COUNTY, STATE
1-888-263-2283
FOREIGN UTILITY LOCATIONS ARE
APPROXIMATE. CONTACT THE LOCAL ONE
CALL AGENCY 48 HOURS PRIOR
TO CONSTRUCTION FOR EXACT
UTILITY LOCATIONS AT :
1-800-227-2600

REVISIONS			
REV. NO.	DESCRIPTION	BY	DATE
0	PERMIT	ESM	01/14


96 - LEAF FIBER, LOOSE BUFFER TUBE CABLE, 12 FIBERS PER TUBE, DIELECTRIC CENTRAL MEMBER, DUAL JACKET SINGLE ARMOR, 1000 LB TENSILE STRENGTH		CABLE FIBER COUNT MPL TYPE OF GLASS	CABLE DESCRIPTION
REEL # N/A		CABLE REEL NO.	
N/A		SPlice TO SPlice CABLE LENGTH & COIL LENGTH	PIPE & BOREHOLE PLACEMENT
353.7M - 1-38mm ID HDPE, 1-38mm ID HDPE (SPARE), 1-32mm ID HDPE (SPARE)		BOREHOLE & TYPE (CONG/SHOON/COLDW)	
		STEEL PIPE SIZE	FUTURE USE PLACE
		PVC	
		FUTURE-2	
		FUTURE-3	
		FUTURE-4	



COMMUNICATIONS GROUP
Network Services

POINT ARENA TO SACRAMENTO
CABLE ROUTE

Drawn by : MTW Date : 02/04/00
Checked by : ESM Date : 02/04/00
Approved by : Date :
A/E : Loc. Code : 000001
Horizontal Scale (DWG & PROF) : 1:30.0
Vertical Scale (DWG) : 1:30.0
Vertical Scale (PROF) : 1:30.0
Map Projection : NAD-PROJECTION
Drawing Number : PTAR-SACR-310-SPRD 5

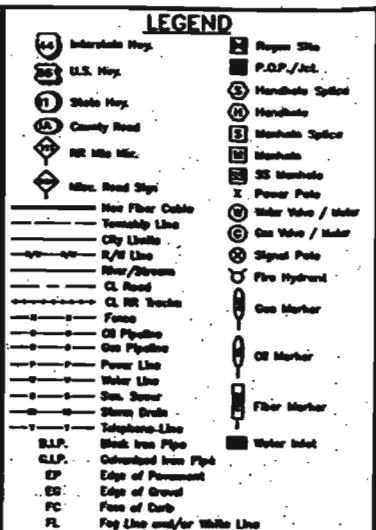


EMERGENCY NOTIFICATION NUMBER
1-800-582-9069


WILLIAMS LOCATE & FOR
COUNTY, STATE
1-888-265-2283

FOREIGN UTILITY LOCATIONS ARE APPROXIMATE. CONTACT THE LOCAL ONE CALL AGENCY 48 HOURS PRIOR TO CONSTRUCTION FOR EXACT UTILITY LOCATIONS AT :
1-800-227-2600

CABLE FIBER COUNT MFG. TYPE OF GLASS	CABLE DESCRIPTION
CABLE STEEL NO.	
SPACE TO SPACE CABLE LENGTH & CBL. LENGTH	PIPE & MANHOLE PLACEMENT
MANHOLE & TYPE (CONC./SMOOTH/COLDR)	
STEEL PIPE SIZE	FUTURE USE PLACE
PVC	
FUTURE-2	
FUTURE-3	
FUTURE-4	

INTEGRIS	COMMUNICATIONS GROUP	
	Network Services	
POINT ARENA TO SACRAMENTO CABLE ROUTE		
DRAWN BY :	SPV	DATE : 06/06/00
CHECKED BY :	KBO	DATE : 06/06/00
APPROVED BY :		DATE :
APPROVED BY :		DATE :
A/E :	4075	LOC. CODE : 0000001
HORIZONTAL SCALE (HWS & PROF) :		1:30.5
VERTICAL SCALE (VWS) :		1:30.5
VERTICAL SCALE (VHS) :		1:30.5
MAP PROJECTION : MAP-PROJECTION		
DRAWING NUMBER : PTAR-SACR-311-SPRD 5		

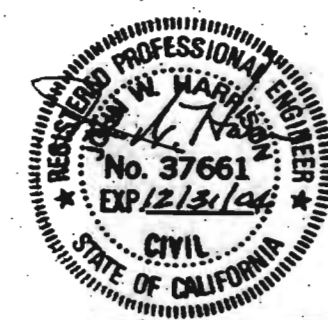

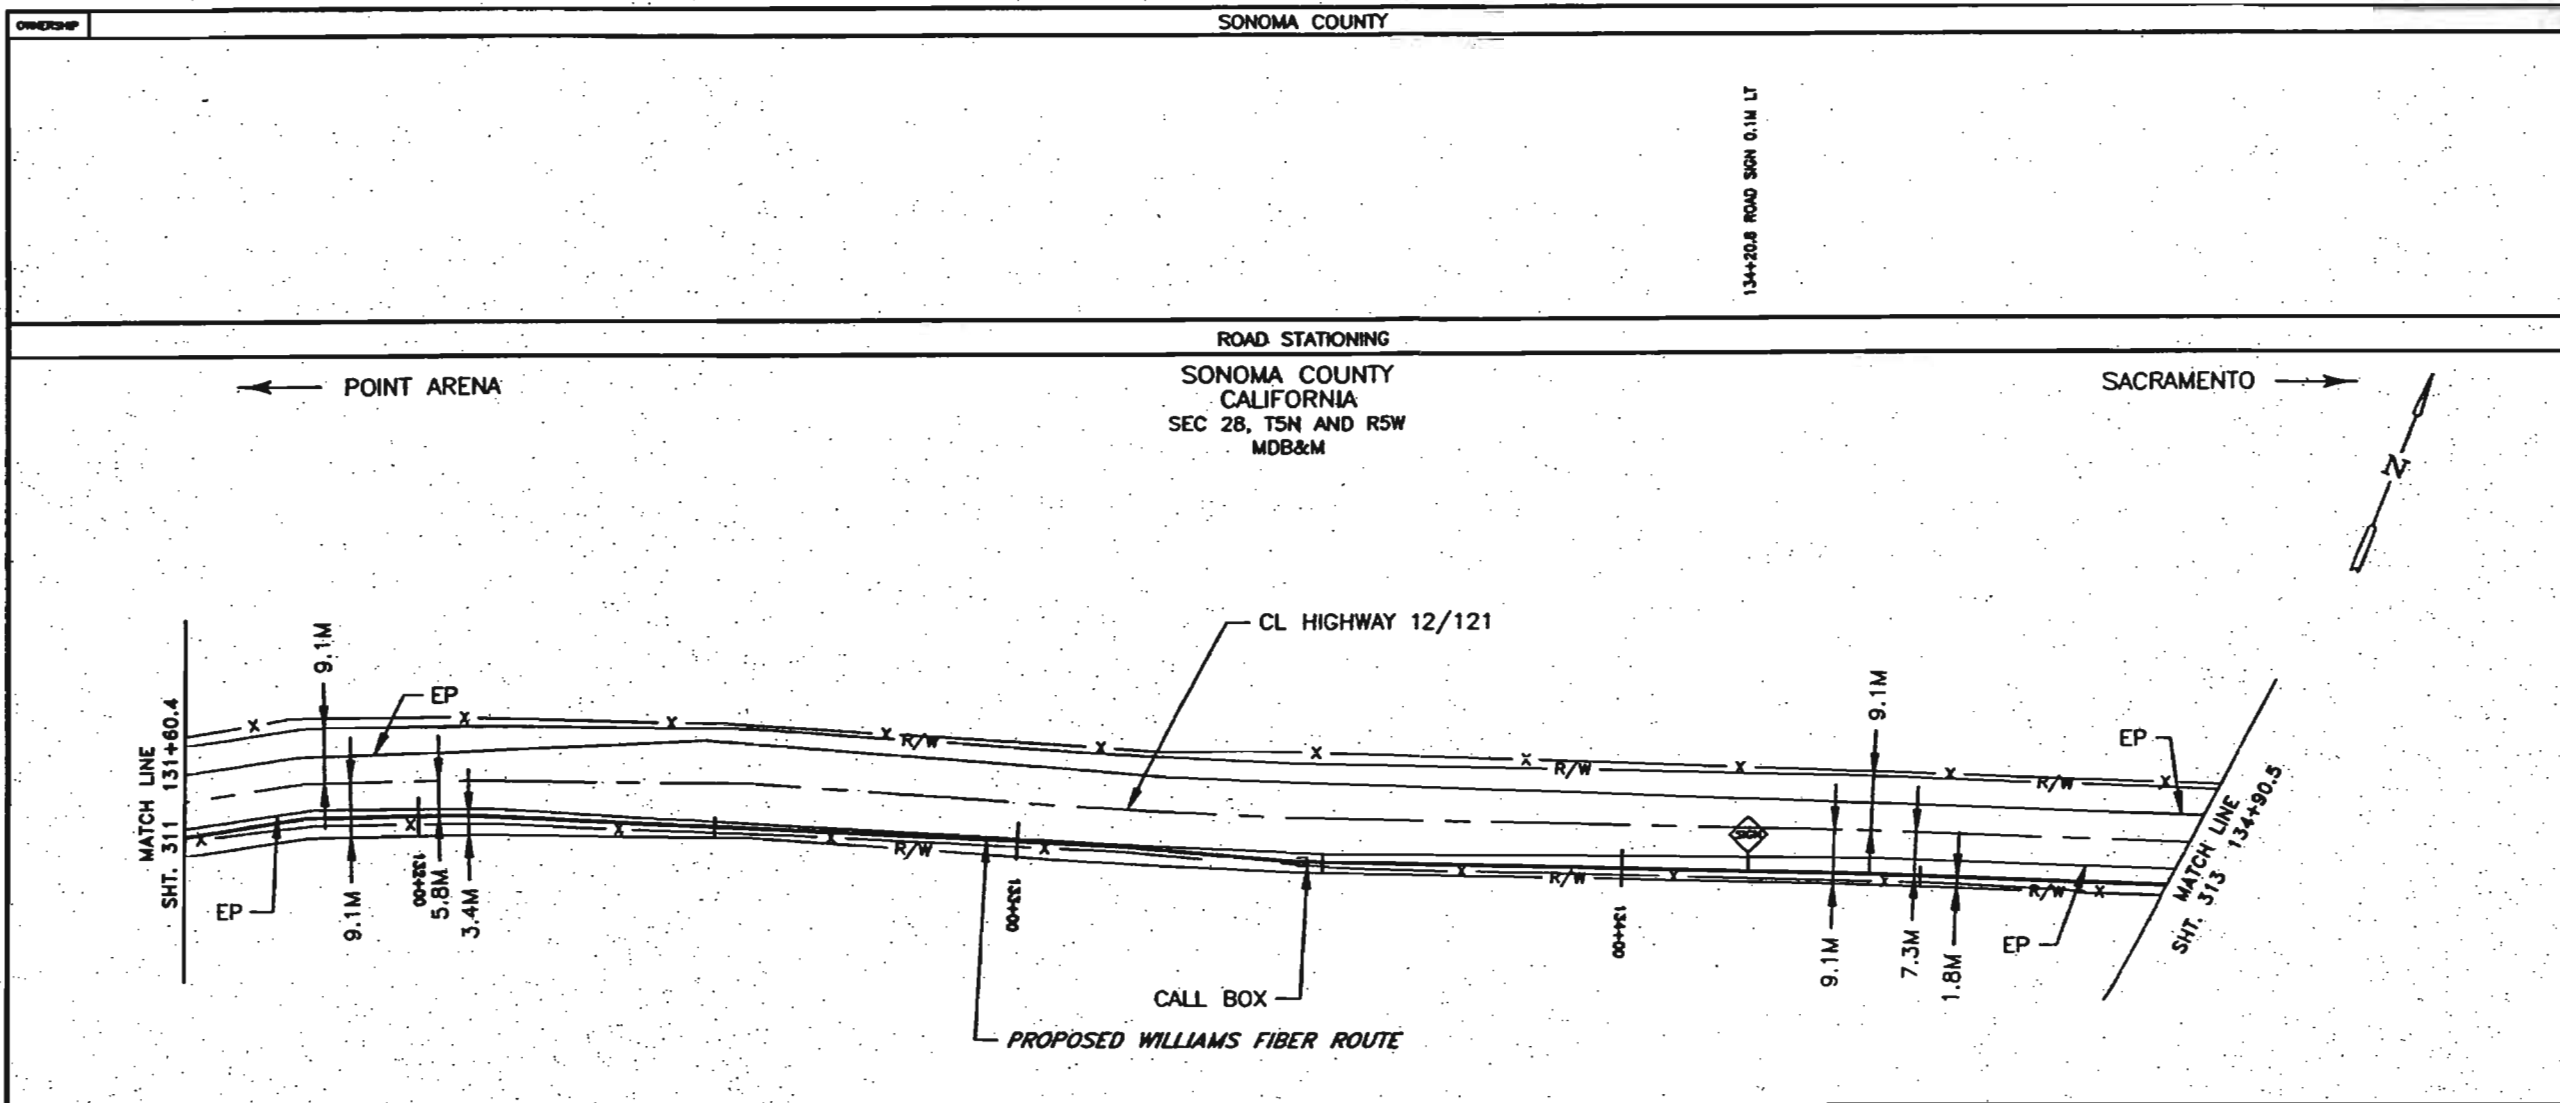

LEGEND

Interstate Hwy.	Region Site
U.S. Hwy.	P.O.P./Jct.
State Hwy.	Handhole Splice
County Road	Handhole
RR Mile Mkr.	Handhole Splice
Min. Road Sign	Handhole
New Fiber Cable	SE Handhole
Turnback Line	Water Valve / Meter
City Limits	Gas Valve / Meter
R/W Line	Signal Pole
River/Stream	Fire Hydrant
CL Road	Gas Marker
CL RR Tracks	Oil Marker
Fence	Fiber Marker
Oil Pipeline	Water Inlet
Gas Pipeline	
Power Line	
Water Line	
Sew. Sewer	
Storm Drain	
Telephone Line	
Black Iron Pipe	
Galvanized Iron Pipe	
Edge of Pavement	
Edge of Gravel	
Face of Curb	
Fog Line and/or White Line	

WILLIAMS
EMERGENCY NOTIFICATION NUMBER
1-800-582-9069

CAUTION
WILLIAMS LOCATE # FOR
COUNTY, STATE
1-888-263-2283

FOREIGN UTILITY LOCATIONS ARE
APPROXIMATE. CONTACT THE LOCAL ONE
CALL AGENCY 48 HOURS PRIOR
TO CONSTRUCTION FOR EXACT
UTILITY LOCATIONS AT :
1-800-227-2600

131+80.4		134+90.5
96 - LEAF FIBER, LOOSE BUFFER TUBE CABLE, 12 FIBERS PER TUBE, DIELECTRIC CENTRAL MEMBER, DUAL JACKET SINGLE ARMOR, 1000 LB TENSILE STRENGTH		
REEL # N/A		
N/A		
330.1M - 1-38mm ID HDPE, 1-38mm ID HDPE (SPARE), 1-32mm ID HDPE (SPARE)		

REVISIONS			
REV. NO.	DESCRIPTION	BY	DATE
0	PERMIT	KSH	01/14

CABLE FIBER COUNT MFG. TYPE OF GLASS	CABLE DESCRIPTION
CABLE REEL NO.	
SPLICE TO SPLICE CABLE LENGTH & COIL LENGTH	
WIREDUCT & TYPE (CONC/SHADOW/COLOR)	PVE & WIREDUCT PLACEMENT
STEEL PIPE SIZE	
PVC	
FUTURE-2	FUTURE ONE PLACE
FUTURE-3	
FUTURE-4	




COMMUNICATIONS GROUP
Network Services

**POINT ARENA TO SACRAMENTO
CABLE ROUTE**

DRAWN BY : HW	DATE : 09/04/00
CHECKED BY : KSH	DATE : 09/04/00
APPROVED BY :	DATE :
APPROVED BY :	DATE :
AFE :	LIC. CODE : 000001
HORIZONTAL SCALE (DWG & PROJ) :	1:30.5
VERTICAL SCALE (DWG) :	1:30.5
VERTICAL SCALE (PROJ) :	1:30.5
MAP PROJECTION :	NAD-PROJECTION
DRAWING NUMBER :	PTAR-SACR-312-SPRD 5

REV-0

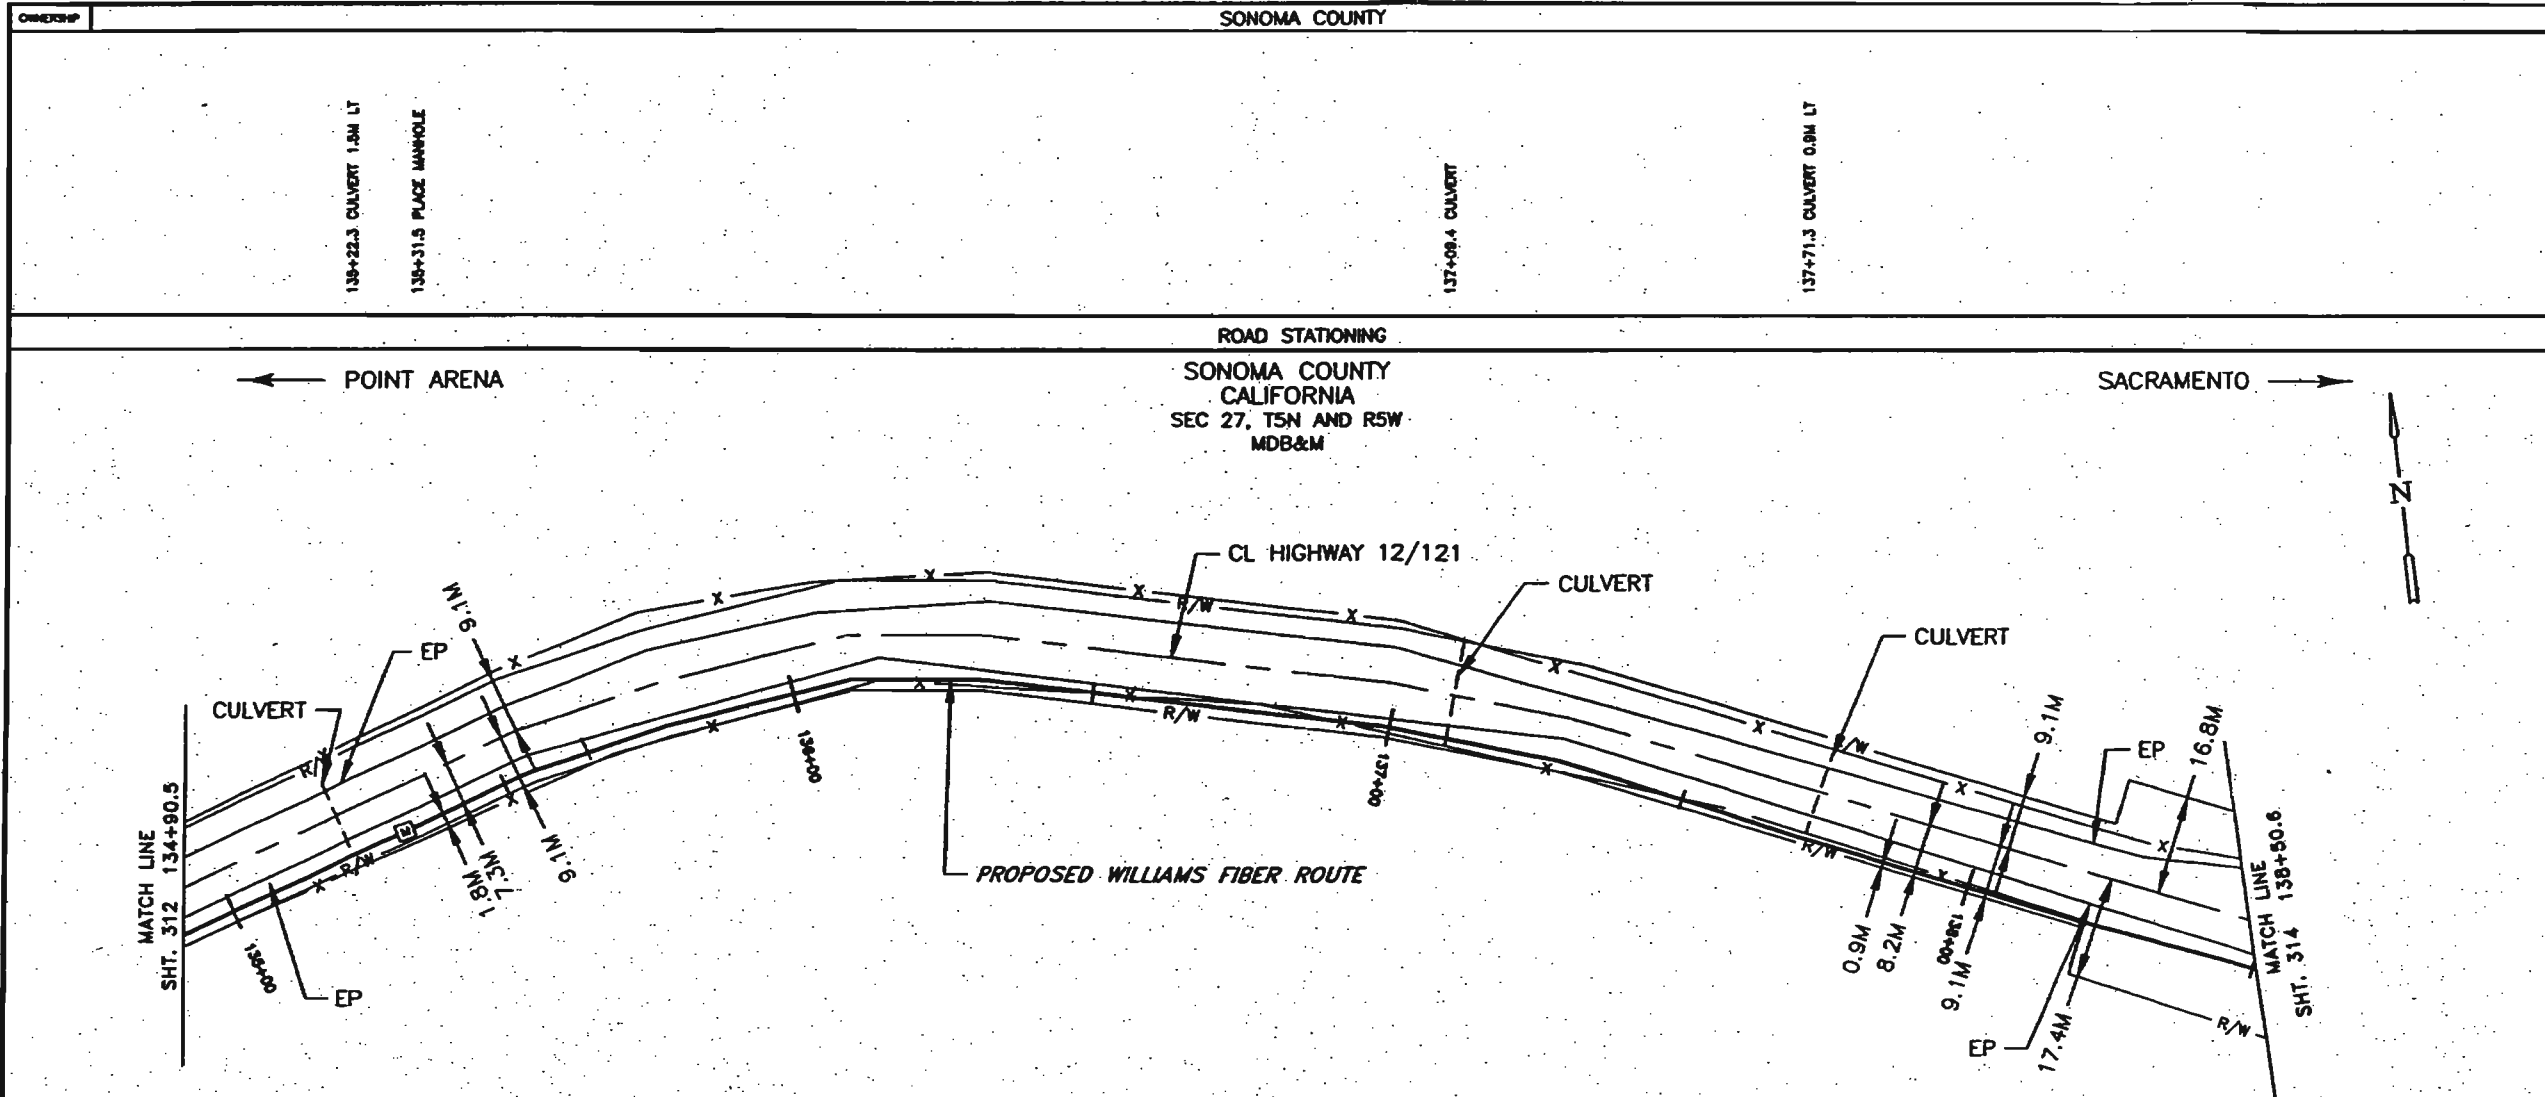

LEGEND	
	Interstate Hwy
	U.S. Hwy
	State Hwy
	County Road
	RR Mile Mr.
	Min. Road Sign
	New Fiber Cable
	Temporary Line
	City Limits
	R/W Line
	River/Stream
	CL Road
	CL RR Tracks
	Fence
	Oil Pipeline
	Gas Pipeline
	Power Line
	Water Line
	San. Sewer
	Storm Drain
	Telephone Line
	Block Iron Pipe
	Submerged Iron Pipe
	Edge of Pavement
	Edge of Ground
	Face of Curb
	Fog Line and/or White Line
	Region Site
	P.O.P./Jct.
	Handhole Symbol
	Handhole
	Manhole Symbol
	Manhole
	SS Manhole
	X Power Pole
	Water Valve / Meter
	Gas Valve / Meter
	Signal Pole
	Fire Hydrant
	Gas Marker
	Oil Marker
	Fiber Marker
	Water Inlet

WILLIAMS
EMERGENCY NOTIFICATION NUMBER
1-800-582-9069


CAUTION
WILLIAMS LOCATE # FOR
COUNTY, STATE
1-888-263-2283

FOREIGN UTILITY LOCATIONS ARE
APPROXIMATE. CONTACT THE LOCAL ONE
CALL AGENCY 48 HOURS PRIOR
TO CONSTRUCTION FOR EXACT
UTILITY LOCATIONS AT :
1-800-227-2600

REVISIONS			
REV. NO.	DESCRIPTION	BY	DATE
0	PERMIT	KSN	11/14

96 - LEAF FIBER, LOOSE BUFFER TUBE CABLE, 12 FIBERS PER TUBE, DIELECTRIC CENTRAL MEMBER, DUAL JACKET SINGLE ARMOR, 1000 LB TENSILE STRENGTH	
REEL # N/A	
N/A	
360.1M - 1-38mm ID HDPE, 1-38mm ID HDPE (SPARE), 1-32mm ID HDPE (SPARE)	

CABLE FIBER COUNT MFL TYPE OF GLASS	CABLE
CABLE REEL NO.	DESCRIPTION
SPACE TO SPACE CABLE LENGTH & CBL LENGTH	
UNDERDUT & TYPE (COND/SHOWN/COLOR)	TYPE
STEEL PIPE SIZE	UNDERDUT
PVC	PLACEMENT
FUTURE-2	FUTURE
FUTURE-3	USE
FUTURE-4	PLACE

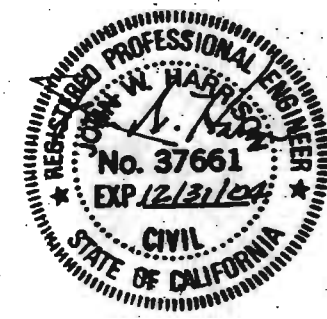

WILLIAMS COMMUNICATIONS GROUP
Network Services

**POINT ARENA TO SACRAMENTO
CABLE ROUTE**

DRAWN BY : MTW DATE : 08/04/09
CHECKED BY : KSN DATE : 08/04/09
APPROVED BY : DATE :
APPROVED BY : DATE :
APP : 4575 LOC CODE : 000001
HORIZONTAL SCALE (HWS & FWS) : 1:30.5
VERTICAL SCALE (VWS) : 1:30.5
VERTICAL SCALE (PROF) : 1:30.5
MAP PROJECTION : MAP-PROJECTION
DRAWING NUMBER : PTAR-SACR-313-SPRD 5

45+20.3 TRAFFIC SIGNAL 1.6M RT
45+24.3 WATER INLET 2.6M RT
45+24.7 FULL BOX 10.0M RT
45+24.7 POWER POLE 10.7M RT

•

1484783 B A CHANOF

1940-1941

	Interstate Hwy.		Regen Site
	U.S. Hwy.		P.D.P./Ind.
	State Hwy.		Handhole Splice
	County Road		Handhole
	RR Mile Mar.		Manhole Splice
	Mile Road Sign		Manhole
	New Fiber Cable		Manhole
	Turnback Line		Power Pole
	City Limits		Water Valve / Meter
	R/W Line		Gas Valve / Meter
	River/Stream		Signal Pole
	CL Road		Fire Hydrant
	CL RR Tracks		Gas Marker
	Fence		Oil Marker
	Oil Pipeline		Oil Marker
	Gas Pipeline		Fiber Marker
	Power Line		Water Inlet
	Water Line		
	San. Sewer		
	Storm Drain		
	Telephone Line		
R.I.P.	Black Iron Pipe		
R.I.P.	Galvanized Iron Pipe		
EP	Edge of Pavement		
ES	Edge of Gravel		
FC	Face of Curb		
FL	Fog Line and/or White Line		

EMERGENCY NOTIFICATION NUMBER
1-800-582-2069

**WILLIAMS LOCATE # FOR
COUNTY, STATE
1-888-265-2283**

**FOREIGN UTILITY LOCATIONS ARE
APPROXIMATE. CONTACT THE LOCAL ONE
CALL AGENCY 48 HOURS PRIOR
TO CONSTRUCTION FOR EXACT
UTILITY LOCATIONS AT :
1-800-227-2600**

REVISIONS

[illegible]

REEL # N/A

N/A


371.0M - 1-38mm ID HDPE, 1-38mm ID HDPE (SPARE), 1-32mm ID HDPE (SPARE)

CABLE FIBER COUNT MFL TYPE OF GLASS	CABLE
CABLE REEL NO.	DESCRIPTION
SPACE TO SPACE CABLE LENGTH & CBL. LENGTH	
INDEXES & TYPE (CORE/SHIELD/COLOR)	PIPE
STEEL PIPE SIZE	& INDEXES
PVC	PLACEMENT
FUTURE-2	
FUTURE-3	FUTURE
	USE
	PLACE

**POINT ARENA TO SACRAMENTO
CABLE ROUTE**


DRAWN BY :	MTW	DATE :	05/04/00
CHECKED BY :	KOB	DATE :	05/04/00
APPROVED BY :		DATE :	
APPROVED BY :		DATE :	
AGE :	4579	LOC. CODE :	000000
HORIZONTAL SCALE (HWS & FWS) :		1:30.5	
VERTICAL SCALE (HVS) :		1:30.5	
VERTICAL SCALE (VVS) :		1:30.5	
MAP PROJECTION : MAP-PROJECTION			
DRAWING NUMBER : PTAR-SACR-316-SPRD 5			

REV-0

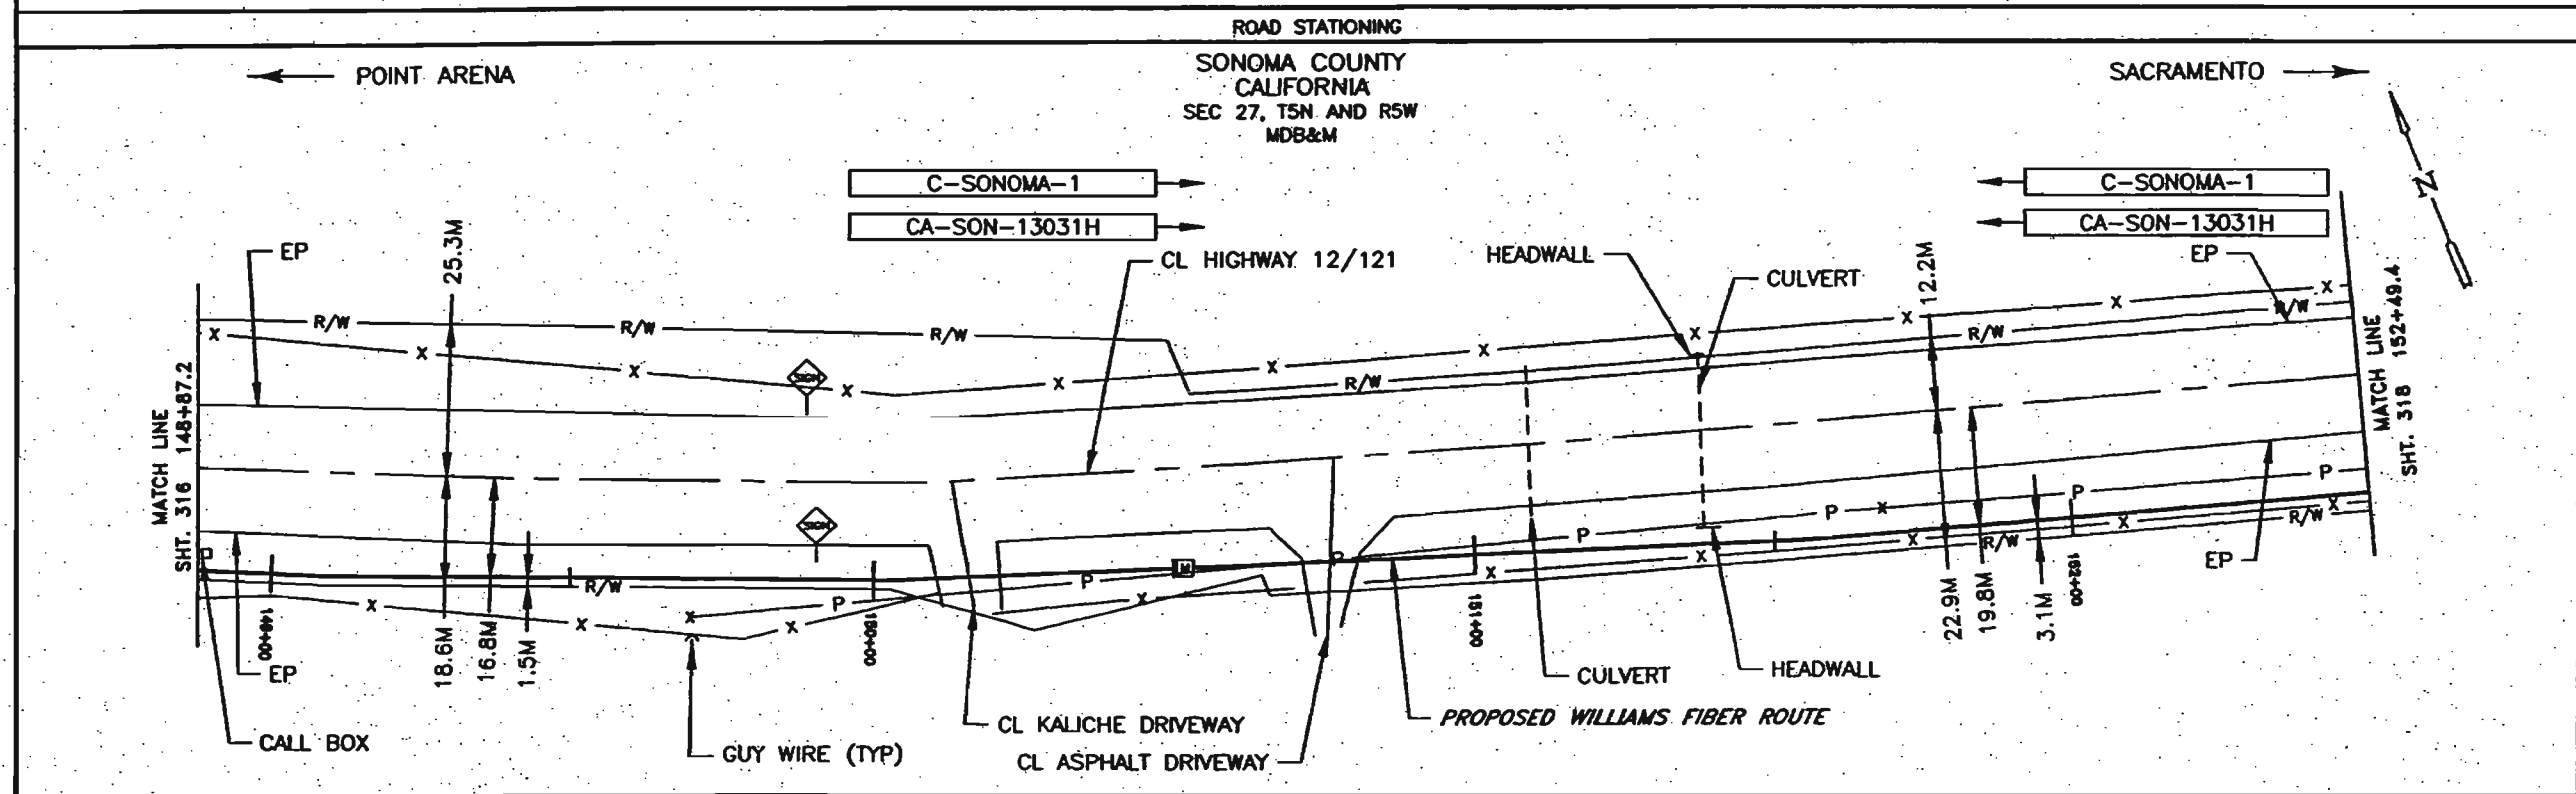

148+87.2		
		152+49.4

96 - LEAF FIBER, LOOSE BUFFER TUBE CABLE, 12 FIBERS PER TUBE, DIELECTRIC CENTRAL MEMBER, DUAL JACKET SINGLE ARMOR, 1000 LB TENSILE STRENGTH	REEL # N/A
	N/A
362.2M - 1-38mm ID HOPE, 1-38mm ID HOPE (SPARE), 1-32mm ID HOPE (SPARE)	

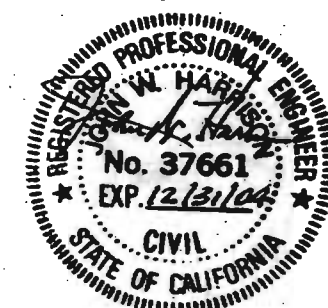

LEGEND

	Interstate Hwy.		Regen Site
	U.S. Hwy.		P.O.P./Jct.
	State Hwy.		Manhole Splice
	County Road		Manhole
	RR City Lbr.		Manhole Splice
	Mile. Road Sign		Manhole
	New Fiber Cable		30 Manhole
	Turnably Line		Power Pole / Meter
	City Limits		Water Valve / Meter
	R/W Line		Gas Valve / Meter
	River/Stream		Signal Pole
	Cl. Road		Fire Hydrant
	Cl. RR Tracks		Gas Marker
	Fence		Oil Marker
	Oil Pipeline		Fiber Marker
	Gas Pipeline		Water Inlet
	Power Line		
	Water Line		
	San. Sewer		
	Storm Drain		
	Telephone Line		
	Blank Iron Pipe		
	GLP.		
	EP		
	EC		
	FC		
	FL		
	Fog Line and/or White Line		

WILLIAMS
EMERGENCY NOTIFICATION NUMBER
1-800-582-9089

CAUTION

WILLIAMS LOCATE @ FOR
COUNTY, STATE
1-888-265-2283

FOREIGN UTILITY LOCATIONS ARE
APPROXIMATE. CONTACT THE LOCAL ONE
CALL AGENCY 48 HOURS PRIOR
TO CONSTRUCTION FOR EXACT
UTILITY LOCATIONS AT :
1-800-227-2600

[illegible]

WILLIAMS		COMMUNICATIONS GROUP Network Services	
POINT ARENA TO SACRAMENTO CABLE ROUTE			
DRAWN BY : MTW		DATE : 08/08/90	
CHECKED BY : KBO		DATE : 08/08/90	
APPROVED BY :		DATE :	
APPROVED BY :		DATE :	
AFE : 4875		LOC. CODE : 000001	
HORIZONTAL SCALE (HWD & PROF) : 1:30.0			
VERTICAL SCALE (HWD) : 1:30.0			
VERTICAL SCALE (PROF) : 1:30.0			
MAP PROJECTION : MAP-PROJECTION			
DRAWING NUMBER : PTAR-SACR-317-SPRD 5			

OWNERSHIP

SONOMA COUNTY

153+13.1 POWER POLE 3.7M LT

154+22.7 CULVERT 6.1M LT


154+82.9 POWER POLE 4.0M LT

155+21.4 POWER POLE 3.9M LT

155+21.9 GUY WIRE 1.4M LT

155+38.3 ROAD SIGN 0.9M LT

155+79.9 CULVERT 6.9M LT

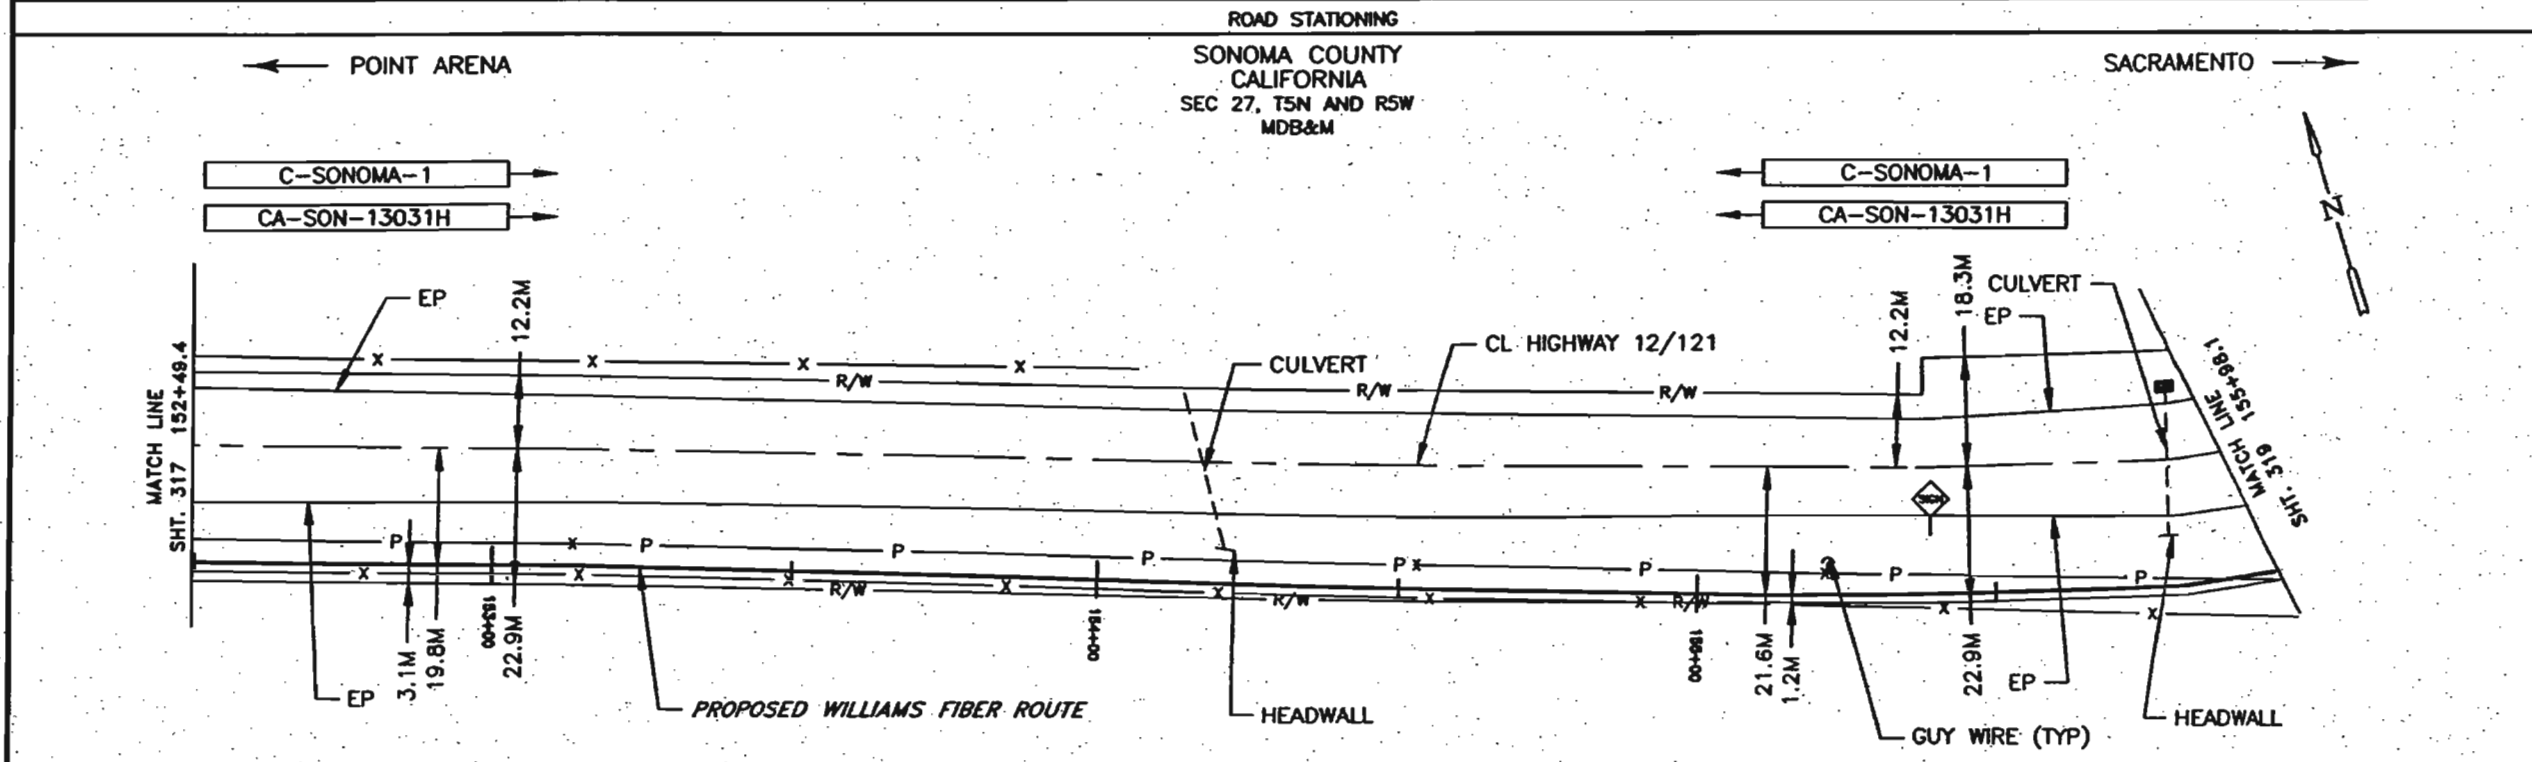

LEGEND

Interstate Hwy.	Regen Site
U.S. Hwy.	P.O.P./Jct.
State Hwy.	Handhole Split
County Road	Handhole
RR Mile Mr.	Manhole Split
Mile Road Sign	Manhole
New Fiber Cable	SS Manhole
Township Line	Water Valve / Meter
City Limits	Gas Valve / Meter
R/W Line	Signal Pole
Road/Stream	Fire Hydrant
CL Road	Gas Marker
CL RR Tracks	Oil Marker
Fence	Fiber Marker
Gas Pipeline	Water Inlet
Oil Pipeline	
Power Line	
Water Line	
San. Sewer	
Storm Drain	
Telephone Line	
Black Iron Pipe	
Galvanized Iron Pipe	
Edge of Pavement	
Edge of Gravel	
Face of Curb	
Fog Line and/or White Line	

WILLIAMS

EMERGENCY NOTIFICATION NUMBER

1-800-582-9069

CAUTION

WILLIAMS LOCATE # FOR COUNTY, STATE

1-888-265-2283

FOREIGN UTILITY LOCATIONS ARE APPROXIMATE. CONTACT THE LOCAL ONE CALL AGENCY 48 HOURS PRIOR TO CONSTRUCTION FOR EXACT UTILITY LOCATIONS AT :

1-800-227-2600

152+49.4		155+98.1
----------	--	----------

96 - LEAF FIBER, LOOSE BUFFER TUBE CABLE, 12 FIBERS PER TUBE, DIELECTRIC CENTRAL MEMBER, DUAL JACKET SINGLE ARMOR, 1000 LB TENSILE STRENGTH

REEL # N/A

N/A

348.7M - 1-38mm ID HDPE, 1-38mm ID HDPE (SPARE), 1-32mm ID HDPE (SPARE)

REVISIONS

REV. NO.	DESCRIPTION	BY	DATE
0	PERMIT	KCN	01/14

CABLE FIBER COUNT	TYPE OF GLASS	CABLE DESCRIPTION

SPACE TO SPACE CABLE LENGTH & COIL LENGTH	PIPE & BURENDUCT PLACEMENT

BURENDUCT & TYPE (CONC/SHEDD/COLOR)	PIPE & BURENDUCT PLACEMENT


STEEL PIPE SIZE	PIPE & BURENDUCT PLACEMENT

PVC	PIPE & BURENDUCT PLACEMENT

FUTURE-2	FUTURE

FUTURE-3	USE PLACE

FUTURE-4	USE PLACE

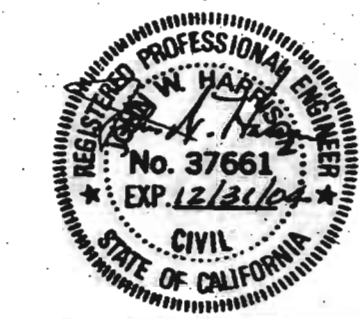

WILLIAMS COMMUNICATIONS GROUP
Network Services

POINT ARENA TO SACRAMENTO CABLE ROUTE

DRAWN BY : MTW	DATE : 05/05/00
CHECKED BY : KCB	DATE : 05/05/00
APPROVED BY :	DATE :
APPROVED BY :	DATE :
AFE :	LOC. CODE : 000001
HORIZONTAL SCALE (DWG & PROF) :	1:38.5
VERTICAL SCALE (DWG) :	1:38.5
VERTICAL SCALE (PROF) :	1:38.5
MAP PROJECTION :	MAP-PROJECTION
DRAWING NUMBER :	PTAR-SACR-318-SPRD 5

58+31.8 POWER POLE 7.1M RT
58+32.0 GUY WARE 8.7M RT

150+80.3 POWER POLE 9.1M RT
150+81.3 CUT WARE / 9M RT

57+86.6 POWER POLE 0.9M RT .


58+55.1 POWER POLE 1.1M LT
58+56.7 GUY WIRE 1.5M RT
58+58.0 PLACE MANHOLE

59+22.9 CUY WIRE
59+24.9 CUY WIRE 4.0M LT
59+26.9 POWER POLE 0.4M LT
59+28.9 POWER POLE 0.6M RT
59+31.9 CUY WIRE 1.0M LT

ROAD STATIONING

NAPA COUNTY
CALIFORNIA
SEC 26, T5N AND R5W
MDB&M.

SACRAMENTO

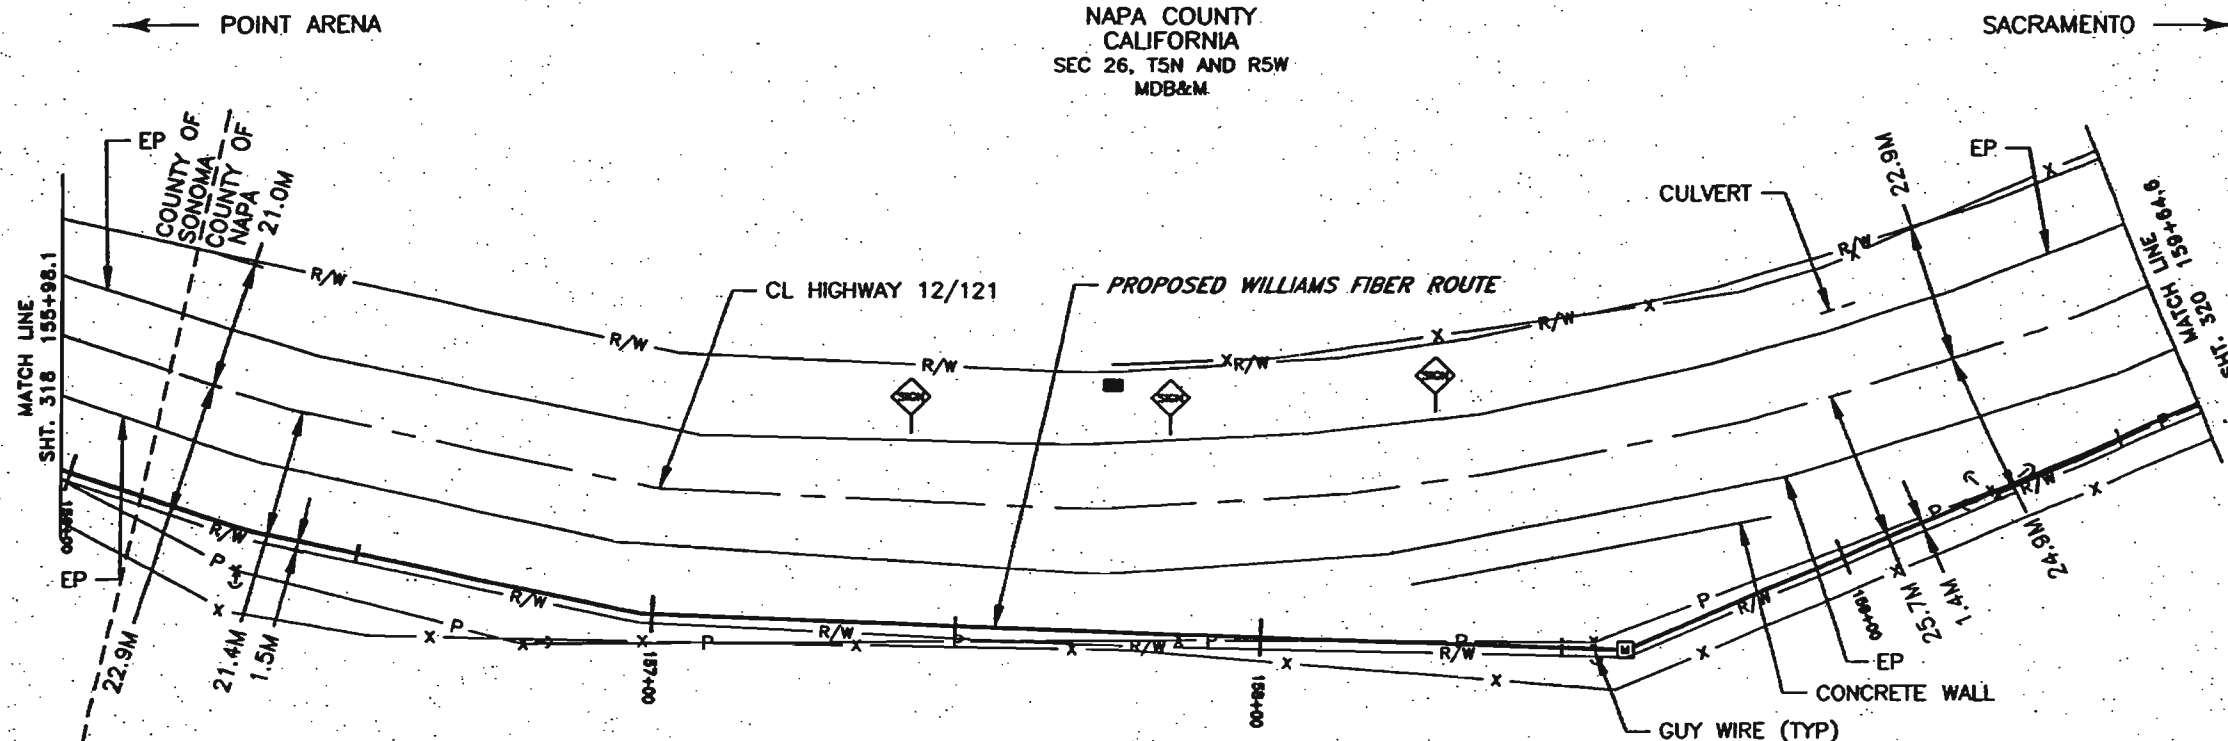

155+98.1

878+65

96 - LEAF FIBER, LOOSE BUFFER TUBE CABLE, 12 FIBERS PER TUBE, DIELECTRIC CENTRAL MEMBER, DUAL JACKET SINGLE ARMOR, 1000 LB TENSILE STRENGTH

REEL # N/A

N/A

366.5M - 1-38mm ID HDPE, 1-38mm ID HDPE (SPARE), 1-32mm ID HDPE (SPARE)

LEGEND

- | | | | |
|--|-----------------------------|--|---------------------|
| | Interstate Hwy. | | Regen. Site |
| | U.S. Hwy. | | P.O.P./Jct. |
| | State Hwy. | | Manhole Splice |
| | County Road | | Manhole |
| | RR Mile Mkr. | | SS Manhole |
| | Mile. Road Sign | | Power Pole |
| | New Fiber Cable | | Water Valve / Water |
| | Turnaway Line | | Gas Valve / Water |
| | City Limits | | Signal Pole |
| | R/W Line | | Fire Hydrant |
| | River/Stream | | Gas Marker |
| | CL Road | | OS Marker |
| | CL RR Tracks | | Fiber Marker |
| | Fence | | Water Inlet |
| | Oil Pipeline | | |
| | Gas Pipeline | | |
| | Power Line | | |
| | Water Line | | |
| | San. Sewer | | |
| | Storm Drain | | |
| | Telephone Line | | |
| | Black Iron Pipe | | |
| | Culvert under Pipe | | |
| | Edge of Pavement | | |
| | Edge of Ground | | |
| | Face of Curb | | |
| | Flag Line and/or White Line | | |

WILLIAMS

EMERGENCY NOTIFICATION NUMBER

1-800-582-9063

CAUTION

**WILLIAMS LOCATE & FOR
COUNTY, STATE
1-888-265-2283**

FOREIGN UTILITY LOCATIONS ARE APPROXIMATE. CONTACT THE LOCAL ONE CALL AGENCY 48 HOURS PRIOR TO CONSTRUCTION FOR EXACT UTILITY LOCATIONS AT :

1-800-227-2600

REVISIONS

[illegible]

CABLE FIBER COUNT MFG. TYPE OF GLASS	CABLE DESCRIPTION
CABLE REEL NO.	
SPACE TO SPACE CABLE LENGTH & COIL LENGTH	PIPE & IMBURSED LENGTHS
NUMBER & TYPE (COND./SHOWN/COLOR)	
STEEL PIPE SIZE	FUTURE USE PLACE
PVC	
FUTURE-2	
FUTURE-3	
FUTURE-4	

COMMUNICATIONS GROUP
Network Services

POINT ARENA TO SACRAMENTO CABLE ROUTE

DRAWN BY: ALJ	DATE: 06/06/00
CHECKED BY: HSB	DATE: 06/06/00
APPROVED BY:	DATE:
APPROVED BY:	DATE:
AFE: 4675 LOC. CODE: 000001 HORIZONTAL SCALE (HWS & PWS): 1:30.5 VERTICAL SCALE (HVS): 1:30.5 VERTICAL SCALE (PVS): 1:30.5 MAP PROJECTION: MAP-PROJECTION	
DRAWING NUMBER: PTAR-SACR-319-SPRD 5	

DRAWING NUMBER : PTAR-SACR-319-SPRD 5

OWNERSHIP

NAPA COUNTY


165+76.4 PLACE MARKER

ROAD STATIONING
NAPA COUNTY
CALIFORNIA
SEC 26, T5N AND R5W
MDB&M

POINT ARENA

SACRAMENTO

D-NAPA-A

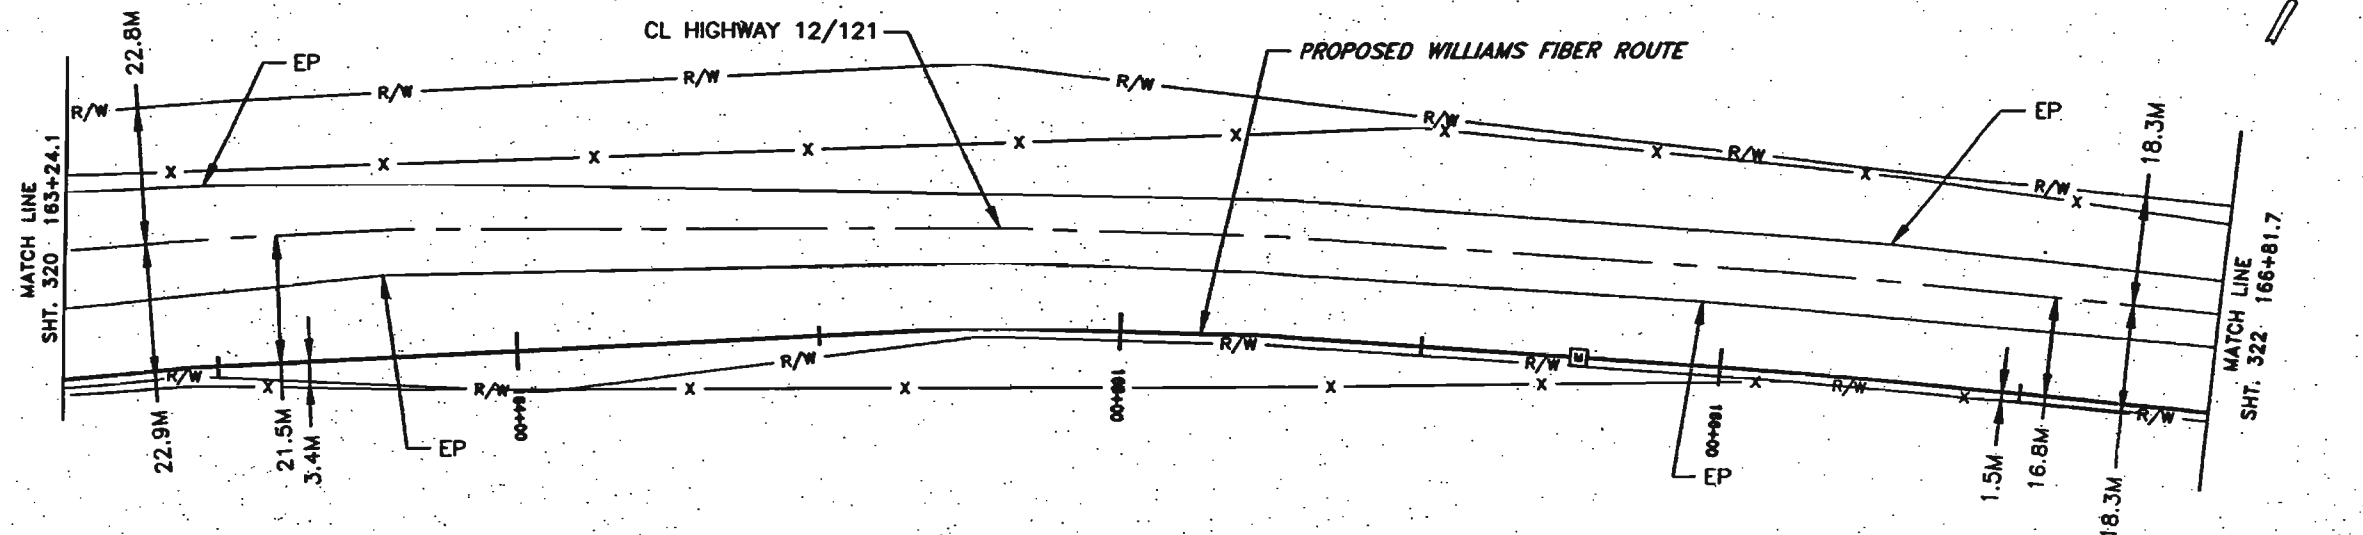

LEGEND

- Interstate Hwy.
- U.S. Hwy.
- State Hwy.
- County Road
- RM Mile Marker
- Min. Road Sign
- New Fiber Cable
- Traverse Line
- City Limits
- R/W Line
- River/Stream
- CL Road
- CL RR Tracks
- Fence
- OS Pipeline
- Gas Pipeline
- Power Line
- Water Line
- San. Sewer
- Storm Drain
- Telephone Line
- BLP
- CLP
- EP
- ES
- FC
- FL
- Regen Site
- P.O.P./Jct.
- Handhole Splice
- Handhole
- Manhole Splice
- Manhole
- SS Manhole
- Power Pole
- Water Valve / Meter
- Gas Valve / Meter
- Signal Pole
- Pole Hydrant
- Gas Marker
- Oil Marker
- Fiber Marker
- Water Inlet

WILLIAMS

EMERGENCY NOTIFICATION NUMBER
1-800-582-9089

CAUTION

WILLIAMS LOCATE # FOR
COUNTY, STATE
1-888-285-2283

FOREIGN UTILITY LOCATIONS ARE
APPROXIMATE. CONTACT THE LOCAL ONE
CALL AGENCY 48 HOURS PRIOR
TO CONSTRUCTION FOR EXACT
UTILITY LOCATIONS AT :

1-800-227-2600

REVISIONS

REV. NO.	DESCRIPTION	BY	DATE
0	PERMIT	RSN	11/14


96 - LEAF FIBER, LOOSE BUFFER TUBE CABLE, 12 FIBERS PER TUBE, DIELECTRIC CENTRAL MEMBER, DUAL JACKET SINGLE ARMOR, 1000 LB TENSILE STRENGTH

REEL # N/A

N/A

357.6M - 1-38mm ID HDPE, 1-38mm ID HDPE (SPARE), 1-32mm ID HDPE (SPARE)


CABLE FIBER COUNT	WPL TYPE OF GLASS	CABLE DESCRIPTION
CABLE REEL NO.		
SPACE TO SPACE CABLE LENGTH & COIL LENGTH		
INSULATION & TYPE (COND/SHIELD/COLOR)		PIPE &
STEEL PIPE SIZE		INSULATION PLACEMENT
PVC		
FIGURE-2		FUTURE USE PLACE
FIGURE-3		
FIGURE-4		

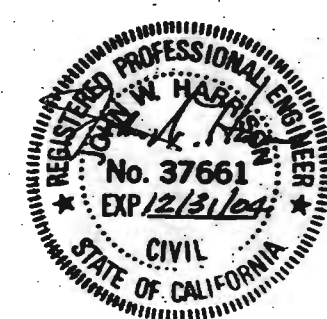

COMMUNICATIONS GROUP
Network Services

POINT ARENA TO SACRAMENTO
CABLE ROUTE

DRAWN BY : ALI	DATE : 09/05/00
CHECKED BY : J20	DATE : 09/05/00
APPROVED BY :	DATE :
APPROVED BY :	DATE :
APR : 4075	LOC. CODE : 800001
HORIZONTAL SCALE (DWG & PROF) : 1:30.5	
VERTICAL SCALE (DWG) : 1:30.5	
VERTICAL SCALE (PROF) : 1:30.5	
MAP PROJECTION : MAP-PROJECTION	
DRAWING NUMBER : PTAR-SACR-321-SPRD 5	

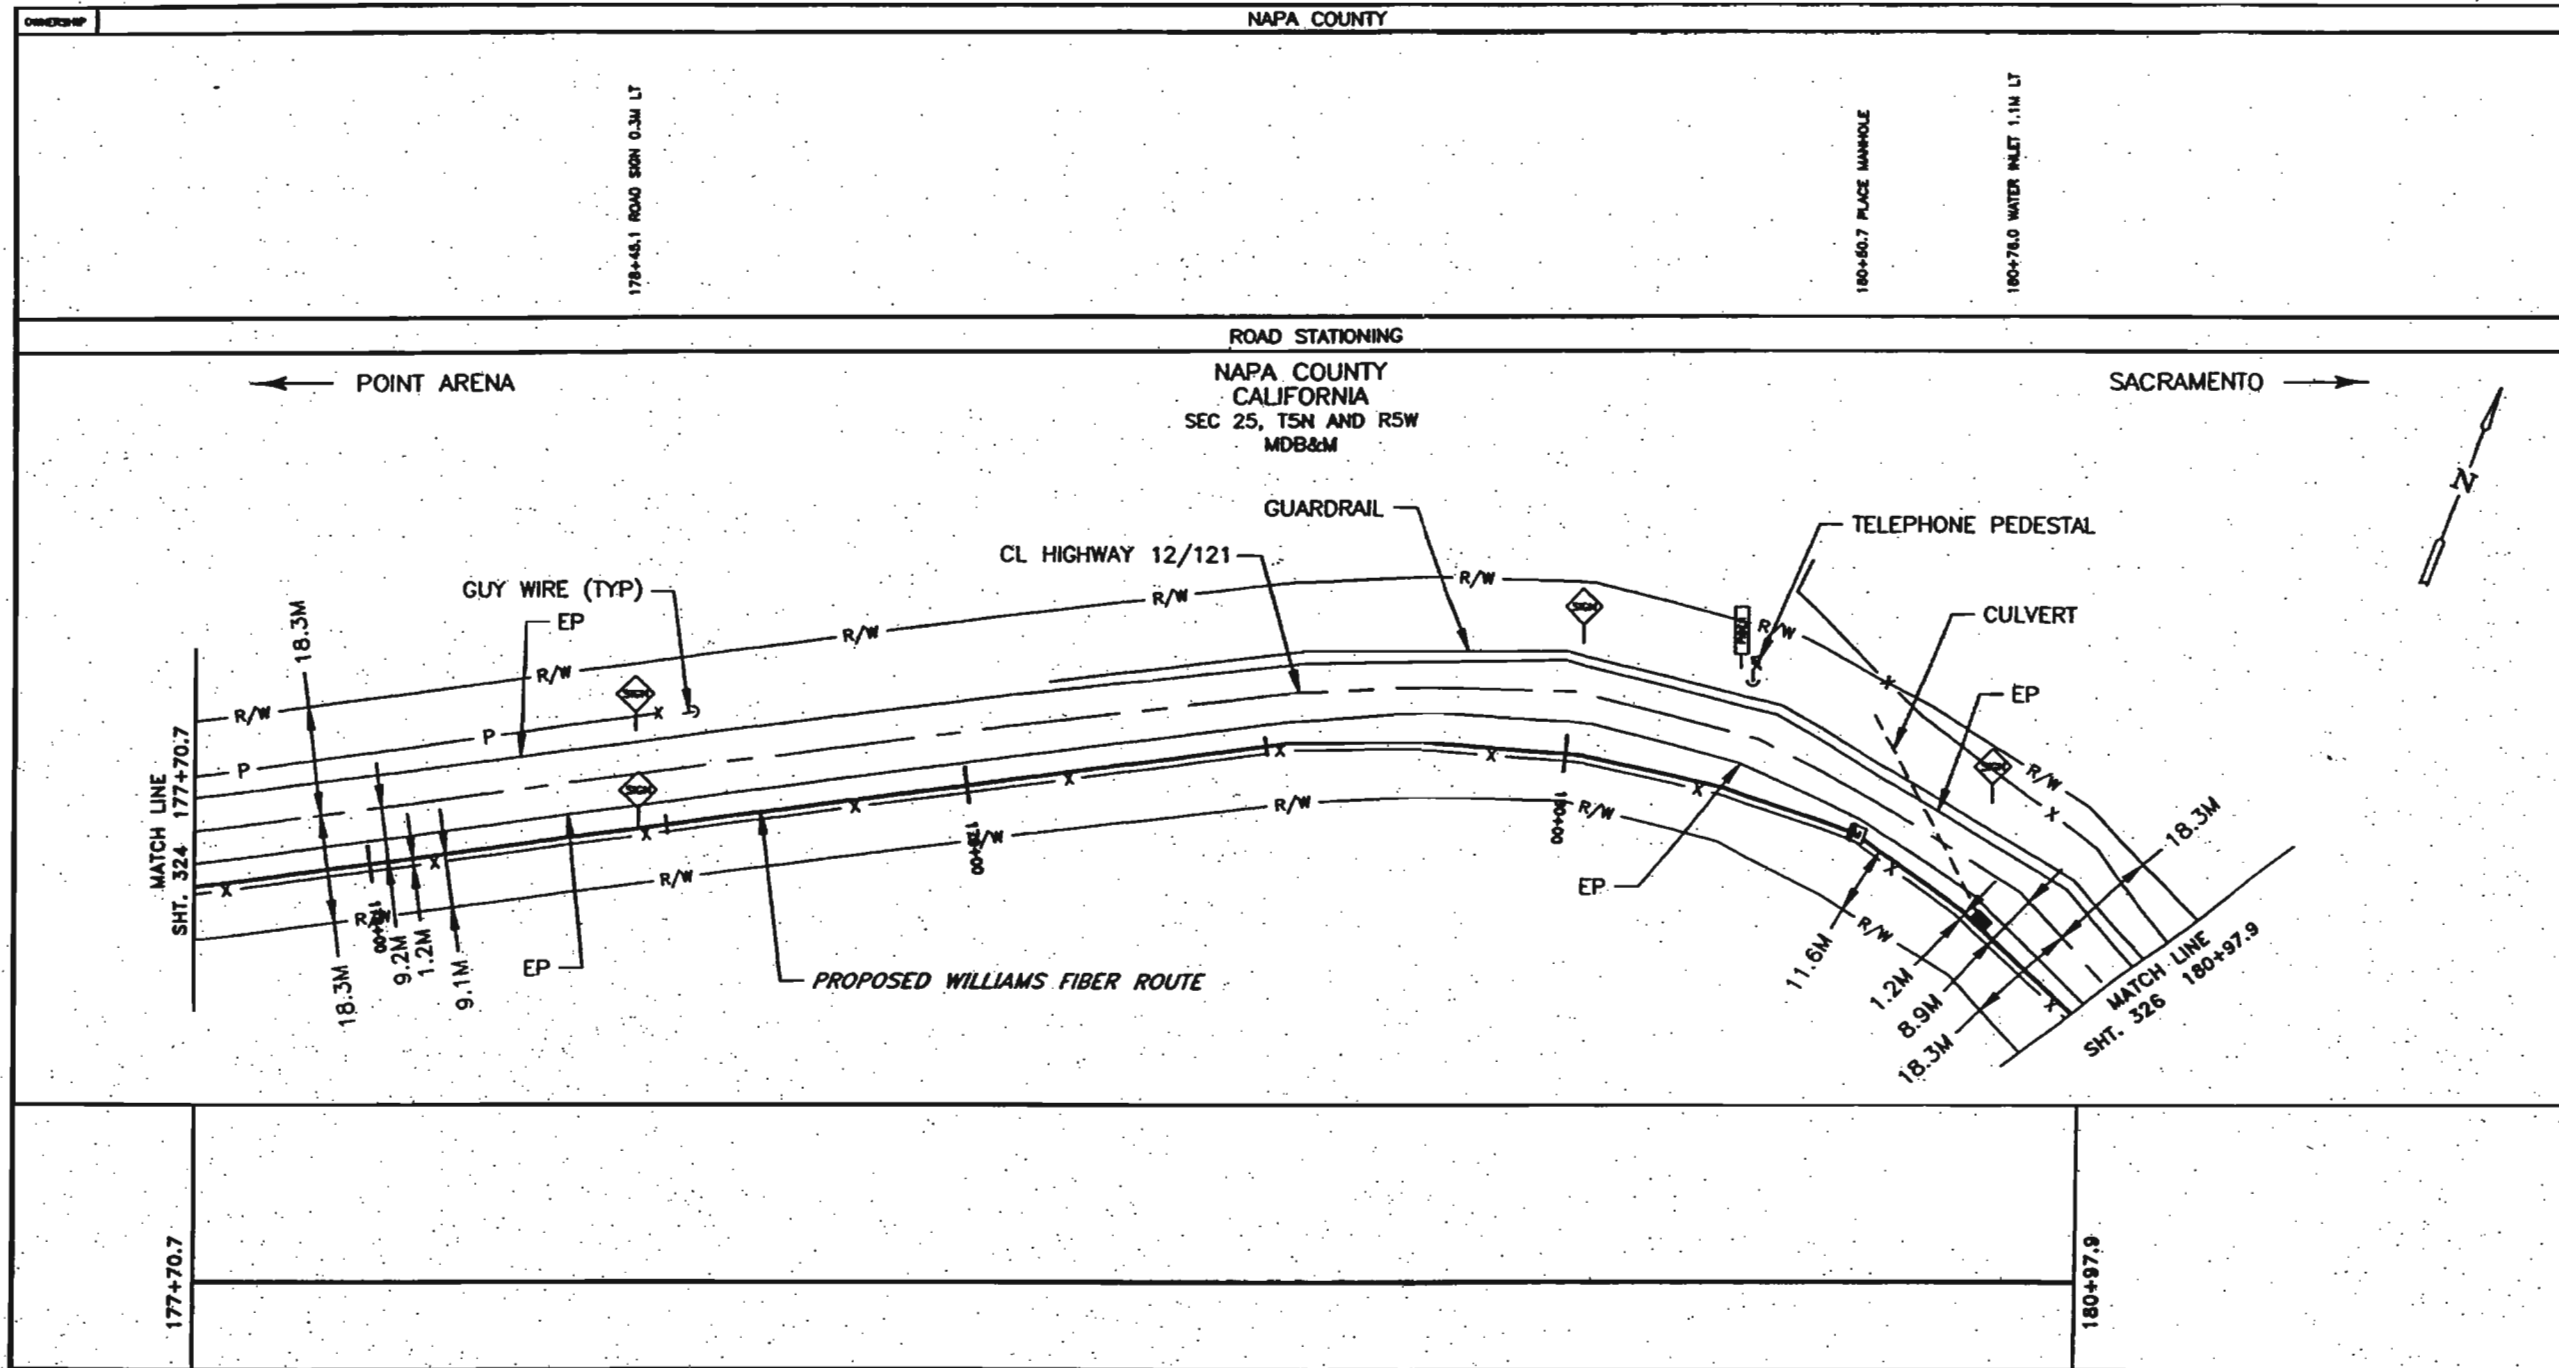

LEGEND

Interstate Hwy.	Right Side
U.S. Hwy.	P.O.P./Jct.
State Hwy.	Handhole Splice
County Road	Handhole
RR Mile Marker	Handhole Splice
Min. Road Sign	Handhole
New Fiber Cable	SS Handhole
Traverse Line	Power Pole
City Limits	Water Valve / Meter
R/W Line	Gas Valve / Meter
Road/Stream	Signal Pole
CL Road	Fire Hydrant
CL RR Tracks	Gas Marker
Fence	Oil Marker
OS Pipeline	Fiber Marker
Gas Pipeline	Water Inlet
Power Line	
Water Line	
Sew. Sewer	
Storm Drain	
Telephone Line	
BLP.	Black Iron Pipe
SLP.	Galvanized Iron Pipe
EP	Edge of Pavement
EB	Edge of Ground
FC	Face of Curb
FL	Fog Line and/or White Line

WILLIAMS
 EMERGENCY NOTIFICATION NUMBER
 1-800-582-9089

CAUTION
 WILLIAMS LOCATE # FOR
 COUNTY, STATE
 1-888-285-2283

FOREIGN UTILITY LOCATIONS ARE
 APPROXIMATE. CONTACT THE LOCAL ONE
 CALL AGENCY 48 HOURS PRIOR
 TO CONSTRUCTION FOR EXACT
 UTILITY LOCATIONS AT :
 1-800-227-2600

REVISIONS

REV. NO.	DESCRIPTION	BY	DATE
0	PERMIT	KSH	11/1/00


96 - LEAF FIBER, LOOSE BUFFER TUBE CABLE, 12 FIBERS PER TUBE, DIELECTRIC CENTRAL MEMBER, DUAL JACKET SINGLE ARMOR, 1000 LB TENSILE STRENGTH	CABLE FIBER COUNT MFR, TYPE OF GLASS	CABLE
REEL # N/A	CABLE REEL NO.	DESCRIPTION
327.2M - 1-38mm ID HDPE, 1-38mm ID HDPE (SPARE), 1-32mm ID HDPE (SPARE)	SPACE TO SPLICER CABLE LENGTH & COIL LENGTH	
	CONDUIT & TYPE (CONDUIT/SHIELDING/CABLE)	PIPE
	STEEL PIPE SIZE	WIREMAN
	PVC	PLACEMENT
	FIGURE-2	FIGURE
	FIGURE-3	FIGURE
	FIGURE-4	FIGURE



COMMUNICATIONS GROUP
 Network Services

**POINT ARENA TO SACRAMENTO
 CABLE ROUTE**

DRAWN BY : AJ	DATE : 09/08/00
CHECKED BY : KSH	DATE : 09/08/00
APPROVED BY :	DATE :
APPROVED BY :	DATE :
DATE :	LOC. CODE : 000001
HORIZONTAL SCALE (HWS & PROF) : 1:30.0	
VERTICAL SCALE (HWS) : 1:30.0	
VERTICAL SCALE (PROF) : 1:30.0	
MAP PROJECTION : UTM-PROJECTION	
DRAWING NUMBER : PTAR-SACR-325-SPRD 5	

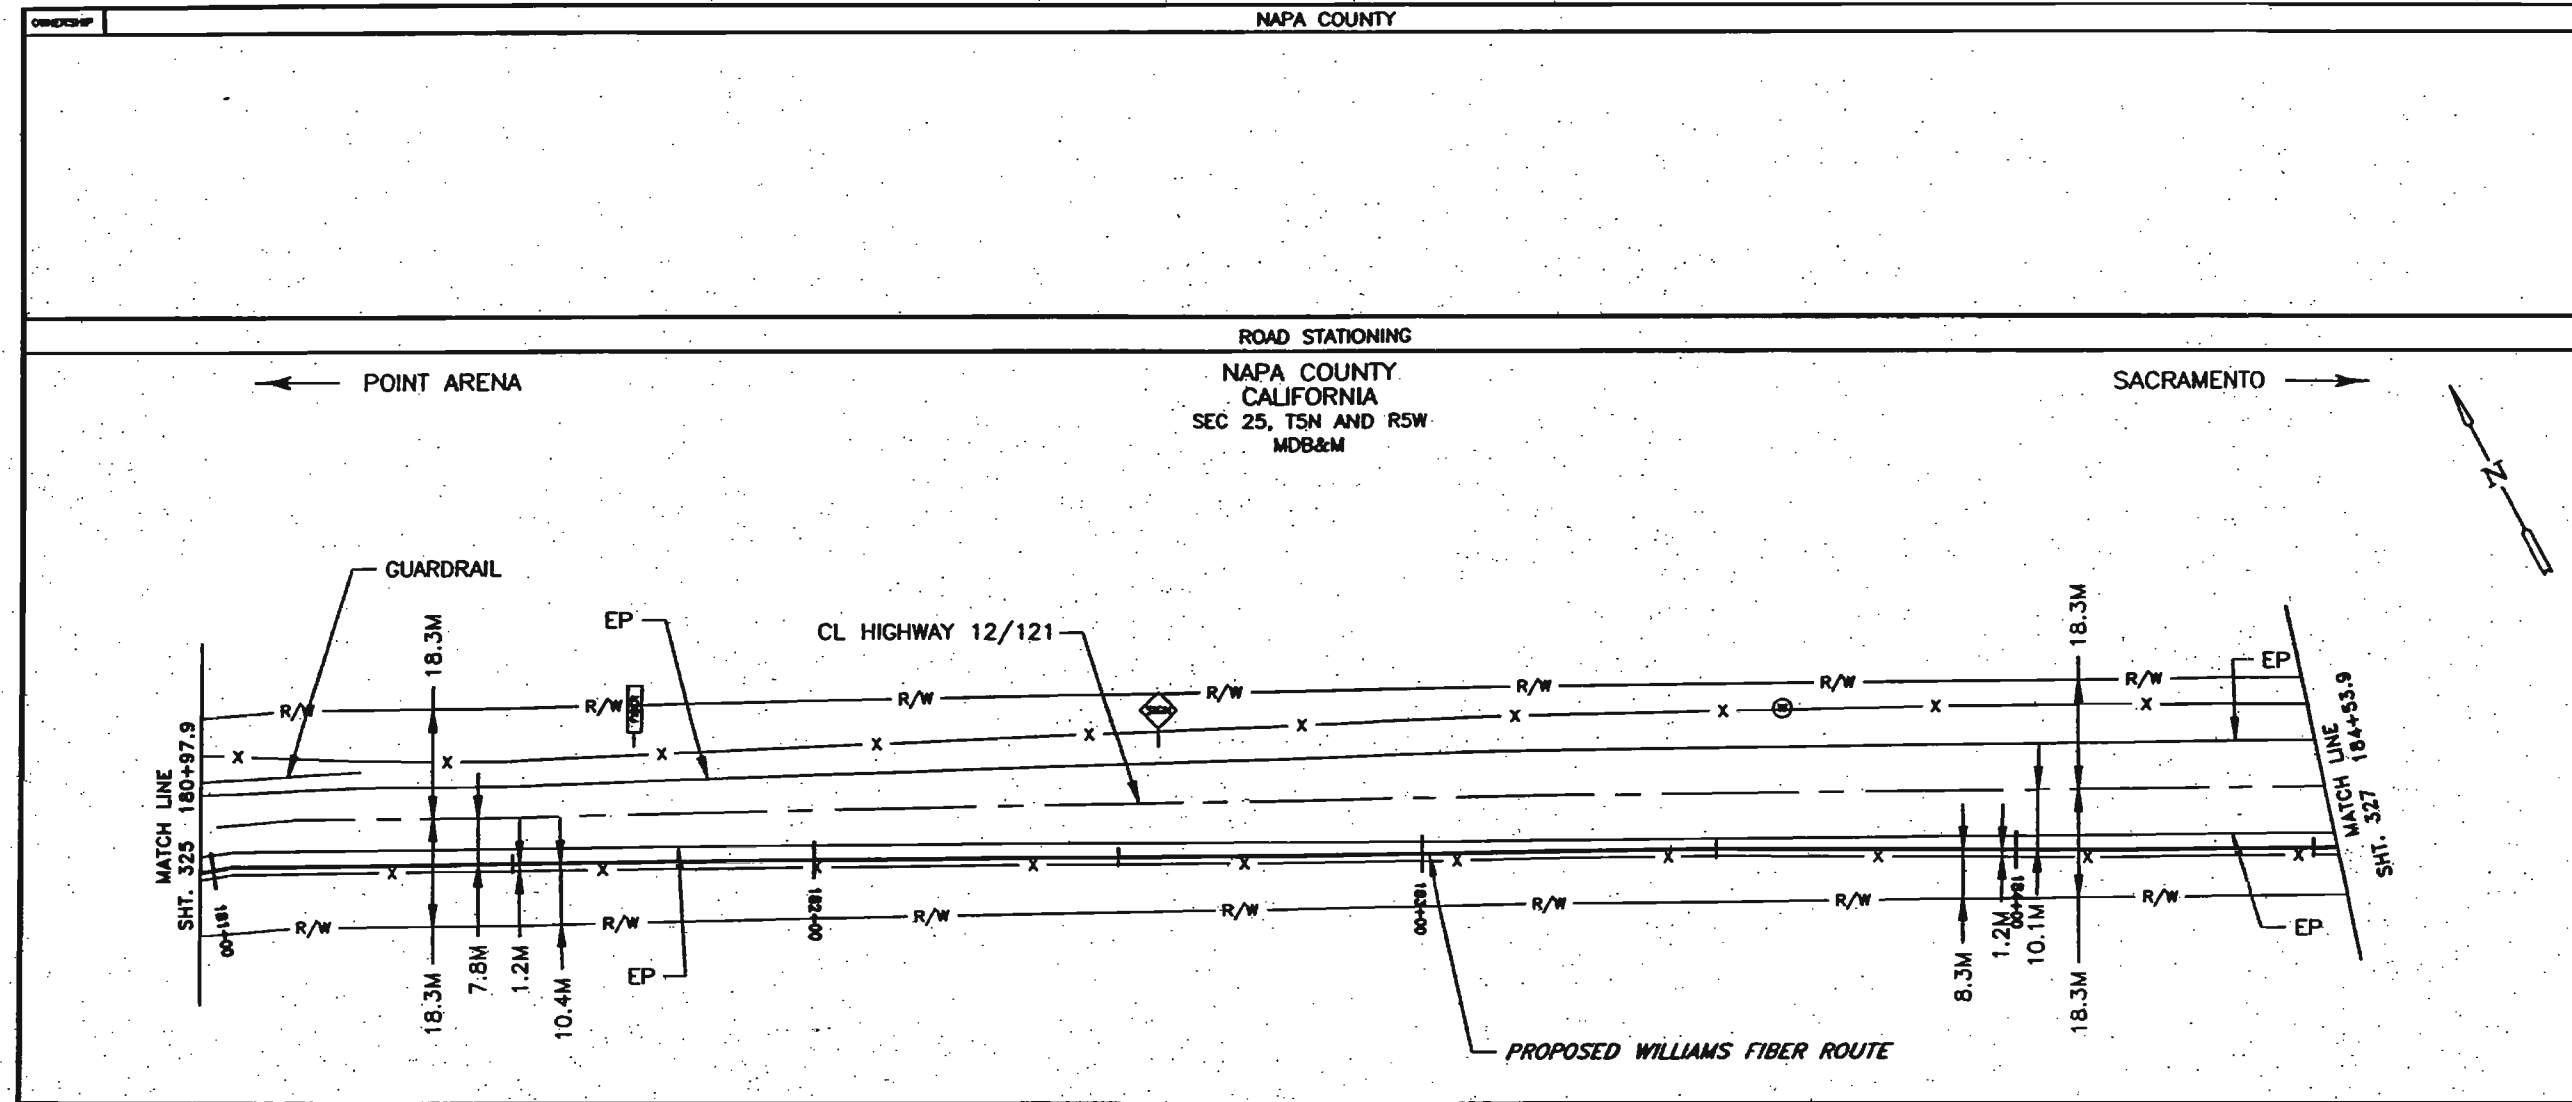

LEGEND

Interstate Hwy.	Regen Site
U.S. Hwy.	P.O.P./Jct.
State Hwy.	Handhole Splice
County Road	Handhole
RT Mile Mar.	Handhole Splice
Misc. Road Sign	Handhole
New Fiber Cable	25 Handhole
Township Line	Power Pole
City Limits	Water Valve / Meter
R/W Line	Gas Valve / Meter
Road/Stream	Signal Pole
Q. Road	Fire Hydrant
Q. RT Trunk	Gas Marker
Power	Oil Marker
Oil Pipeline	Oil Marker
Gas Pipeline	Fiber Marker
Power Line	Water Inlet
Water Line	
San. Sewer	
Storm Drain	
Telephone Line	
Black Iron Pipe	
Galvanized Iron Pipe	
Edge of Pavement	
Edge of Gravel	
Face of Curb	
Fog Line and/or White Line	

WILLIAMS

EMERGENCY NOTIFICATION NUMBER
1-800-582-9069

CAUTION

WILLIAMS LOCATE # FOR
COUNTY, STATE
1-888-265-2283


FOREIGN UTILITY LOCATIONS ARE
APPROXIMATE. CONTACT THE LOCAL ONE
CALL AGENCY 48 HOURS PRIOR
TO CONSTRUCTION FOR EXACT
UTILITY LOCATIONS AT :
1-800-227-2600

180+97.9		184+53.9
96 - LEAF FIBER, LOOSE BUFFER TUBE CABLE, 12 FIBERS PER TUBE, DIELECTRIC CENTRAL MEMBER, DUAL JACKET SINGLE ARMOR, 1000 LB TENSILE STRENGTH		
REEL # N/A		
N/A		
356.0M - 1-38M ID HDPE, 1-38M ID HDPE (SPARE), 1-32M ID HDPE (SPARE)		
CABLE FIBER COUNT MFG. TYPE OF GLASS		
CABLE REEL NO.		
SPICE TO SPICE CABLE LENGTH & COIL LENGTH		
INSTRUMENT & TYPE (COM/SHOWN/COLOR)		
SHEIL PIPE SIZE		
PVC		
FURNISH-2		
FURNISH-3		
FURNISH-4		

REVISIONS

REV. NO.	DESCRIPTION	BY	DATE
0	PERMIT	KSH	01/14

CABLE DESCRIPTION	CABLE
FIBER & INVERTMENT PLACEMENT	FIBER & INVERTMENT PLACEMENT

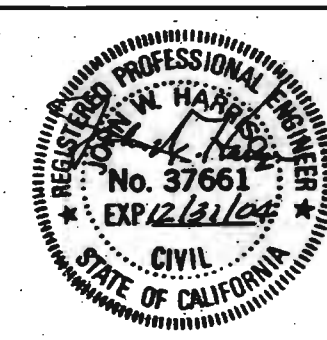

COMMUNICATIONS GROUP
Network Services

**POINT ARENA TO SACRAMENTO
CABLE ROUTE**

DRAWN BY : AUJ	DATE : 09/04/00
CHECKED BY : KSH	DATE : 09/04/00
APPROVED BY :	DATE :
APPROVED BY :	DATE :

A/E : 4875 LOC. CODE : 000001


HORIZONTAL SCALE (DWG & PROF) : 1:30.5

VERTICAL SCALE (DWG) : 1:30.5

VERTICAL SCALE (PROF) : 1:30.5

MAP PROJECTION : MAP-PROJECTION

DRAWING NUMBER : PTAR-SACR-326-SPRD 5

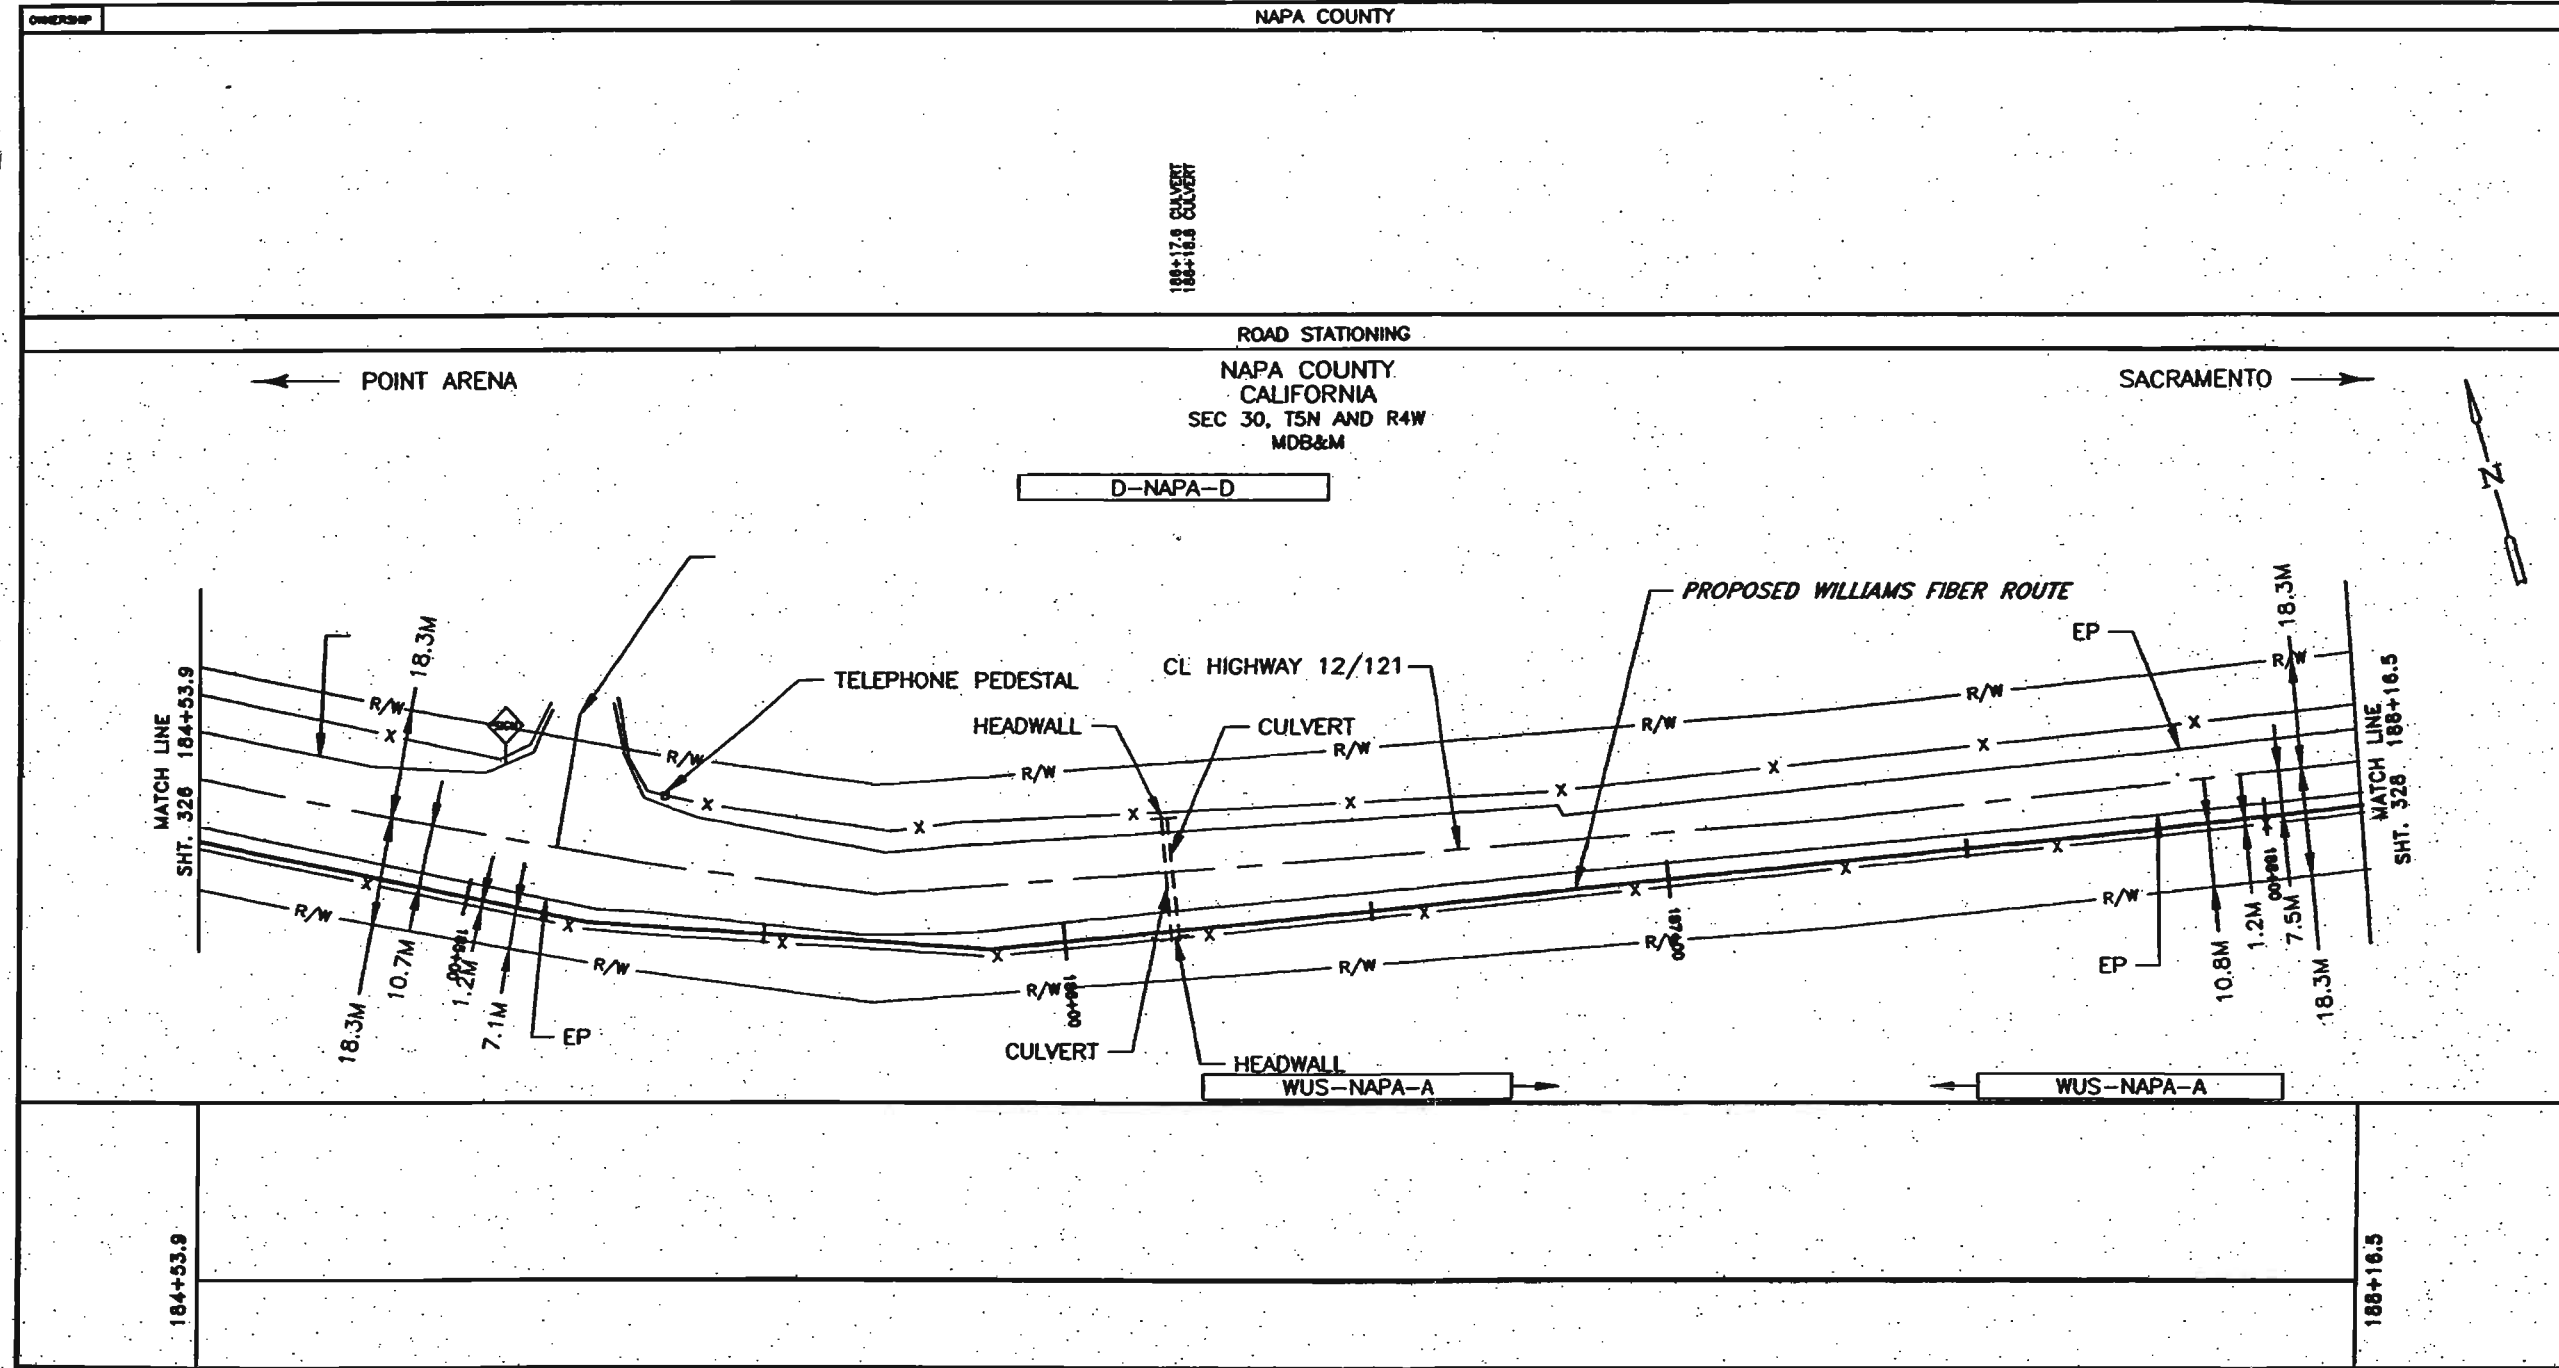

LEGEND

Interstate Hwy.	Regen Site
U.S. Hwy.	P.O.P./Jct.
State Hwy.	Handhole Splice
County Road	Handhole
RR Mile Mr.	Handhole Splice
Min. Road Sign	Handhole
New Fiber Cable	SS Handhole
Trenching Line	Power Pole
City Line	Water Valve / Meter
T/W Line	Gas Valve / Meter
River/Stream	Signal Pole
CL Road	Fire Hydrant
CL RR Tracks	Gas Marker
Fence	Oil Marker
Oil Pipeline	Fiber Marker
Gas Pipeline	Water Inlet
Power Line	
Water Line	
San. Sewer	
Storm Drain	
Telephone Line	
Black Iron Pipe	
Submerged Iron Pipe	
B.I.P.	Edge of Pavement
G.I.P.	Edge of Ground
EP	Face of Curb
GS	Fog Line and/or White Line
FL	

WILLIAMS

EMERGENCY NOTIFICATION NUMBER

1-800-582-9068

CAUTION

WILLIAMS LOCATE & FOR
COUNTY, STATE
1-888-265-2283


FOREIGN UTILITY LOCATIONS ARE
APPROXIMATE. CONTACT THE LOCAL ONE
CALL AGENCY 48 HOURS PRIOR
TO CONSTRUCTION FOR EXACT
UTILITY LOCATIONS AT :

1-800-227-2500

REVISIONS

REV. NO.	DESCRIPTION	BY	DATE
1	PERMIT	KSM	01/14

96 - LEAF FIBER, LOOSE BUFFER TUBE CABLE, 12 FIBERS PER TUBE, DIELECTRIC CENTRAL MEMBER, DUAL JACKET SINGLE ARMOR, 1000 LB TENSILE STRENGTH	CABLE FIBER CORDS MPD TYPE OF GLASS	CABLE DESCRIPTION
REEL # N/A	CABLE REEL NO.	
N/A	SPICE TO SPICE CABLE LENGTH & CIL LENGTH	
362.6M - 1-38mm ID HDPE, 1-38mm ID HDPE (SPARE), 1-32mm ID HDPE (SPARE)	INSULATION & TYPE (CUM/SHOWN/COLOR)	PIPE & DIMENSIONS
	STEEL PIPE SIZE	
	PVC	
	FIGURE-2	FIGURE-2
	FIGURE-3	FIGURE-3
	FIGURE-4	FIGURE-4

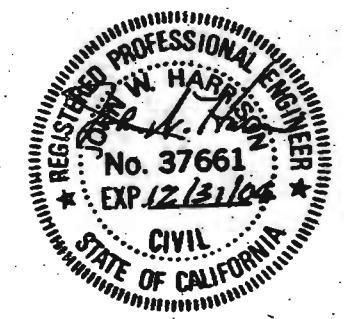


COMMUNICATIONS GROUP
Network Services

POINT ARENA TO SACRAMENTO
CABLE ROUTE

DRAWN BY : AJ	DATE : 06/06/00
CHECKED BY : KSM	DATE : 06/06/00
APPROVED BY :	DATE :
APPROVED BY :	DATE :
APE : KCS	LOC. CODE : 000001
HORIZONTAL SCALE (DIM & PROF) : 1:300.0	
VERTICAL SCALE (DIM) : 1:300.0	
VERTICAL SCALE (PROF) : 1:300.0	
MAP PROJECTION : MAP-PROJECTION	

DRAWING NUMBER : PTAR-SACR-327-SPRD 5

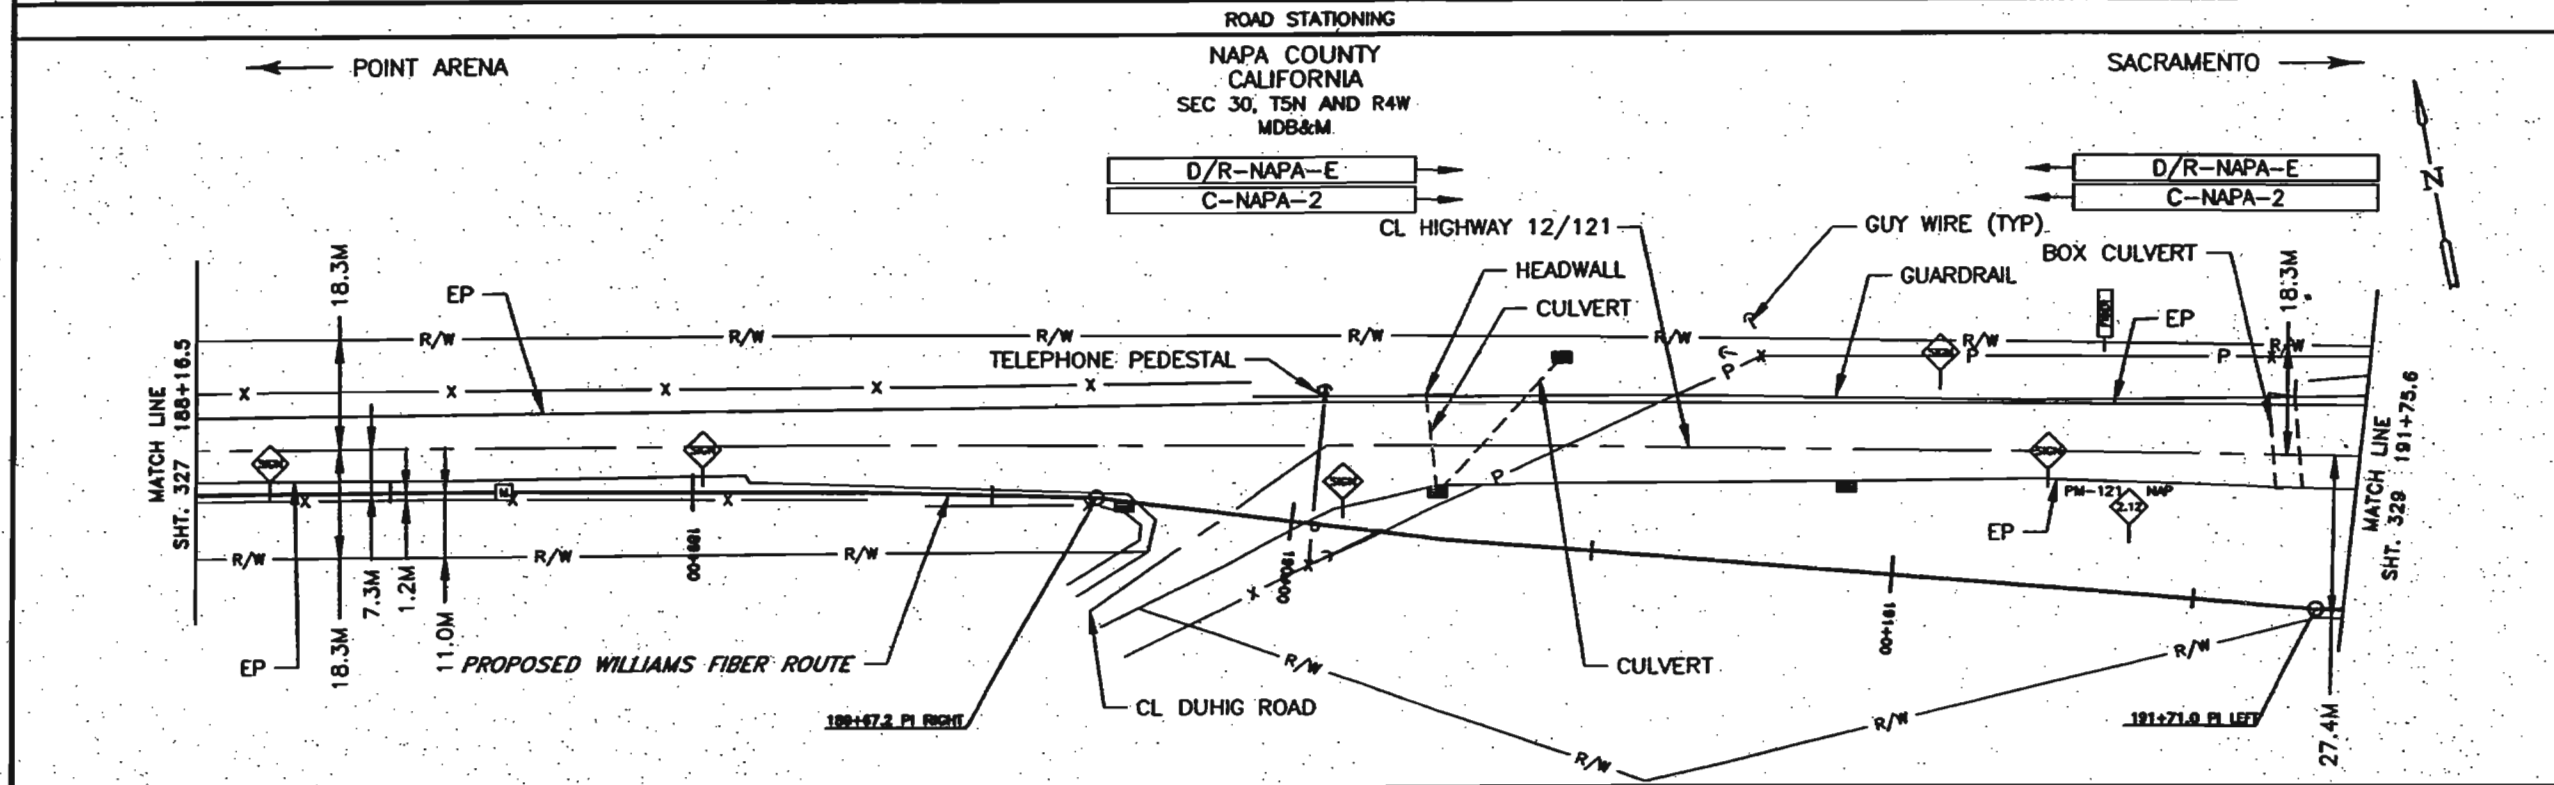


188+16.5		
191+75.6		

96 - LEAF FIBER, LOOSE BUFFER TUBE CABLE, 12 FIBERS PER TUBE, DIELECTRIC CENTRAL MEMBER, DUAL JACKET SINGLE ARMOR, 1000 LB TENSILE STRENGTH	REEL # N/A
	N/A
359.1M - 1-38mm ID HDPE, 1-38mm ID HDPE (SPARE), 1-32mm ID HDPE (SPARE)	

A circular professional engineer seal for John W. Harris, No. 37661, State of California, Civil Engineering. The seal features a signature across the center and the text "REGISTERED PROFESSIONAL ENGINEER" around the top and "STATE OF CALIFORNIA" around the bottom. The word "CIVIL" is at the bottom center. The number "No. 37661" and the date "EXP. 12/31/09" are prominently displayed in the center.

[illegible]

1365+54	52'	RT. FENCE COR.
1365+73	53'	RT. BRIDGE
1365+73	66'	RT. FIBER MARKER
1365+80	65'	RT. FIBER OPTIC
1365+88	58'	RT. FIBER OPTIC
1365+92	24'	RT. SIGN
1366+33	33'	RT. FENCE COR.
1366+49	32'	RT. FIBER MARKER
1366+72	24'	RT. FIBER OPTIC

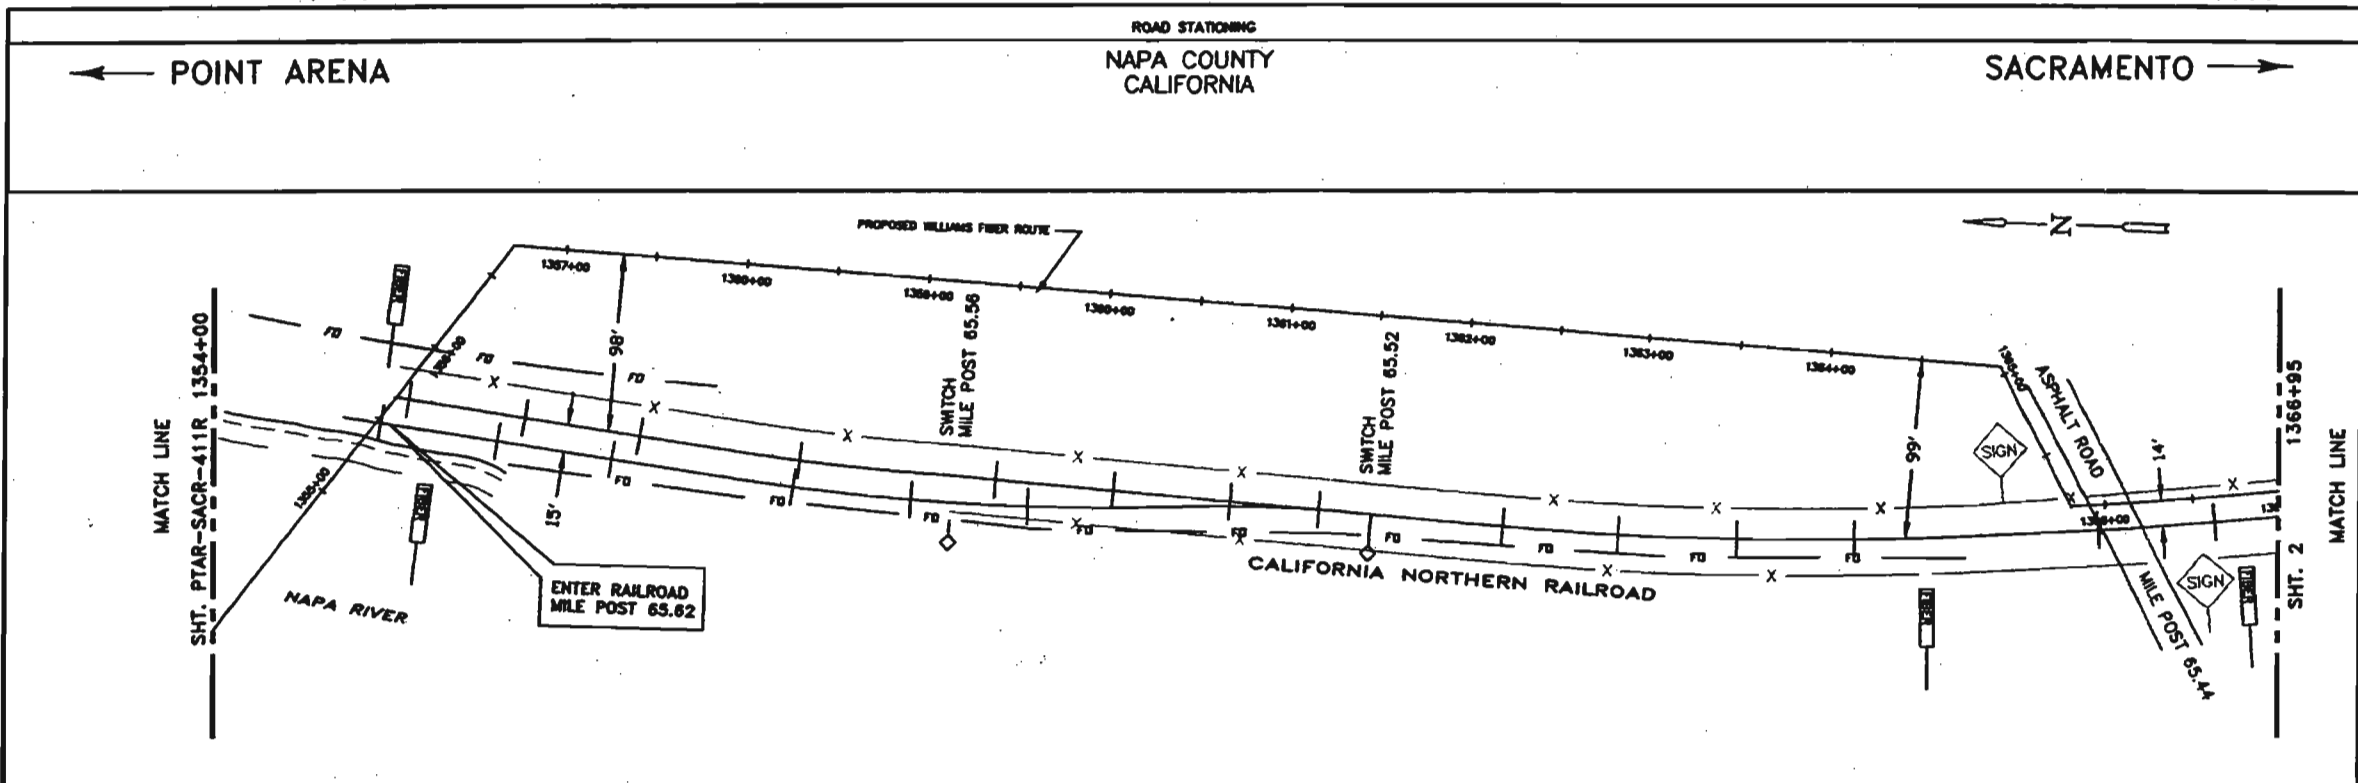

LEGEND

	Interstate Hwy.		Ragee Site
	U.S. Hwy.		PAP/Int.
	State Hwy.		Handmade Splice
	County Road		Handmade
	RR mile marker		Handmade Splice
	Miles. Road Sign		Handmade
	New Fiber Cable		SF Markers
	Trenching Line		Power Pole
	City Limits		Water Valve / Meter
	R/W Line		Gas Valve / Meter
	River/Stream		Signal Pole
	Cl. Road		Fire Hydrant
	Cl. RR Tracks		Gas Marker
	Fence		Oil Marker
	Oil Pipeline		Fiber Marker
	Gas Pipeline		Black Inset
	Power Line		
	Water Line		
	San. Sewer		
	Storm Drain		
	Telephone Line		
	Black Iron Pipe		
	Galvanized Iron Pipe		
	Edge of Pavement		
	Edge of Gravel		
	Edge of Curb		
	Fog Line and/or White Line		

WILLIAMS
EMERGENCY NOTIFICATION NUMBER
1-800-582-9069

CAUTION

WILLIAMS LOCATE & FOR
COUNTY, STATE
1-888-945-2255

FOREIGN UTILITY LOCATIONS ARE
APPROXIMATE. CONTACT THE LOCAL ONE
CALL AGENCY 48 HOURS PRIOR
TO CONSTRUCTION FOR EXACT
UTILITY LOCATIONS AT :
1-800-227-2600

DRAWING DISCLAIMER

FACILITY LOCATIONS ARE GENERAL IN NATURE
WILLIAMS WILL NOT BE HELD ACCOUNTABLE FOR
THE ACCURACY OF THE INFORMATION PROVIDED
ON THESE DRAWINGS.

PRELIMINARY

[illegible]

98	- LEAF FIBER, LOOSE BUFFER TUBE CABLE, 12 FIBERS PER TUBE, DIELECTRIC CENTRAL MEMBER, DUAL JACKET SINGLE ARMOR, 1000 LB TENSILE STRENGTH
	REEL # N/A
	N/A
	1200' 1-1.5" ID HDPE, 1-1.5" ID HDPE (SPARE), 1-1.25" ID HDPE (SPARE)

CABLE FIBER COUNT MFL TYPE OF GLASS	CABLE DESCRIPTION
CABLE SERIAL NO.	
SPLICE TO SPLICE CABLE LENGTH & COIL LENGTH	
INSHEDUCT & TYPE (CORR./SMOOTH/CABLE)	
SERIAL PIPE SIZE	PIPE & INSHEDUCT PLACEMENT
PVC	
FUTURE-3	
FUTURE-3	
FUTURE-4	FUTURE PIPE PLACE

INTEGRATED **COMMUNICATIONS GROUP**
Network Services

**POINT ARENA TO SACRAMENTO
CABLE ROUTE**

DRAWN BY : NMC	DATE : 08/25/00
CHECKED BY : MHW	DATE : 08/29/00
APPROVED BY :	DATE :
APPROVED BY :	DATE :
AFE : 4577	LSC CODE :
HORIZONTAL SCALE (HWP & PROF) : 1"=100'	
VERTICAL SCALE (HWP) :	
VERTICAL SCALE (PROF) :	
MAP PROJECTION :	

(DRAWING NUMBER) SHEET - 1

000000-00

CALIFORNIA NORTHERN RAILROAD

FIBER STATIONING


1367+10 25' RT. FIBER OPTIC
 1367+28 2' LT. HEADWALL
 1367+28 24' RT. HEADWALL
 1367+37 1' LT. HEADWALL
 1367+37 20' RT. HEADWALL
 1367+45 21' RT. FIBER OPTIC
 1367+84 24' RT. FIBER OPTIC
 1368+38 23' RT. FIBER OPTIC
 1368+48 7' LT. GAS MARKER
 1368+85 23' RT. FIBER OPTIC
 1368+42 24' RT. FIBER OPTIC
 1370+08 24' RT. FIBER OPTIC
 1370+83 24' RT. FIBER OPTIC
 1370+84 24' RT. FIBER OPTIC
 1371+63 24' RT. FIBER OPTIC
 1372+11 37' RT. FIBER MARKER
 1372+32 2' RT. WATER LINE
 1372+32 30' RT. WATER LINE
 1372+40 23' RT. FIBER OPTIC
 1373+07 23' RT. FIBER OPTIC
 1374+11 23' RT. FIBER OPTIC
 1375+15 23' RT. FIBER OPTIC
 1375+79 24' RT. FIBER OPTIC
 1376+58 9' LT. FENCE COR.
 1376+67 58' RT. FENCE COR.
 1376+86 34' RT. FIBER MARKER
 1376+86 25' RT. FIBER OPTIC
 1376+44 33' RT. FIBER MARKER
 1376+56 24' RT. FIBER OPTIC

ROAD STATIONING

NAPA COUNTY
 CALIFORNIA

SACRAMENTO

POINT ARENA

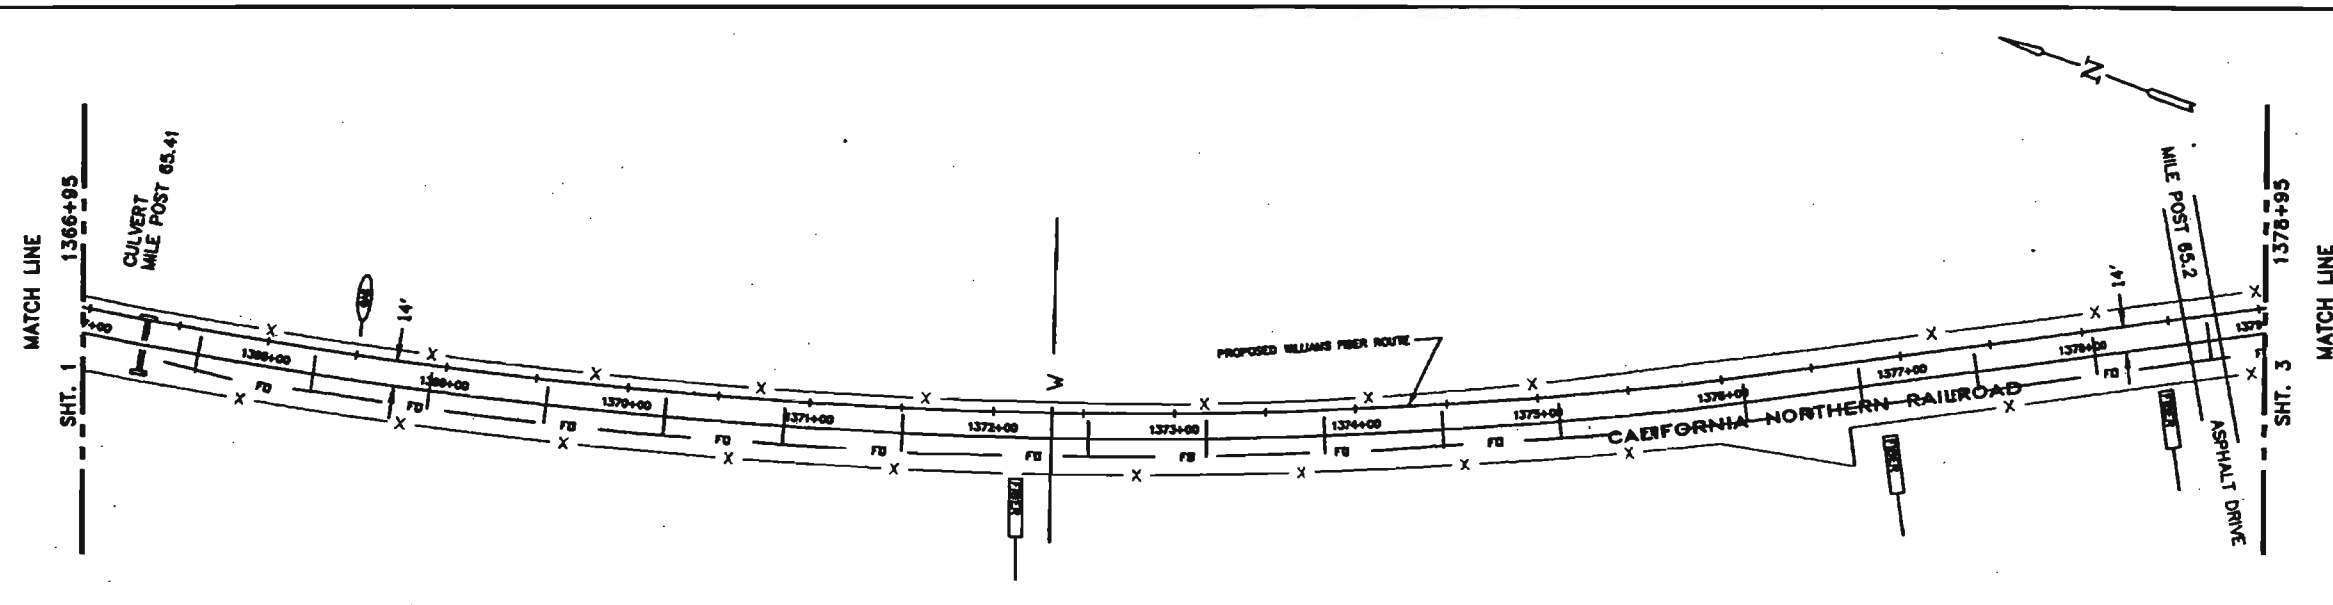

LEGEND

Interstate Hwy.	Region Site
U.S. Hwy.	P.O.P./Jct.
State Hwy.	Handhole Spline
County Road	Handhole
RT Mile Mar.	Handhole Spline
Mile Road Sign	Handhole
New Fiber Cable	SS Handhole
Township Line	Power Pole
City Limits	Meter Valve / Meter
R/W Line	Gas Valve / Meter
River/Stream	Signal Pole
CL Road	Fire Hydrant
CL RT Trunk	Gas Marker
Fence	Oil Marker
Oil Pipeline	Fiber Marker
Gas Pipeline	Water Inlet
Power Line	
Water Line	
San. Sewer	
Storm Drain	
Telephone Line	
Black Iron Pipe	
Galvanized Iron Pipe	
Edge of Pavement	
Edge of Gravel	
Face of Curb	
Fog Line and/or White Line	

WILLIAMS

EMERGENCY NOTIFICATION NUMBER

1-800-582-9088

CAUTION

WILLIAMS LOCATE # FOR
 COUNTY, STATE
 1-888-845-2255

FOREIGN UTILITY LOCATIONS ARE
 APPROXIMATE. CONTACT THE LOCAL
 CALL AGENCY 48 HOURS PRIOR
 TO CONSTRUCTION FOR EXACT
 UTILITY LOCATIONS AT :

1-800-227-2600

DRAWING DISCLAIMER

FACILITY LOCATIONS ARE GENERAL IN NATURE.
 WILLIAMS WILL NOT BE HELD ACCOUNTABLE FOR
 THE ACCURACY OF THE INFORMATION PROVIDED
 ON THESE DRAWINGS.

PRELIMINARY

REVISIONS

REV. NO.	DESCRIPTION	BY	DATE

96 - LEAF FIBER, LOOSE BUFFER TUBE CABLE, 12 FIBERS PER TUBE, DIELECTRIC CENTRAL MEMBER, DUAL JACKET SINGLE ARMOR, 1000 LB TENSILE STRENGTH

REEL # N/A

N/A

1200' 1-1.5" ID HOPE, 1-1.5" ID HOPE (SPARE), 1-1.25" ID HOPE (SPARE)


CABLE FIBER COUNT MPF. TYPE OF GLASS	CABLE DESCRIPTION
CABLE REEL NO.	
SPLICE TO SPLICE CABLE LENGTH & CIL LENGTH	
SHIELD & TYPE (CON/THROU/COLOR)	PIPE & INVERTING PLACEMENT
SHIELD PIPE SIZE	
PVC	
FOUR-2	FOUR-2
FOUR-3	FOUR-3
FOUR-4	FOUR-4

COMMUNICATIONS GROUP
 National Services

**POINT ARENA TO SACRAMENTO
 CABLE ROUTE**

DESIGN BY : NHC	DATE : 08/25/00
CHECKED BY : LNW	DATE : 08/29/00
APPROVED BY :	DATE :
APPROVED BY :	DATE :
APR : 4877	LOC. CODE :
HORIZONTAL SCALE (DWG & PROF) : 1"=100'	
VERTICAL SCALE (DWG) :	
VERTICAL SCALE (PROF) :	
MAP PROJECTION :	

DRAWING NUMBER : SHEET -- 2

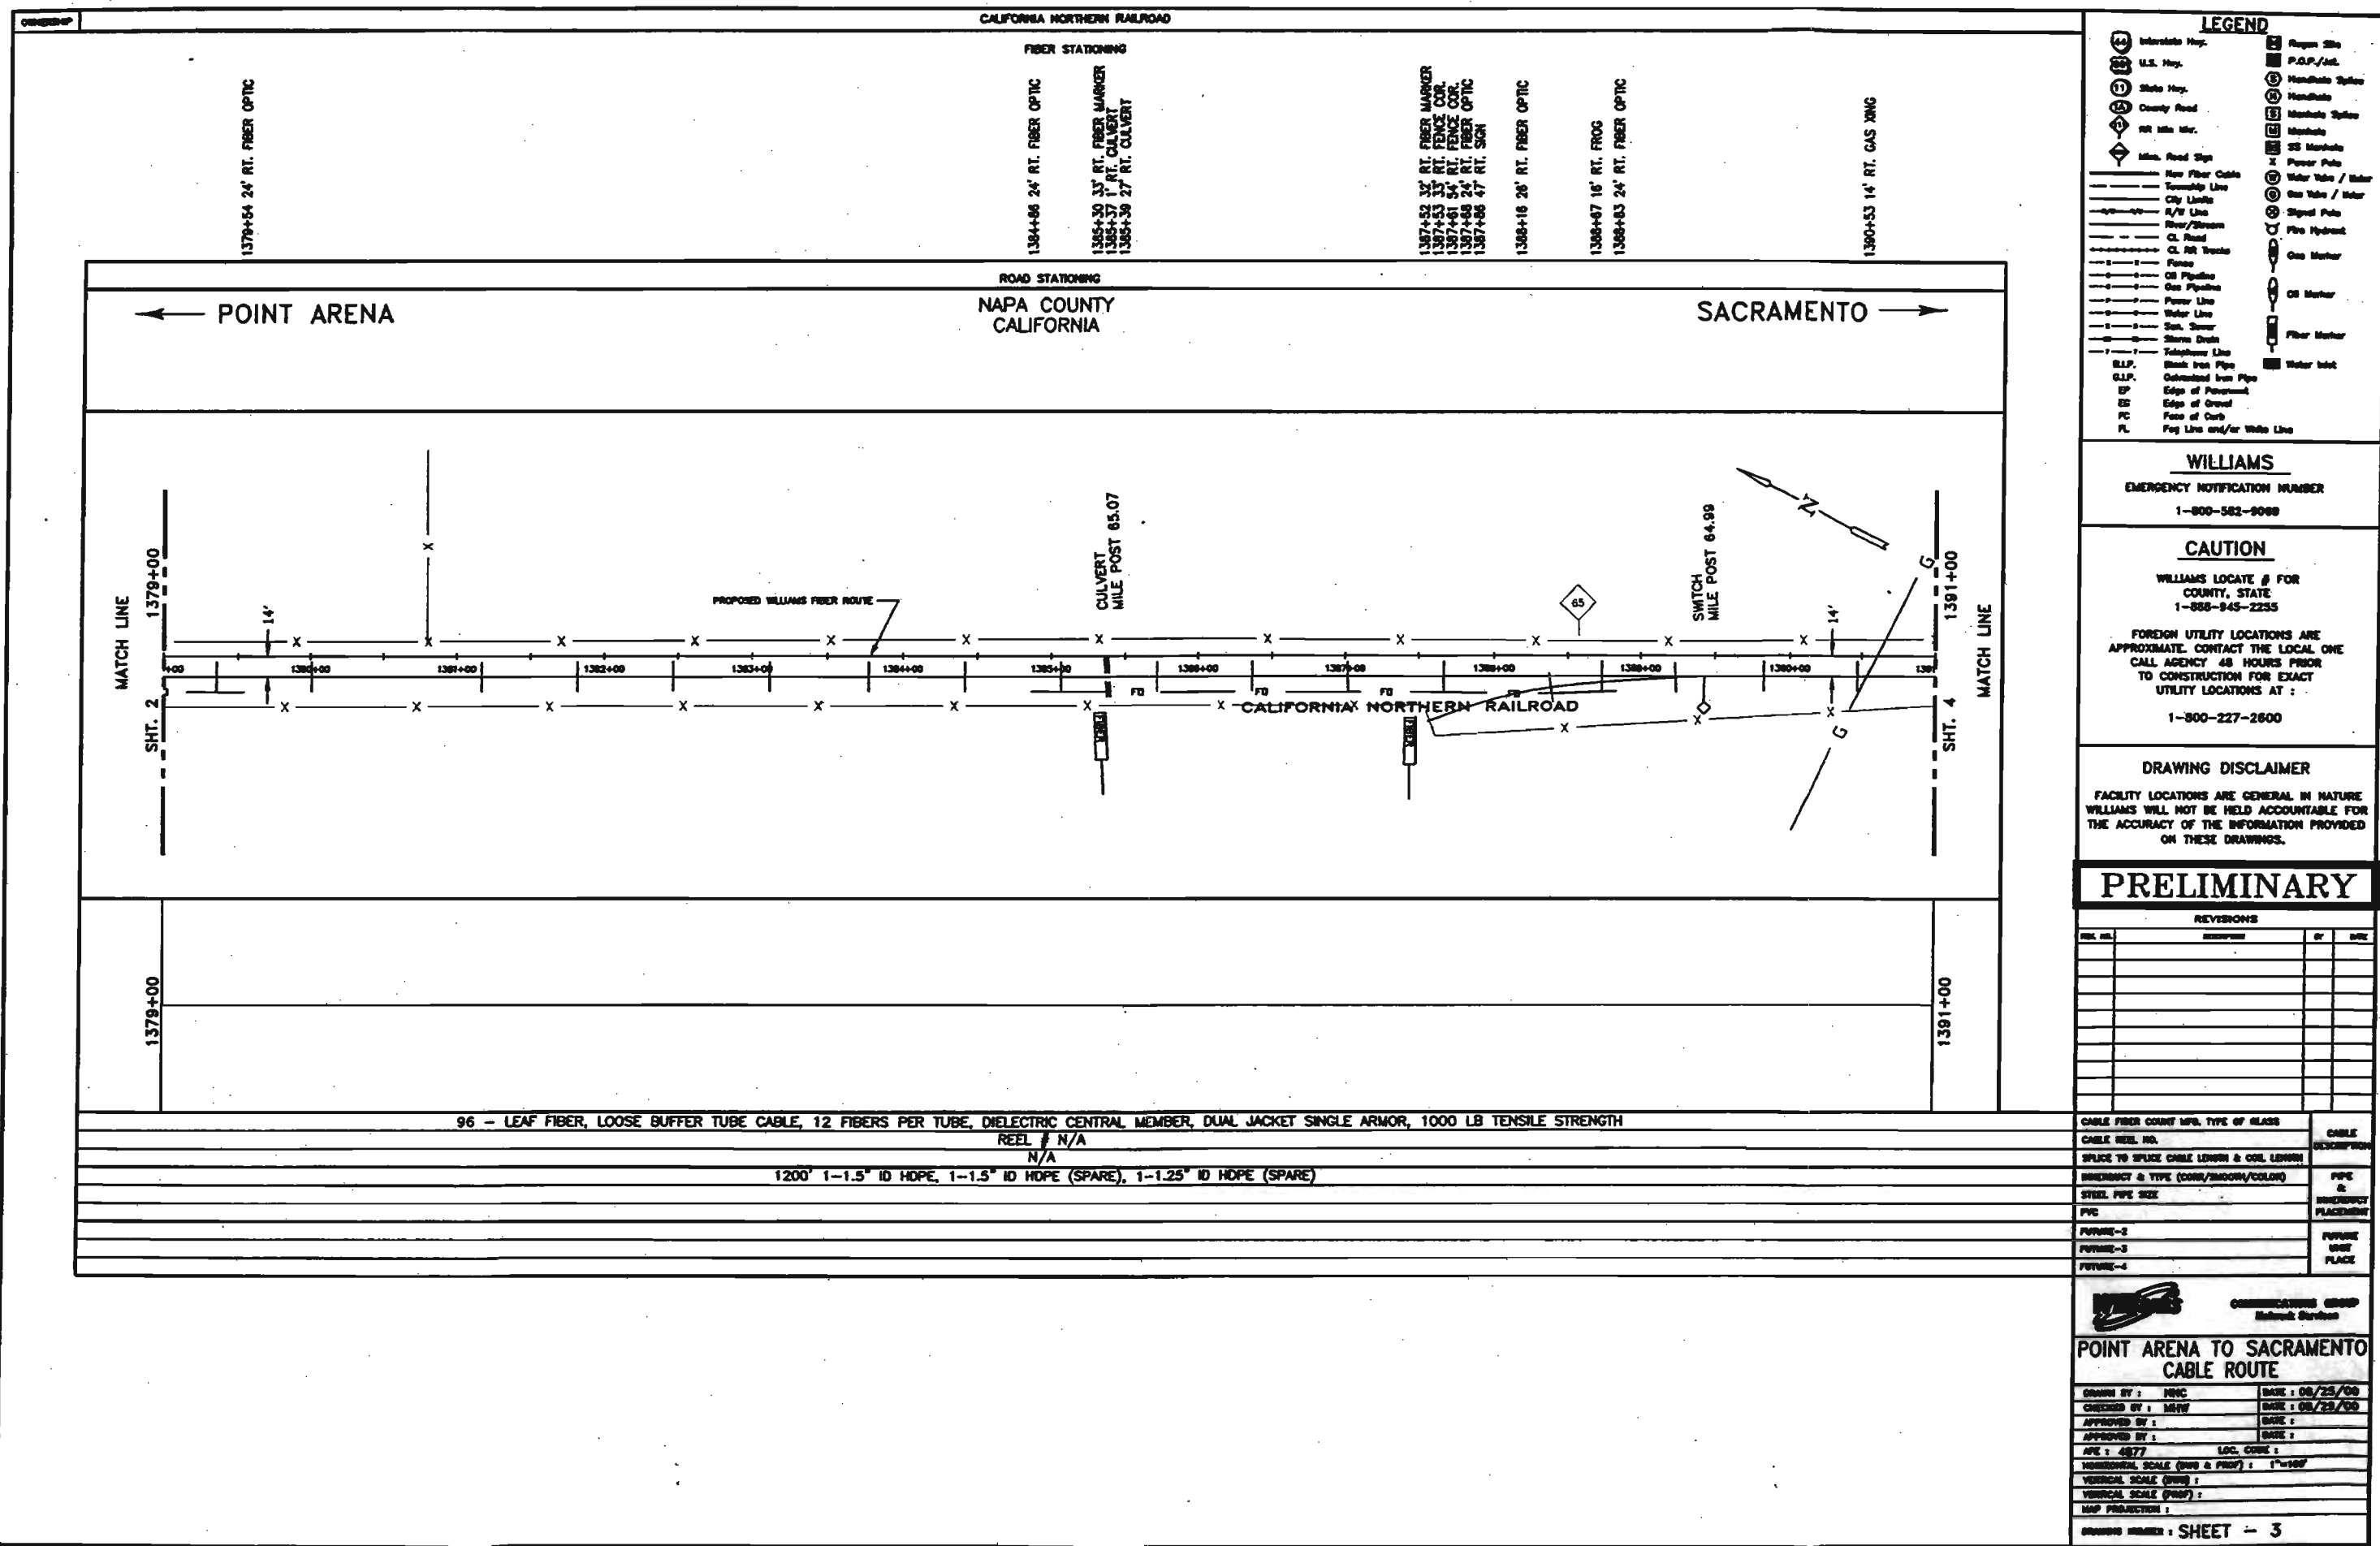

LEGEND	
	Interstate Hwy.
	U.S. Hwy.
	State Hwy.
	County Road
	RR Mile Marker
	Mile Road Sign
	New Fiber Cable
	Township Line
	City Limits
	R/W Line
	River/Stream
	CL Road
	CL RR Tracks
	Fence
	Gas Pipeline
	Gas Pipeline
	Power Line
	Water Line
	Sewer Line
	Storm Drain
	Telephone Line
	Steel Iron Pipe
	Galvanized Iron Pipe
	Edge of Pavement
	Edge of Gravel
	Face of Curb
	Fog Line and/or White Line
	Right of Way
	P.O.P./Jct.
	Handhole
	Handhole
	Handhole
	SS Handhole
	Power Pole
	Water Valve / Meter
	Gas Valve / Meter
	Signal Pole
	Fire Hydrant
	Gas Marker
	Gas Marker
	Gas Marker
	Fiber Marker
	Water Inlet

WILLIAMS
EMERGENCY NOTIFICATION NUMBER
1-800-582-9088

CAUTION
WILLIAMS LOCATE & FOR
COUNTY, STATE
1-888-945-2235

FOREIGN UTILITY LOCATIONS ARE
APPROXIMATE. CONTACT THE LOCAL ONE
CALL AGENCY 48 HOURS PRIOR
TO CONSTRUCTION FOR EXACT
UTILITY LOCATIONS AT :
1-800-227-2600

DRAWING DISCLAIMER
FACILITY LOCATIONS ARE GENERAL IN NATURE
WILLIAMS WILL NOT BE HELD ACCOUNTABLE FOR
THE ACCURACY OF THE INFORMATION PROVIDED
ON THESE DRAWINGS.

PRELIMINARY

REVISIONS			
REV. NO.	DESCRIPTION	BY	DATE

CABLE FIBER COUNT MFG. TYPE OF GLASS	CABLE DESCRIPTION
CABLE REEL NO.	
SPICE TO SPICE CABLE LENGTH & COIL LENGTH	PIPE & BURIED/DEPTH PLACEMENT
BURIED/DEPTH & TYPE (CONC./SMOOTH/COLOR)	
STEEL PIPE SIZE	FUTURE USE PLACE
PVC	
FUTURE-2	
FUTURE-3	
FUTURE-4	

COMMUNICATIONS GROUP
Network Services

**POINT ARENA TO SACRAMENTO
CABLE ROUTE**

DRAWN BY : MNC	DATE : 08/25/00
CHECKED BY : MNV	DATE : 08/25/00
APPROVED BY :	DATE :
APPROVED BY :	DATE :

N/A : 4877 LOC. CODE :


HORIZONTAL SCALE (HWS & PROF) : 1"=100'

VERTICAL SCALE (HWS) :

VERTICAL SCALE (PROF) :

MAP PRODUCTION :

DRAWING NUMBER : **SHEET - 3**

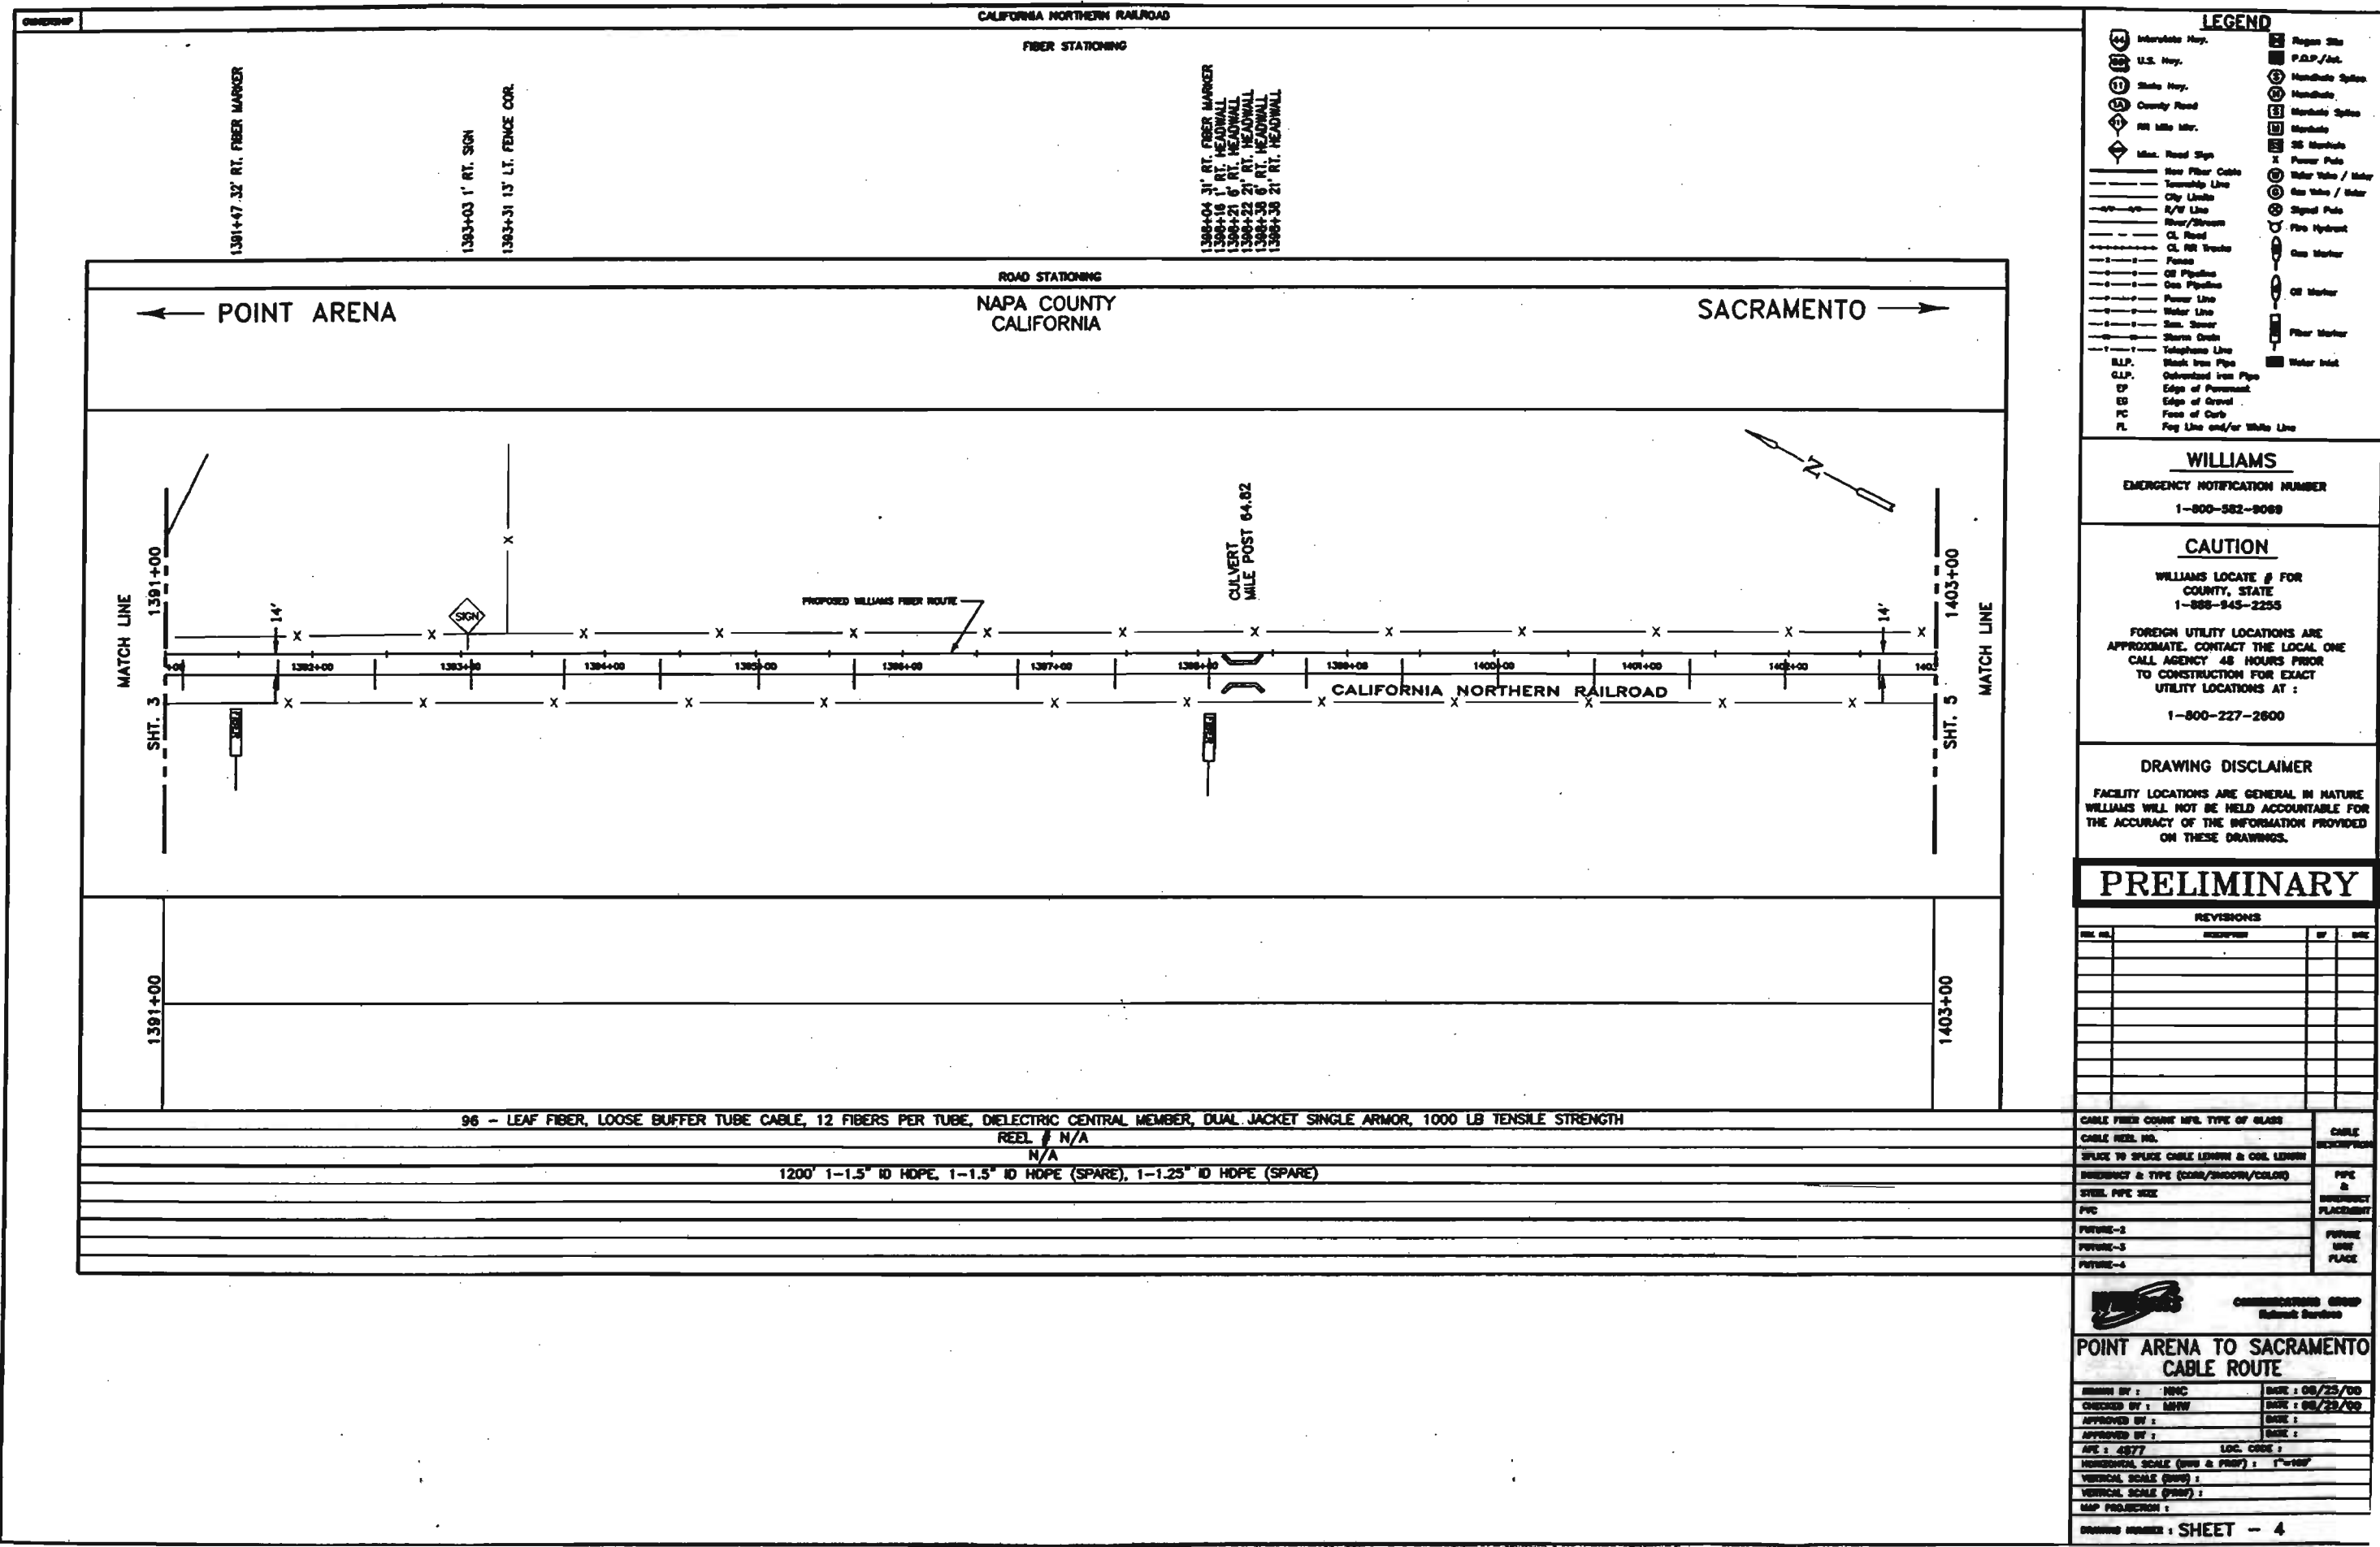

LEGEND	
Interstate Hwy.	Regen Site
U.S. Hwy.	P.O.P./Int.
State Hwy.	Handhole Splice
County Road	Handhole
RR Mile Mar.	Handhole Splice
Min. Road Sign	Handhole
New Fiber Cable	25 Handhole
Township Line	Power Pole
City Limits	Water Valve / Meter
R/W Line	Gas Valve / Meter
River/Stream	Signal Pole
CL Road	Fire Hydrant
CL RR Tracks	Gas Marker
Fence	Oil Marker
OS Pipeline	Fiber Marker
Gas Pipeline	Water Inlet
Power Line	
Water Line	
Sew. Sewer	
Storm Drain	
Telephone Line	
Blank Iron Pipe	
Submerged Iron Pipe	
Edge of Pavement	
Edge of Gravel	
Face of Curb	
Fog Line and/or White Line	

WILLIAMS
EMERGENCY NOTIFICATION NUMBER
1-800-582-9088

CAUTION
WILLIAMS LOCATE # FOR
COUNTY, STATE
1-888-945-2255

FOREIGN UTILITY LOCATIONS ARE
APPROXIMATE. CONTACT THE LOCAL ONE
CALL AGENCY 48 HOURS PRIOR
TO CONSTRUCTION FOR EXACT
UTILITY LOCATIONS AT :
1-800-227-2600

DRAWING DISCLAIMER
FACILITY LOCATIONS ARE GENERAL IN NATURE
WILLIAMS WILL NOT BE HELD ACCOUNTABLE FOR
THE ACCURACY OF THE INFORMATION PROVIDED
ON THESE DRAWINGS.


PRELIMINARY			
REVISIONS			
REV. NO.	DESCRIPTION	BY	DATE

CABLE FIBER COUNT MFL TYPE OF GLASS	CABLE DESCRIPTION
CABLE REEL NO.	
SPICE TO SPICE CABLE LENGTH & COIL LENGTH	PIPE & BURIED PLACEMENT
INTERFERENCE & TYPE (CONC/SHOWN/COLOR)	
STEEL PIPE SIZE	FUTURE USE PLACE
PVC	
FUTURE-2	
FUTURE-3	
FUTURE-4	

**POINT ARENA TO SACRAMENTO
CABLE ROUTE**

DRAWN BY : NMC	DATE : 08/25/00
CHECKED BY : MWN	DATE : 08/25/00
APPROVED BY :	DATE :
APPROVED BY :	DATE :
APR : 4577	LOC. CODE :
HORIZONTAL SCALE (HWS & PWS) : 1"=100'	
VERTICAL SCALE (VWS) :	
VERTICAL SCALE (VWS) :	
MAP PROJECTION :	

DRAWING NUMBER : SHEET - 4

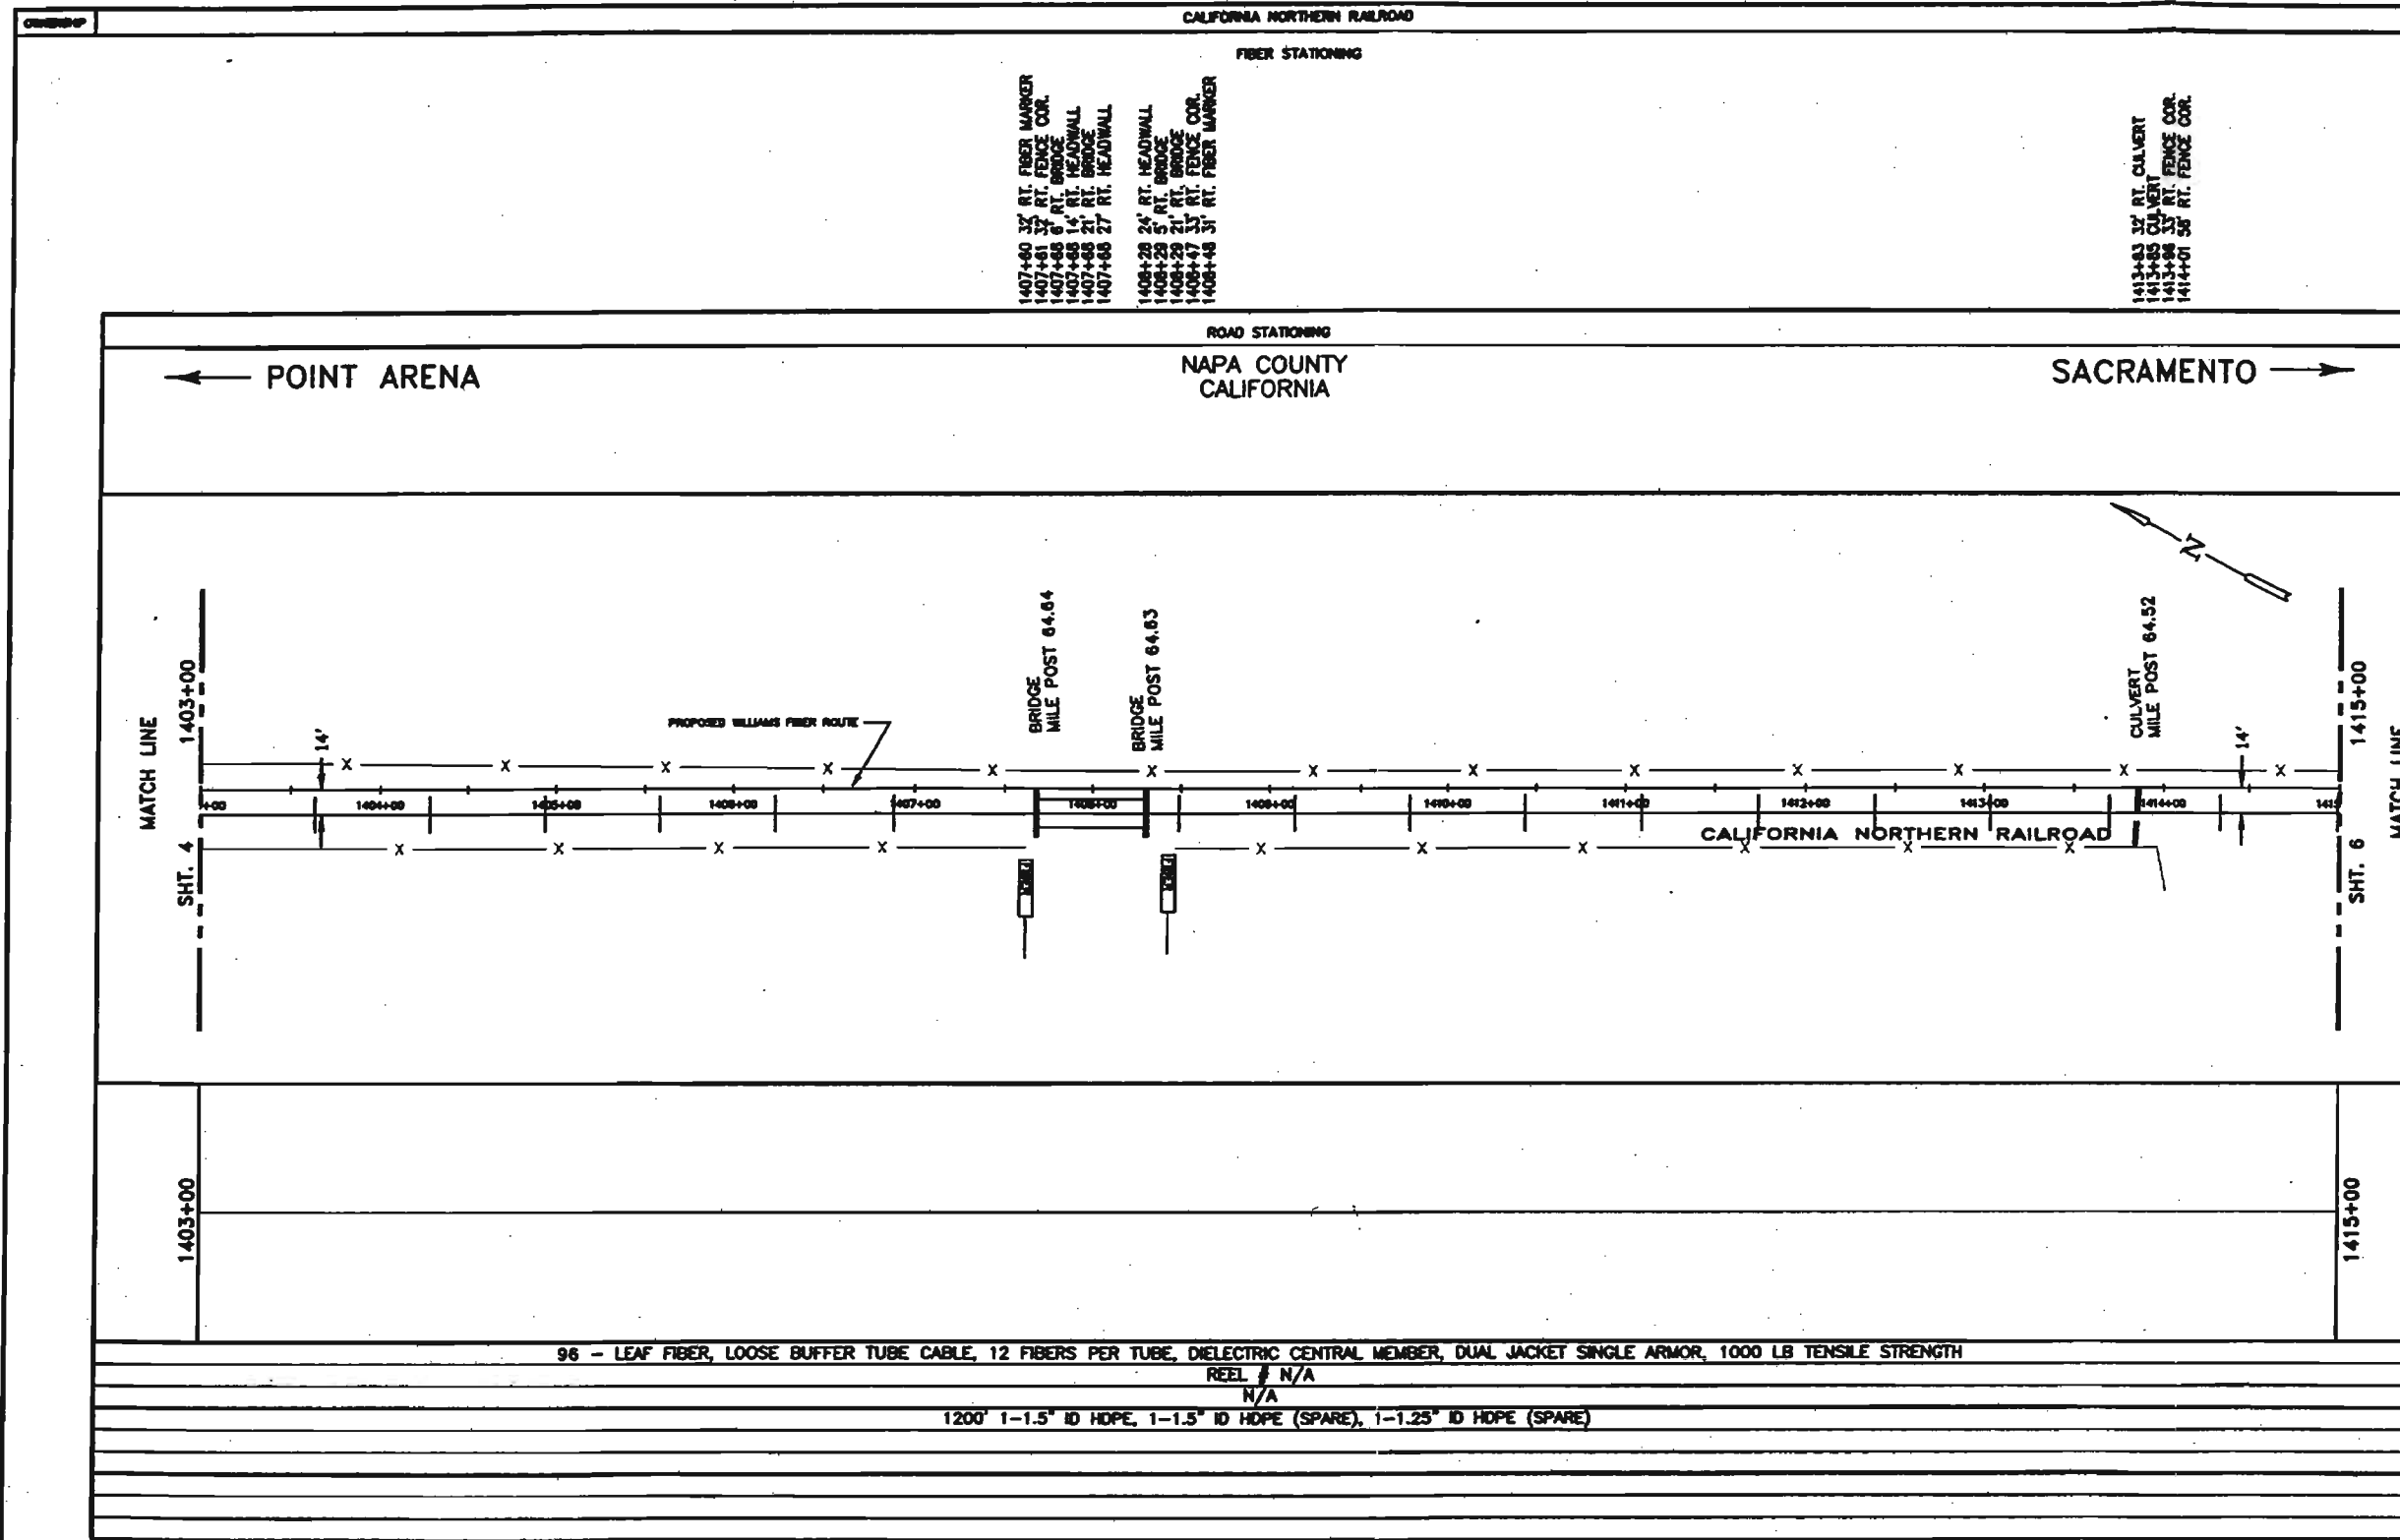

LEGEND

1/4" = 1' Scale	Interstate Hwy.	Region Site
1/8" = 1' Scale	U.S. Hwy.	P.O.P./Jct.
1/16" = 1' Scale	State Hwy.	Headhole Splice
1/32" = 1' Scale	County Road	Headhole
WILLIAMS
 EMERGENCY NOTIFICATION NUMBER
 1-800-582-9089

CAUTION
 WILLIAMS LOCATE & FOR
 COUNTY, STATE
 1-888-845-2255

FOREIGN UTILITY LOCATIONS ARE
 APPROXIMATE. CONTACT THE LOCAL ONE
 CALL AGENCY 48 HOURS PRIOR
 TO CONSTRUCTION FOR EXACT
 UTILITY LOCATIONS AT :
 1-800-227-2600

DRAWING DISCLAIMER
 FACILITY LOCATIONS ARE GENERAL IN NATURE
 WILLIAMS WILL NOT BE HELD ACCOUNTABLE FOR
 THE ACCURACY OF THE INFORMATION PROVIDED
 ON THESE DRAWINGS.


PRELIMINARY

REVISIONS			
REV. NO.	DESCRIPTION	BY	DATE

CABLE FIBER COUNT MFL TYPE OF GLASS	CABLE DESCRIPTION
CABLE REEL NO.	
SPACE TO SPACE CABLE LENGTH & CIL LENGTH	PIPE & BRACKET PLACEMENT
BRACKET & TYPE (CON/SMOOTH/COLOR)	
STEEL PIPE SIZE	
PVC	
FUTURE-1	FUTURE USE PLACE
FUTURE-2	
FUTURE-3	
FUTURE-4	

POINT ARENA TO SACRAMENTO CABLE ROUTE

DESIGNED BY : HMC DATE : 08/25/00
 CHECKED BY : MTH DATE : 08/25/00
 APPROVED BY : DATE :
 DATE :
 APE : 4577 LOC. CODE :
 HORIZONTAL SCALE (DWG & PROF) : 1"=100'
 VERTICAL SCALE (DWG) :
 VERTICAL SCALE (PROF) :
 MAP PROJECTION :
 DRAWING NUMBER : SHEET - 5

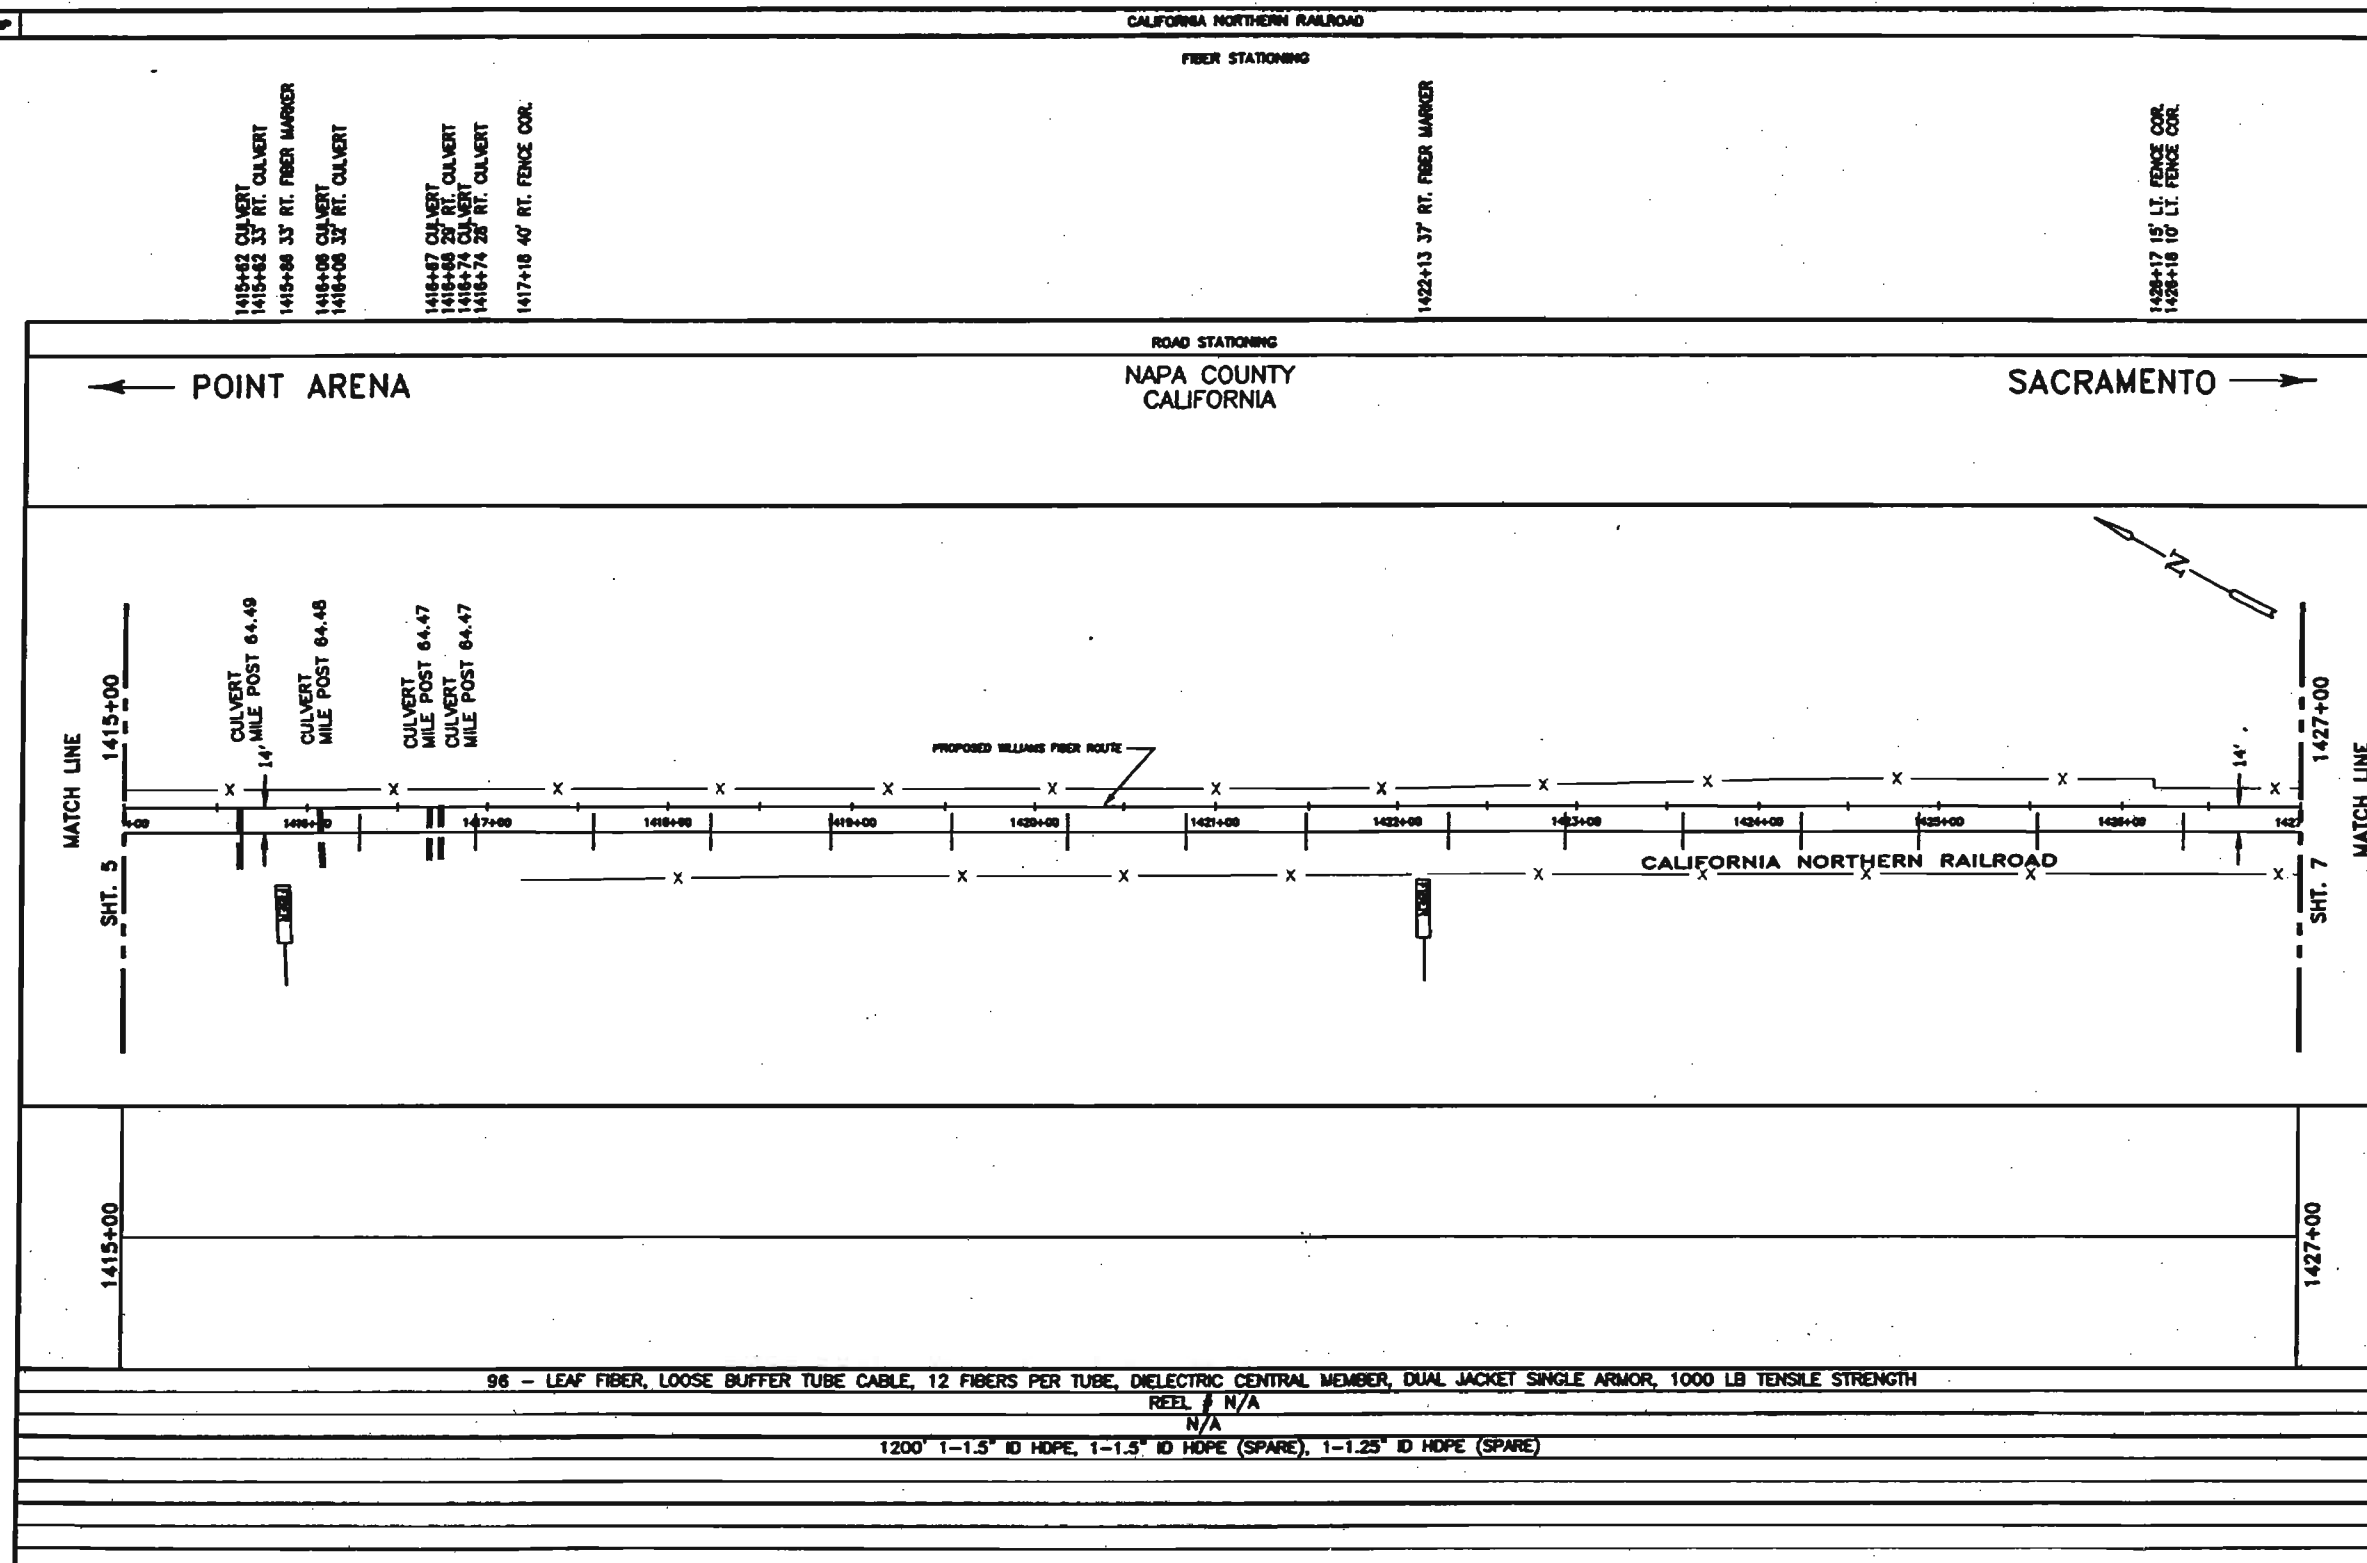

LEGEND

	Interstate Hwy.		Region Site
	U.S. Hwy.		P&P/Int.
	State Hwy.		Headache Splice
	County Road		Headache
	RR Mile Marker		Headache Splice
	Mile Road Sign		Headache
	New Fiber Cable		SE Headache
	Township Line		Power Pole
	City Limits		Water Valve / Meter
	R/W Line		Gas Valve / Meter
	River/Stream		Signal Pole
	CL Road		Fire Hydrant
	CL RR Track		Gas Marker
	Fence		Oil Marker
	Oil Piping		Fiber Marker
	Gas Piping		Water Inlet
	Power Line		
	Water Line		
	San. Sewer		
	Storm Drain		
	Telephone Line		
	Black Iron Pipe		
	Columbian Iron Pipe		
	Edge of Pavement		
	Edge of Gravel		
	Edge of Curb		
	Fog Line and/or White Line		

WILLIAMS
EMERGENCY NOTIFICATION NUMBER
1-800-582-8069

CAUTION

**WILLIAMS LOCATE # FOR
COUNTY, STATE
1-888-845-2255**

**FOREIGN UTILITY LOCATIONS ARE
APPROXIMATE. CONTACT THE LOCAL ONE
CALL AGENCY 48 HOURS PRIOR
TO CONSTRUCTION FOR EXACT
UTILITY LOCATIONS AT :**

1-800-227-2800

DRAWING DISCLAIMER

FACILITY LOCATIONS ARE GENERAL IN NATURE
WILLIAMS WILL NOT BE HELD ACCOUNTABLE FOR
THE ACCURACY OF THE INFORMATION PROVIDED
ON THESE DRAWINGS.

PRELIMINARY


[illegible]

CABLE FIBER COUNT MFG. TYPE OF GLASS	CABLE DESCRIPTION
CABLE REEL NO.	
SPACE TO SPACE CABLE LENGTH & CBL. LENGTH	PIPE & UNDERGROUND PLACEMENT
UNDERCUT & TYPE (CONG./SMOOTH/COLOR)	
STEEL PIPE SIZE	FUTURE WELL PLACE
PVC	
FUTURE-2	
FUTURE-3	
FUTURE-4	


COMMENCEMENT GROUP
 Entry Services

POINT ARENA TO SACRAMENTO
CABLE ROUTE

DESIGNED BY :	MHC	DATE :	06/25/00
CHECKED BY :	MTW	DATE :	06/25/00
APPROVED BY :		DATE :	
APPROVED BY :		DATE :	
AGE :	4577	LOC. CODE :	
HORIZONTAL SCALE (DWG & PROF) : 1"=100'			
VERTICAL SCALE (DWG) :			
VERTICAL SCALE (PROF) :			
MAP PROJECTION :			
DRAWING NUMBER : SHEET - 6			

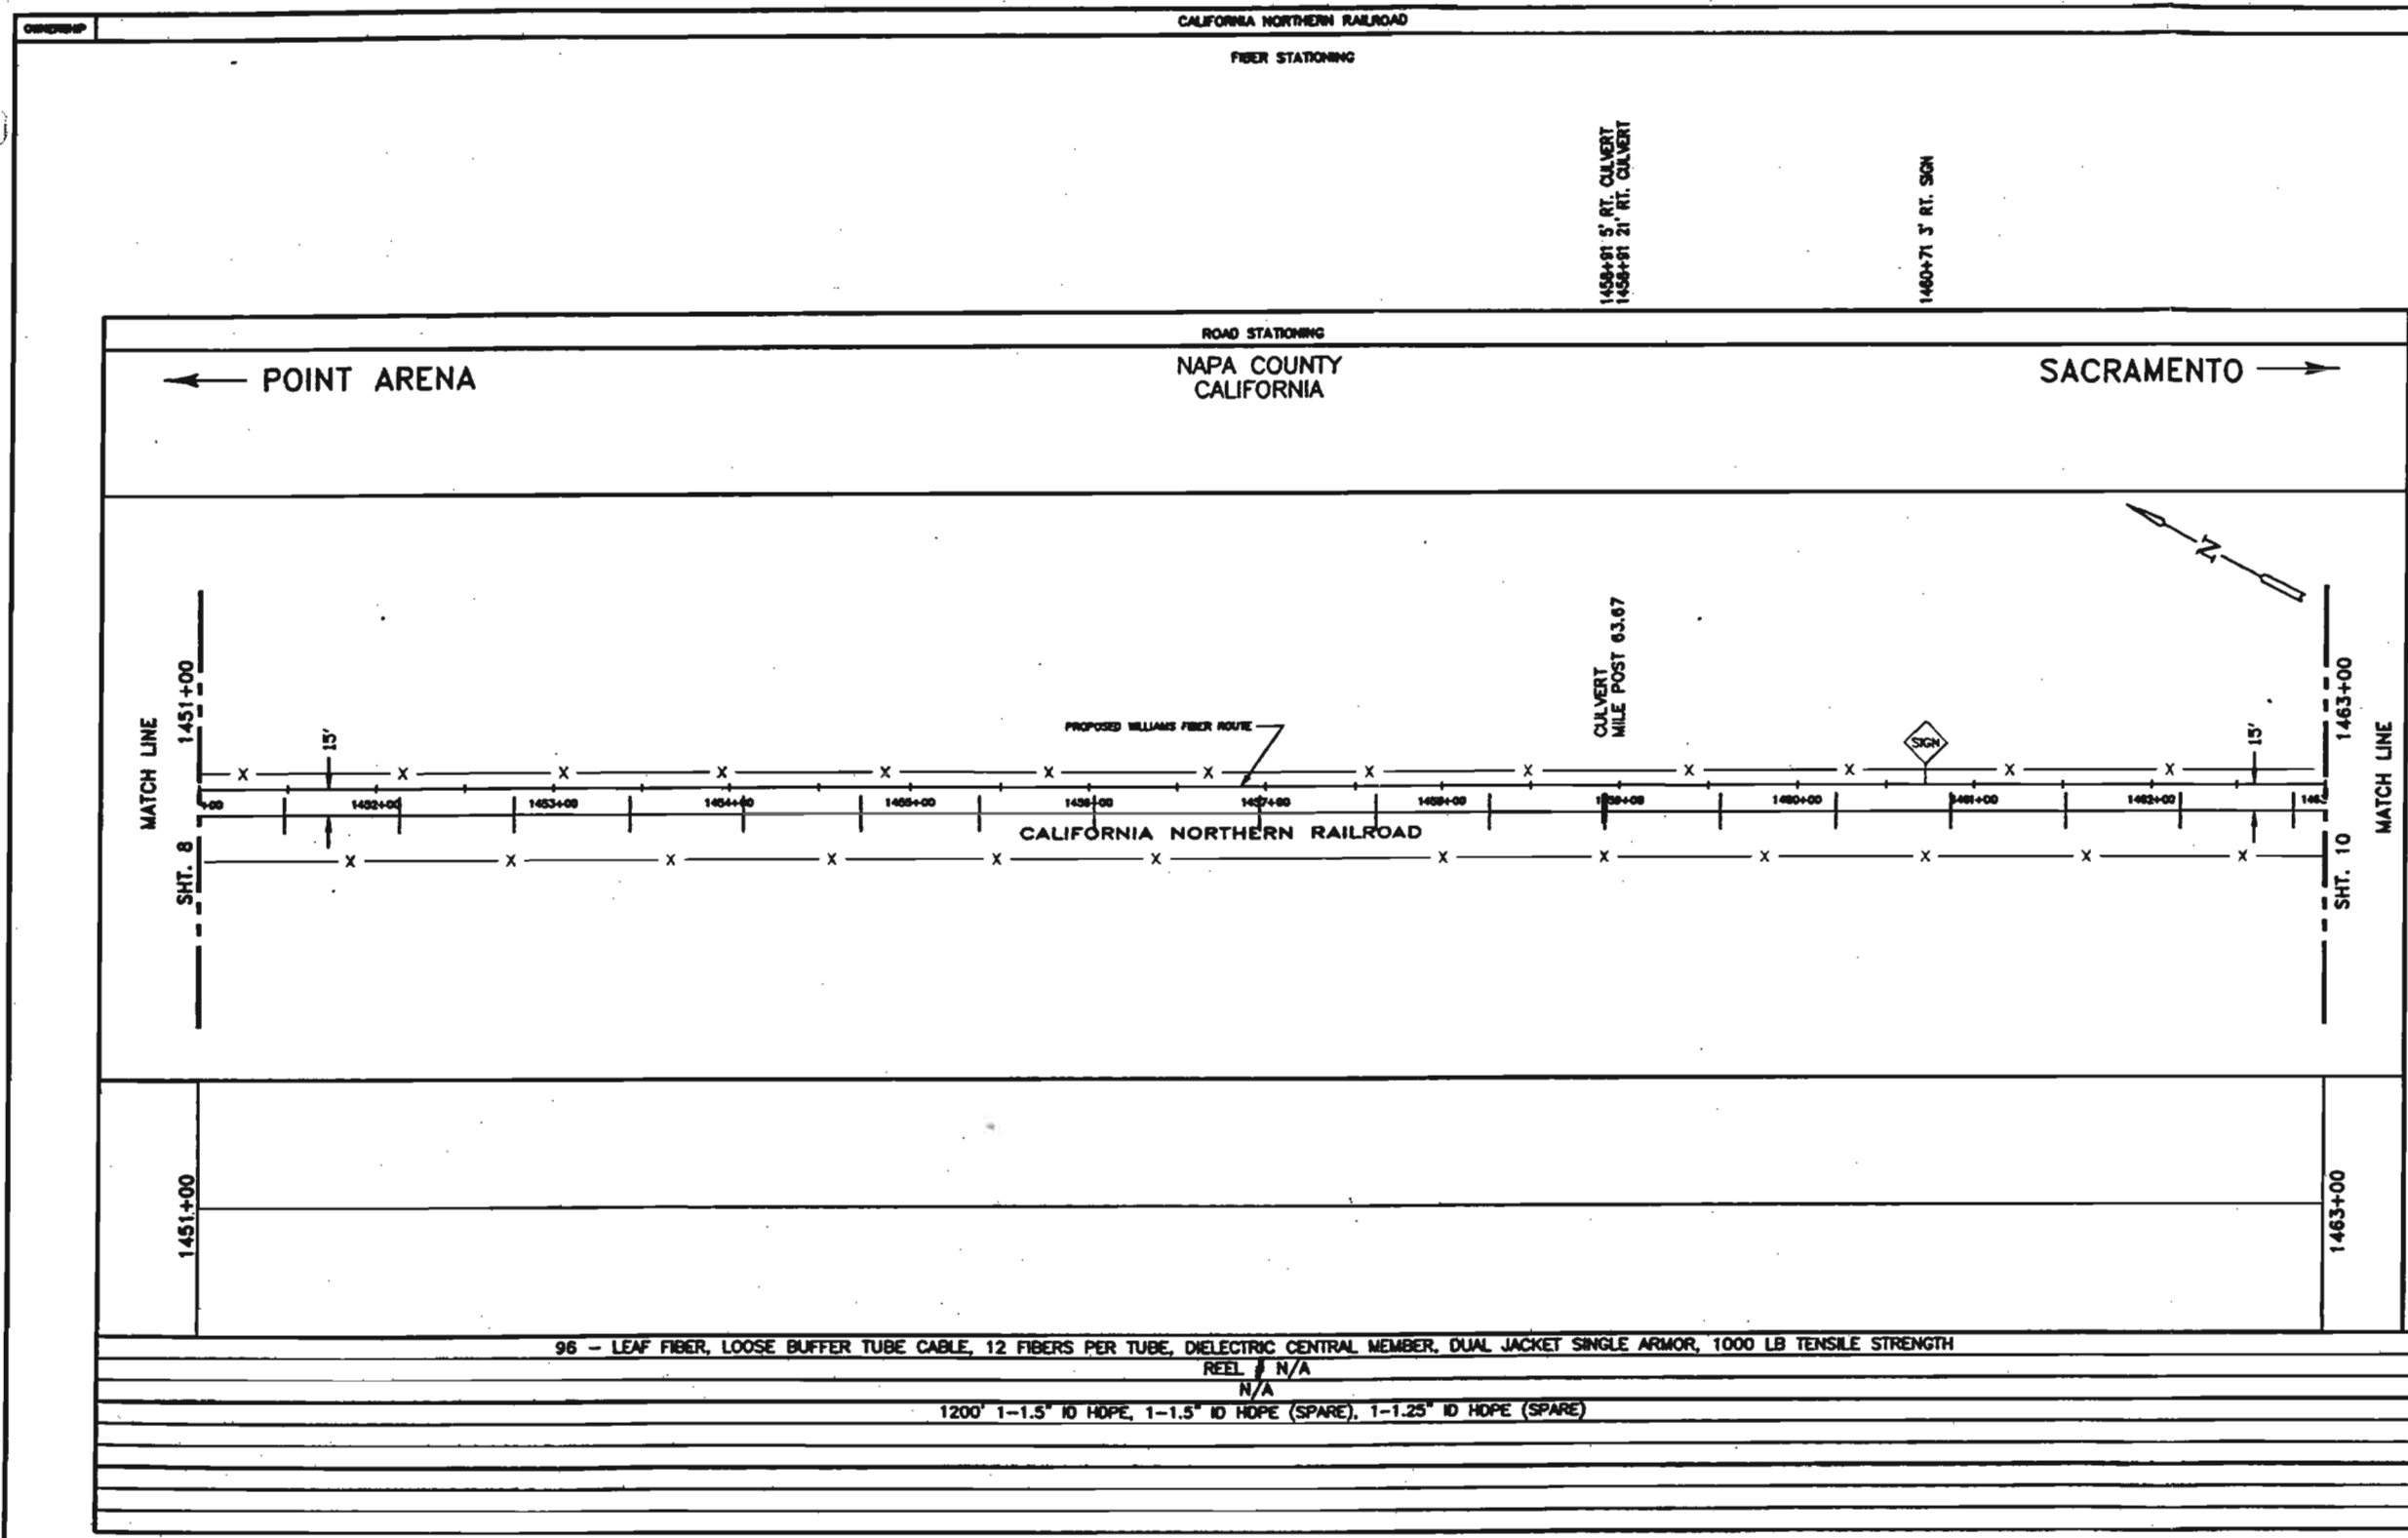

LEGEND

Interstate Hwy.	Regen Site
U.S. Hwy.	P.O.P./Int.
State Hwy.	Handhole Splice
County Road	Handhole Splice
RR Mile Mkr.	Handhole
Min. Road Sign	25 Handhole
New Fiber Cable	Power Pole
Existing Line	Water Valve / Meter
City Limits	Gas Valve / Meter
R/W Line	Signal Pole
River/Stream	Fire Hydrant
CL Road	Gas Marker
CL RR Tracks	Oil Marker
Fence	Oil Marker
Oil Pipeline	Fiber Marker
Gas Pipeline	Water Inlet
Power Line	
Water Line	
San. Sewer	
Storm Drain	
Telephone Line	
R.I.P.	Black Iron Pipe
G.I.P.	Galvanized Iron Pipe
EP	Edge of Pavement
ED	Edge of Ground
FC	Face of Curb
FL	Fog Line and/or White Line

WILLIAMS
EMERGENCY NOTIFICATION NUMBER
1-800-582-9099

CAUTION
WILLIAMS LOCATE & FOR
COUNTY, STATE
1-888-945-2255

FOREIGN UTILITY LOCATIONS ARE
APPROXIMATE. CONTACT THE LOCAL ONE
CALL AGENCY 48 HOURS PRIOR
TO CONSTRUCTION FOR EXACT
UTILITY LOCATIONS AT:
1-800-227-2600

DRAWING DISCLAIMER
FACILITY LOCATIONS ARE GENERAL IN NATURE.
WILLIAMS WILL NOT BE HELD ACCOUNTABLE FOR
THE ACCURACY OF THE INFORMATION PROVIDED
ON THESE DRAWINGS.

PRELIMINARY

REVISIONS			
REV. NO.	DESCRIPTION	BY	DATE

96 - LEAF FIBER, LOOSE BUFFER TUBE CABLE, 12 FIBERS PER TUBE, DIELECTRIC CENTRAL MEMBER, DUAL JACKET SINGLE ARMOR, 1000 LB TENSILE STRENGTH	CABLE FIBER COUNT MFG. TYPE OF GLASS	CABLE
REEL # N/A	CABLE REEL NO.	DESCRIPTION
N/A	SPICE TO SPICE CABLE LENGTH & COIL LENGTH	
1200' 1-1.5" ID HOPE, 1-1.5" ID HOPE (SPARE), 1-1.25" ID HOPE (SPARE)	INSULATION & TYPE (CONC./SHOULDER/COLOR)	PIPE & BONDING
	STEEL PIPE SIZE	PLACEMENT
	PVC	
	FUTURE-3	FUTURE
	FUTURE-3	USE
	FUTURE-4	PLACE

COMMUNICATIONS GROUP
Network Services

**POINT ARENA TO SACRAMENTO
CABLE ROUTE**

DESIGNED BY: HNC	DATE: 06/25/00
CHECKED BY: MFW	DATE: 06/29/00
APPROVED BY:	DATE:
DATE:	DATE:

APP: 4877 LGO CODE:

HORIZONTAL SCALE (DWG & PROF): 1"=100'

VERTICAL SCALE (DWG):

VERTICAL SCALE (PROF):

TOP PROJECTION:

DRAWING NUMBER: SHEET - 9

OVERVIEW

CALIFORNIA NORTHERN RAILROAD

FIBER STATIONING

1467+47 12' RT. FROG

1470+01 5' LT. FENCE COR.

1470+72 5' LT. FENCE COR.

1470+72 41' RT. FENCE COR.

1470+83 11' RT. BRIDGE

1470+84 19' RT. BRIDGE

1470+84 23' RT. HEADWALL

1471+38 6' RT. HEADWALL

1471+38 11' RT. BRIDGE

1471+38 19' RT. BRIDGE

1471+38 24' RT. HEADWALL

1471+43 41' RT. FENCE COR.


1471+51 5' LT. FENCE COR.

ROAD STATIONING

NAPA COUNTY
CALIFORNIA

POINT ARENA

SACRAMENTO

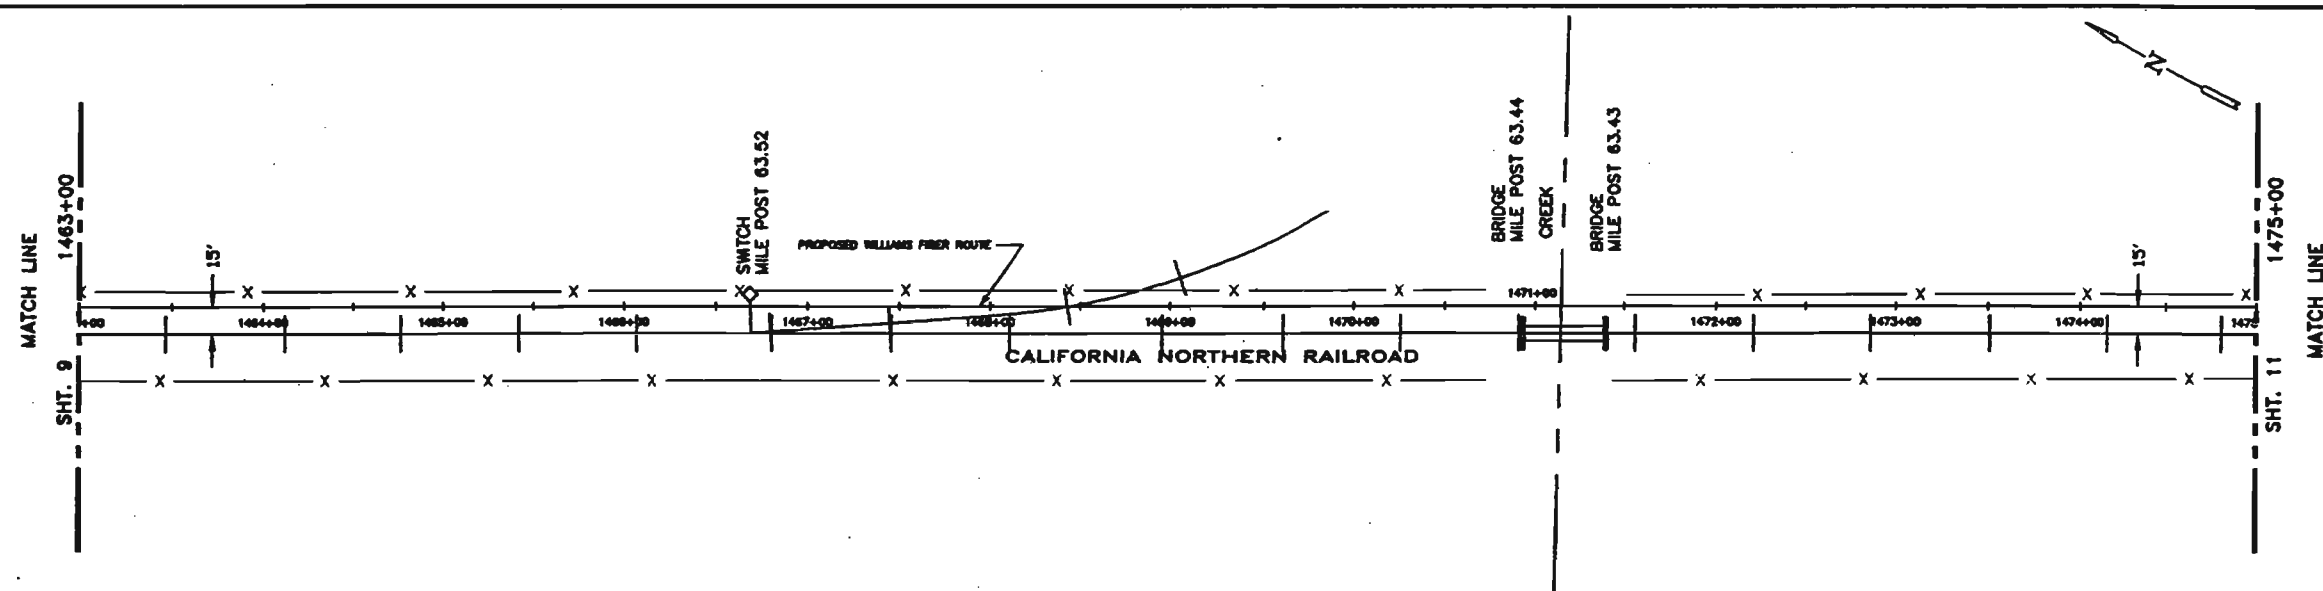

LEGEND

- | | |
|-----------------|---------------------|
| Interstate Hwy. | Regen Site |
| U.S. Hwy. | P.O.P./Int. |
| State Hwy. | Handhole |
| County Road | Handhole |
| RT Mile Mkr. | Handhole |
| Mile Road Sign | SE Manhole |
| New Fiber Cable | Power Pole |
| Traverse Line | Water Valve / Meter |
| City Limits | Gas Valve / Meter |
| R/W Line | Signal Pole |
| Road/Stream | Fire Hydrant |
| CL Road | Gas Marker |
| CL RT Trk | Oil Marker |
| Fence | Fiber Marker |
| Oil Pipeline | Water Inlet |
| Gas Pipeline | |
| Power Line | |
| Water Line | |
| Sew. Saver | |
| Storm Drain | |
| Telephone Line | |
| Black Iron Pipe | |
| BLP | |
| GLP | |
| EP | |
| ES | |
| PC | |
| PL | |

WILLIAMS

EMERGENCY NOTIFICATION NUMBER

1-800-582-9099

CAUTION

WILLIAMS LOCATE & FOR
COUNTY, STATE
1-888-945-2255

FOREIGN UTILITY LOCATIONS ARE
APPROXIMATE. CONTACT THE LOCAL ONE
CALL AGENCY 48 HOURS PRIOR
TO CONSTRUCTION FOR EXACT
UTILITY LOCATIONS AT :

1-800-227-2600

DRAWING DISCLAIMER

FACILITY LOCATIONS ARE GENERAL IN NATURE.
WILLIAMS WILL NOT BE HELD ACCOUNTABLE FOR
THE ACCURACY OF THE INFORMATION PROVIDED
ON THESE DRAWINGS.

PRELIMINARY

REVISIONS

REV. NO.	DESCRIPTION	BY	DATE

96 - LEAF FIBER, LOOSE BUFFER TUBE CABLE, 12 FIBERS PER TUBE, DIELECTRIC CENTRAL MEMBER, DUAL JACKET SINGLE ARMOR, 1000 LB TENSILE STRENGTH

REEL # N/A

N/A

1200' 1-1.5" ID HDPE, 1-1.5" ID HDPE (SPARE), 1-1.25" ID HDPE (SPARE)


CABLE FIBER COUNT MFL TYPE OF GLASS	CABLE
CABLE REEL NO.	DESCRIPTION
SPLICE TO SPLICE CABLE LENGTH & COIL LENGTH	
WARRANTY & TYPE (COND/SHOULDER/COLOR)	PIPE & WAREHOUSE PLACEMENT
STEEL PIPE SIZE	
PVC	
FUTURE-2	FUTURE USE PLACE
FUTURE-3	
FUTURE-4	



COMMUNICATIONS GROUP
Network Services

POINT ARENA TO SACRAMENTO
CABLE ROUTE

DESIGN BY : HMC	DATE : 08/25/00
CHECKED BY : MHW	DATE : 08/25/00
APPROVED BY :	DATE :
APPROVED BY :	DATE :
APR : 4877	LOC. CODE :
HORIZONTAL SCALE (DWS & PROF) :	1"=100'
VERTICAL SCALE (DWS) :	
VERTICAL SCALE (PROF) :	
MAP PROJECTION :	
DRAWING NUMBER :	SHEET - 10

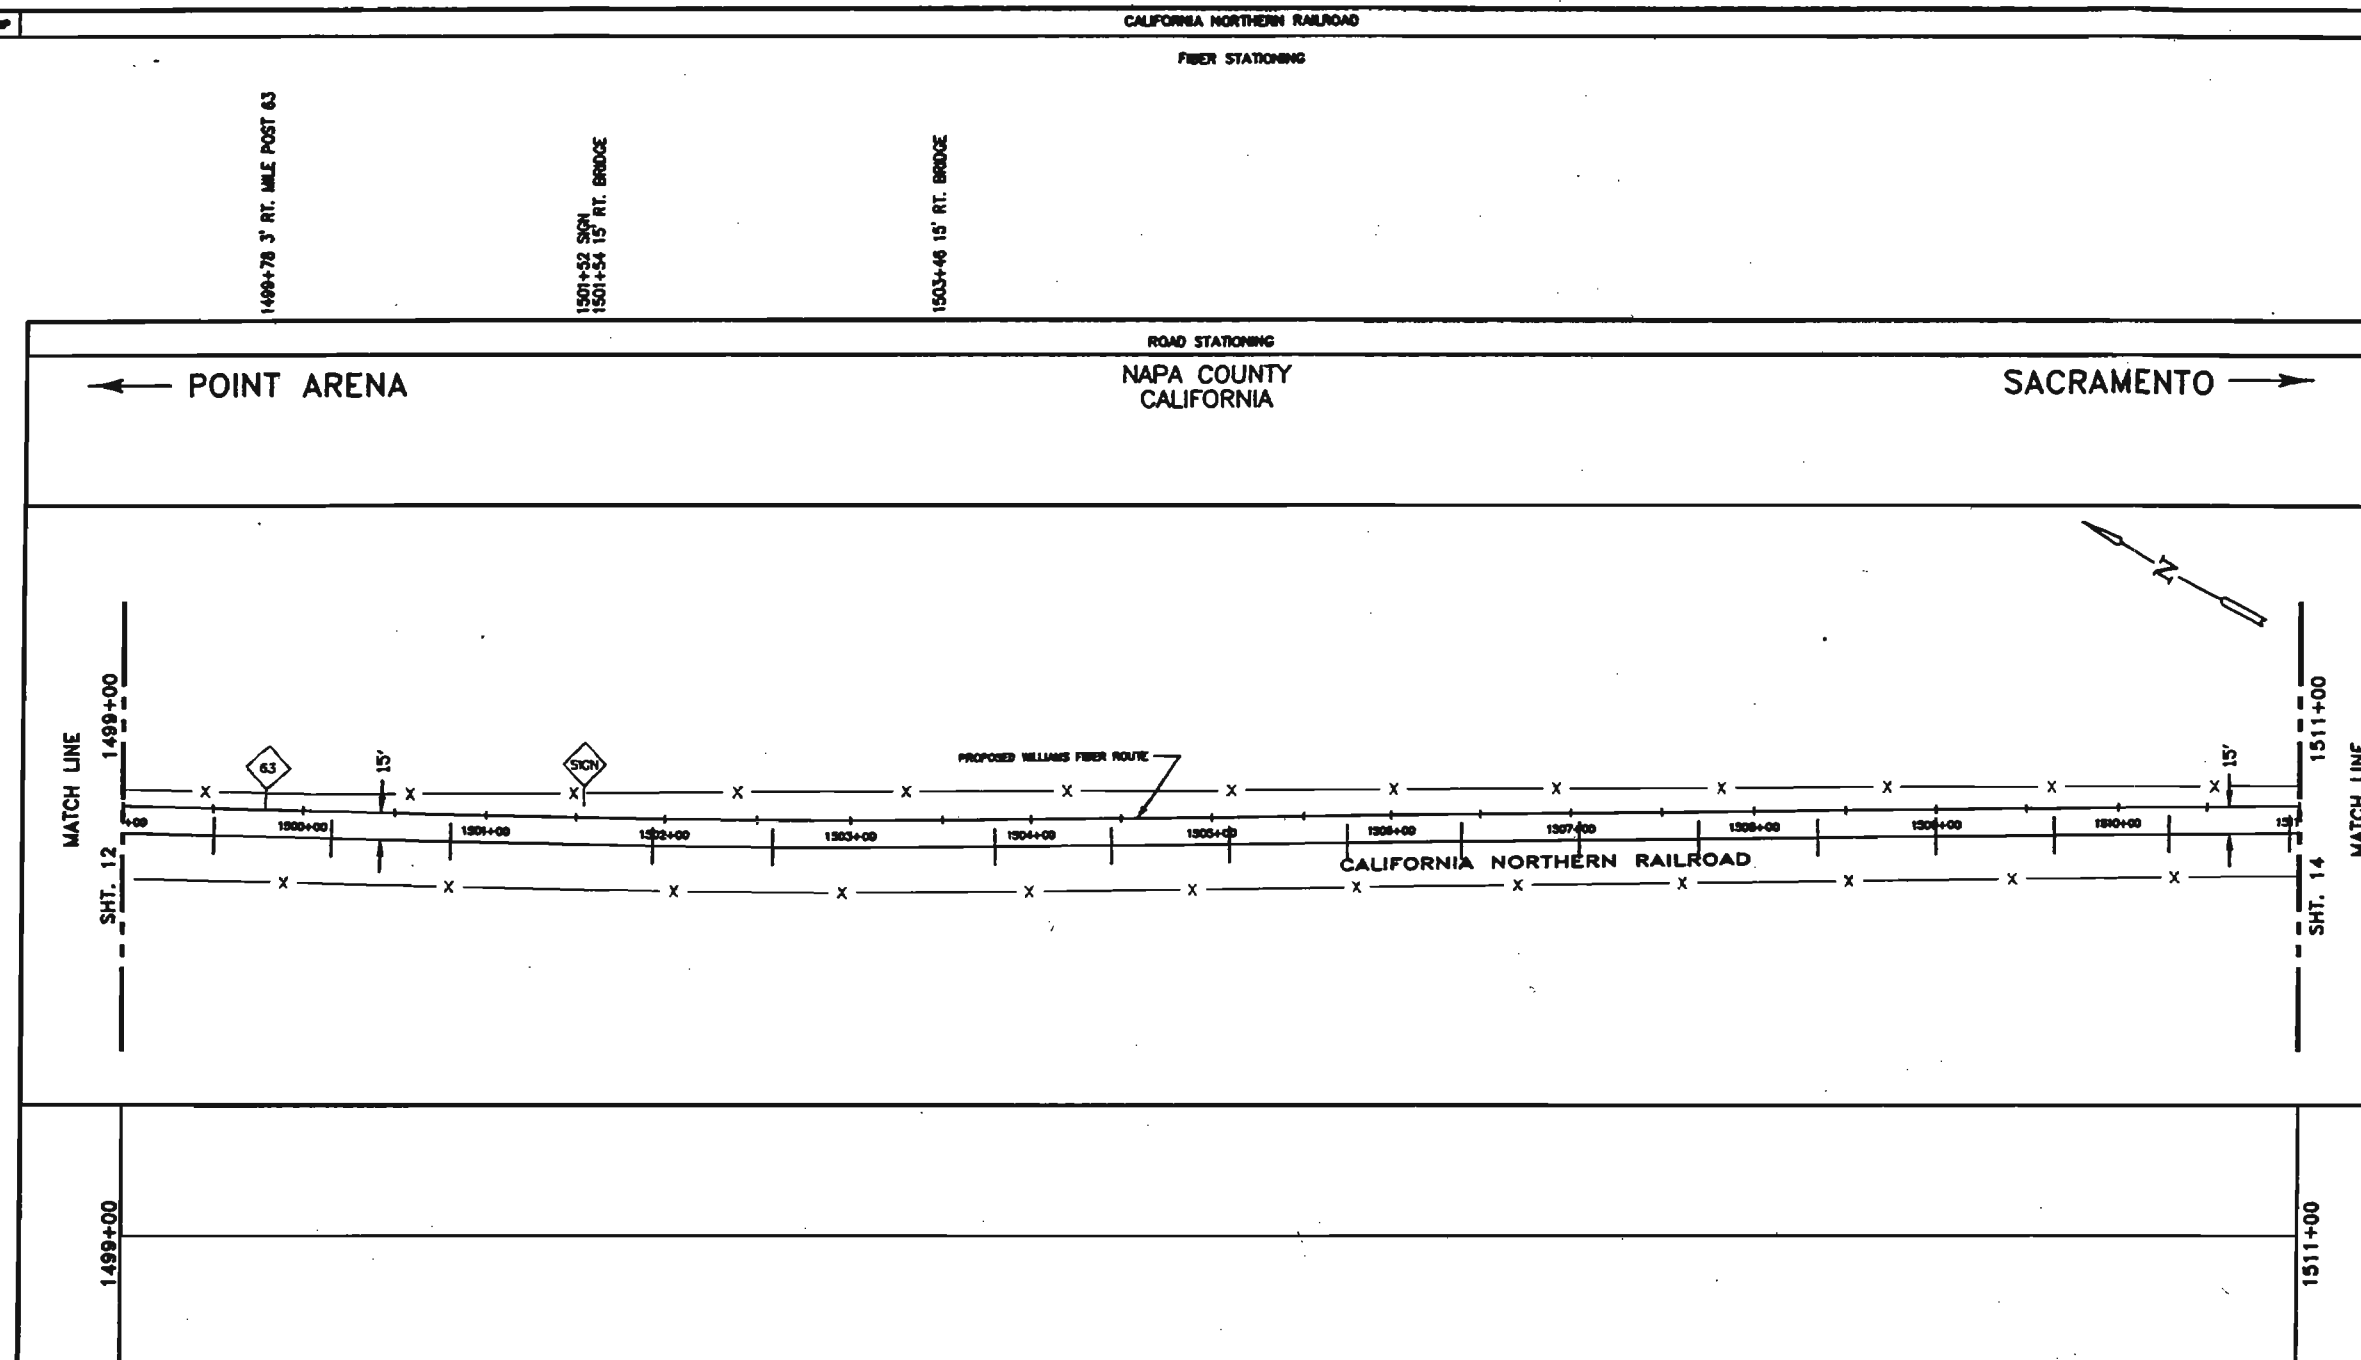

96	- LEAF FIBER, LOOSE BUFFER TUBE CABLE, 12 FIBERS PER TUBE, DIELECTRIC CENTRAL MEMBER, DUAL JACKET SINGLE ARMOR, 1000 LB TENSILE STRENGTH
	REEL # N/A
	N/A
	1200' 1-1.5" ID HDPE, 1-1.5" ID HDPE (SPARE), 1-1.25" ID HDPE (SPARE)

LEGEND

	Interstate Hwy.		Regain Site
	U.S. Hwy.		P.O.P./Jct.
	State Hwy.		Handshake Splice
	County Road		Handshake
	RR Mile Mkr.		Handshake Splice
	Mile, Road Sign		Handshake
	How Fiber Cable		SS Handshake
	Township Line		Water Valve / Meter
	City Limits		Gas Valve / Meter
	R/W Line		Signal Pole
	River/Stream		Fire Hydrant
	CL Road		Gas Marker
	CL RR Tracks		Oil Marker
	Fence		Fiber Marker
	Oil Pipeline		Water Intake
	Gas Pipeline		
	Power Line		
	Water Line		
	Sea, Sewer		
	Shore Drain		
	Telephone Line		
	Blank Iron Pipe		
	Concretized Iron Pipe		
	Edge of Pavement		
	Edge of Ground		
	Face of Curve		
	Fog Line and/or White Line		

WILLIAMS
EMERGENCY NOTIFICATION NUMBER
1-800-582-8089

CAUTION

**WILLIAMS LOCATE & FOR
COUNTY, STATE
1-888-943-2255**

**FOREIGN UTILITY LOCATIONS ARE
APPROXIMATE. CONTACT THE LOCAL ONE
CALL AGENCY 48 HOURS PRIOR
TO CONSTRUCTION FOR EXACT
UTILITY LOCATIONS AT :**

1-800-227-2800

DRAWING DISCLAIMER


FACILITY LOCATIONS ARE GENERAL IN NATURE
WILLIAMS WILL NOT BE HELD ACCOUNTABLE FOR
THE ACCURACY OF THE INFORMATION PROVIDED
ON THESE DRAWINGS.

PRELIMINARY

[illegible]

CABLE FIBER COUNT MFG. TYPE OF GLASS	CABLE DESCRIPTION
CABLE REEL NO.	
SPLICE TO SPLICE CABLE LENGTH & COIL LENGTH	
WINDING & TYPE (CONC./BAGGON/COLOR)	FIBER & WINDING PLACEMENT
STEEL PIPE SIZE	
PVC	
FUTURE-2	FUTURE GRID PLACE
FUTURE-3	
FUTURE-4	

		COMMUNICATIONS GROUP Network Services	
POINT ARENA TO SACRAMENTO CABLE ROUTE			
DRAWN BY : NWC		DATE : 08/25/00	
CHECKED BY : MHW		DATE : 08/29/00	
APPROVED BY :		SIGN :	
APPROVED BY :		DATE :	
AFE : 4577		LOC. CODE :	
HORIZONTAL SCALE (HWS & PROF) : 1"=100'			
VERTICAL SCALE (VWS) :			
VERTICAL SCALE (PROF) :			
MAP PROJECTION :			
DRAWING NUMBER : SHEET - 13			

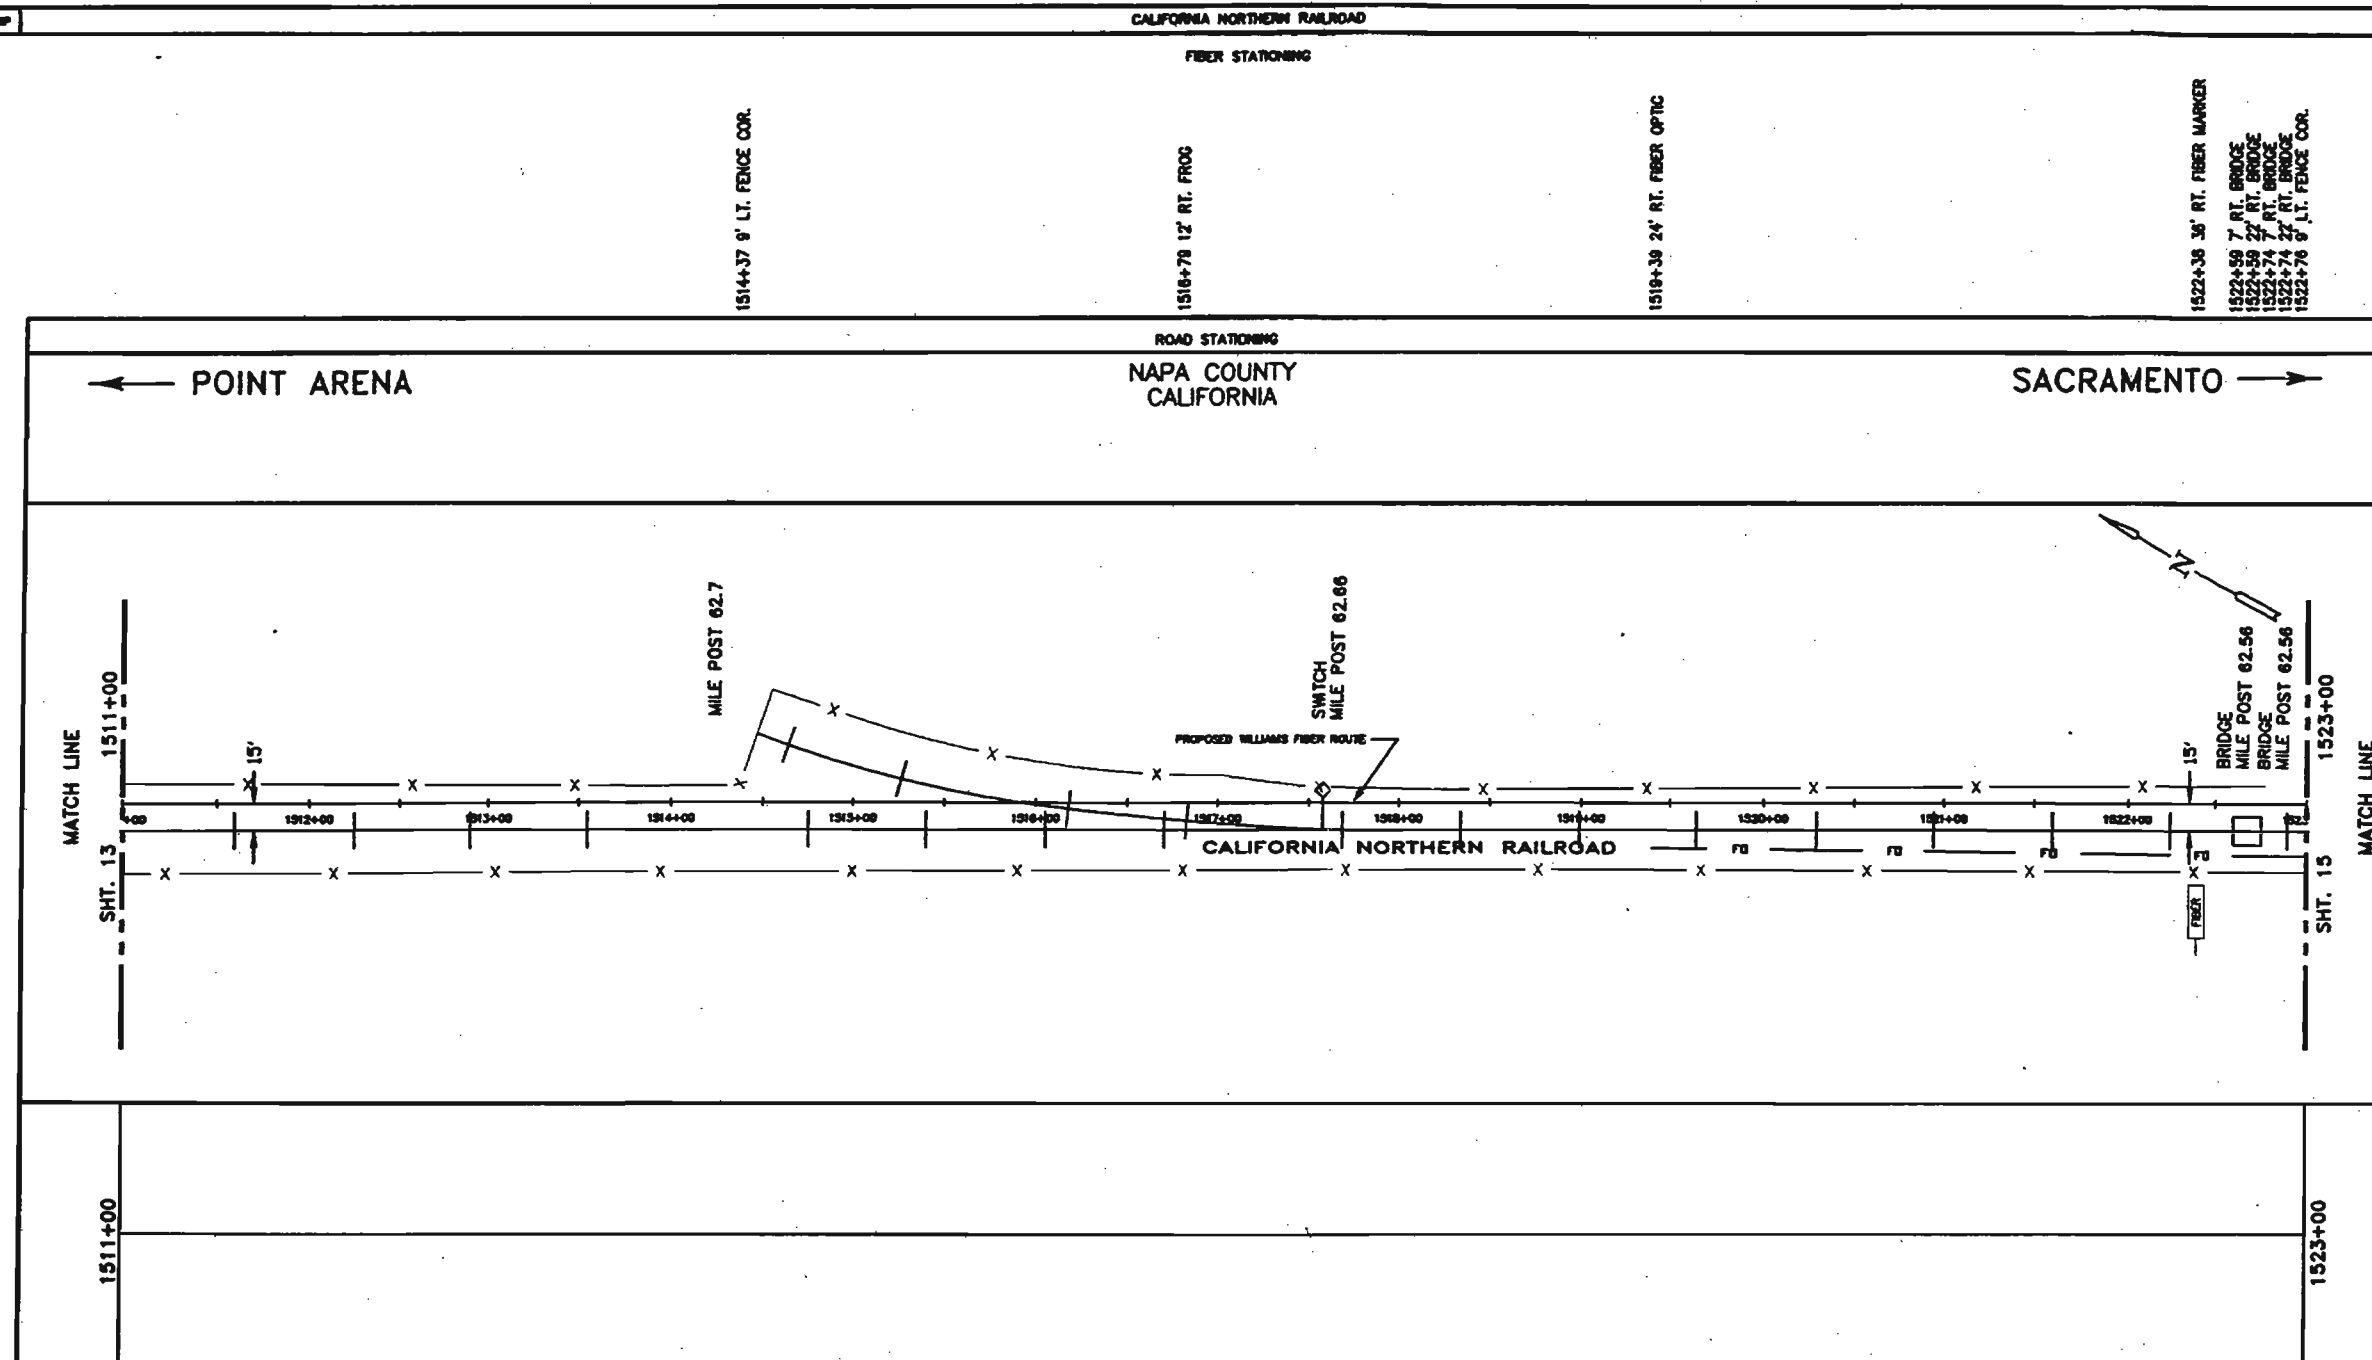

96	-	LEAF FIBER, LOOSE BUFFER TUBE CABLE, 12 FIBERS PER TUBE, DIELECTRIC CENTRAL MEMBER, DUAL JACKET SINGLE ARMOR, 1000 LB TENSILE STRENGTH
		REEL # N/A
		N/A
		1200' 1-1.5" ID HDPE, 1-1.5" ID HDPE (SPARE), 1-1.25" ID HDPE (SPARE)

LEGEND

	Interstate Hwy.		Region Site
	U.S. Hwy.		P.O.P. / Jct.
	State Hwy.		Manhole Symbol
	County Road		Manhole
	RR Mile Mark.		Manhole Symbol
			Manhole
	Miles Road Sign		SS Manhole
	New Fiber Cable		Power Pole
	Turntable Line		Water Valve / Meter
	City Limits		Gas Valve / Meter
	R/W Line		Signal Pole
	River/Stream		Fire Hydrant
	CL Road		Gas Marker
	CL RR Tracks		GS Marker
	Fences		Fiber Marker
	GS Pipeline		
	Gas Pipeline		Water Inlet
	Power Line		
	Water Line		
	Sew. Sewer		
	Storm Drain		
	Telephone Line		
	Black Iron Pipe		
	Galvanized Iron Pipe		
	Edge of Pavement		
	Edge of Ground		
	Face of Curve		
	Fog Line and/or White Line		

WILLIAMS
EMERGENCY NOTIFICATION NUMBER
1-800-582-9068

CAUTION
WILLIAMS LOCATE ϕ FOR
COUNTY, STATE
1-888-945-2255

FOREIGN UTILITY LOCATIONS ARE
APPROXIMATE. CONTACT THE LOCAL ONE
CALL AGENCY 48 HOURS PRIOR
TO CONSTRUCTION FOR EXACT
UTILITY LOCATIONS AT :
1-800-227-2600

DRAWING DISCLAIMER

FACILITY LOCATIONS ARE GENERAL IN NATURE
WILLIAMS WILL NOT BE HELD ACCOUNTABLE FOR
THE ACCURACY OF THE INFORMATION PROVIDED
ON THESE DRAWINGS.

PRELIMINARY

[illegible]

CABLE FIBER COUNT MFG. TYPE OF GLASS	CABLE DESCRIPTION
CABLE REEL NO.	
SPACE TO SPACE CABLE LENGTH & COIL LENGTH	
SHIELDING & TYPE (CONC./SHADOW/COLOR)	PIPE & SHIELDING PLACEMENTS
STEEL PIPE SIZE	
PVC	
FUTURE-2	FUTURE PIPE PLACE
FUTURE-3	
FUTURE-4	



COMMUNICATIONS GROUP
Internet Services

**POINT ARENA TO SACRAMENTO
CABLE ROUTE**

DRAWN BY :	MMC	DATE :	08/28/00
CHECKED BY :	LMW	DATE :	08/28/00
APPROVED BY :		DATE :	
APPROVED BY :		DATE :	
APE : 4577		LOC. CODE :	
HORIZONTAL SCALE (HWS & PROF) : 1"=100'			
VERTICAL SCALE (VWS) :			
VERTICAL SCALE (PROF) :			
MAP PROJECTION :			

OWNER'S USE

CALIFORNIA NORTHERN RAILROAD

FIBER STATIONING

1537+01 31' RT. HEADWALL
1537+03 1' LT. HEADWALL
1537+08 31' RT. HEADWALL
1537+09 1' LT. HEADWALL

1538+72 26' RT. SPLICE BOX


1539+42 15' RT. BRIDGE

ROAD STATIONING

NAPA COUNTY
CALIFORNIA

SACRAMENTO

POINT ARENA

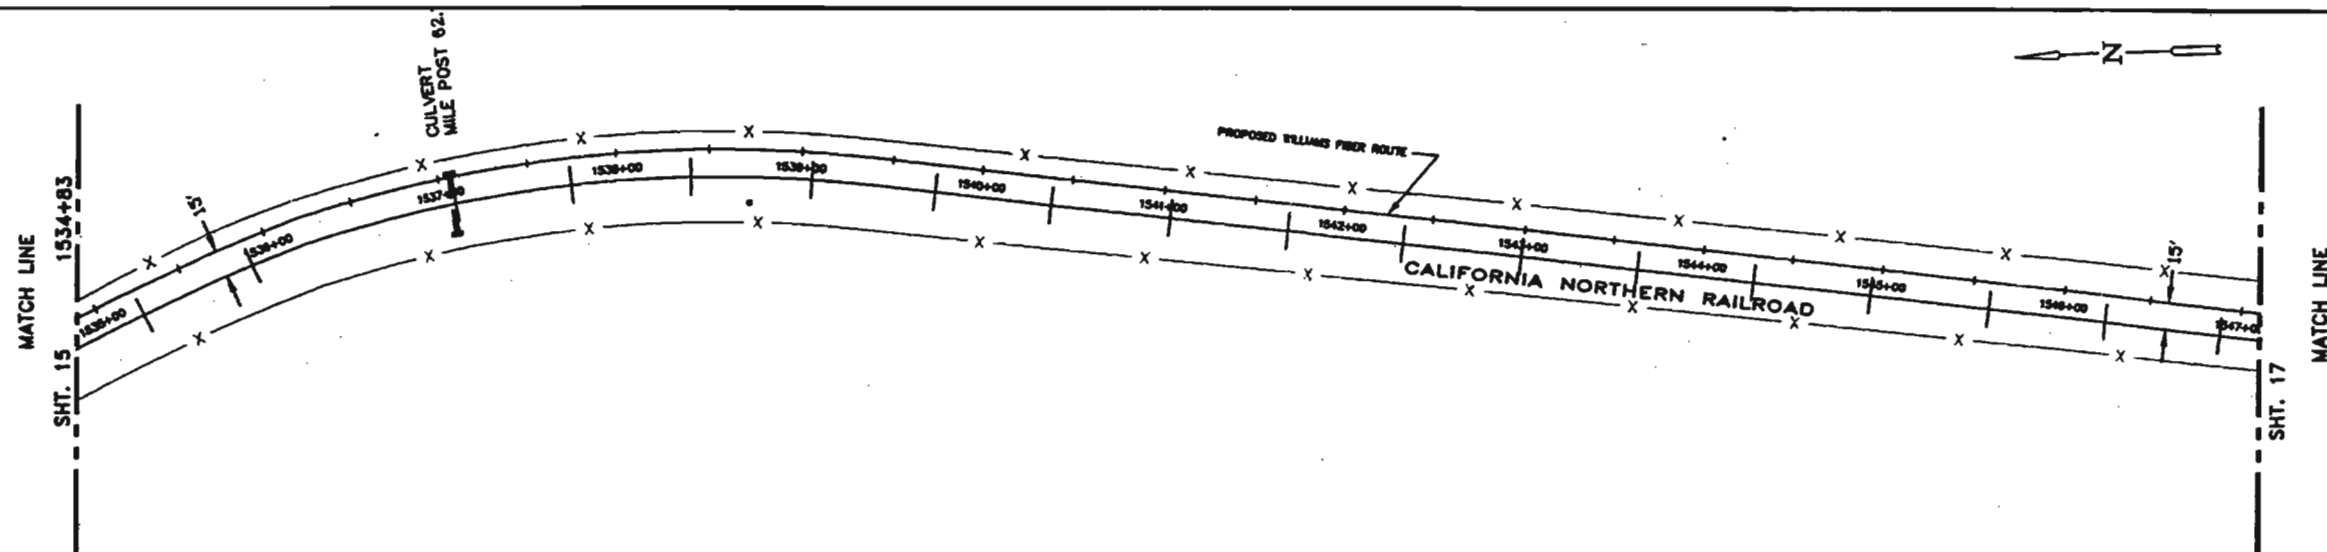

LEGEND

- Interstate Hwy.
- U.S. Hwy.
- State Hwy.
- County Road
- RR Mile Mkr.
- Min. Road Sign
- Now Road Cable
- Township Line
- City Limits
- R/W Line
- River/Stream
- CL Road
- CL RR Tracks
- Fence
- Oil Pipeline
- Gas Pipeline
- Power Line
- Water Line
- San. Sewer
- Storm Drain
- Telephone Line
- Black Iron Pipe
- Galvanized Iron Pipe
- Edge of Pavement
- Edge of Gravel
- Face of Cut
- Fog Line and/or White Line
- Region Site
- P.O.P./Jct.
- Handhole Splice
- Handhole
- Manhole Splice
- Manhole
- 25 Manhole
- Power Pole
- Water Valve / Meter
- Gas Valve / Meter
- Signal Pole
- Pole Hydrant
- Gas Marker
- Oil Marker
- Fiber Marker
- Water Inlet

WILLIAMS

EMERGENCY NOTIFICATION NUMBER
1-800-582-9088

CAUTION

WILLIAMS LOCATE # FOR
COUNTY, STATE
1-888-845-2255
FOREIGN UTILITY LOCATIONS ARE
APPROXIMATE. CONTACT THE LOCAL ONE
CALL AGENCY 48 HOURS PRIOR
TO CONSTRUCTION FOR EXACT
UTILITY LOCATIONS AT :
1-800-227-2600

DRAWING DISCLAIMER

FACILITY LOCATIONS ARE GENERAL IN NATURE.
WILLIAMS WILL NOT BE HELD ACCOUNTABLE FOR
THE ACCURACY OF THE INFORMATION PROVIDED
ON THESE DRAWINGS.

PRELIMINARY

REVISIONS

REV. NO.	DESCRIPTION	BY	DATE

96 - LEAF FIBER, LOOSE BUFFER TUBE CABLE, 12 FIBERS PER TUBE, DIELECTRIC CENTRAL MEMBER, DUAL JACKET SINGLE ARMOR, 1000 LB TENSILE STRENGTH

REEL # N/A

N/A

1200' 1-1.5" ID HDPE, 1-1.5" ID HDPE (SPARE), 1-1.25" ID HDPE (SPARE)

CABLE FIBER COUNT	MPG. TYPE OF GLASS	CABLE DESCRIPTION


COMMUNICATIONS GROUP
Network Services

POINT ARENA TO SACRAMENTO CABLE ROUTE

DRAWN BY : HNC	DATE : 08/25/08
CHECKED BY : MHW	DATE : 08/29/08
APPROVED BY :	DATE :
APPROVED BY :	DATE :

MP : 4577 LOC. CODE :
HORIZONTAL SCALE (HWS & PROF) : 1"=100'
VERTICAL SCALE (VWS) :
VERTICAL SCALE (VPS) :
MAP PROJECTION :

DRAWING NUMBER : SHEET - 16

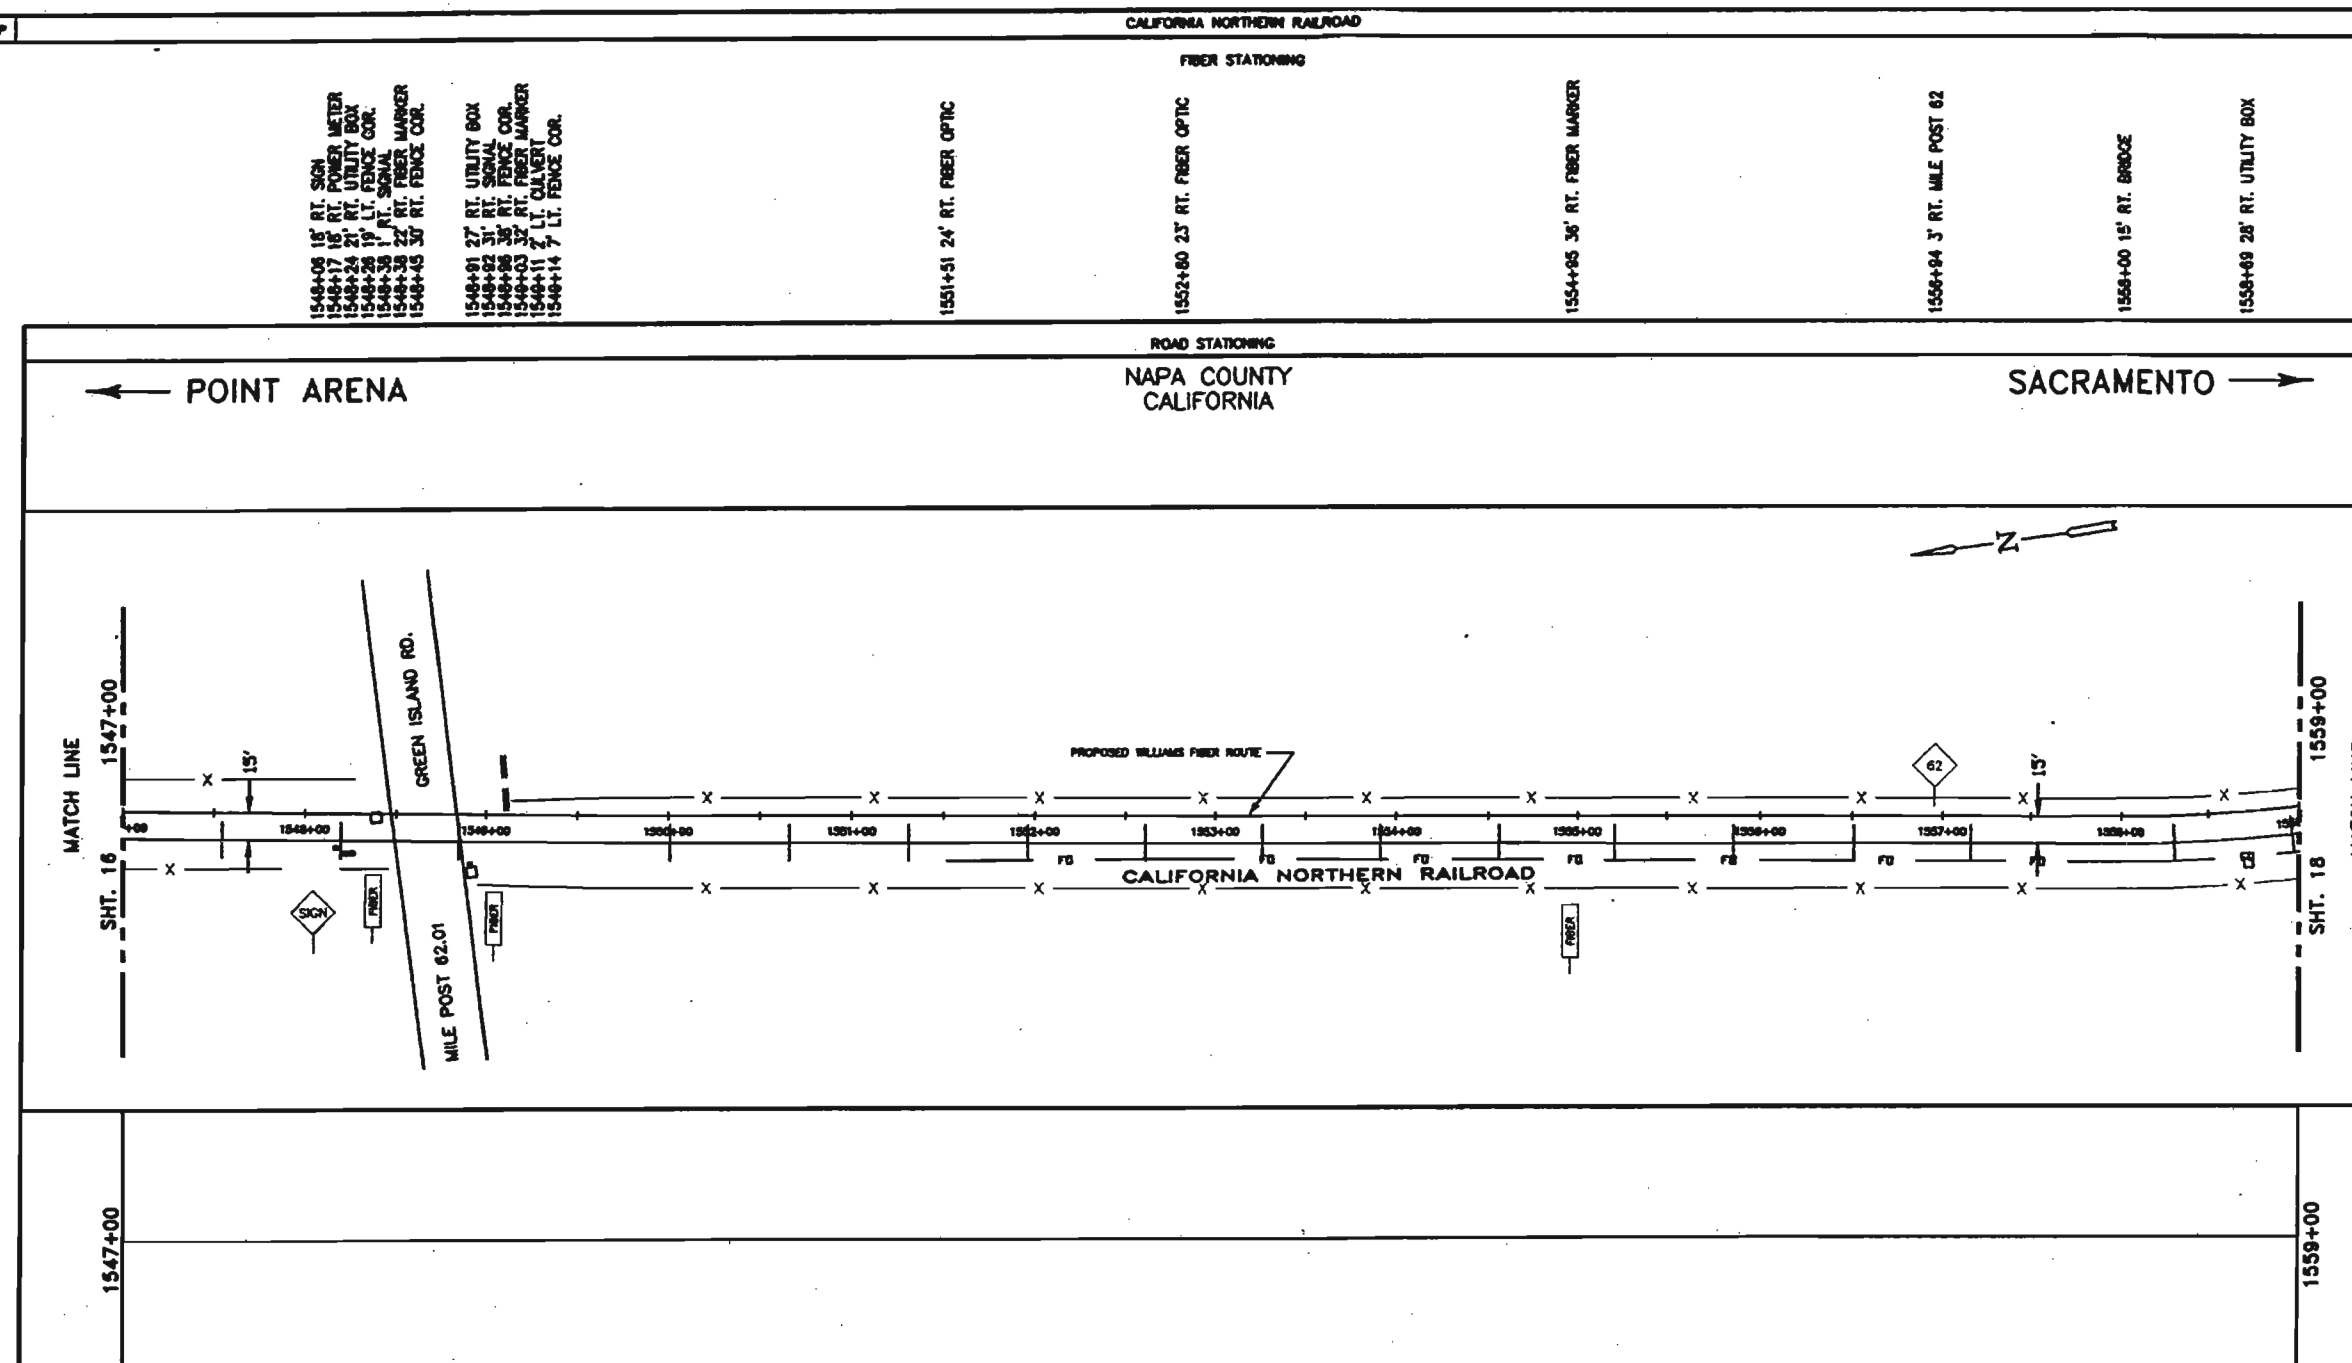

96	-- LEAF FIBER, LOOSE BUFFER TUBE CABLE, 12 FIBERS PER TUBE, DIELECTRIC CENTRAL MEMBER, DUAL JACKET SINGLE ARMOR, 1000 LB TENSILE STRENGTH
	REEL # N/A
	N/A
	1200' 1-1.5" ID HDPE, 1-1.5" ID HDPE (SPARE), 1-1.25" ID HDPE (SPARE)

LEGEND

	Interstate Hwy.		Region Site
	U.S. Hwy.		P.O.P. / Int.
	State Hwy.		Handhole System
	County Road		Handhole
	RR Mile Mar.		Handhole System
	Min. Road Sign		Handhole
	Min. Road Sign		SE Handhole
	New Fiber Cable		Power Pole
	Township Line		Water Valve / Meter
	City Limits		Gas Valve / Meter
	R/W Line		Signal Pole
	River/Stream		Fire Hydrant
	CL Road		Gas Marker
	CL RR Tracks		Oil Marker
	Fence		Oil Marker
	Oil Pipeline		Oil Marker
	Gas Pipeline		Oil Marker
	Power Line		Oil Marker
	Water Line		Oil Marker
	Gas. Sewer		Oil Marker
	Storm Sewer		Oil Marker
	Telephone Line		Oil Marker
	Black Iron Pipe		Oil Marker
	Galvanized Iron Pipe		Oil Marker
	Edge of Pavement		Oil Marker
	Edge of Ground		Oil Marker
	Foe of Curve		Oil Marker
	Fee Line and/or White Line		Oil Marker

WILLIAMS
EMERGENCY NOTIFICATION NUMBER
1-800-582-8089

CAUTION

**WILLIAMS LOCATE & FOR
COUNTY, STATE
1-888-945-2255**

**FOREIGN UTILITY LOCATIONS ARE
APPROXIMATE. CONTACT THE LOCAL ONE
CALL AGENCY 48 HOURS PRIOR
TO CONSTRUCTION FOR EXACT
UTILITY LOCATIONS AT :
1-800-227-2800**

DRAWING DISCLAIMER

FACILITY LOCATIONS ARE GENERAL IN NATURE
WILLIAMS WILL NOT BE HELD ACCOUNTABLE FOR
THE ACCURACY OF THE INFORMATION PROVIDED
ON THESE DRAWINGS.

PRELIMINARY

[illegible]

CABLE FIBER COUNT MFL TYPE OF GLASS	CABLE
CABLE REEL NO.	REEL NO.
SPACE TO SPACE CABLE LENGTH & COIL LENGTH	
INTERDUCT & TYPE (COIL/SMOOTH/COLOR)	PFE
SHEEL PIPE SIZE	BRANCHING
PVC	PLACEMENT
FUTURE-2	
FUTURE-3	
FUTURE-4	FUTURE
	USE
	PLACE



COMMERCIAL GROUP
Black Series

POINT ARENA TO SACRAMENTO
CABLE ROUTE

DRAWN BY :	NHC	DATE :	08/25/00
CHECKED BY :	MAW	DATE :	08/29/00
APPROVED BY :		DATE :	
APPROVED BY :		DATE :	
NFE : 4577		LOC. CODE :	
HORIZONTAL SCALE (HWS & PROF) : 1"=100'			
VERTICAL SCALE (HWS) :			
VERTICAL SCALE (PROF) :			
MAP PROJECTION :			

SHEET - 17

[illegible]

SACRAMENTO

POINT ARENA



1583+12

1200' 1-1.5" ID HDPE, 1-1.5" ID HDPE (SPARE), 1-1.25" ID HDPE (SPARE)

WILLIAMS

CAUTION

DRAWING DISCLAIMER

PRELIMINARY

CABLE FIBER COUNT INFO. TYPE OF GLASS	CABLE
CABLE REEL NO.	DESCRIPTION
SPACE TO SPlice CABLE LENGTH & CBL. LENGTH	
BEND RADIUS & TYPE (CORR./SMOOTH/COLOR)	FIBER
STEEL PIPE SIZE	&
PVC	BEND RADIUS
FUTURE-3	PLACEMENT
FUTURE-3	
FUTURE-4	FUTURE
	USE
	PLACE

POINT ARENA TO SACRAMENTO CABLE ROUTE

DRAWN BY : MWC	DATE : 08/23/00
CHECKED BY : MWH	DATE : 08/23/00
APPROVED BY :	DATE :
APPROVED BY :	DATE :
NPC : 4877	LOC. CODE :
HORIZONTAL SCALE (HWS & PROF) : 1"=100'	
VERTICAL SCALE (VWS) :	
VERTICAL SCALE (PROF) :	
MAP PROJECTION :	
DRAWING NUMBER : SHEET - 19	

OVERSHEET

CALIFORNIA NORTHERN RAILROAD

FIBER STATIONING


1583+78 22' RT. FROG
1584+42 28' RT. CL RR
1584+42 41' RT. CL RR
1585+31 25' RT. CL RR
1585+38 5' RT. CL RR
1585+44 5' RT. FENCE
1585+44 5' RT. GUY WIRE
1585+51 47' RT. GUY WIRE
1585+51 2' RT. CL RR
1585+77 45' RT. CULVERT
1587+13 23' RT. CL RR
1587+13 40' RT. POLE
1587+14 48' RT. GUY WIRE
1588+11 21' RT. CL RR
1589+09 50' RT. GUY WIRE
1589+11 42' RT. POLE
1589+25 25' RT. CL RR
1589+30 5' RT. FENCE
1590+96 73' RT. POLE
1590+97 84' RT. GUY WIRE
1591+07 36' RT. CL RR
1593+40 30' RT. CL RR

ROAD STATIONING

NAPA COUNTY
CALIFORNIA

POINT ARENA

SACRAMENTO

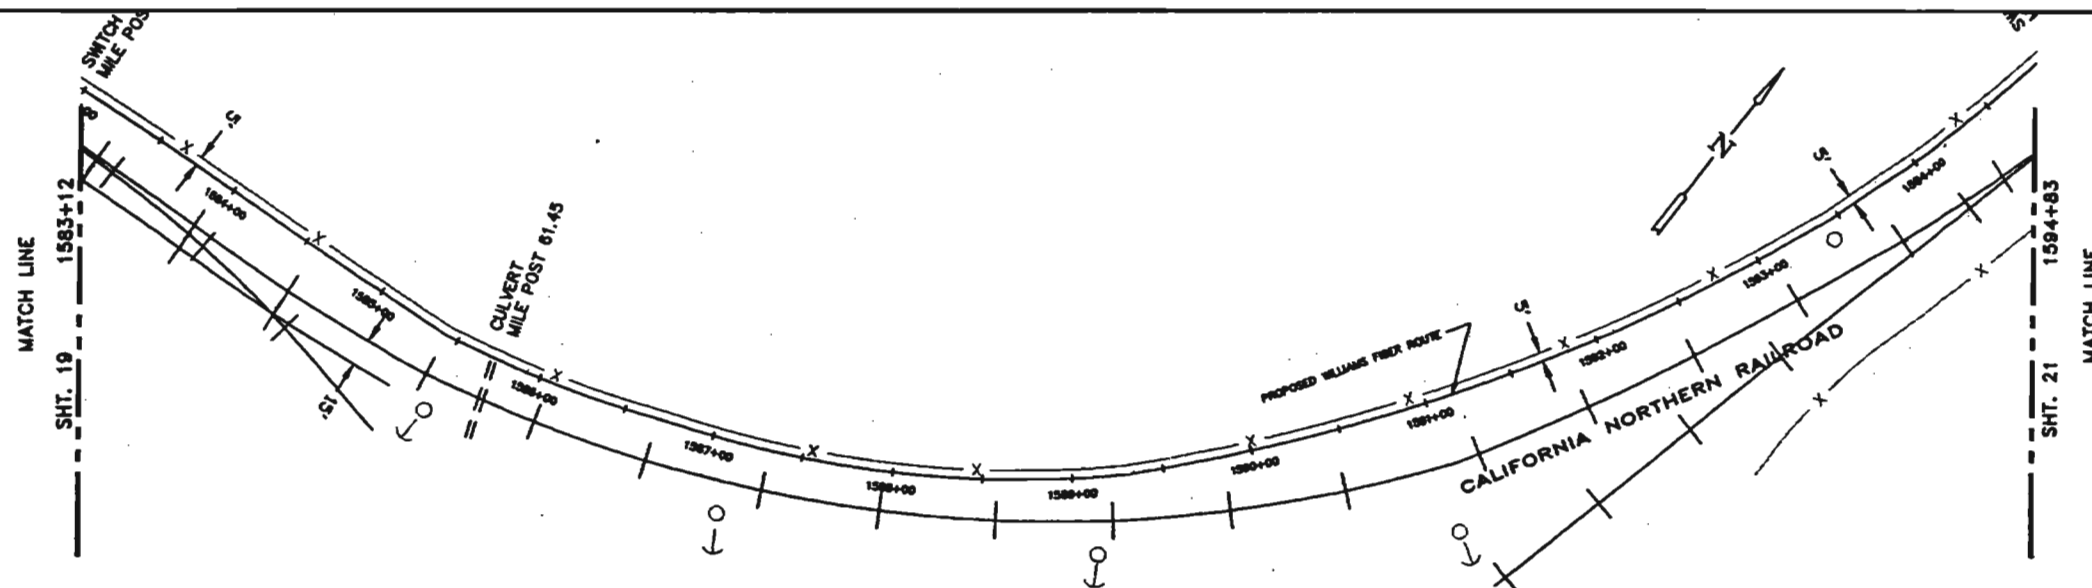

LEGEND

- Interstate Hwy.
- U.S. Hwy.
- State Hwy.
- County Road
- RR Mile Mr.
- Min. Road Sign
- New Fiber Cable
- Existing Line
- City Limits
- R/W Line
- Flow/Stream
- CL Road
- CL RR Tracks
- Fence
- Gas Pipeline
- Gas Pipeline
- Power Line
- Water Line
- San. Sewer
- Storm Drain
- Telephone Line
- Black Iron Pipe
- Galvanized Iron Pipe
- Edge of Pavement
- Edge of Gravel
- Face of Curb
- Fog Line and/or White Line
- Regen Site
- P.O.P./Jct.
- Handhole Splice
- Handhole
- Handhole Splice
- Handhole
- SS Handhole
- Power Pole
- Water Valve / Meter
- Gas Valve / Meter
- Signal Pole
- Pole Hydrant
- Gas Marker
- OS Marker
- OS Marker
- Fiber Marker
- Water Inlet

WILLIAMS

EMERGENCY NOTIFICATION NUMBER

1-800-582-9088

CAUTION

WILLIAMS LOCATE # FOR
COUNTY, STATE
1-888-945-2255

FOREIGN UTILITY LOCATIONS ARE
APPROXIMATE. CONTACT THE LOCAL ONE
CALL AGENCY 48 HOURS PRIOR
TO CONSTRUCTION FOR EXACT
UTILITY LOCATIONS AT :

1-800-227-2800

DRAWING DISCLAIMER

FACILITY LOCATIONS ARE GENERAL IN NATURE.
WILLIAMS WILL NOT BE HELD ACCOUNTABLE FOR
THE ACCURACY OF THE INFORMATION PROVIDED
ON THESE DRAWINGS.

PRELIMINARY

REVISIONS

REV. NO.	DESCRIPTION	BY	DATE

96 - LEAF FIBER, LOOSE BUFFER TUBE CABLE, 12 FIBERS PER TUBE, DIELECTRIC CENTRAL MEMBER, DUAL JACKET SINGLE ARMOR, 1000 LB TENSILE STRENGTH

REEL # N/A

N/A

1200' 1-1.5" ID HDPE, 1-1.5" ID HDPE (SPARE), 1-1.25" ID HDPE (SPARE)

CABLE FIBER COUNT MFD. TYPE OF GLASS	CABLE DESCRIPTION
CABLE REEL NO.	
SPACE TO SPACE CABLE LENGTH & CABLE LENGTH	
SPURRING & TYPE (CONC./SMOOTH/COLOR)	
STEEL PIPE SIZE	
PVC	
FUTURE-2	
FUTURE-3	
FUTURE-4	



COMMUNICATIONS GROUP
Railroad Division

POINT ARENA TO SACRAMENTO
CABLE ROUTE

DRAWN BY : HNC DATE : 08/23/09
CHECKED BY : MFW DATE : 08/23/09
APPROVED BY : DATE :
DATE : 4877 LOC. CODE :
HORIZONTAL SCALE (DWD & PROF) : 1"=100'
VERTICAL SCALE (DWD) :
VERTICAL SCALE (PROF) :
MAP PROJECTION :
DRAWING NUMBER : SHEET - 20

FIBER STATISTICS

5044-83	40RT. SWITCH
5044-83	50RT. SWITCH
5044-15	50RT. FIBER OPTIC
5044-18	7 LT. FENCE CORNER
5044-23	7 LT. POWER POLE
5044-27	50RT. FIBER MARKER
5044-30	3 RT. FIBER SON
5044-31	3 RT. CL VENT
5044-32	50RT. FIBER OPTIC
5044-33	50RT. FIBER OPTIC
5044-44	70RT. FENCE CORNER
5044-52	40RT. CL RR
5044-54	20RT. GAS LINE
5044-56	20RT. WATER LINE
5044-62	67RT. GAS LINE
5044-74	3 RT. SON
5044-75	60RT. WATER LINE
5044-81	50RT. FIBER OPTIC
5044-82	57RT. FIBER MARKER
5044-83	80RT. WATER VALVE
5044-85	80RT. FENCE CORNER
5044-86	6 LT. FIBER MARKER
5044-87	83RT. FIBER MARKER
5044-92	49RT. FIBER OPTIC
5044-93	40RT. CL RR
5044-93	6 LT. FENCE CORNER
5044-94	30RT. CL RR
5044-95	30RT. FENCE

1599+57 88'RT. FENCE
1599+65 40'RT. CL RR
1599+65 7' LI. FENCE

1601+81 82'RT. FIBER MARKER

1603+19 39RT. CL RR
1603+21 7 LT. FENCE

1603+95	8' LT. FENCE
1603+97	11' LT. POWER POLE

1604+29 77'RT. CL DITCH
1604+44 94'RT. POWER POLE

1604+63 89'RT. FENCE

1605+11 40' RT. CL. RR
1605+14 7' LT. FENCE


606+34	26"RT. CULVERT
606+34	53"RT. CULVERT
606+34	67"RT. CL DITCH
606+35	8 RT. CL CREEK
606+37	50"RT. CL CREEK
606+65	61"RT. FIBER MARKER
606+57	49"RT. FIBER OPTIC

ROAD STATING

**NAPA COUNTY
CALIFORNIA**

SACRAMENTO

POINT ARENA

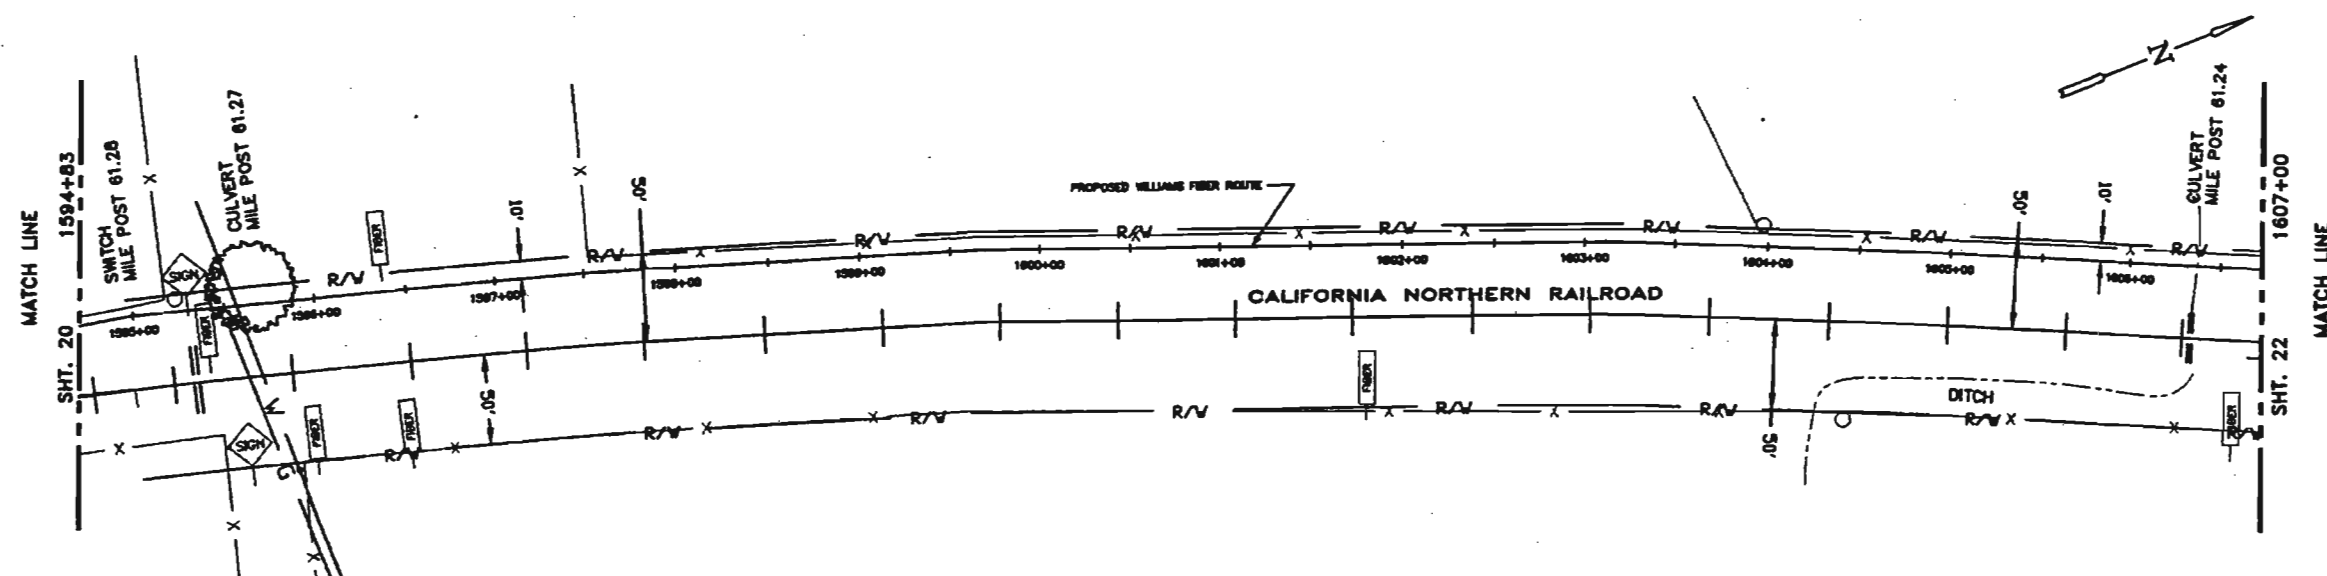


98 - LEAF FIBER, LOOSE BUFFER TUBE CABLE, 12 FIBERS PER TUBE, DIELECTRIC CENTRAL MEMBER, DUAL JACKET SINGLE ARMOR, 1000 LB TENSILE STRENGTH

REEL # N/A

N/A

1200' 1-1.5" ID HDPE, 1-1.5" ID HDPE (SPARE), 1-1.25" ID HDPE (SPARE)

LEGEND

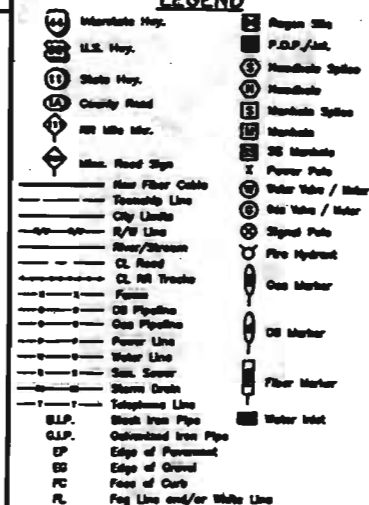

WILLIAMS

EMERGENCY NOTIFICATION NUMBER
1-800-582-8099

CAUTION

WILLIAMS LOCATE # FOR
COUNTY, STATE
1-888-945-2255

FOREIGN UTILITY LOCATIONS ARE APPROXIMATE. CONTACT THE LOCAL ONE CALL AGENCY 48 HOURS PRIOR TO CONSTRUCTION FOR EXACT UTILITY LOCATIONS AT :
1-800-227-2600

DRAWING DISCLAIMER

FACILITY LOCATIONS ARE GENERAL IN NATURE
WILLIAMS WILL NOT BE HELD ACCOUNTABLE FOR
THE ACCURACY OF THE INFORMATION PROVIDED
ON THESE DRAWINGS.

PRELIMINARY

[illegible]

CABLE FIBER COUNT MFG. TYPE OF GLASS	CABLE
CABLE SERIAL NO.	DESCRIPTION
SPACE TO SPACE CABLE LENGTH & COIL LENGTH	
EMERGENCY TO TYPE (COAR/SMOOTH/COLOR)	PIPE &
STEEL PIPE SIZE	BRIDGE
PVC	PLACEMENT
FUTURE-2	
FUTURE-3	PURPOSE
FUTURE-4	SHR
	PLACEMENT



1. **NAME** _____
 2. **ADDRESS** _____
 3. **CITY** _____
 4. **STATE** _____
 5. **ZIP** _____
 6. **PHONE** _____
 7. **DATE** _____
 8. **SIGNATURE** _____
 9. **PRINT NAME** _____
 10. **PRINT ADDRESS** _____
 11. **PRINT CITY** _____
 12. **PRINT STATE** _____
 13. **PRINT ZIP** _____
 14. **PRINT PHONE** _____
 15. **PRINT DATE** _____
 16. **PRINT SIGNATURE** _____
 17. **PRINT NAME** _____
 18. **PRINT ADDRESS** _____
 19. **PRINT CITY** _____
 20. **PRINT STATE** _____
 21. **PRINT ZIP** _____
 22. **PRINT PHONE** _____
 23. **PRINT DATE** _____
 24. **PRINT SIGNATURE** _____
 25. **PRINT NAME** _____
 26. **PRINT ADDRESS** _____
 27. **PRINT CITY** _____
 28. **PRINT STATE** _____
 29. **PRINT ZIP** _____
 30. **PRINT PHONE** _____
 31. **PRINT DATE** _____
 32. **PRINT SIGNATURE** _____
 33. **PRINT NAME** _____
 34. **PRINT ADDRESS** _____
 35. **PRINT CITY** _____
 36. **PRINT STATE** _____
 37. **PRINT ZIP** _____
 38. **PRINT PHONE** _____
 39. **PRINT DATE** _____
 40. **PRINT SIGNATURE** _____
 41. **PRINT NAME** _____
 42. **PRINT ADDRESS** _____
 43. **PRINT CITY** _____
 44. **PRINT STATE** _____
 45. **PRINT ZIP** _____
 46. **PRINT PHONE** _____
 47. **PRINT DATE** _____
 48. **PRINT SIGNATURE** _____
 49. **PRINT NAME** _____
 50. **PRINT ADDRESS** _____
 51. **PRINT CITY** _____
 52. **PRINT STATE** _____
 53. **PRINT ZIP** _____
 54. **PRINT PHONE** _____
 55. **PRINT DATE** _____
 56. **PRINT SIGNATURE** _____
 57. **PRINT NAME** _____
 58. **PRINT ADDRESS** _____
 59. **PRINT CITY** _____
 60. **PRINT STATE** _____
 61. **PRINT ZIP** _____
 62. **PRINT PHONE** _____
 63. **PRINT DATE** _____
 64. **PRINT SIGNATURE** _____
 65. **PRINT NAME** _____
 66. **PRINT ADDRESS** _____
 67. **PRINT CITY** _____
 68. **PRINT STATE** _____
 69. **PRINT ZIP** _____
 70. **PRINT PHONE** _____
 71. **PRINT DATE** _____
 72. **PRINT SIGNATURE** _____
 73. **PRINT NAME** _____
 74. **PRINT ADDRESS** _____
 75. **PRINT CITY** _____
 76. **PRINT STATE** _____
 77. **PRINT ZIP** _____
 78. **PRINT PHONE** _____
 79. **PRINT DATE** _____
 80. **PRINT SIGNATURE** _____
 81. **PRINT NAME** _____
 82. **PRINT ADDRESS** _____
 83. **PRINT CITY** _____
 84. **PRINT STATE** _____
 85. **PRINT ZIP** _____
 86. **PRINT PHONE** _____
 87. **PRINT DATE** _____
 88. **PRINT SIGNATURE** _____
 89. **PRINT NAME** _____
 90. **PRINT ADDRESS** _____
 91. **PRINT CITY** _____
 92. **PRINT STATE** _____
 93. **PRINT ZIP** _____
 94. **PRINT PHONE** _____
 95. **PRINT DATE** _____
 96. **PRINT SIGNATURE** _____
 97. **PRINT NAME** _____
 98. **PRINT ADDRESS** _____
 99. **PRINT CITY** _____
 100. **PRINT STATE** _____
 101. **PRINT ZIP** _____
 102. **PRINT PHONE** _____
 103. **PRINT DATE** _____
 104. **PRINT SIGNATURE** _____
 105. **PRINT NAME** _____
 106. **PRINT ADDRESS** _____
 107. **PRINT CITY** _____
 108. **PRINT STATE** _____
 109. **PRINT ZIP** _____
 110. **PRINT PHONE** _____
 111. **PRINT DATE** _____
 112. **PRINT SIGNATURE** _____
 113. **PRINT NAME** _____
 114. **PRINT ADDRESS** _____
 115. **PRINT CITY** _____
 116. **PRINT STATE** _____
 117. **PRINT ZIP** _____
 118. **PRINT PHONE** _____
 119. **PRINT DATE** _____
 120. **PRINT SIGNATURE** _____
 121. **PRINT NAME** _____
 122. **PRINT ADDRESS** _____
 123. **PRINT CITY** _____
 124. **PRINT STATE** _____
 125. **PRINT ZIP** _____
 126. **PRINT PHONE** _____
 127. **PRINT DATE** _____
 128. **PRINT SIGNATURE** _____
 129. **PRINT NAME** _____
 130. **PRINT ADDRESS** _____
 131. **PRINT CITY** _____
 132. **PRINT STATE** _____
 133. **PRINT ZIP** _____
 134. **PRINT PHONE** _____
 135. **PRINT DATE** _____
 136. **PRINT SIGNATURE** _____
 137. **PRINT NAME** _____
 138. **PRINT ADDRESS** _____
 139. **PRINT CITY** _____
 140. **PRINT STATE** _____
 141. **PRINT ZIP** _____
 142. **PRINT PHONE** _____
 143. **PRINT DATE** _____
 144. **PRINT SIGNATURE** _____
 145. **PRINT NAME** _____
 146. **PRINT ADDRESS** _____
 147. **PRINT CITY** _____
 148. **PRINT STATE** _____
 149. **PRINT ZIP** _____
 150. **PRINT PHONE** _____
 151. **PRINT DATE** _____
 152. **PRINT SIGNATURE** _____
 153. **PRINT NAME** _____
 154. **PRINT ADDRESS** _____
 155. **PRINT CITY** _____
 156. **PRINT STATE** _____
 157. **PRINT ZIP** _____
 158. **PRINT PHONE** _____
 159. **PRINT DATE** _____
 160. **PRINT SIGNATURE** _____
 161. **PRINT NAME** _____
 162. **PRINT ADDRESS** _____
 163. **PRINT CITY** _____
 164. **PRINT STATE** _____
 165. **PRINT ZIP** _____
 166. **PRINT PHONE** _____
 167. **PRINT DATE** _____
 168. **PRINT SIGNATURE** _____
 169. **PRINT NAME** _____
 170. **PRINT ADDRESS** _____
 171. **PRINT CITY** _____
 172. **PRINT STATE** _____
 173. **PRINT ZIP** _____
 174. **PRINT PHONE** _____
 175. **PRINT DATE** _____
 176. **PRINT SIGNATURE** _____
 177. **PRINT NAME** _____
 178. **PRINT ADDRESS** _____
 179. **PRINT CITY** _____
 180. **PRINT STATE** _____
 181. **PRINT ZIP** _____
 182. **PRINT PHONE** _____
 183. **PRINT DATE** _____
 184. **PRINT SIGNATURE** _____
 185. **PRINT NAME** _____
 186. **PRINT ADDRESS** _____
 187. **PRINT CITY** _____
 188. **PRINT STATE** _____
 189. **PRINT ZIP** _____
 190. **PRINT PHONE** _____
 191. **PRINT DATE** _____
 192. **PRINT SIGNATURE** _____
 193. **PRINT NAME** _____
 194. **PRINT ADDRESS** _____
 195. **PRINT CITY** _____
 196. **PRINT STATE** _____
 197. **PRINT ZIP** _____
 198. **PRINT PHONE** _____
 199. **PRINT DATE** _____
 200. **PRINT SIGNATURE** _____
 201. **PRINT NAME** _____
 202. **PRINT ADDRESS** _____
 203. **PRINT CITY** _____
 204. **PRINT STATE** _____
 205. **PRINT ZIP** _____
 206. **PRINT PHONE** _____
 207. **PRINT DATE** _____
 208. **PRINT SIGNATURE** _____
 209. **PRINT NAME** _____
 210. **PRINT ADDRESS** _____
 211. **PRINT CITY** _____
 212. **PRINT STATE** _____
 213. **PRINT ZIP** _____
 214. **PRINT PHONE** _____
 215. **PRINT DATE** _____
 216. **PRINT SIGNATURE** _____
 217. **PRINT NAME** _____
 218. **PRINT ADDRESS** _____
 219. **PRINT CITY** _____
 220. **PRINT STATE** _____

POINT ARENA TO SACRAMENTO
CABLE ROUTE

DRAWN BY :	MMW	DATE :	08/23/00
CHECKED BY :	MMW	DATE :	08/23/00
APPROVED BY :		DATE :	
APPROVED BY :		DATE :	
APE : 4577		LOC. CODE :	
HORIZONTAL SCALE (HWS & PROF) : 1"=100'			
VERTICAL SCALE (VWS) :			
VERTICAL SCALE (PROF) :			
MAP PROJECTION :			

CIVIL/ENR


CALIFORNIA NORTHERN RAILROAD

FIBER STATIONING

ROAD STATIONING
NAPA COUNTY
CALIFORNIA

SACRAMENTO

POINT ARENA

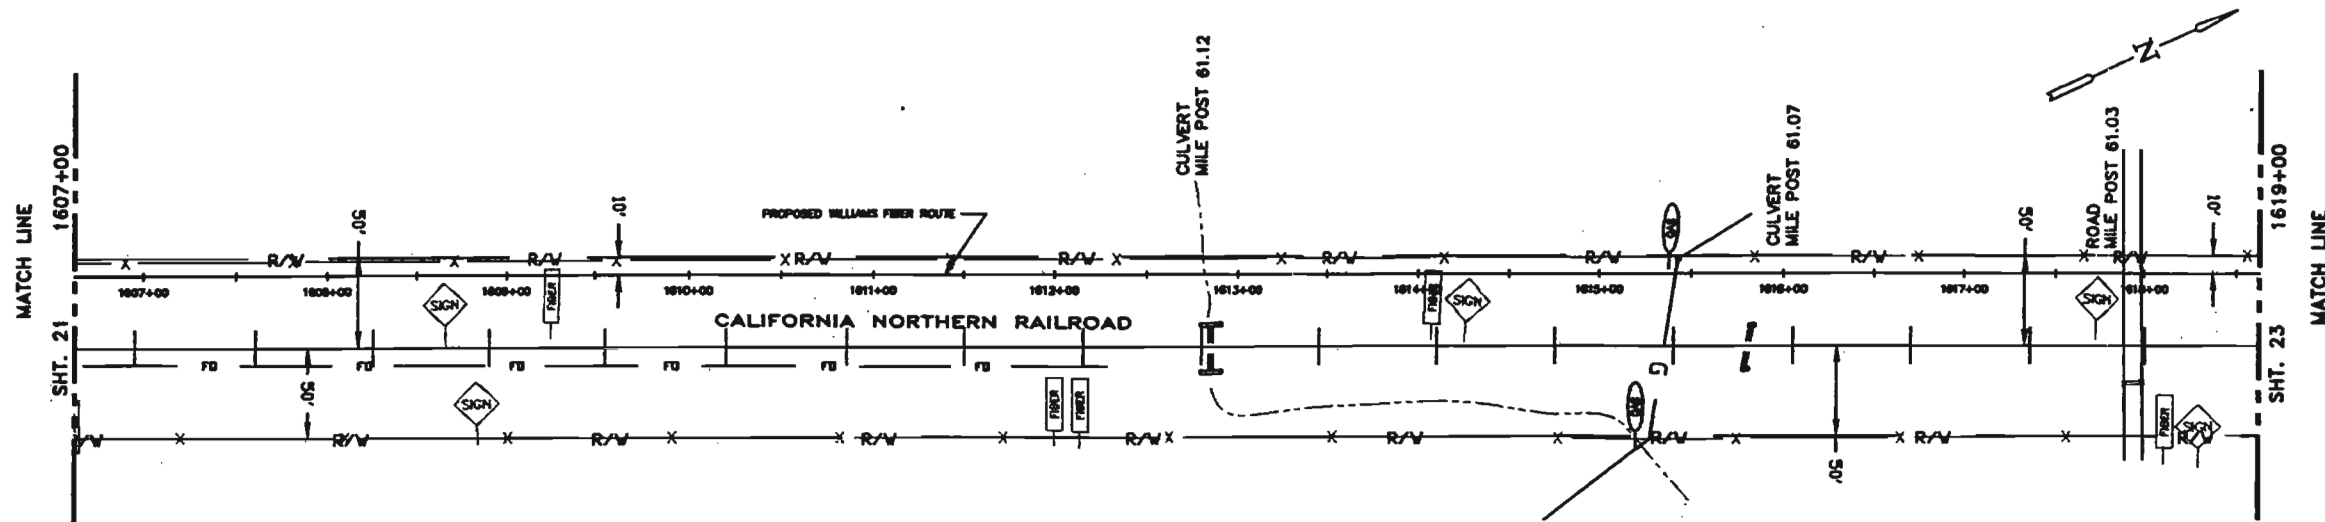

1607+00

1619+00

96 - LEAF FIBER, LOOSE BUFFER TUBE CABLE, 12 FIBERS PER TUBE, DIELECTRIC CENTRAL MEMBER, DUAL JACKET SINGLE ARMOR, 1000 LB TENSILE STRENGTH

REEL # N/A

N/A

1200' 1-1.5" ID HDPE, 1-1.5" ID HDPE (SPARE), 1-1.25" ID HDPE (SPARE)

LEGEND

- Interstate Hwy.
- U.S. Hwy.
- State Hwy.
- County Road
- RR Mile Mar.
- Min. Road Sign
- New Fiber Cable
- Township Line
- City Limits
- R/W Line
- River/Stream
- CL Road
- CL RR Tracks
- CL Pipeline
- Gas Pipeline
- Power Line
- Water Line
- San. Sewer
- Storm Drain
- Telephone Line
- Black Iron Pipe
- Galvanized Iron Pipe
- Edge of Pavement
- Edge of Gravel
- Face of Curb
- Fog Line and/or White Line
- Region Site
- P.O.P./Int.
- Handhole Splice
- Handhole
- Handhole Splice
- Handhole
- SS Handhole
- Water Valve / Meter
- Gas Valve / Meter
- Signal Pole
- Fire Hydrant
- Gas Marker
- Oil Marker
- Fiber Marker
- Water Inlet

WILLIAMS

EMERGENCY NOTIFICATION NUMBER

1-800-582-9089

CAUTION

WILLIAMS LOCATE # FOR
COUNTY, STATE
1-888-945-2255

FOREIGN UTILITY LOCATIONS ARE
APPROXIMATE. CONTACT THE LOCAL ONE
CALL AGENCY 48 HOURS PRIOR
TO CONSTRUCTION FOR EXACT
UTILITY LOCATIONS AT :

1-800-227-2600

DRAWING DISCLAIMER

FACILITY LOCATIONS ARE GENERAL IN NATURE.
WILLIAMS WILL NOT BE HELD ACCOUNTABLE FOR
THE ACCURACY OF THE INFORMATION PROVIDED
ON THESE DRAWINGS.

PRELIMINARY

REVISIONS

REL. NO.	REVISION	BY	DATE

CABLE FIBER COUNT MPD. TYPE OF GLASS	CABLE
CABLE REEL NO.	REVISION
SPICE TO SPICE CABLE LENGTH & COIL LENGTH	
SPICE TO SPICE CABLE LENGTH & COIL LENGTH	
COMMUNICATIONS GROUP
Network Services

POINT ARENA TO SACRAMENTO
CABLE ROUTE

DRAWN BY : NHC	DATE : 08/25/08
DESIGNED BY : MHW	DATE : 08/25/08
APPROVED BY :	DATE :
APPROVED BY :	DATE :
APR : 4577	LOC. CODE :
HORIZONTAL SCALE (HWS & PROF) : 1"=100'	
VERTICAL SCALE (HWS) :	
VERTICAL SCALE (PROF) :	
MAP PROJECTION :	
DRAWING NUMBER : SHEET - 22	

1619+25 53RT. RR MP

1619+84 SORT, FIBER OPTIC

1620+76 6' L.T. FIBER MARKER

FIBER STATIONING

1625+83 6' LT. FIBER MARKER

1626+02 4' L.T. FENCE CORNER

1628+38 85' RT. FENCE CORNER

1626+30 63' RT. FENCE CORNER
1626+43 11' RT. FENCE CORNER

1628+69 14' L. CL. CREEK
1628+73 69' RT. FENCE CORNER

1628+73 69 RT. FENCE CORNER

1627+00	20'RT. CULVERT
1627+01	50'RT. CULVERT
1627+02	50'RT. CULVERT

1627+10 75 RT. CL CREEK
1627+25 52 RT. FIBER MARKER

1627+45 15 RT. FENCE CORNER

1627+46	16 RT. FENCE CORNER
1627+53	60 RT. FENCE CORNER
1627+64	90 RT. POWER POLE

1627+64 80 KI. POWER POLE
1627+74 6' LT. FENCE CORNER

1628+10 7' LT. FIBER MARKER

01407241 / 17 FEB 1974

1628+18 7' LT. FIBER MARKER


1628447 87RT. FENCE CORNER

1630+34 88'RT, POWER POLE

← POINT ARENA

ROAD STATIONING
NAPA COUNTY
CALIFORNIA

SACRAMENTO

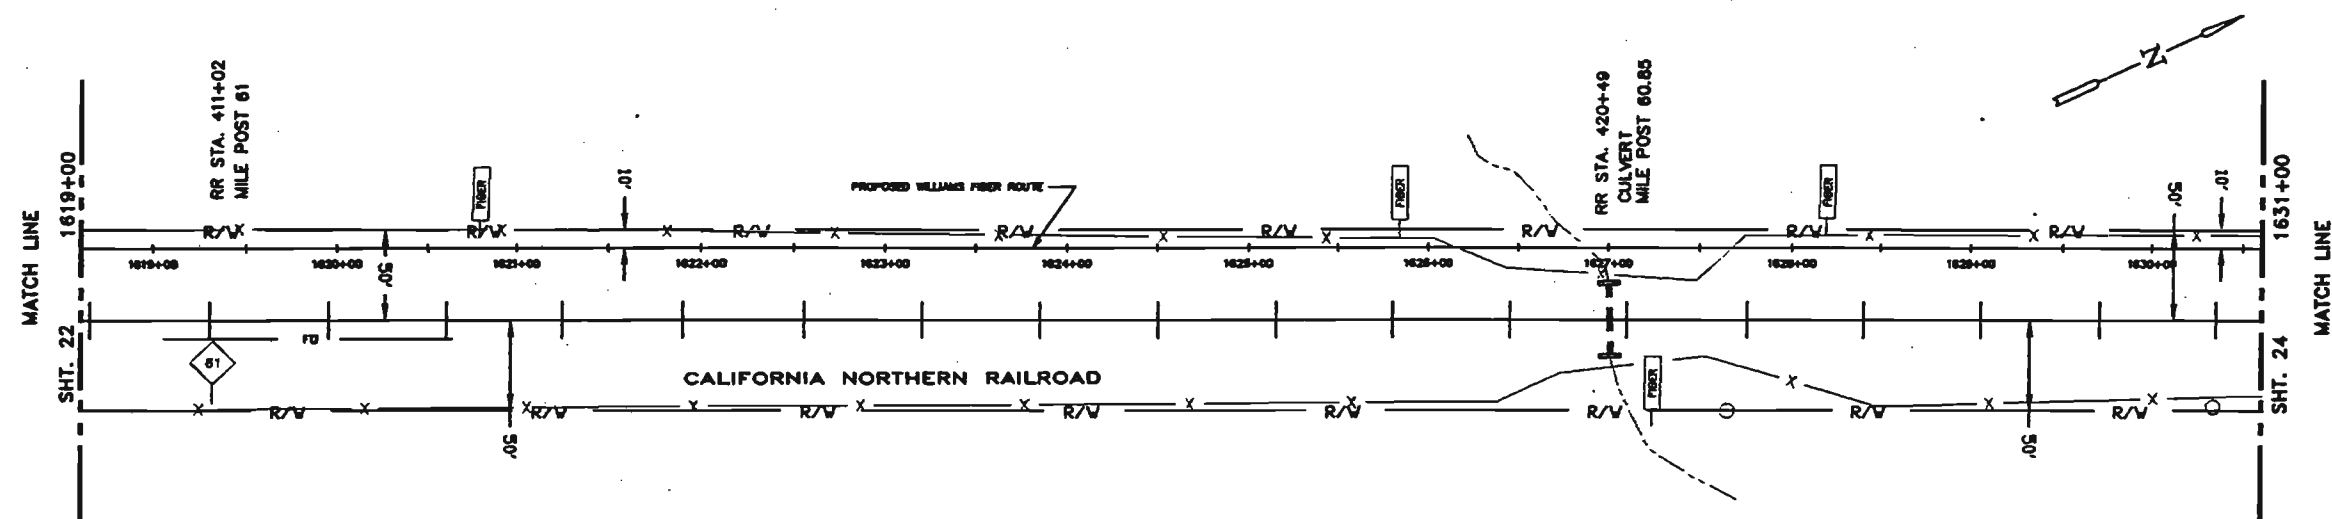

1619+00

1631+00

96 - LEAF FIBER, LOOSE BUFFER TUBE CABLE, 12 FIBERS PER TUBE, DIELECTRIC CENTRAL MEMBER, DUAL JACKET SINGLE ARMOR, 1000 LB TENSILE STRENGTH

REEL N/A

N/A
1200' 1-1.5" ID HDPE, 1-1.5" ID HDPE (SPARE), 1-1.25" ID HDPE (SPARE)

LEGEND

- ### LEGEND
- | | | | |
|--|----------------------------|--|---------------------|
| | Interstate Hwy. | | Rugby Sho. |
| | U.S. Hwy. | | P.O.P./Int. |
| | State Hwy. | | Handshake Spline |
| | County Road | | Handshake |
| | RR Mile Mkr. | | Handshake Spline |
| | Mile. Road Sign | | Handshake |
| | New Fiber Cable | | SS Interlock |
| | Telephone Line | | Power Pole |
| | City Limits | | Water Valve / Meter |
| | R/W Line | | Gas Valve / Meter |
| | River/Stream | | Signal Pole |
| | CL Road | | Fire Hydrant |
| | CL RR Tracks | | Gas Marker |
| | Fence | | Oil Marker |
| | Oil Pipeline | | Fiber Marker |
| | Gas Pipeline | | Water Inlet |
| | Power Line | | |
| | Water Line | | |
| | San. Sewer | | |
| | Storm Drain | | |
| | Telephone Line | | |
| | Metal Iron Pipe | | |
| | Columbized Iron Pipe | | |
| | Edge of Pavement | | |
| | Edge of Gravel | | |
| | Edge of Curb | | |
| | Fog Line and/or White Line | | |

WILLIAMS

EMERGENCY NOTIFICATION NUMBER
1-800-582-8069

CAUTION

**WILLIAMS LOCATE # FOR
COUNTY, STATE
1-888-845-2255**

**FOREIGN UTILITY LOCATIONS ARE
APPROXIMATE. CONTACT THE LOCAL ONE
CALL AGENCY 48 HOURS PRIOR
TO CONSTRUCTION FOR EXACT
UTILITY LOCATIONS AT :
1-800-227-2600**

DRAWING DISCLAIMER

FACILITY LOCATIONS ARE GENERAL IN NATURE
WILLIAMS WILL NOT BE HELD ACCOUNTABLE FOR
THE ACCURACY OF THE INFORMATION PROVIDED
ON THESE DRAWINGS.

PRELIMINARY

[illegible]


CABLE FIBER COUNT MFL TYPE OF GLASS	CABLE SECTION FROM
CABLE REEL NO.	
SPLICE TO SPLICE CABLE LENGTH & COIL, LENGTH	PIPE & INSULANT PLACEMENT
INSULANT & TYPE (COIL/SHADOW/COLOR)	
STEEL PIPE SIZE	
PVC	
FUTURE-2	FUTURE OVER PLACE
FUTURE-5	
FUTURE-4	



COMMUNITY GROUP
Network Garden

**POINT ARENA TO SACRAMENTO
CABLE ROUTE**

DESIGNED BY :	MHC	DATE :	08/25/00
CHECKED BY :	MHW	DATE :	08/25/00
APPROVED BY :		DATE :	
APPROVED BY :		DATE :	
NTE :	4877	LOC. CODE :	
HORIZONTAL SCALE (DWS & PROF) : 1"=100'			
VERTICAL SCALE (DWS) :			
VERTICAL SCALE (PROF) :			
MAP PROJECTION :			
DRAWING NUMBER : SHEET - 23			

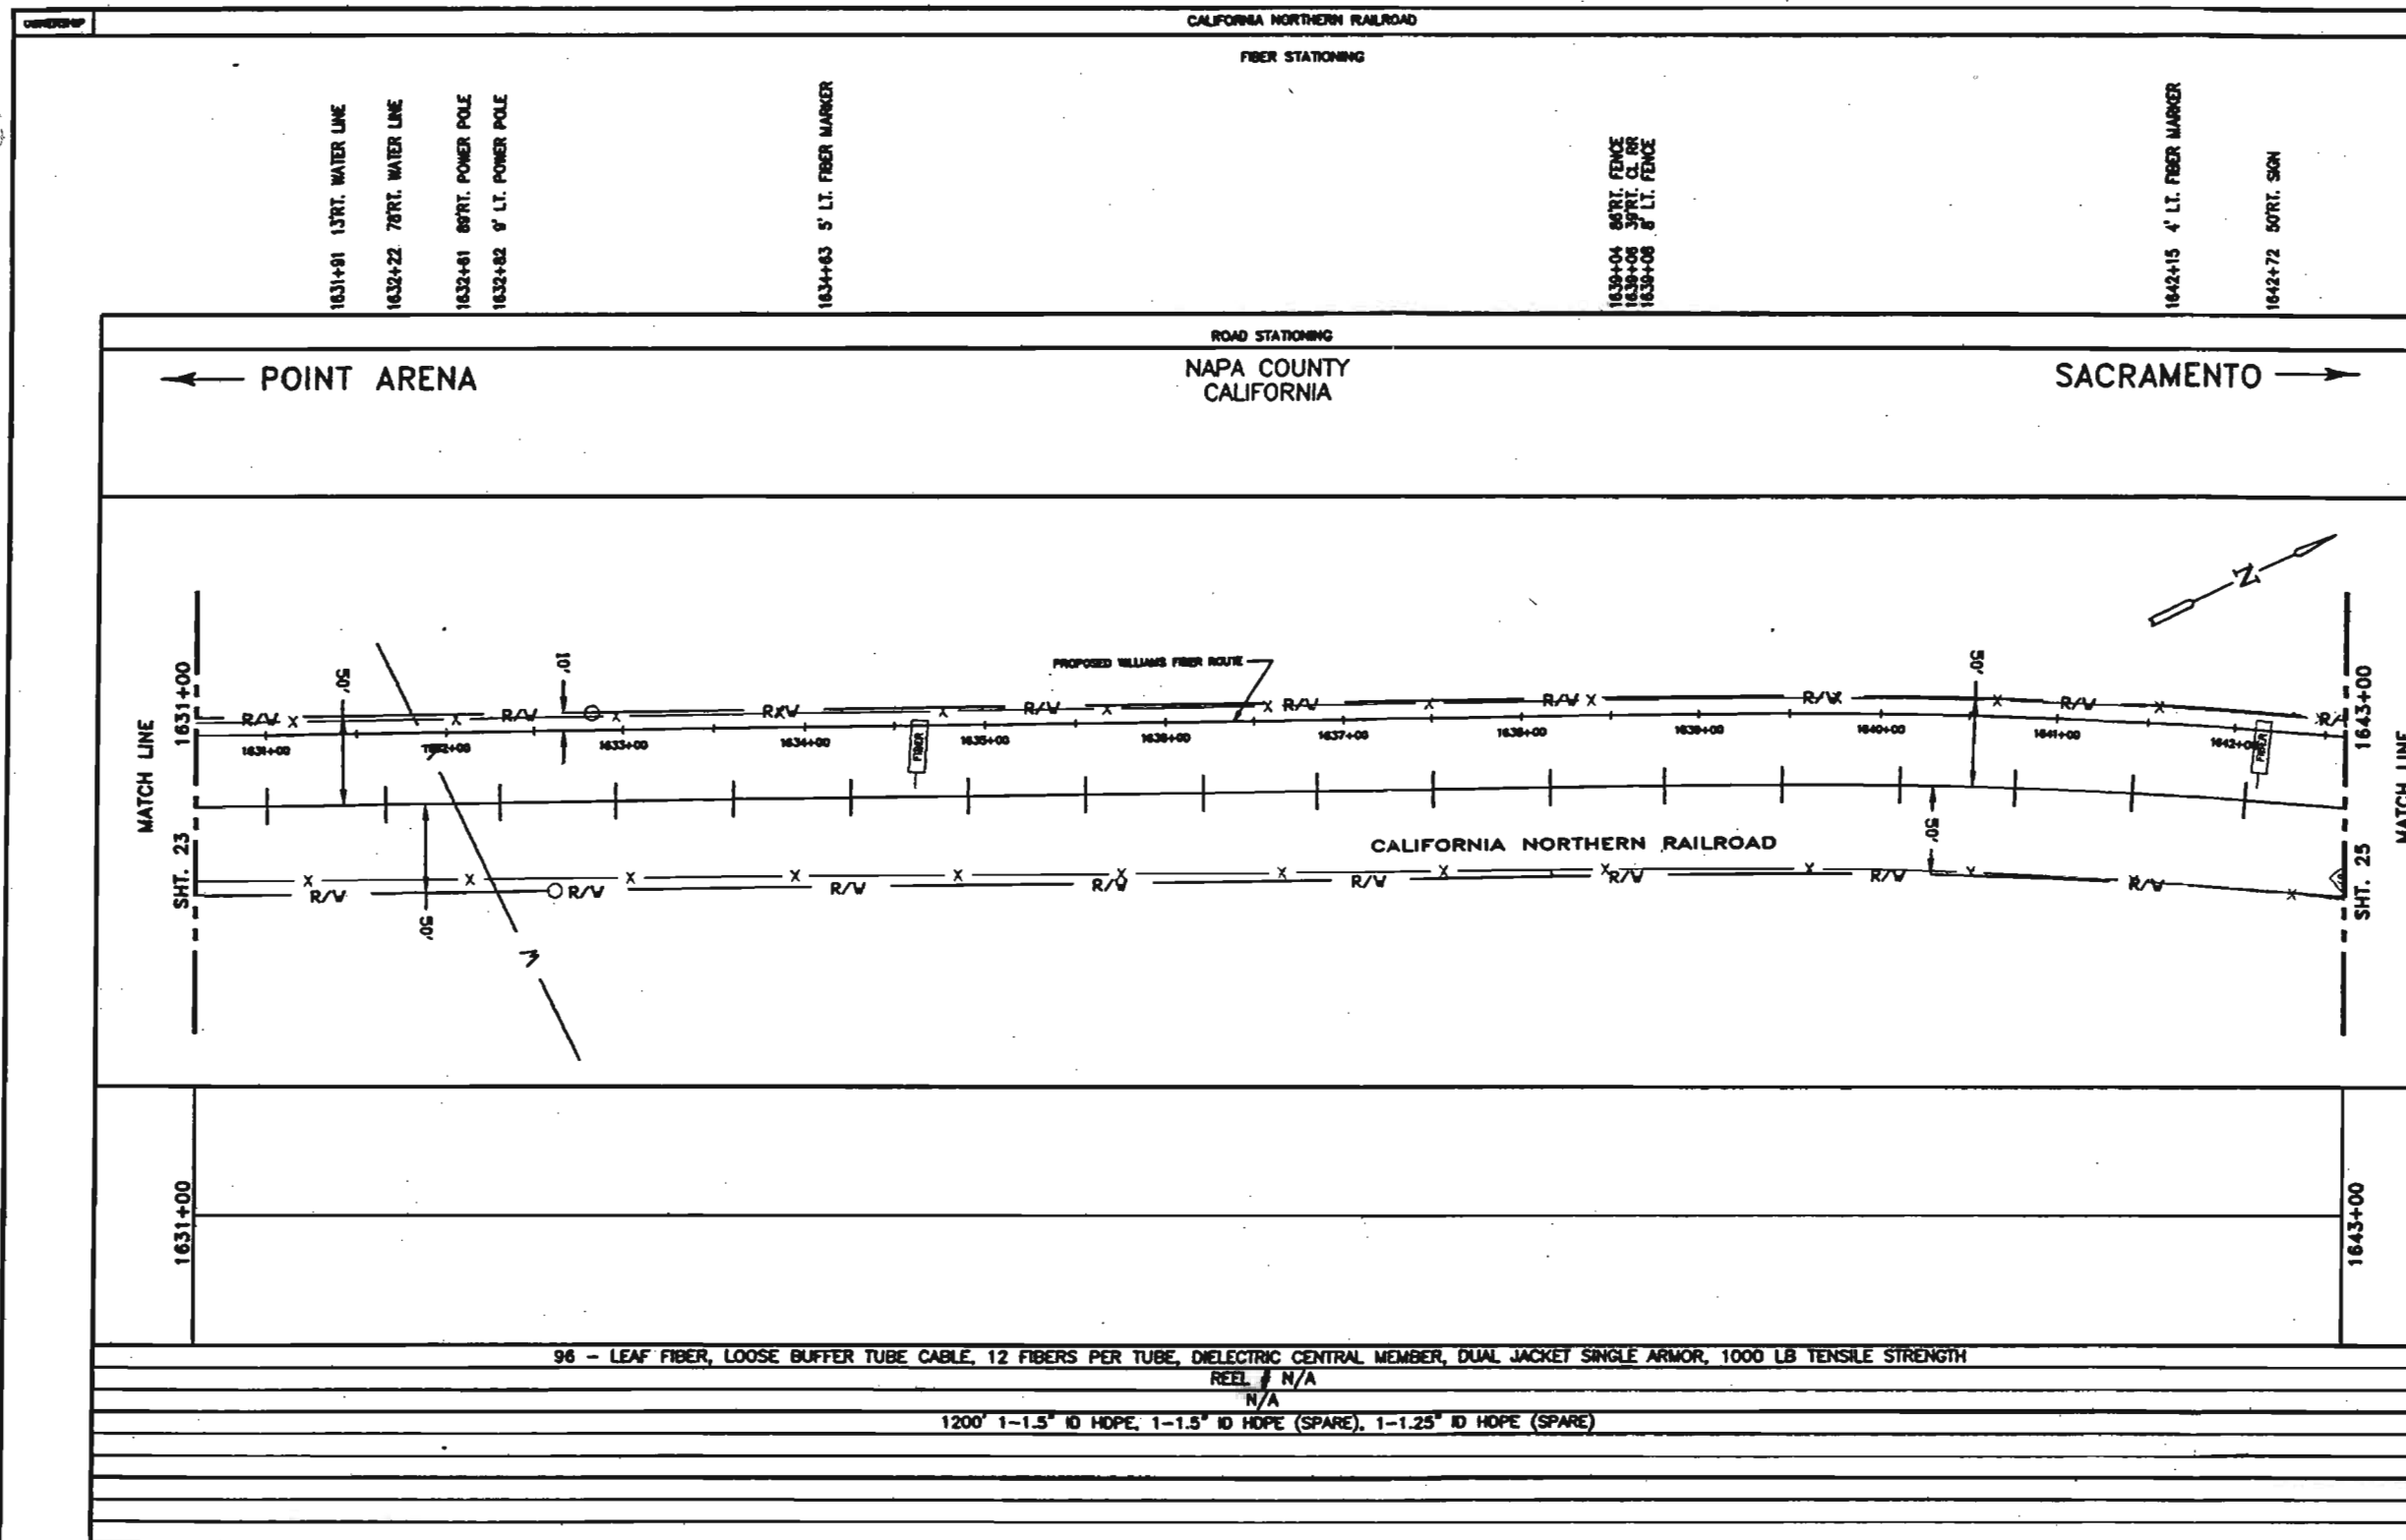

LEGEND

- Interstate Hwy. - U.S. Hwy. - State Hwy. - County Road - RT Mile Marker - Min. Road Sign - New Fiber Cable - Tramway Line - City Limits - R/W Line - River/Stream - CL Road - CL RT Truck - Fence - Oil Pipeline - Gas Pipeline - Power Line - Water Line - San. Sewer - Storm Drain - Telephone Line - B.L.P. - C.L.P. - EP - EG - PC - FL	- Region Site - P.O.P./Jct. - Handhole Splice - Handhole - Manhole Splice - Manhole 35 Manhole - Power Pole - Water Valve / Meter - Gas Valve / Meter - Signal Pole - Pole Hydrant - Gas Marker - Oil Marker - Fiber Marker - Water Inlet
---	--

WILLIAMS
 EMERGENCY NOTIFICATION NUMBER
 1-800-582-9099

CAUTION
 WILLIAMS LOCATE # FOR
 COUNTY, STATE
 1-888-945-2255
 FOREIGN UTILITY LOCATIONS ARE
 APPROXIMATE. CONTACT THE LOCAL ONE
 CALL AGENCY 48 HOURS PRIOR
 TO CONSTRUCTION FOR EXACT
 UTILITY LOCATIONS AT :
 1-800-227-2600

DRAWING DISCLAIMER
 FACILITY LOCATIONS ARE GENERAL IN NATURE
 WILLIAMS WILL NOT BE HELD ACCOUNTABLE FOR
 THE ACCURACY OF THE INFORMATION PROVIDED
 ON THESE DRAWINGS.

PRELIMINARY

REVISIONS

REV. NO.	DESCRIPTION	BY	DATE

CABLE FIBER COUNT MFG. TYPE OF GLASS	CABLE DESCRIPTION
CABLE REEL NO.	
SPICE TO SPICE CABLE LENGTH & COIL LENGTH	
BURNDUCT & TYPE (CORR./SMOOTH/COLOR)	
STEEL PIPE SIZE	PIPE & BURNDUCT PLACEMENT
PVC	
FUTURE-2	FUTURE SHEET PLACE
FUTURE-3	
FUTURE-4	

COMMUNICATIONS GROUP
 Robert Suriano

**POINT ARENA TO SACRAMENTO
 CABLE ROUTE**

DRAWN BY : MNC	DATE : 08/25/00
CHECKED BY : MNC	DATE : 08/25/00
APPROVED BY :	DATE :
APPROVED BY :	DATE :

AFE : 4877 LOC. CODE :

HORIZONTAL SCALE (HWS & HSB) : 1"=100'


VERTICAL SCALE (VWS) :

VERTICAL SCALE (VSB) :

MAP PROJECTION :

DRAWING NUMBER : SHEET - 24

96 - LEAF FIBER, LOOSE BUFFER TUBE CABLE, 12 FIBERS PER TUBE, DIELECTRIC CENTRAL MEMBER, DUAL JACKET SINGLE ARMOR, 1000 LB TENSILE STRENGTH
REEL # N/A
N/A
1200' 1-1.5" ID HOPE, 1-1.5" ID HOPE (SPARE), 1-1.25" ID HOPE (SPARE)

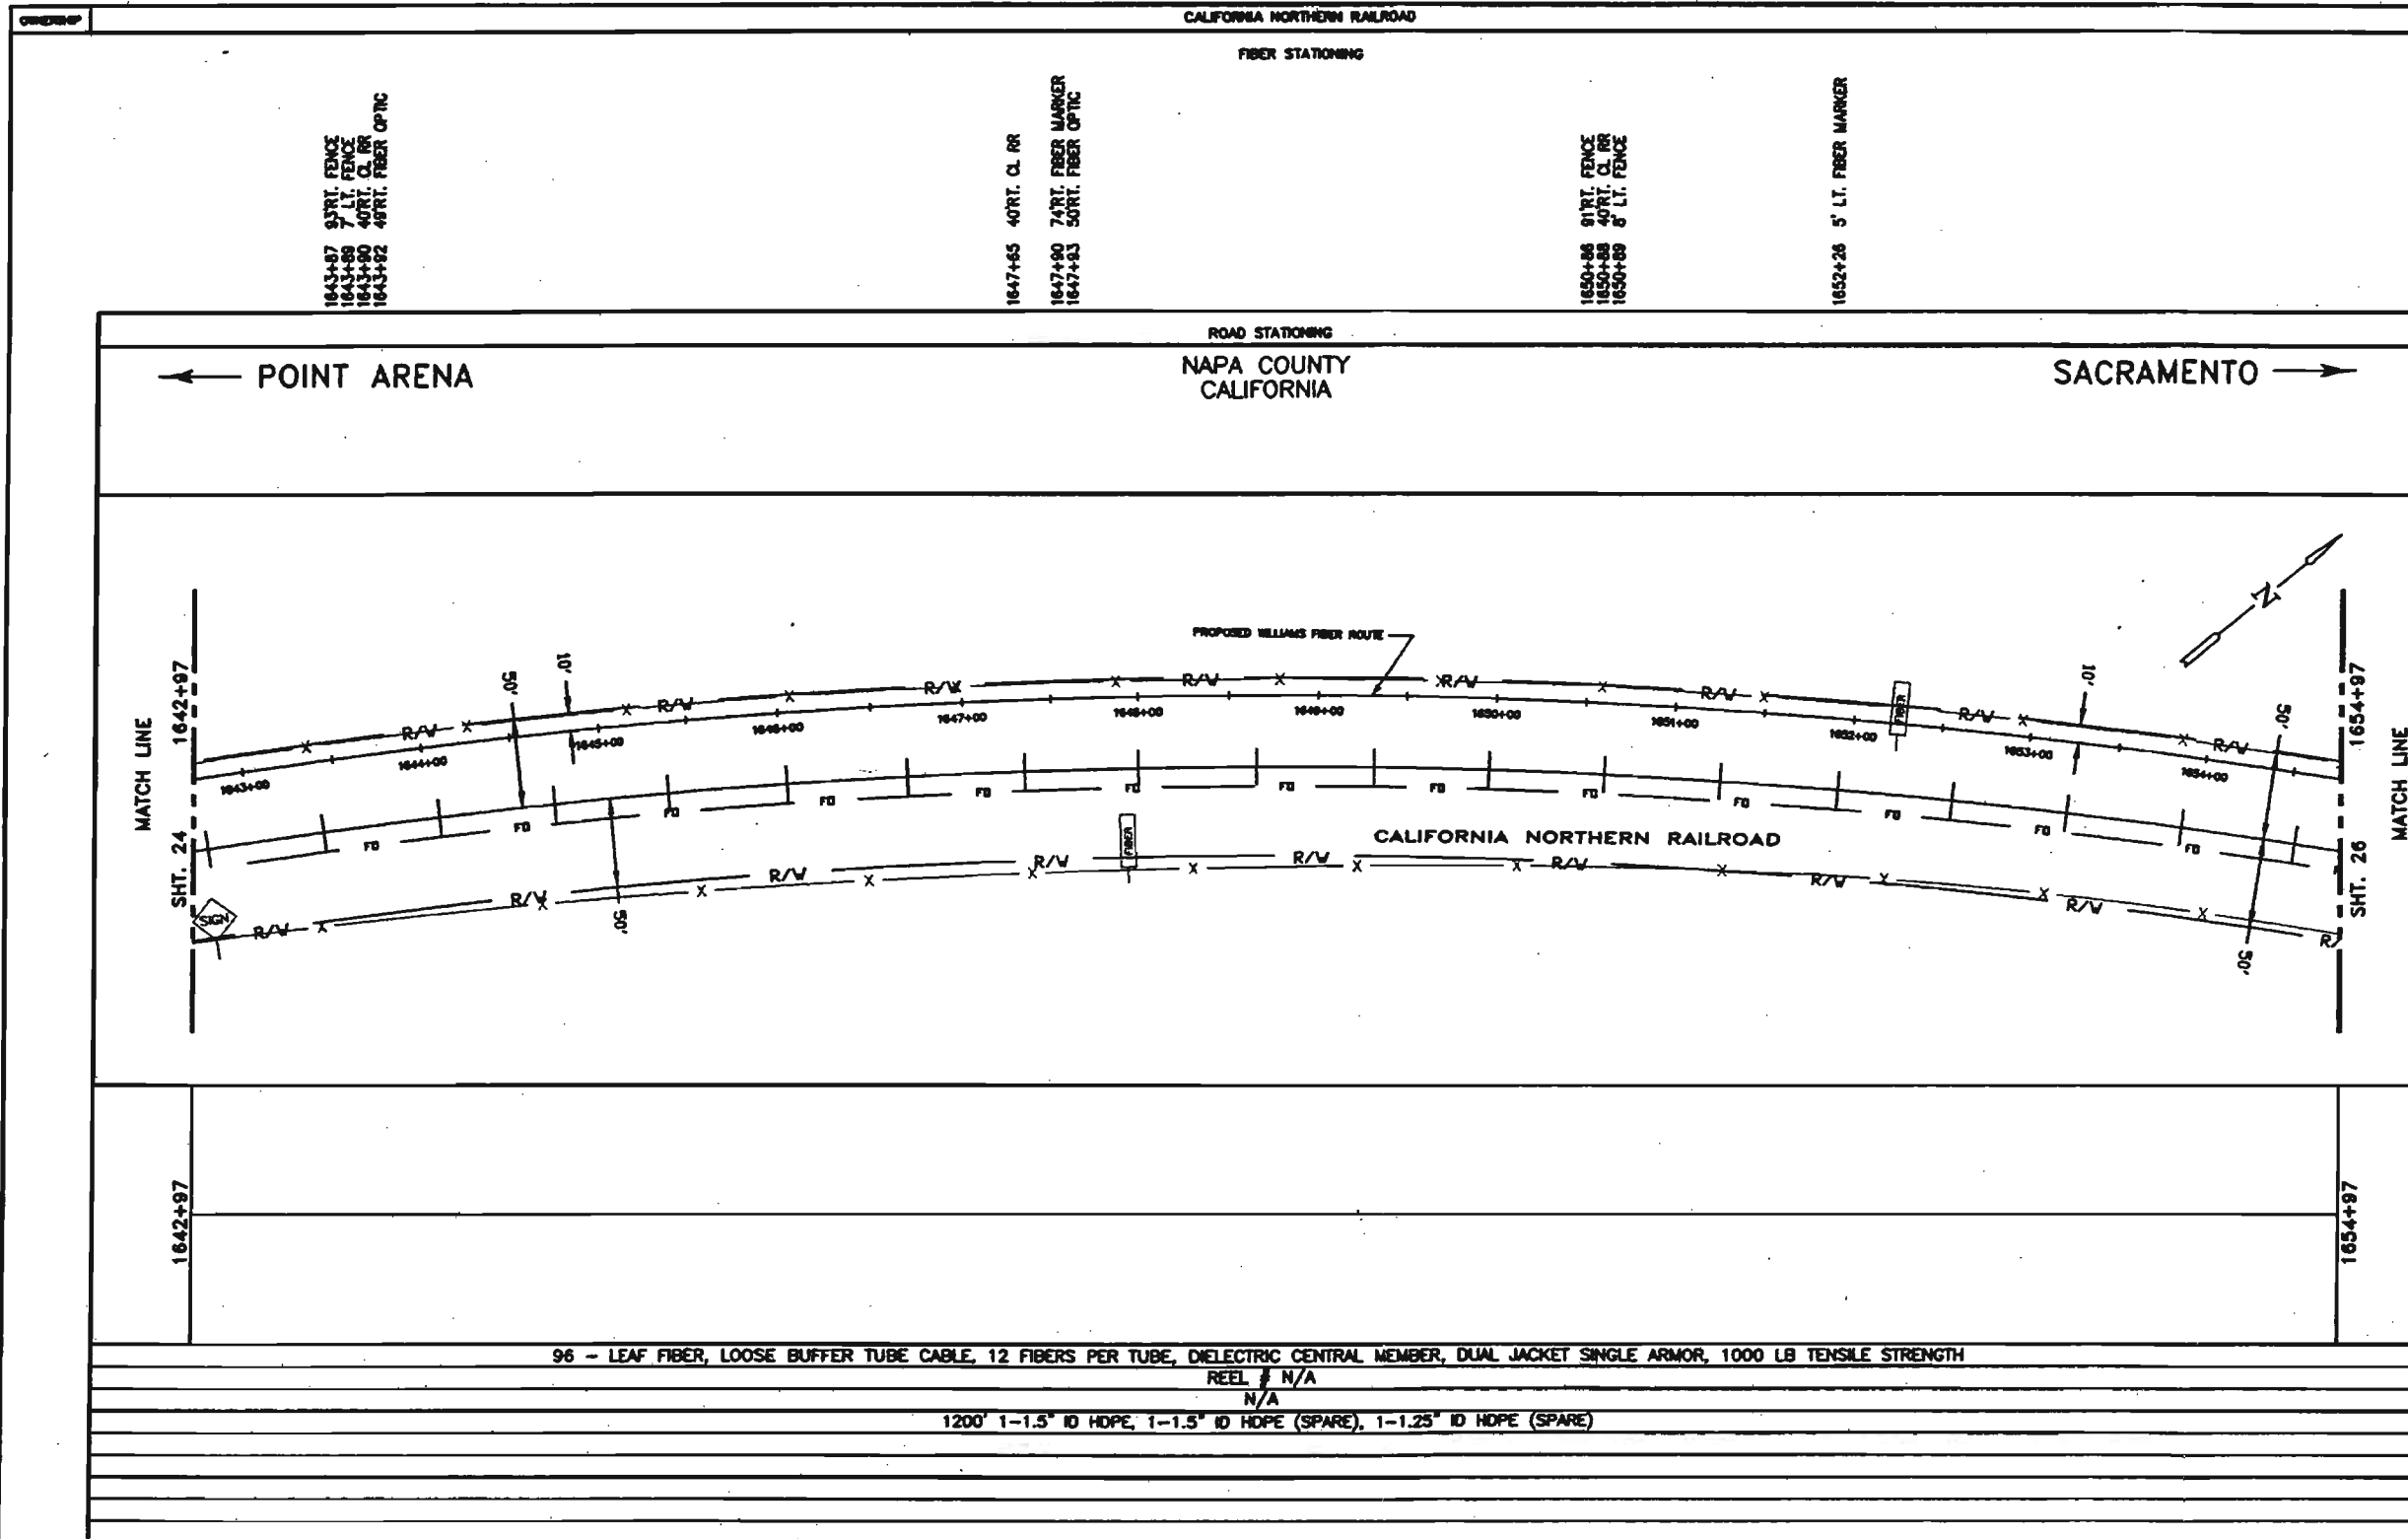

LEGEND	
	Interstate Hwy.
	U.S. Hwy.
	State Hwy.
	County Road
	RR Mile Mkr.
	Mile. Road Sign
	New Fiber Cable
	Township Line
	City Limits
	R/W Line
	Water/Stream
	CL Road
	CL RR Tracks
	Fence
	Oil Pipeline
	Gas Pipeline
	Power Line
	Water Line
	San. Sewer
	Storm Drain
	Telephone Line
	Black Iron Pipe
	Galvanized Iron Pipe
	Edge of Pavement
	Edge of Gravel
	Face of Curb
	Fog Line and/or White Line
	Region Site
	P.A.P./Jct.
	Handhole Splice
	Markhole Splice
	Markhole
	25 Markhole
	Power Pole
	Water Valve / Meter
	Gas Valve / Meter
	Signal Pole
	Fire Hydrant
	Gas Marker
	Oil Marker
	Fiber Marker
	Water Jet

WILLIAMS

EMERGENCY NOTIFICATION NUMBER

1-800-582-8089

CAUTION

WILLIAMS LOCATE # FOR COUNTY, STATE 1-888-945-2255.

FOREIGN UTILITY LOCATIONS ARE APPROXIMATE. CONTACT THE LOCAL ONE CALL AGENCY 48 HOURS PRIOR TO CONSTRUCTION FOR EXACT UTILITY LOCATIONS AT : 1-800-227-2600

DRAWING DISCLAIMER

FACILITY LOCATIONS ARE GENERAL IN NATURE WILLIAMS WILL NOT BE HELD ACCOUNTABLE FOR THE ACCURACY OF THE INFORMATION PROVIDED ON THESE DRAWINGS.

PRELIMINARY

REVISIONS			
REV. NO.	DESCRIPTION	BY	DATE

CABLE FIBER COUNT MFL TYPE OF GLASS	CABLE
CABLE REEL NO.	DESCRIPTION
SPLICE TO SPLICE CABLE LENGTH & COIL LENGTH	
CONDUIT & TYPE (COND/3000W/COLOR)	PIPE
SHIELD PIPE SIZE	WARRANTY
PVC	PLACEMENT
FOURTE-2	FOURTE
FOURTE-3	WST
FOURTE-4	PLACE

COMMUNICATION GROUP
Submittal Services

POINT ARENA TO SACRAMENTO CABLE ROUTE

DESIGN BY : HNC DATE : 08/28/00
CHECKED BY : MHW DATE : 08/29/00
APPROVED BY : DATE :
APPROVED BY : DATE :

REV : 4877 LOC. CODE :

HORIZONTAL SCALE (SHEET & PROF) : 1"=100'
VERTICAL SCALE (SHEET) :
VERTICAL SCALE (PROF) :
MAP PROJECTION :

DRAWING NUMBER : SHEET - 25

16554-32	49" L. I.	CL. RR.
16554-33	27" R. I.	SIGN
16554-41	60" R. I.	FENCE CORNER
16554-43	7" L. I.	CL. RR.
16554-46	50" R. I.	CL. RR.
16554-50	69" R. I.	CL. RR.
16554-56	51" R. I.	SIGN
16554-62	49" R. I.	FIBER OPTIC
16554-80	3" L. I.	FIBER MARKER
16554-80	85" R. I.	FIBER MARKER
16554-80	69" R. I.	FENCE CORNER

1657+55 5' LT. FENCE

1658403 26'RT. O/H POWER

1658+48 57RT. 0/M POWER

1650+00	16"RT. CULVERT
1650+00	60"RT. CULVERT
1650+01	4' RT. CL. CREEK
1650+24	53"RT. FIBER MANHOLE

1650+50 SORT. FIBER OPTIC


1664-17 51'BT FREEZ CONT

665+60	57RT. FIBER MARKER
665+85	57RT. FIBER MARKER
665+67	89RT. FENCE
665+70	6' LT. FENCE

ROAD STATIONING
NAPA COUNTY
CALIFORNIA

POINT ARENA

SACRAMENTO

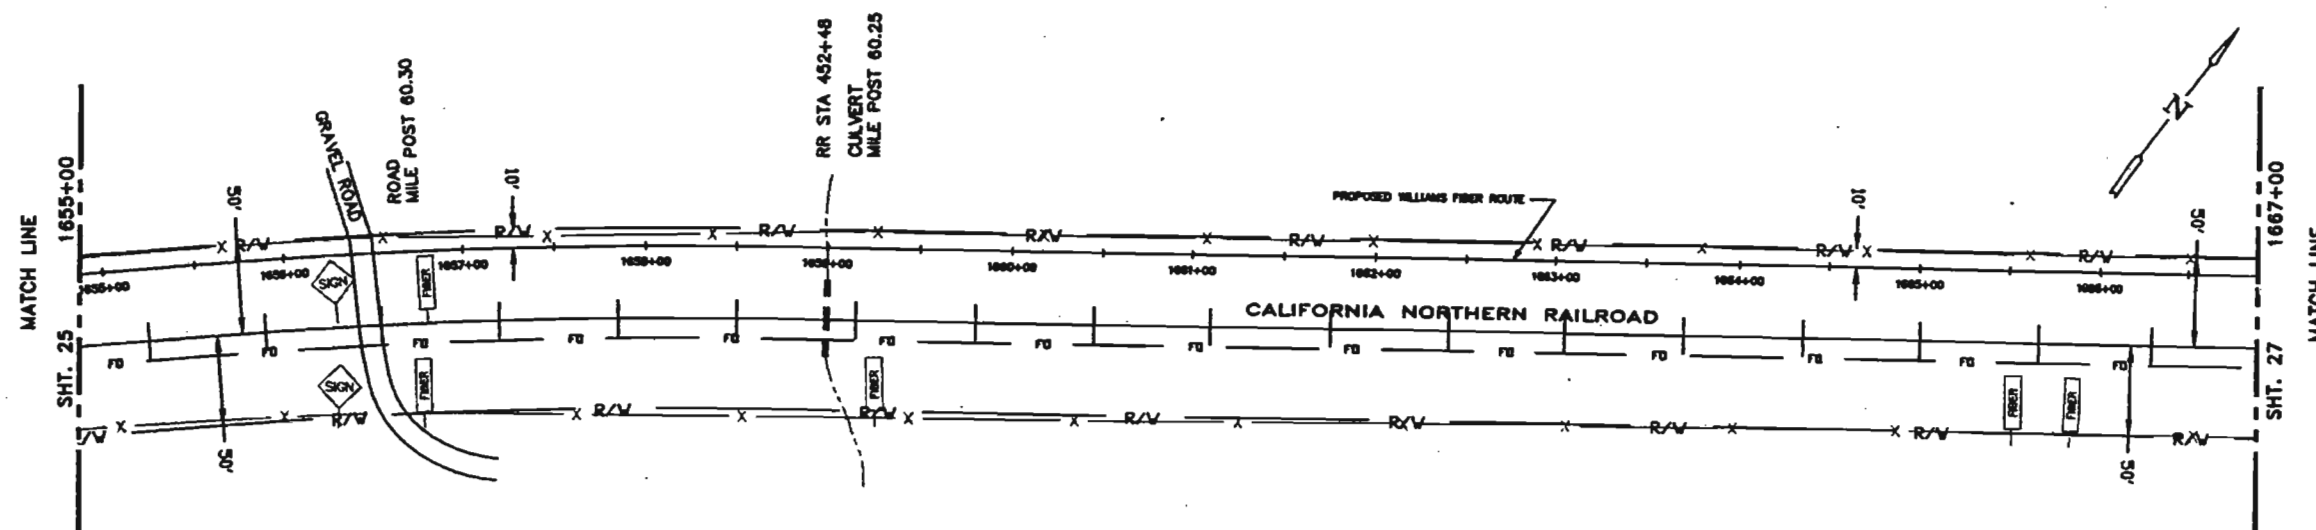

1655+00

1687+00

96 - LEAF FIBER, LOOSE BUFFER TUBE CABLE, 12 FIBERS PER TUBE, DIELECTRIC CENTRAL MEMBER, DUAL JACKET SINGLE ARMOR, 1000 LB TENSILE STRENGTH

REEL	N/A
N/A	

1200' 1-1.5" ID HDPE, 1-1.5" ID HDPE (SPARE), 1-1.25" ID HDPE (SPARE)

Legend	
	Interstate Hwy.
	U.S. Hwy.
	State Hwy.
	County Road
	MI Mile Mkr.
	Mile Road Sign
	Hot Fiber Cable
	Telephone Line
	City Limits
	R/W Line
	River/Stream
	CL Road
	CL RR Tracks
	Fence
	Oil Pipeline
	Gas Pipeline
	Power Line
	Water Line
	Sun. Sewer
	Storm Drain
	Telephone Line
	Black Iron Pipe
	Galvanized Iron Pipe
	Edge of Pavement
	Edge of Ground
	Edge of Curve
	Fog Line and/or Wall Line
	Runway Site
	P.D.P./Int.
	Handhole Spigot
	Handhole
	Handhole Spigot
	Handhole
	Handhole
	Power Pole
	Water Valve / Meter
	Gas Valve / Meter
	Signal Pole
	Fire Hydrant
	Gas Marker
	Oil Marker
	Fiber Marker
	Water Inlet

WILLIAMS

EMERGENCY NOTIFICATION NUMBER
1-800-582-9068

CAUTION

WILLIAMS LOCATE # FOR
COUNTY, STATE
1-888-945-2255

FOREIGN UTILITY LOCATIONS ARE APPROXIMATE. CONTACT THE LOCAL ONE CALL AGENCY 48 HOURS PRIOR TO CONSTRUCTION FOR EXACT UTILITY LOCATIONS AT :
1-800-227-2600

DRAWING DISCLAIMER

FACILITY LOCATIONS ARE GENERAL IN NATURE
WILLIAMS WILL NOT BE HELD ACCOUNTABLE FOR
THE ACCURACY OF THE INFORMATION PROVIDED
ON THESE DRAWINGS.

PRELIMINARY

[illegible]

CABLE FIBER COUNT MFL TYPE OF GLASS	CABLE
CABLE SERIAL NO.	RECORD
SPACE TO INFLUENCE CABLE LENGTH & COIL LENGTH	
INDUCT & TYPE (CABLE/THROW/COIL)	PIPE &
STEEL PIPE SIZE	RECORD
PVC	
PIPELINE-2	
PIPELINE-3	PIPELINE-3
PIPELINE-4	PIPELINE-4





COMMUNICATIONS GROUP
Market Services

POINT ARENA TO SACRAMENTO
CABLE ROUTE

DRAWN BY : MNC	DATE : 08/23/00
CHECKED BY : MFW	DATE : 08/23/00
APPROVED BY :	DATE :
APPROVED BY :	DATE :

NTC : 4877 LOC. CODE :
 HORIZONTAL SCALE (DWG & PROF) : 1"=100'
 VERTICAL SCALE (DWG) :
 VERTICAL SCALE (PROF) :
 MAP PROJECTION :

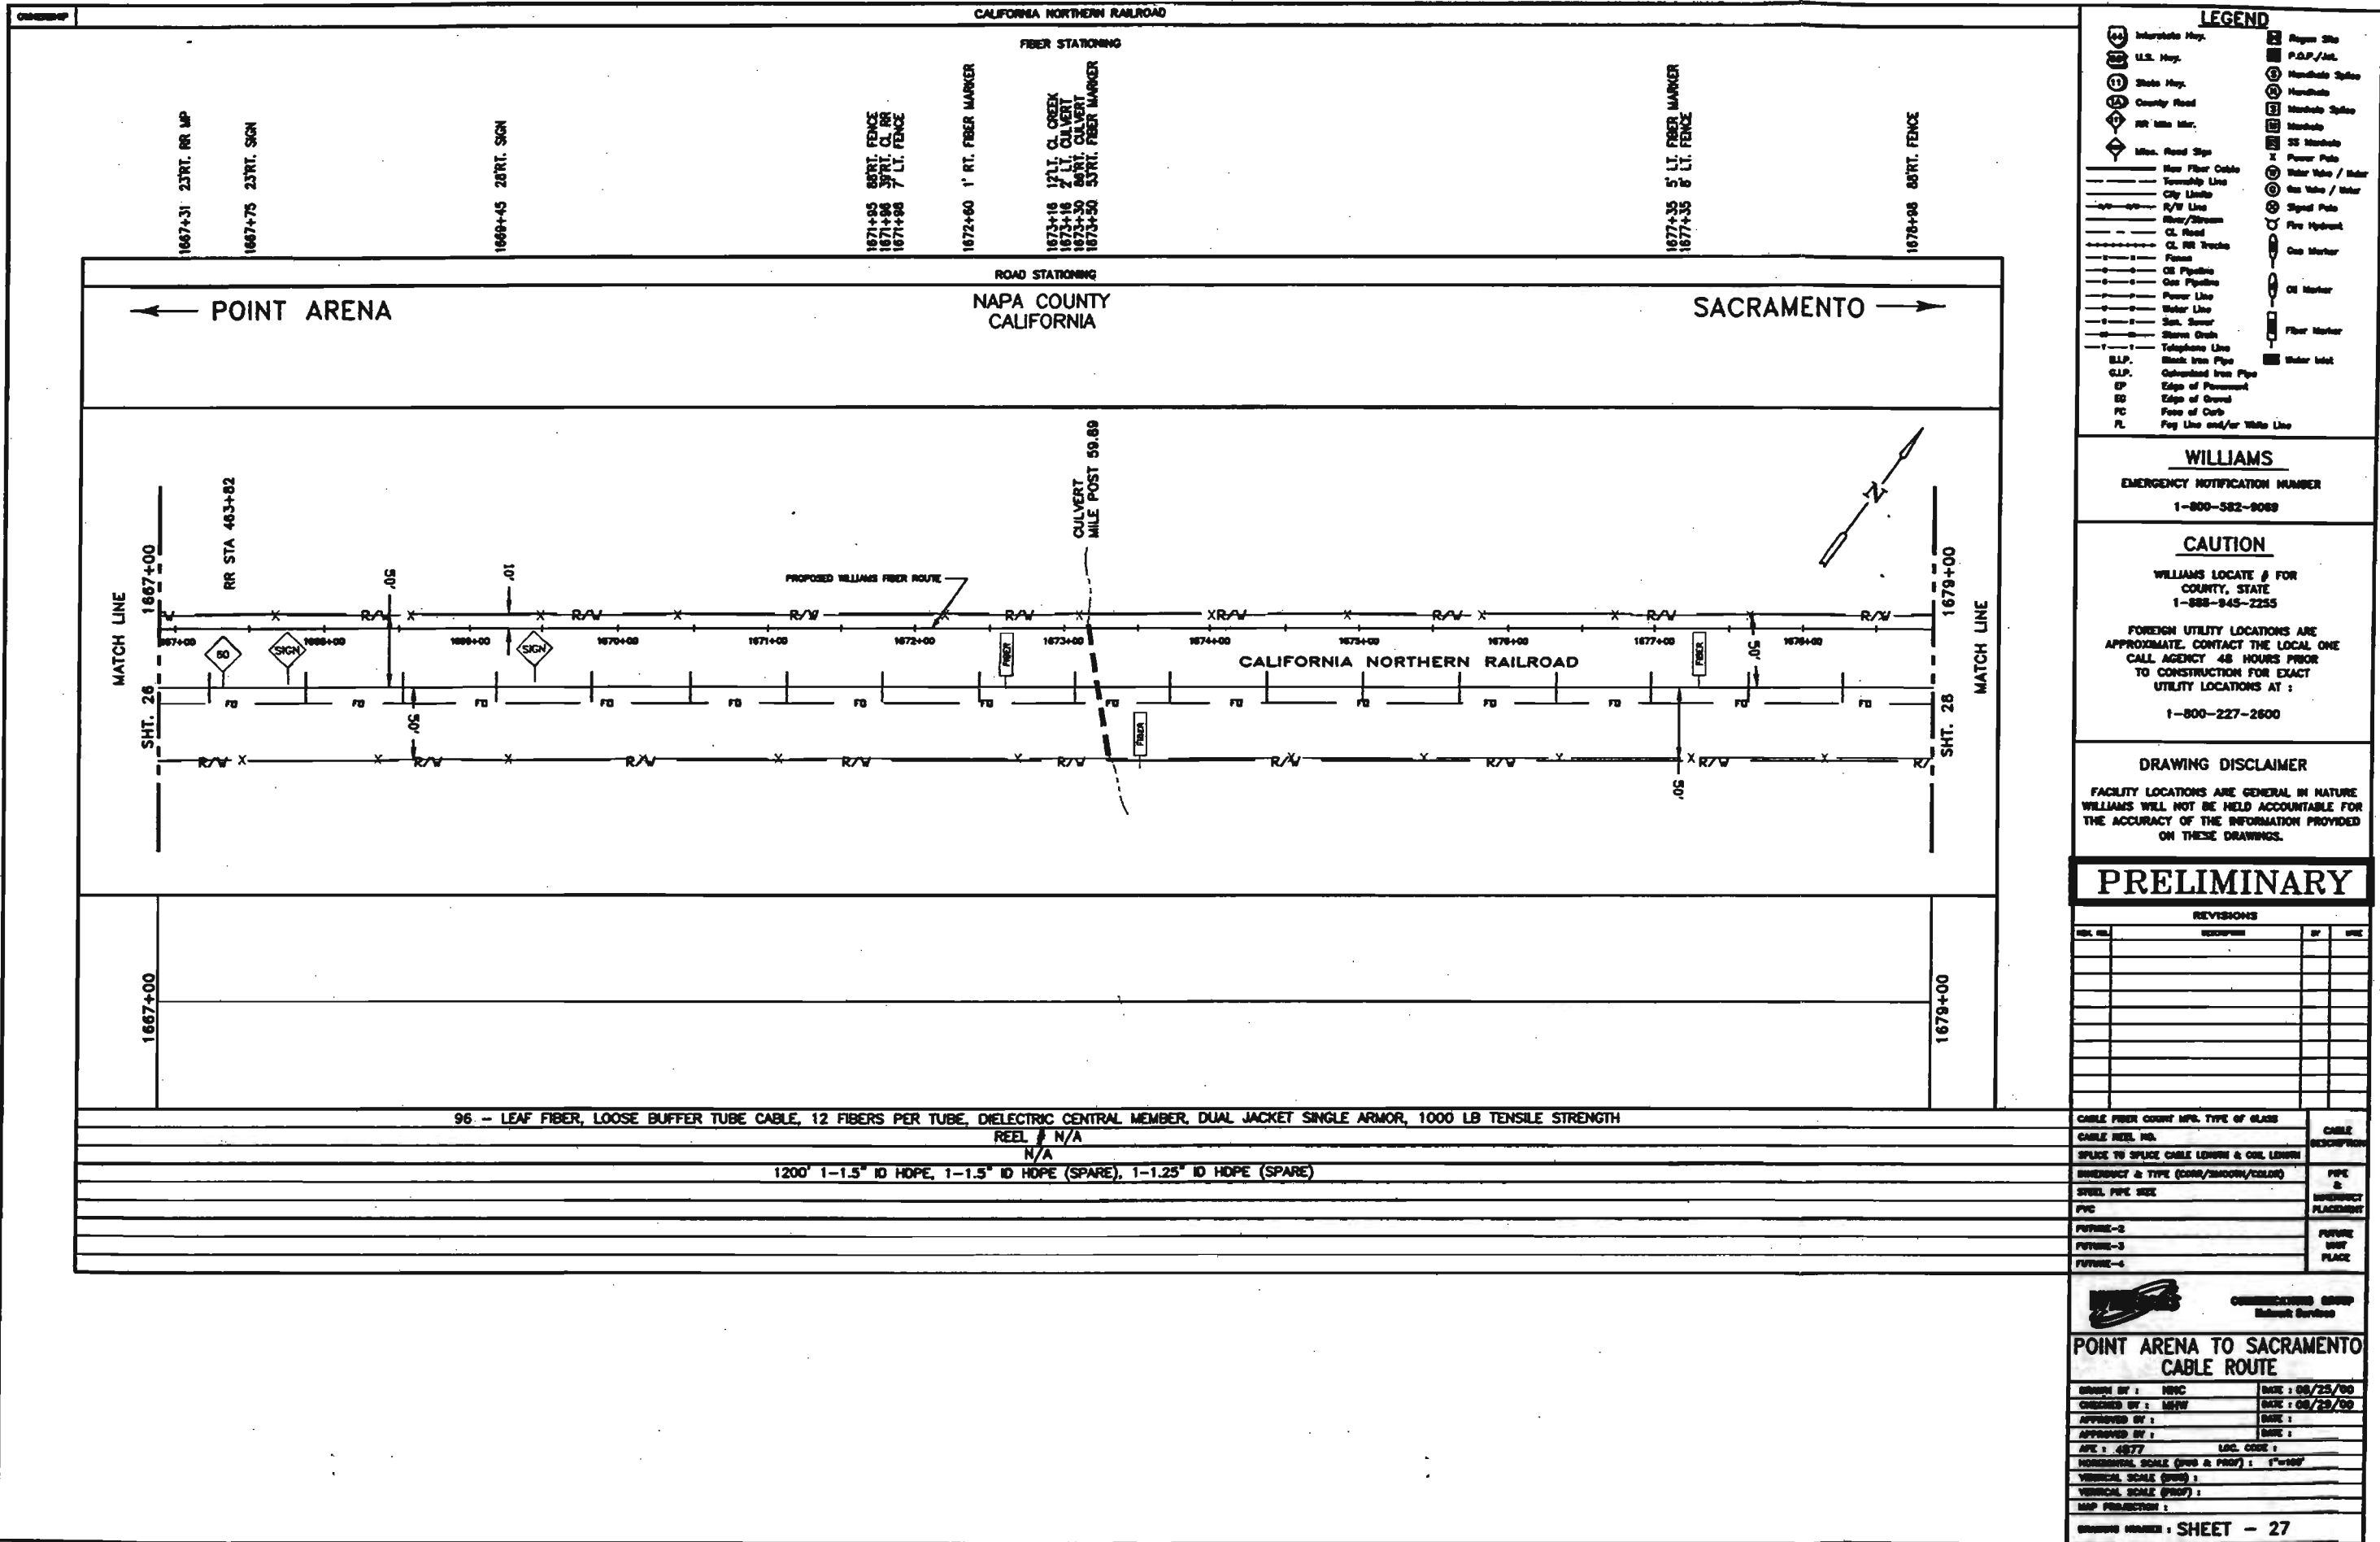

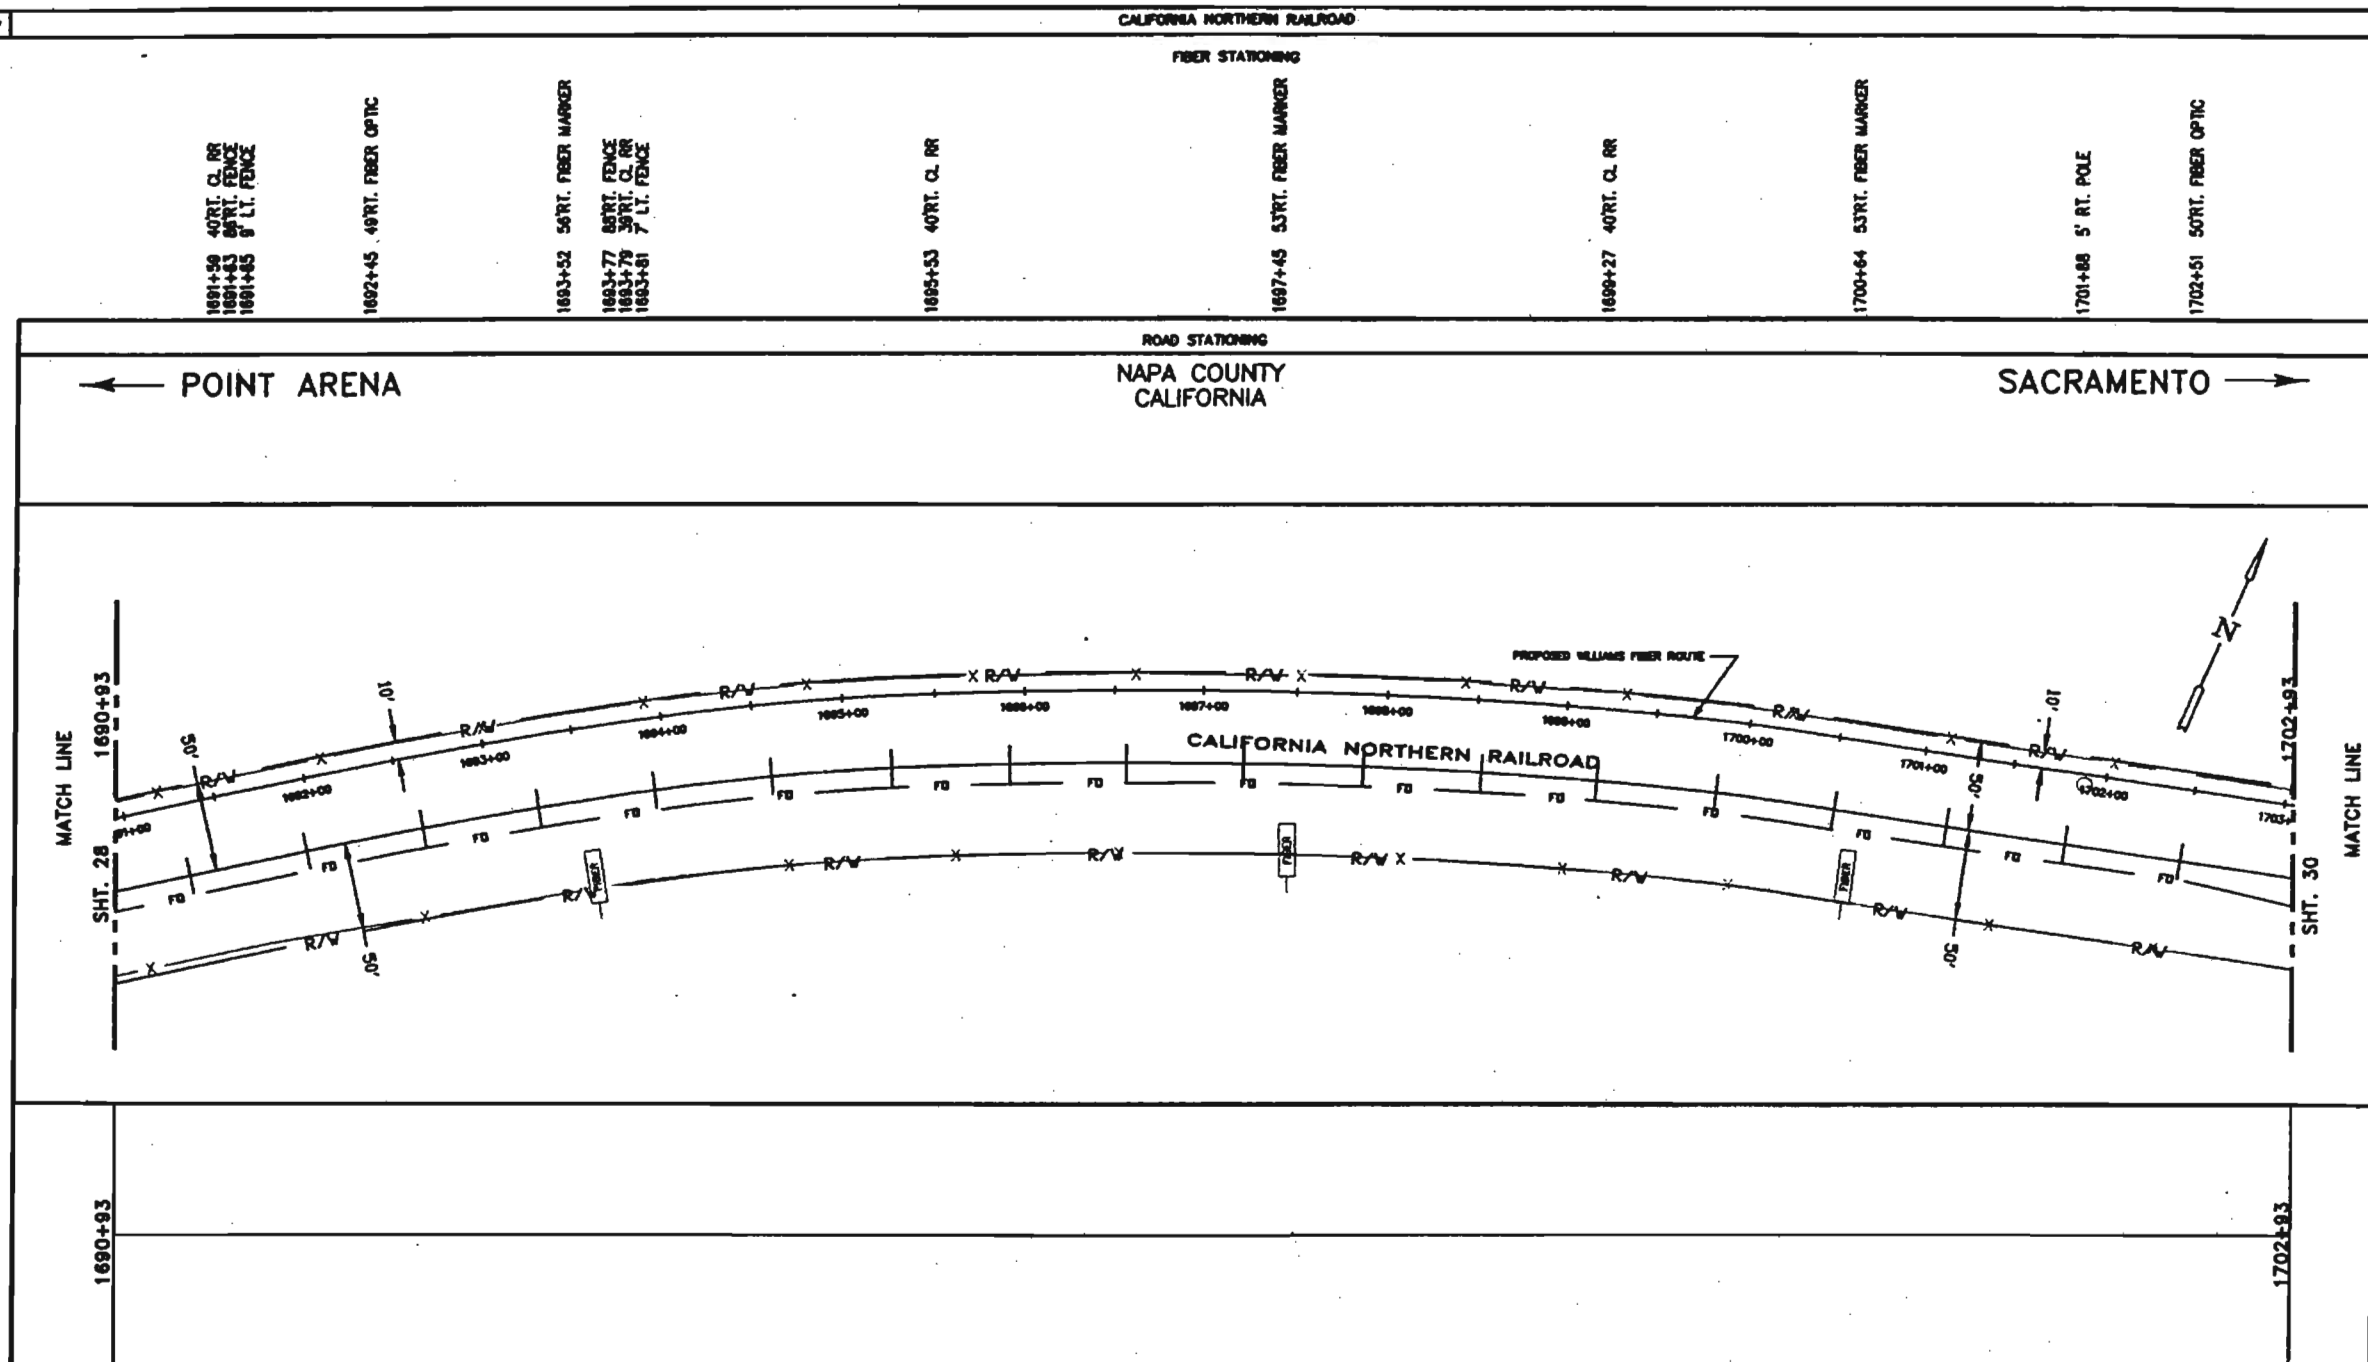

LEGEND

	Interstate Hwy.		Region Site
	U.S. Hwy.		P.A.P./Can.
	State Hwy.		Marshlands Spikes
	County Road		Marshlands
	R/W Mile Mkr.		Marshlands Spikes
	Inter. Road Sign		Marshlands
	New Fiber Cable		Marshlands
	Township Line		Marshlands
	City Limits		Marshlands
	R/W Line		Marshlands
	River/Stream		Marshlands
	CL Road		Marshlands
	CL RR Tracks		Marshlands
	Fence		Marshlands
	Gas Pipeline		Marshlands
	Gas Pipeline		Marshlands
	Power Line		Marshlands
	Water Line		Marshlands
	San. Sewer		Marshlands
	Storm Drain		Marshlands
	Telephone Line		Marshlands
	Black Iron Pipe		Marshlands
	Galvanized Iron Pipe		Marshlands
	Edge of Pavement		Marshlands
	Edge of Ground		Marshlands
	Face of Cut		Marshlands
	Fog Line and/or White Line		Marshlands
	Water Intake		Marshlands

WILLIAMS
EMERGENCY NOTIFICATION NUMBER
1-800-582-9089

CAUTION

**WILLIAMS LOCATE # FOR
COUNTY, STATE
1-888-945-2255**

**FOREIGN UTILITY LOCATIONS ARE
APPROXIMATE. CONTACT THE LOCAL ONE
CALL AGENCY 48 HOURS PRIOR
TO CONSTRUCTION FOR EXACT
UTILITY LOCATIONS AT :**

1-800-227-2600

DRAWING DISCLAIMER

FACILITY LOCATIONS ARE GENERAL IN NATURE
WILLIAMS WILL NOT BE HELD ACCOUNTABLE FOR
THE ACCURACY OF THE INFORMATION PROVIDED
ON THESE DRAWINGS.

PRELIMINARY

[illegible]


CABLE FIBER COUNT MFL TYPE OF GLASS	CABLE SECTION
CABLE HELL, NO.	
SPACE TO SPECIFY CABLE LENGTH & CIL LENGTH	PIPE & IMPERMEANT PLACEMENT
IMPERMEANT & TYPE (GMB/SMOOTH/COLOR)	
STEEL PIPE SIZE	FUTURE UNIT PLACE
PVC	
FUTURE-2	
FUTURE-3	
FUTURE-6	



COMMUNIST GROUP
National Office

POINT ARENA TO SACRAMENTO
CABLE ROUTE

DRAWN BY : HMC	DATE : 08/25/90
CHECKED BY : MHW	DATE : 08/29/90
APPROVED BY :	DATE :
APPROVED BY :	DATE :
APC : 4577 LDC CODE :	
HORIZONTAL SCALE (DWG & PROF) : 1"=100'	
VERTICAL SCALE (DWG) :	
VERTICAL SCALE (PROF) :	
MAP PROJECTION :	

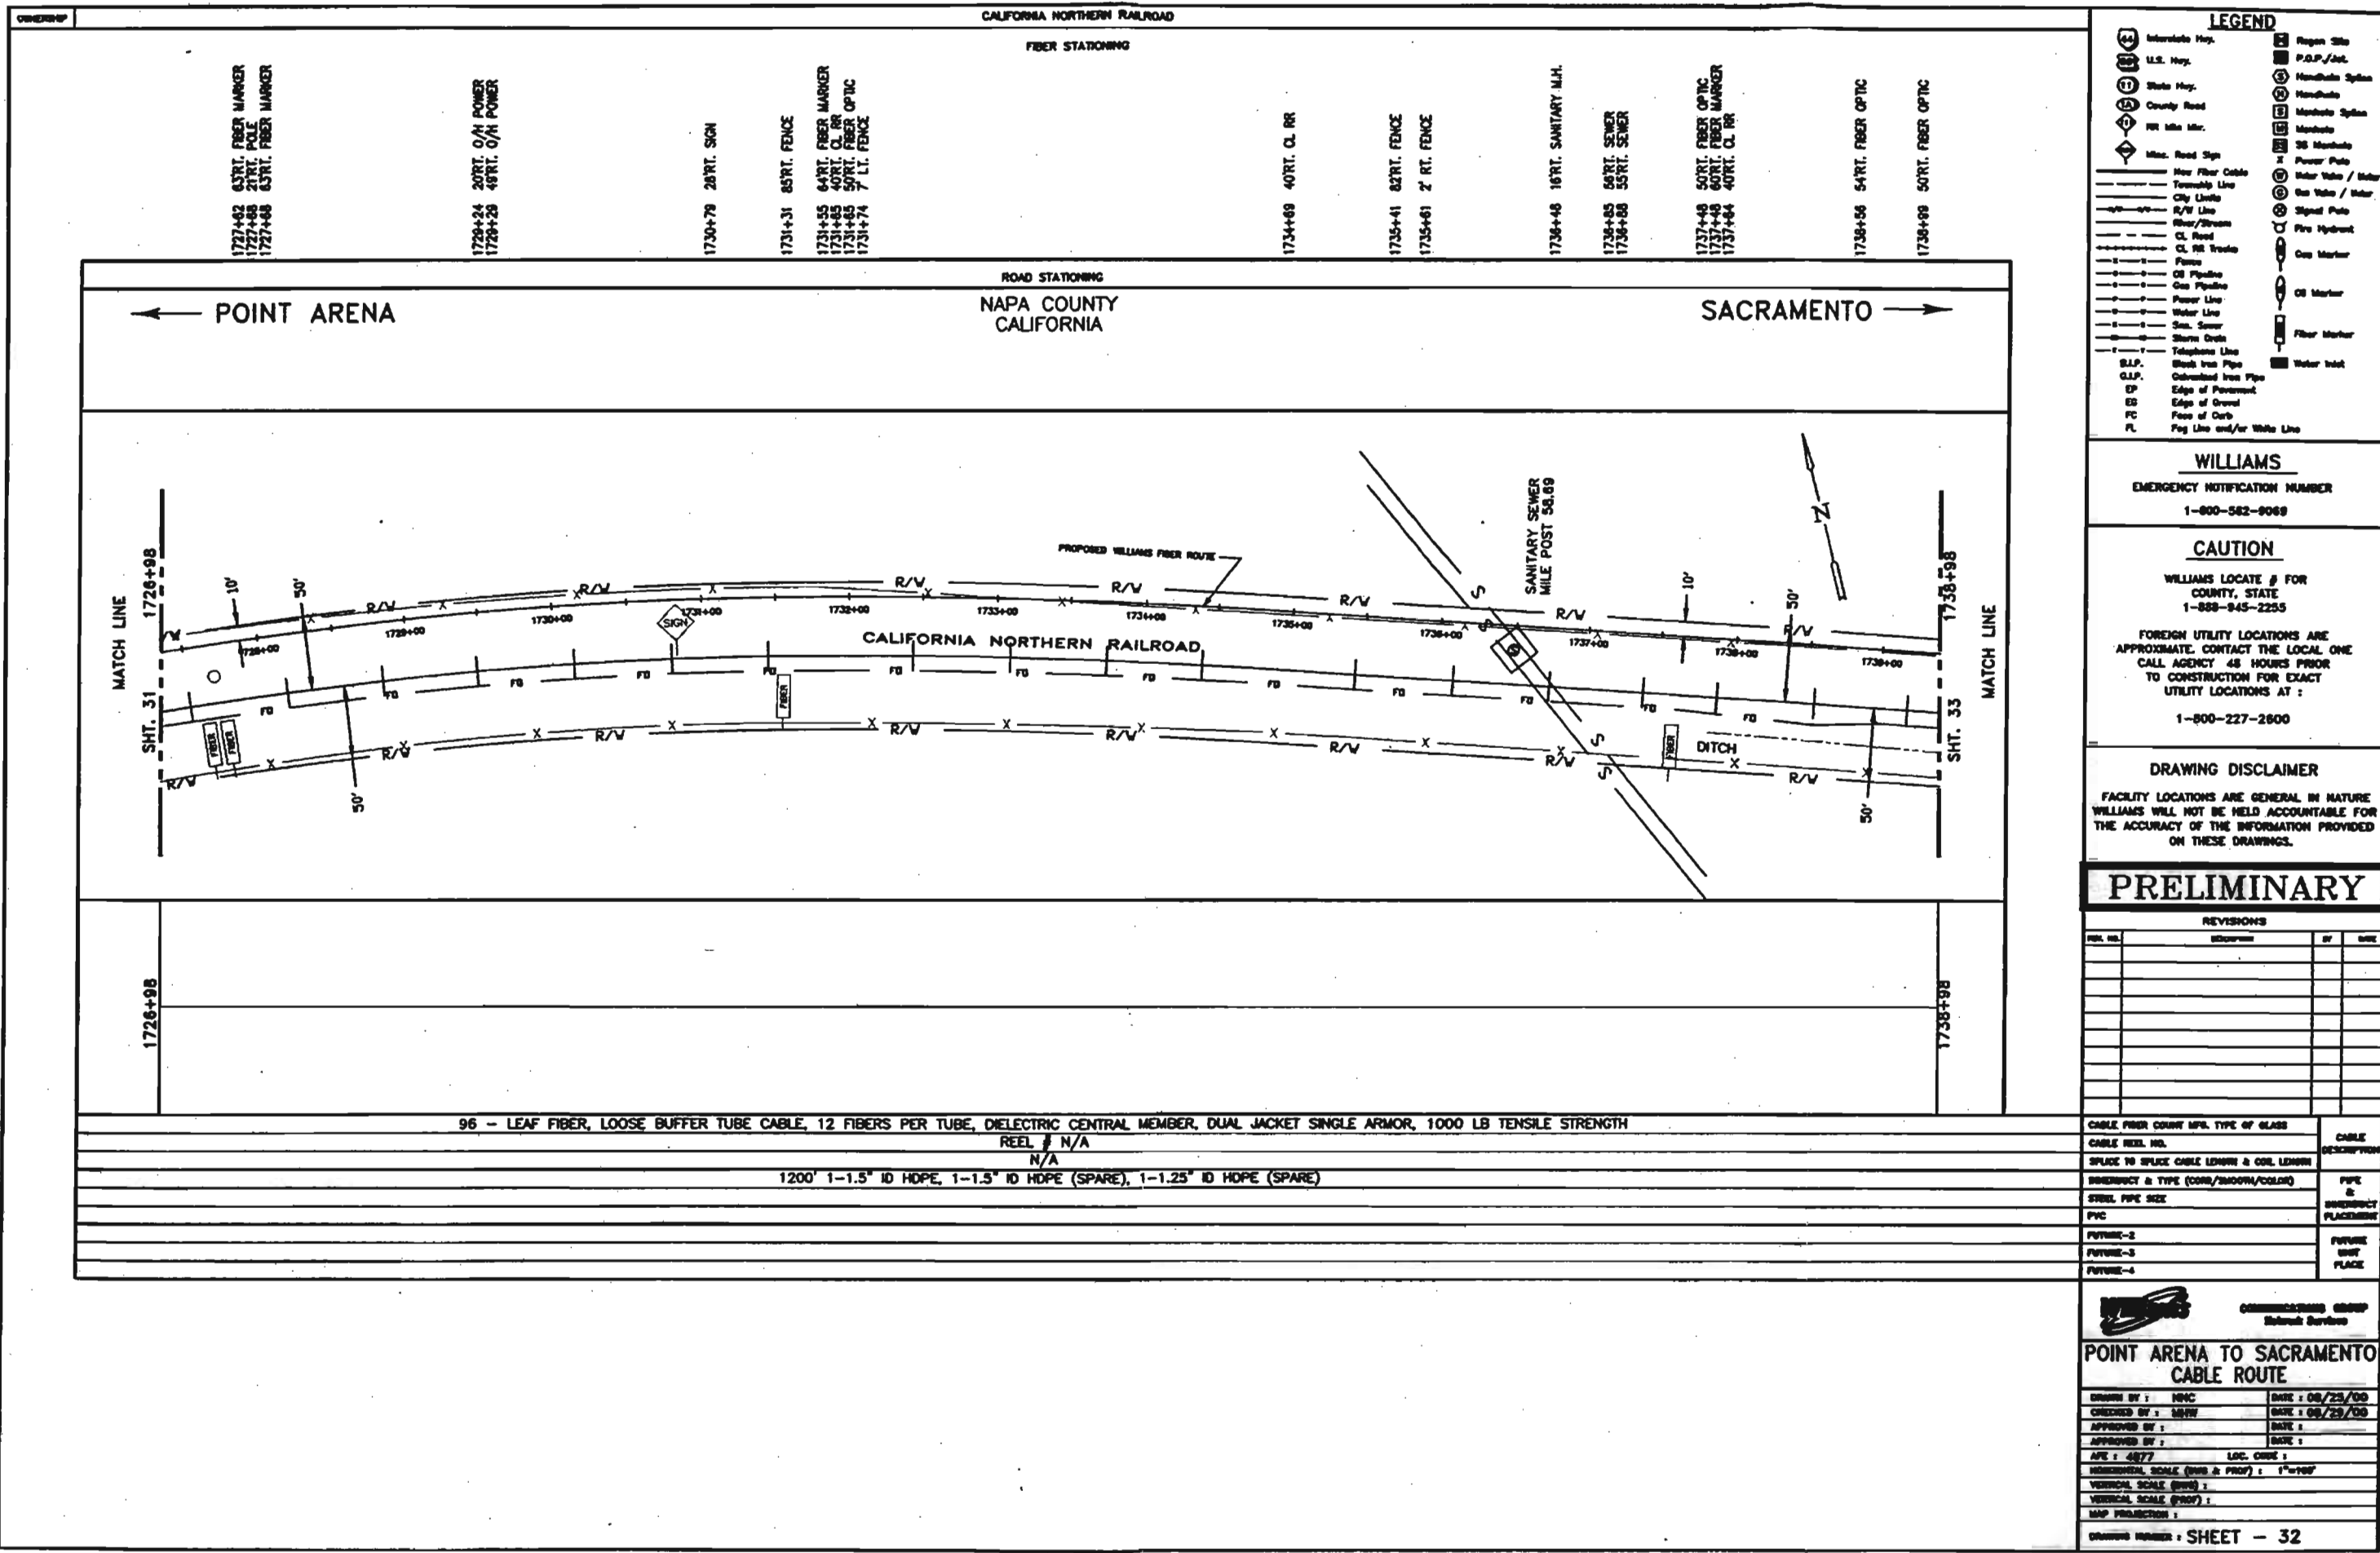

LEGEND	
	Interstate Hwy.
	U.S. Hwy.
	State Hwy.
	County Road
	RR Mile Mr.
	Max. Road Sign
	New Fiber Cable
	Turnback Line
	City Limits
	R/W Line
	River/Stream
	CL Road
	CL RR Tracks
	Fence
	Oil Pipeline
	Gas Pipeline
	Power Line
	Water Line
	Sewer
	Storm Drain
	Telephone Line
	Block Iron Pipe
	Culminated Iron Pipe
	Edge of Pavement
	Edge of Gravel
	Face of Curb
	Flag Line and/or White Line
	Region Site
	P.O.P./Jct.
	Handhole Spline
	Handhole
	Manhole Spline
	Manhole
	30 Manhole
	Power Pole
	Water Valve / Water
	Gas Valve / Gas
	Oil Marker
	Fiber Marker
	Water Inlet

WILLIAMS
EMERGENCY NOTIFICATION NUMBER
1-800-582-9068

CAUTION
WILLIAMS LOCATE & FOR
COUNTY, STATE
1-888-945-2255

FOREIGN UTILITY LOCATIONS ARE
APPROXIMATE. CONTACT THE LOCAL ONE
CALL AGENCY 48 HOURS PRIOR
TO CONSTRUCTION FOR EXACT
UTILITY LOCATIONS AT :
1-800-227-2600

DRAWING DISCLAIMER
FACILITY LOCATIONS ARE GENERAL IN NATURE
WILLIAMS WILL NOT BE HELD ACCOUNTABLE FOR
THE ACCURACY OF THE INFORMATION PROVIDED
ON THESE DRAWINGS.

REVISIONS			
NO.	DESCRIPTION	BY	DATE

CABLE FIBER COUNT MFL TYPE OF GLASS	CABLE DESCRIPTION
CABLE REEL NO.	
SPICE TO SPICE CABLE LENGTH & COIL LENGTH	PIPE & DRAINAGE PLACEMENT
DRAINAGE & TYPE (CON/SMOOTH/COLOR)	
STEEL PIPE SIZE	FUTURE NOT PLACE
PVC	
FUTURE-2	
FUTURE-3	
FUTURE-4	

COMMUNICATIONS GROUP
Network Services

POINT ARENA TO SACRAMENTO CABLE ROUTE

DRAWN BY : NHC	DATE : 08/23/00
CHECKED BY : MSH	DATE : 08/23/00
APPROVED BY :	DATE :
APPROVED BY :	DATE :

AFE : 4877 LOC. CODE :

HORIZONTAL SCALE (HWS & PROF) : 1"=100'

VERTICAL SCALE (VWS) :

VERTICAL SCALE (VWF) :

MAP PROJECTION :

DRAWING NUMBER : SHEET - 32

00000000

CALIFORNIA NORTHERN RAILROAD

FIBER STATIONING

1741+31 50RT. FIBER OPTIC

1742+50 FENCE

1743+02 78RT. CL DITCH
1743+02 85RT. FENCE

1745+40 62RT. FIBER MARKER
1745+48 12RT. FENCE

1747+67 64RT. FIBER MARKER


1749+55 17LT. FENCE

ROAD STATIONING

NAPA COUNTY
CALIFORNIA

← POINT ARENA

SACRAMENTO →

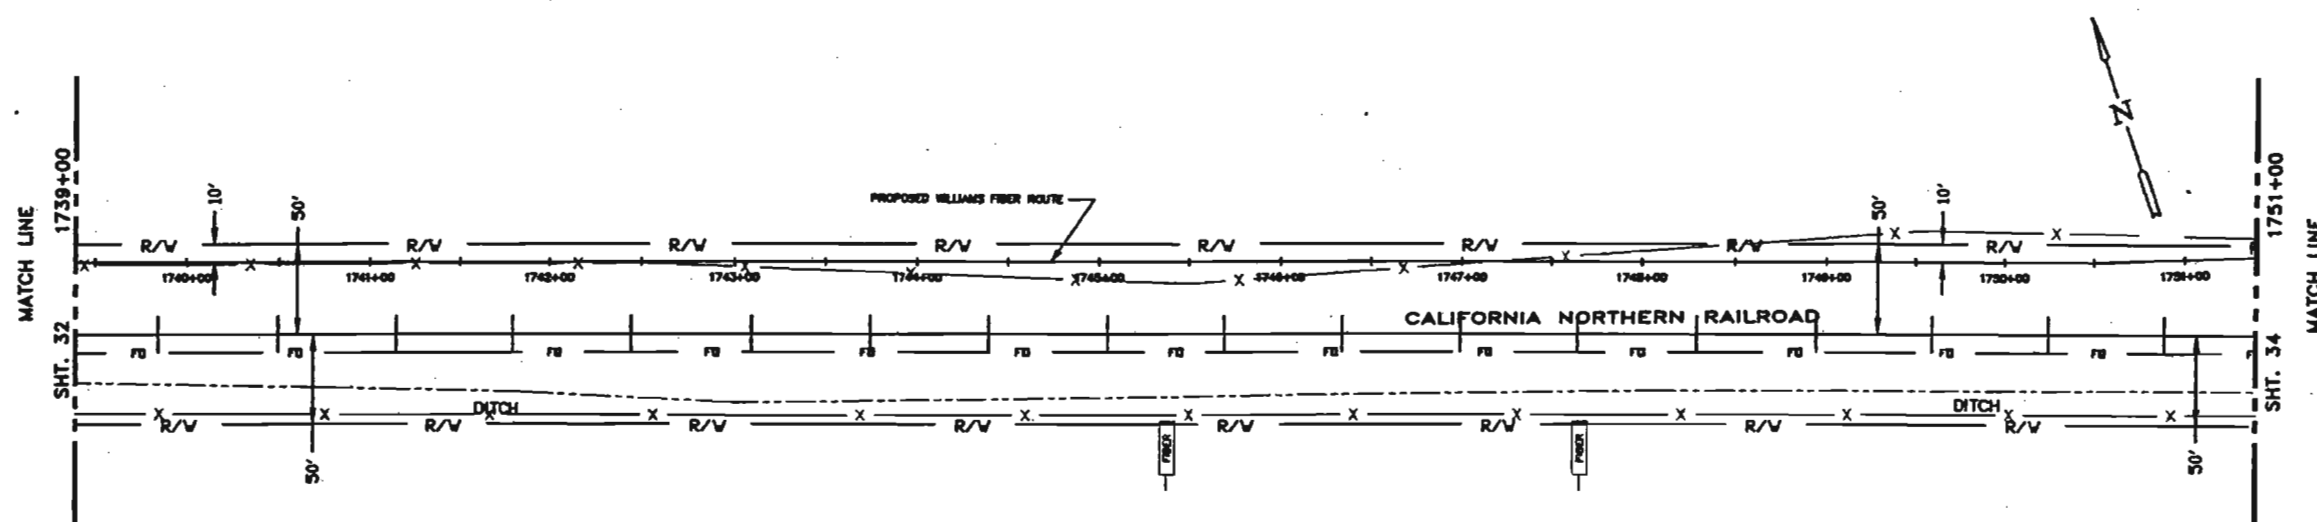

LEGEND

- Interstate Hwy.
- U.S. Hwy.
- State Hwy.
- County Road
- RR Mile Marker
- Min. Road Sign
- New Fiber Cable
- Scenic Line
- City Limits
- R/W Line
- River/Stream
- CL Road
- CL RR Tracks
- Fence
- Gas Pipeline
- Oil Pipeline
- Power Line
- Water Line
- San. Sewer
- Storm Drain
- Telephone Line
- ELP.
- CLP.
- Edge of Pavement
- Edge of Gravel
- Face of Curb
- Fog Line and/or White Line
- Region Site
- P.O.P./Aid.
- Handhole Splice
- Handhole
- Handhole Splice
- Handhole
- 30 Handhole
- Power Pole
- Water Valve / Meter
- Gas Valve / Meter
- Signal Pole
- Pole Hydrant
- Gas Marker
- Oil Marker
- Fiber Marker
- Water Inlet

WILLIAMS

EMERGENCY NOTIFICATION NUMBER
1-800-582-3088

CAUTION

WILLIAMS LOCATE # FOR
COUNTY, STATE
1-888-845-2255
FOREIGN UTILITY LOCATIONS ARE
APPROXIMATE. CONTACT THE LOCAL ONE
CALL AGENCY 48 HOURS PRIOR
TO CONSTRUCTION FOR EXACT
UTILITY LOCATIONS AT:
1-800-227-2800

DRAWING DISCLAIMER

FACILITY LOCATIONS ARE GENERAL IN NATURE
WILLIAMS WILL NOT BE HELD ACCOUNTABLE FOR
THE ACCURACY OF THE INFORMATION PROVIDED
ON THESE DRAWINGS.

PRELIMINARY

REVISIONS

REV. NO.	DESCRIPTION	BY	DATE

96 - LEAF FIBER, LOOSE BUFFER TUBE CABLE, 12 FIBERS PER TUBE, DIELECTRIC CENTRAL MEMBER, DUAL JACKET SINGLE ARMOR, 1000 LB TENSILE STRENGTH

REEL # N/A

N/A

1200' 1-1.5" ID HDPE, 1-1.5" ID HDPE (SPARE), 1-1.25" ID HDPE (SPARE)


CABLE FIBER COUNT	TYPE OF GLASS	CABLE DESCRIPTION

COMMUNICATIONS GROUP
Network Services

POINT ARENA TO SACRAMENTO CABLE ROUTE

DRAWN BY: HMC	DATE: 08/25/00
CHECKED BY: MHW	DATE: 08/25/00
APPROVED BY:	DATE:
APPROVED BY:	DATE:
APR: 4877	LOC. CODE:
HORIZONTAL SCALE (HWD & PROF): 1"=100'	
VERTICAL SCALE (HWD):	
VERTICAL SCALE (PROF):	
MAP PROJECTION:	

WORKING NUMBER: SHEET - 33

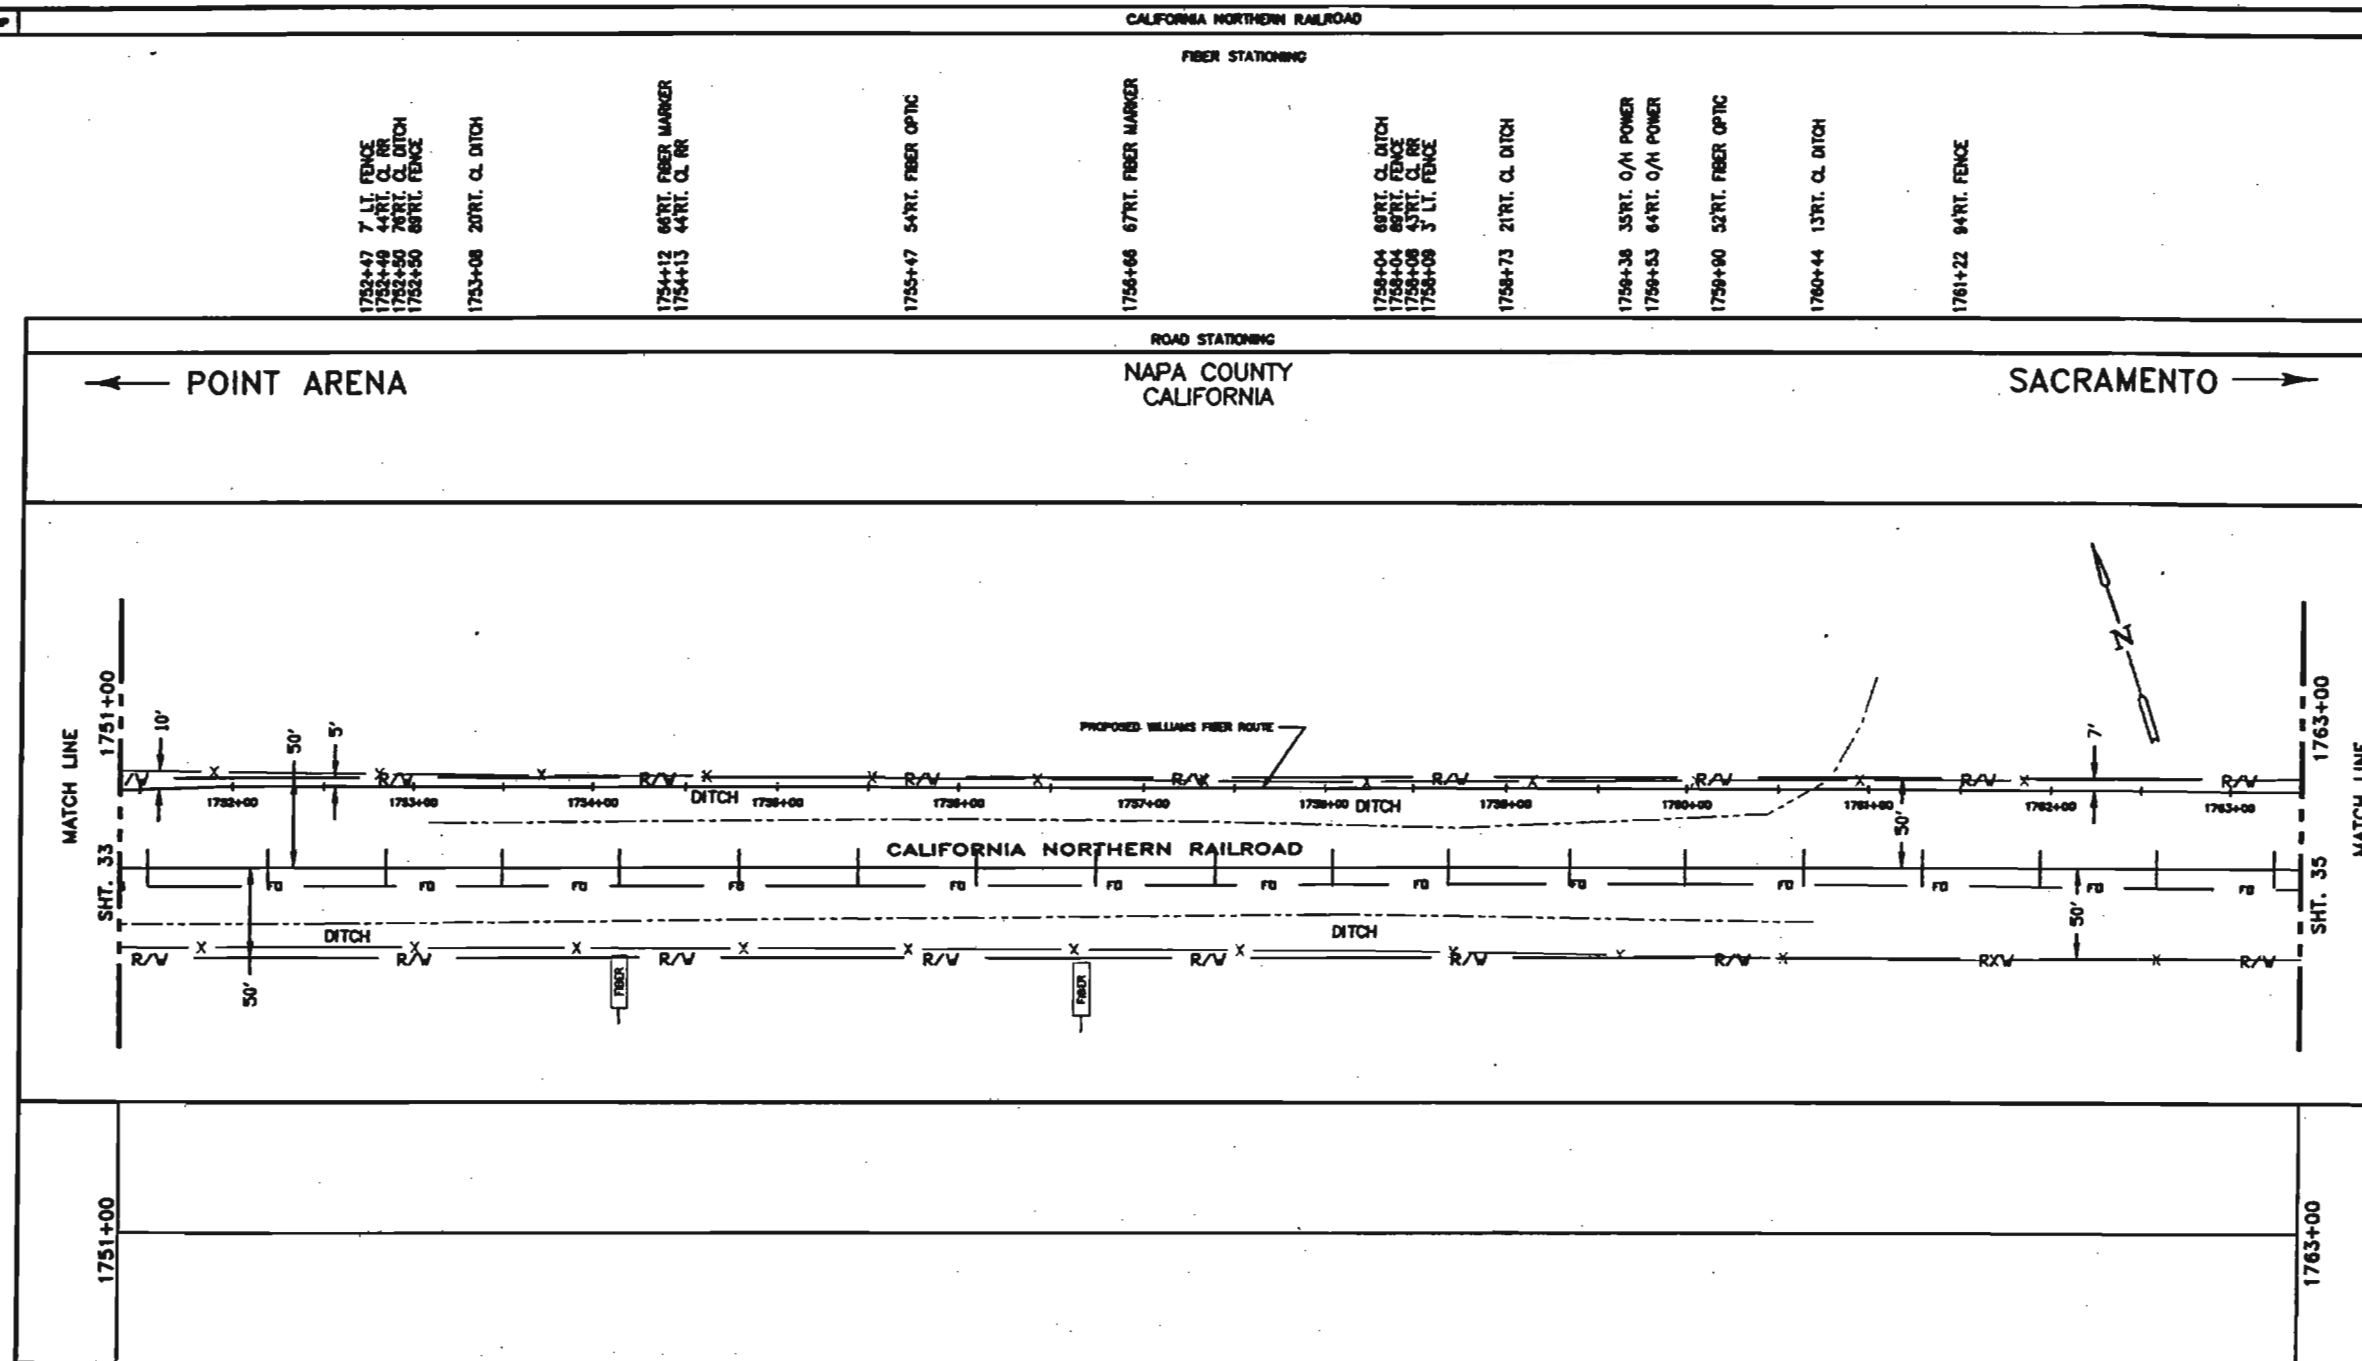

LEGEND

	Interstate Hwy.		Regen Site
	U.S. Hwy.		P&P/Jot
	State Hwy.		Handhole Splice
	County Road		Handhole
	RR Mile Marker		Handhole Splice
	Mile. Road Sign		Handhole
			SE Handhole
	New Fiber Cable		Power Pole
	Township Line		Water Valve / Meter
	City Limits		Gas Valve / Meter
	R/W Line		Signal Pole
	River/Stream		Fire Hydrant
	CL Road		Gas Marker
	CL RR Tracks		Oil Marker
	Fence		Fiber Marker
	Oil Pipeline		Water Inlet
	Gas Pipeline		
	Power Line		
	Water Line		
	San. Sewer		
	Storm Drain		
	Telephone Line		
	Black Iron Pipe		
	Galvanized Iron Pipe		
	Edge of Pavement		
	Edge of Gravel		
	Face of Curb		
	Fog Line and/or Water Line		

WILLIAMS
EMERGENCY NOTIFICATION NUMBER
1-800-582-9099

CAUTION

**WILLIAMS LOCATE & FOR
COUNTY, STATE
1-888-845-2255**

**FOREIGN UTILITY LOCATIONS ARE
APPROXIMATE. CONTACT THE LOCAL ONE
CALL AGENCY 48 HOURS PRIOR
TO CONSTRUCTION FOR EXACT
UTILITY LOCATIONS AT :**

1-800-227-2800

DRAWING DISCLAIMER

FACILITY LOCATIONS ARE GENERAL IN NATURE
WILLIAMS WILL NOT BE HELD ACCOUNTABLE FOR
THE ACCURACY OF THE INFORMATION PROVIDED
ON THESE DRAWINGS.

PRELIMINARY

[illegible]


CABLE FIBER COUNT MFG. TYPE OF GLASS	CABLE SECTION NO.
CABLE NEEL NO.	
SPlice TO SPlice CABLE LENGTH & COIL LENGTH	
INTERJECT & TYPE (CORR/SHADOW/COLOR)	PIPE &
STEEL PIPE SIZE	NUMBER OF
PVC	PLACEMENT
POTUNE-2	POTUNE ONE PLACE
POTUNE-3	
POTUNE-4	



COMMUNIST PARTY
U.S.A.

POINT ARENA TO SACRAMENTO
CABLE ROUTE

DRAWN BY :	MNC	DATE :	08/23/00
CHECKED BY :	MTW	DATE :	08/23/00
APPROVED BY :		DATE :	
APPROVED BY :		DATE :	
AGE : 4877		LOC. CODE :	
HORIZONTAL SCALE (HUB & PROF) : 1"=100'			
VERTICAL SCALE (HUB) :			
VERTICAL SCALE (PROF) :			
MAP PROJECTION :			

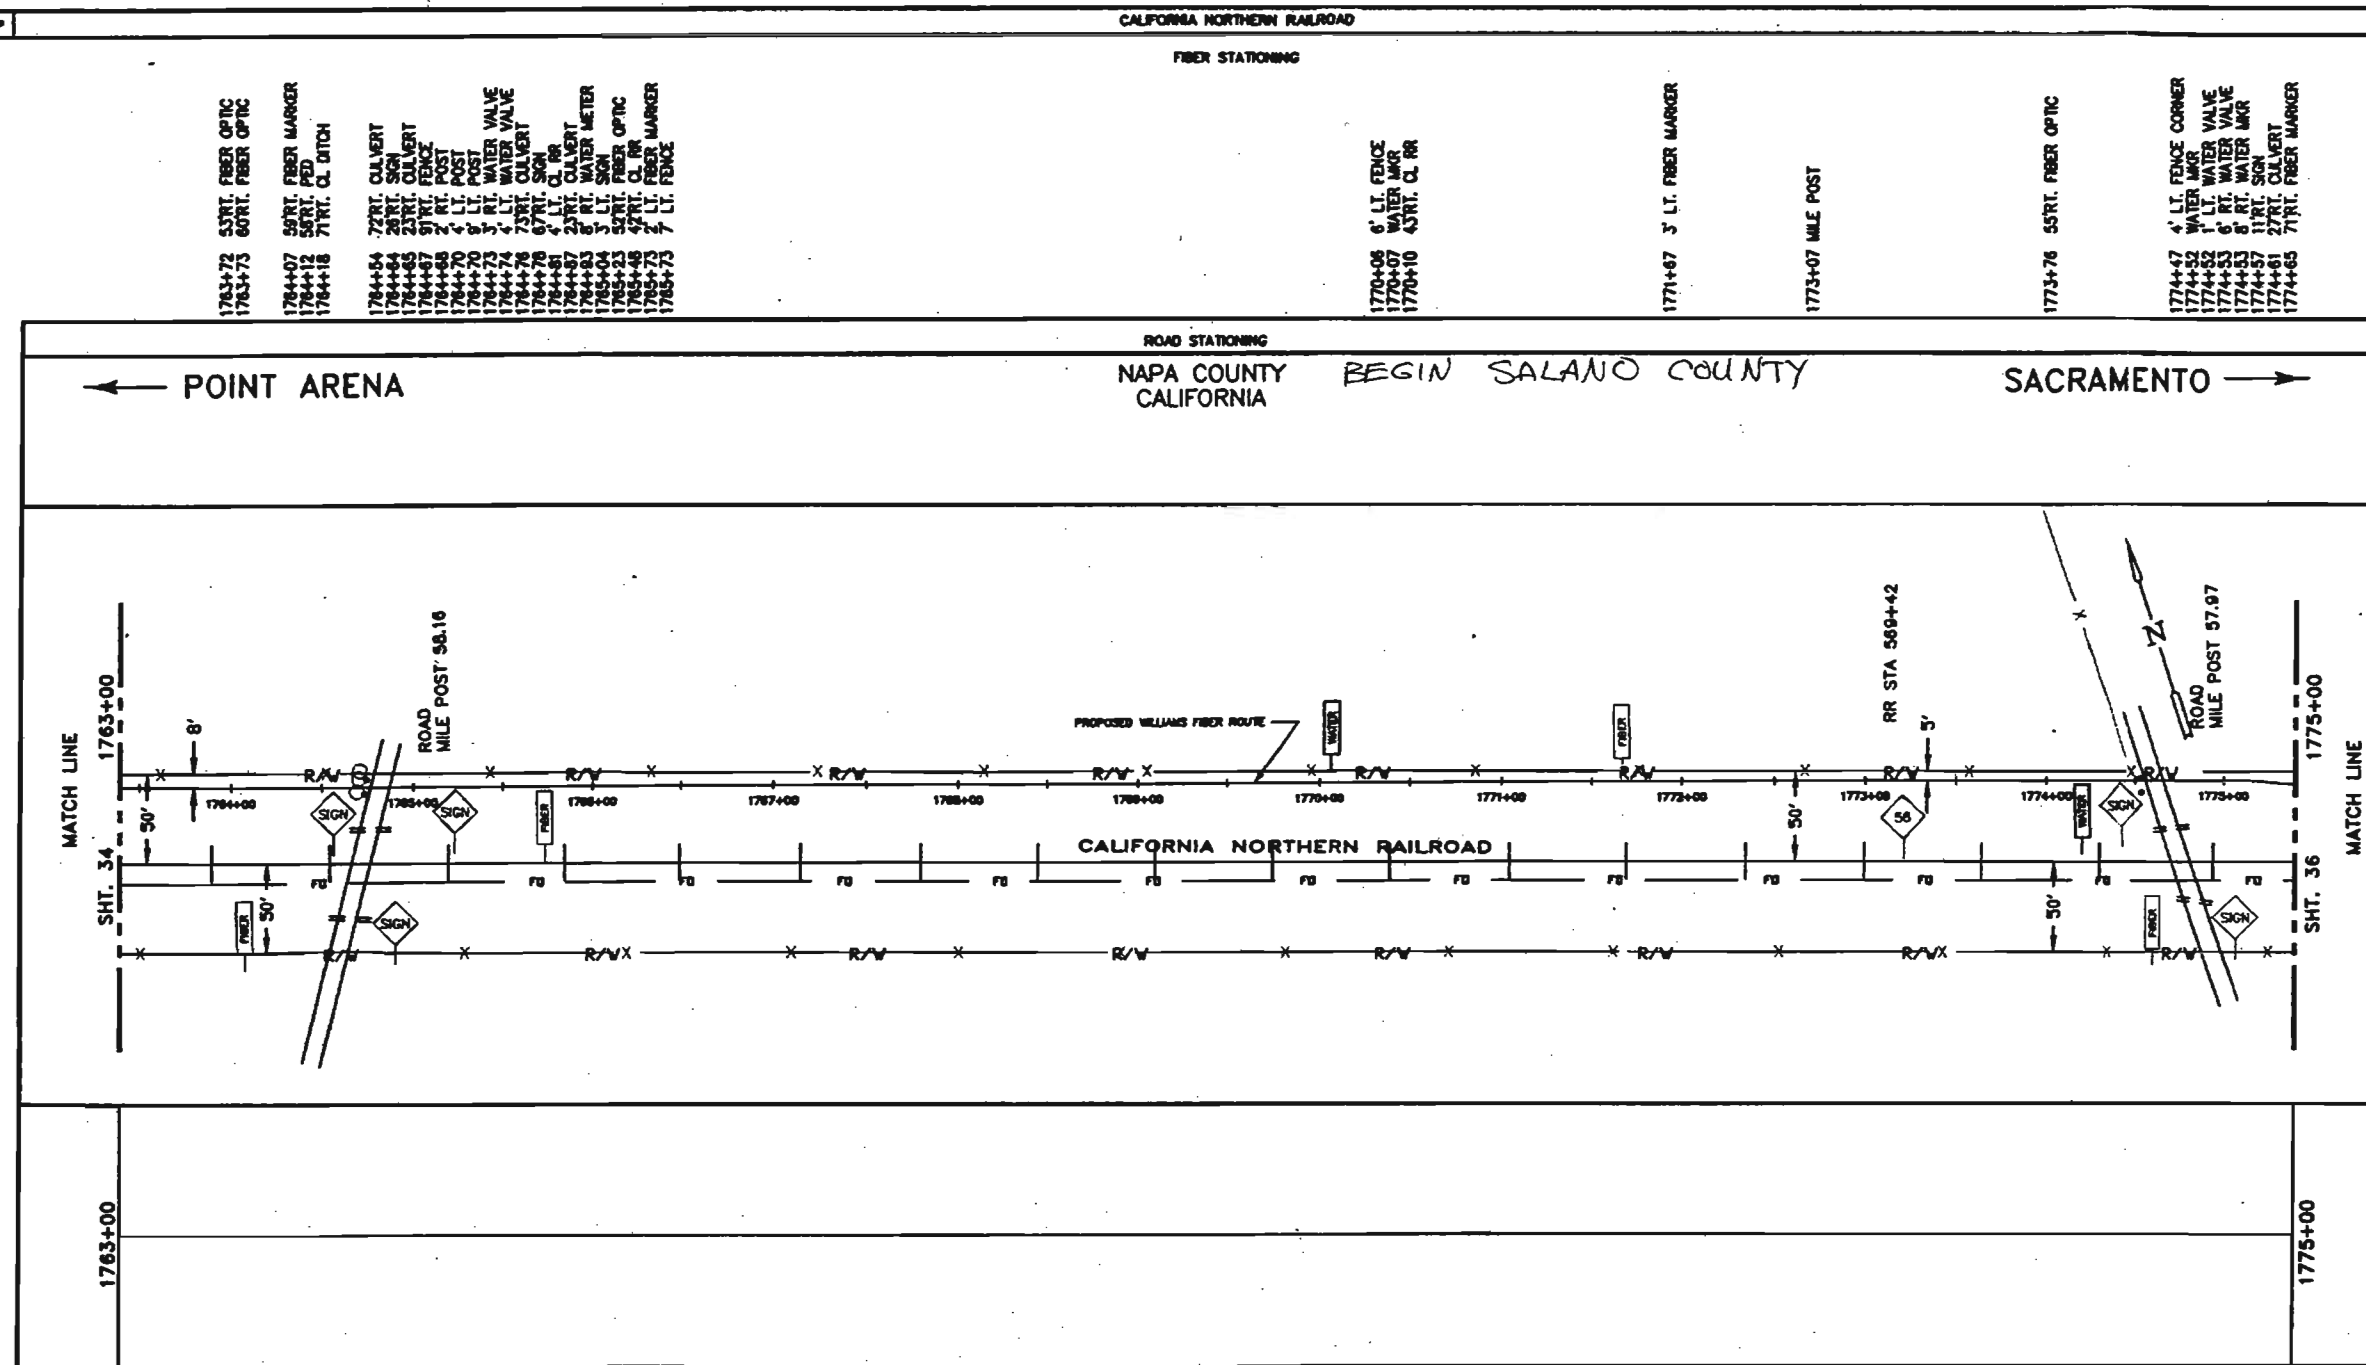

LEGEND

	Interstate Hwy.		Regen Site
	U.S. Hwy.		P.O.P./Jct.
	State Hwy.		Mandshale Splice
	County Road		Mandshale
	RR Mile Mkr.		Mandshale Splice
	Mile. Road Sign		Mandshale
	New Fiber Cable		25 Mandshale
	Township Line		Power Pole
	City Limits		Water Valve / Meter
	R/W Line		Gas Valve / Meter
	River/Stream		Signal Pole
	CL Road		Fire Hydrant
	CL RR Tracks		Gas Marker
	Fence		Oil Marker
	Oil Pipeline		Fiber Marker
	Gas Pipeline		Water Inlet
	Power Line		
	Water Line		
	San. Sewer		
	Storm Drain		
	Telephone Line		
	BLP		
	GLP		
	SP		
	EO		
	FC		
	FL		
	Face of Carb		
	Face Line and/or Width Line		

WILLIAMS
EMERGENCY NOTIFICATION NUMBER
1-800-582-9098

CAUTION

WILLIAMS LOCATE & FOR
COUNTY, STATE
1-888-945-2255

FOREIGN UTILITY LOCATIONS ARE
APPROXIMATE. CONTACT THE LOCAL ONE
CALL AGENCY 48 HOURS PRIOR
TO CONSTRUCTION FOR EXACT
UTILITY LOCATIONS AT :
1-800-227-2800

DRAWING DISCLAIMER


FACILITY LOCATIONS ARE GENERAL IN NATURE
WILLIAMS WILL NOT BE HELD ACCOUNTABLE FOR
THE ACCURACY OF THE INFORMATION PROVIDED
ON THESE DRAWINGS.

PRELIMINARY

[illegible]

CABLE NUMBER COUNT MFG. TYPE OF GLASS	CABLE DESCRIPTION
CABLE SERIAL NO.	
SPACE TO REPLACE CABLE LENGTH & COIL LENGTH	PIPE & INDEPENDENT PLACEMENT
INDEPENDENT & TYPE (CONC./SMOOTH/COLOR)	
STEEL PIPE SIZE	PISTON GUN PLACE
PVC	
PISTON-2	
PISTON-3	
PISTON-4	

		COMMUNICATIONS GROUP Network Services	
POINT ARENA TO SACRAMENTO CABLE ROUTE			
DRAWN BY : HMC		DATE : 06/25/00	
CHECKED BY : MSW		DATE : 06/29/00	
APPROVED BY :		DATE :	
APPROVED BY :		DATE :	
AFC : 4577		LOC. CODE :	
HORIZONTAL SCALE (HWD & FWD) : 1"=100'			
VERTICAL SCALE (HWD) :			
VERTICAL SCALE (FWD) :			
BNP PROJECTION :			
DRAWING NUMBER : SHEET - 35			

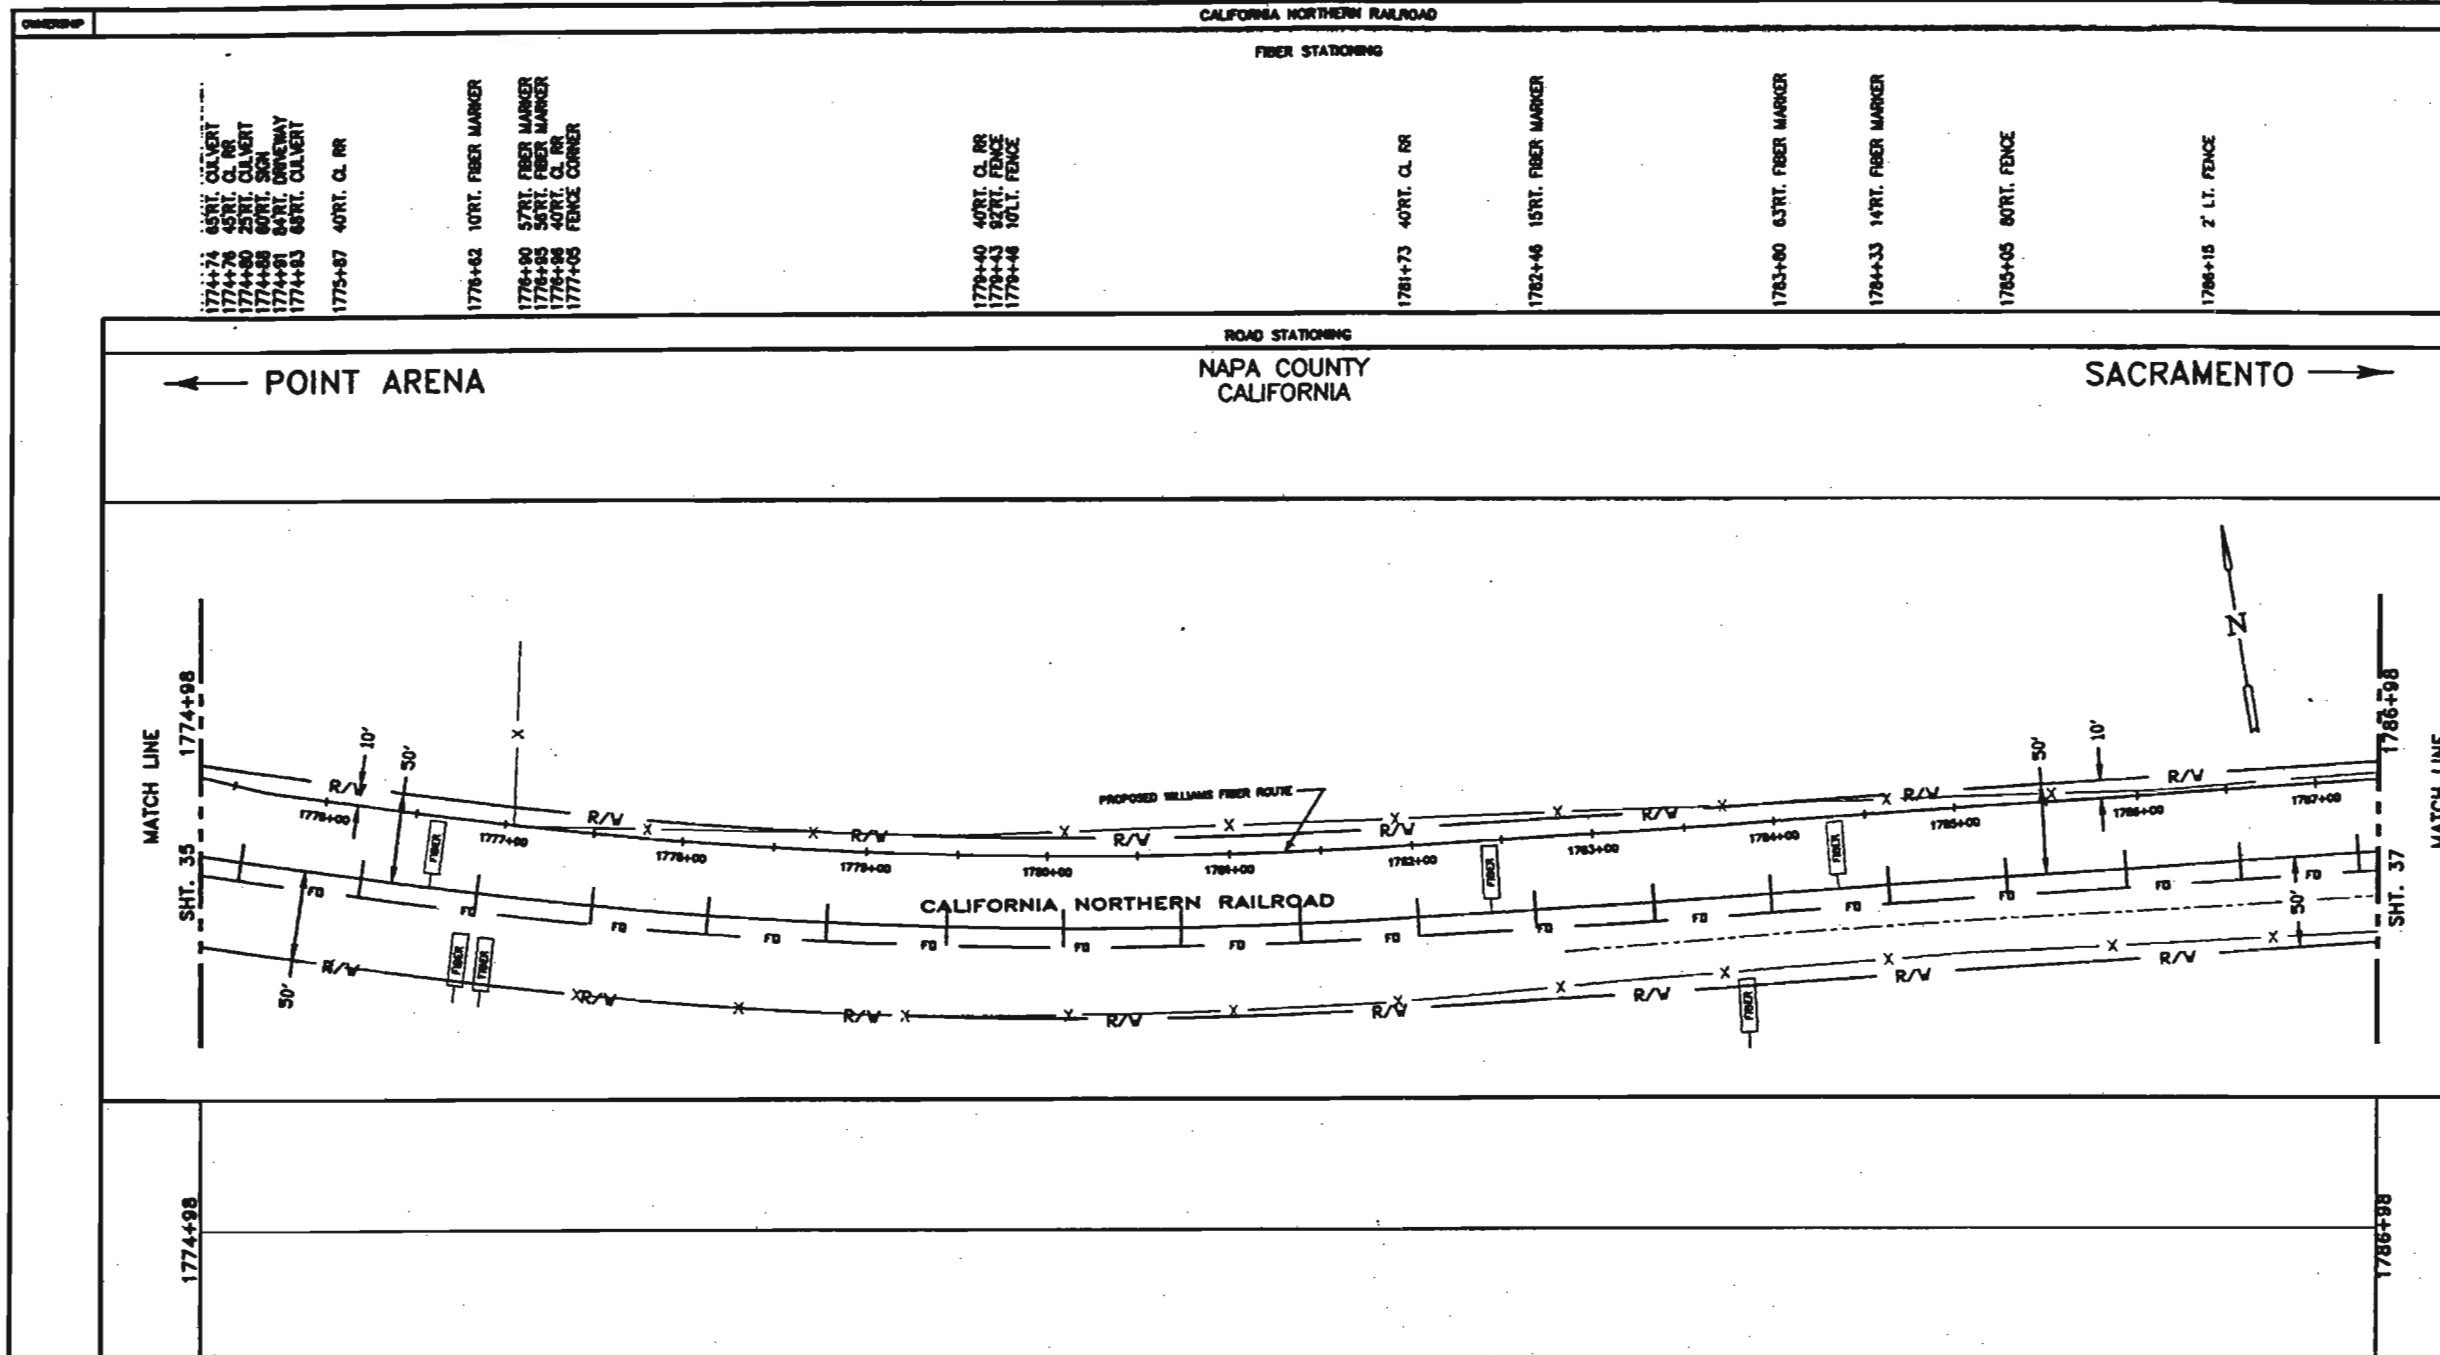

LEGEND	
44	Interstate Hwy.
16	U.S. Hwy.
15	State Hwy.
14	County Road
13	RR Mile Mkr.
12	Mile Road Sign
11	New Fiber Cable
10	Telephone Line
9	City Limits
8	R/W Line
7	Shut/Stream
6	CL Road
5	CL RR Tracks
4	Fence
3	Oil Pipeline
2	Gas Pipeline
1	Power Line
0	Water Line
-1	Sew. Sewer
-2	Storm Drain
-3	Telephone Line
-4	Black Iron Pipe
-5	Galvanized Iron Pipe
-6	Edge of Pavement
-7	Edge of Ground
-8	Face of Curb
-9	Fog Line and/or White Line
1	Regen Site
2	P.O.P./Jct.
3	Handhole Splice
4	Handhole
5	Handhole Splice
6	Handhole
7	36 Handhole
8	Power Pole
9	Water Valve / Meter
10	Gas Valve / Meter
11	Signal Pole
12	Fire Hydrant
13	Gas Marker
14	Oil Marker
15	Fiber Marker
16	Water Inlet

WILLIAMS
EMERGENCY NOTIFICATION NUMBER
1-800-582-9088

CAUTION
WILLIAMS LOCATE & FOR
COUNTY, STATE
1-888-945-2255

FOREIGN UTILITY LOCATIONS ARE
APPROXIMATE. CONTACT THE LOCAL ONE
CALL AGENCY 48 HOURS PRIOR
TO CONSTRUCTION FOR EXACT
UTILITY LOCATIONS AT :
1-800-227-2800

DRAWING DISCLAIMER
FACILITY LOCATIONS ARE GENERAL IN NATURE.
WILLIAMS WILL NOT BE HELD ACCOUNTABLE FOR
THE ACCURACY OF THE INFORMATION PROVIDED
ON THESE DRAWINGS.

REVISIONS			
REV. NO.	DESCRIPTION	BY	DATE

96 - LEAF FIBER, LOOSE BUFFER TUBE CABLE, 12 FIBERS PER TUBE, DIELECTRIC CENTRAL MEMBER, DUAL JACKET SINGLE ARMOR, 1000 LB TENSILE STRENGTH	CABLE DESCRIPTION
REEL # N/A	
N/A	
1200' 1-1.5" ID HOPE, 1-1.5" ID HOPE (SPARE), 1-1.25" ID HOPE (SPARE)	
	PIPE & UNDERDUCT PLACEMENT
	FUTURE HWT PLACE

COMMUNICATIONS GROUP
Network Services

**POINT ARENA TO SACRAMENTO
CABLE ROUTE**

DRAWN BY : NNC	DATE : 08/23/00
CHECKED BY : MHW	DATE : 08/23/00
APPROVED BY :	DATE :
APPROVED BY :	DATE :

APE : 4877 LOC. CODE :


HORIZONTAL SCALE (HWS & PWS) : 1"=100'

VERTICAL SCALE (VWS) :

VERTICAL SCALE (VWS) :

MAP PROJECTION :

DRAWING NUMBER : SHEET - 36

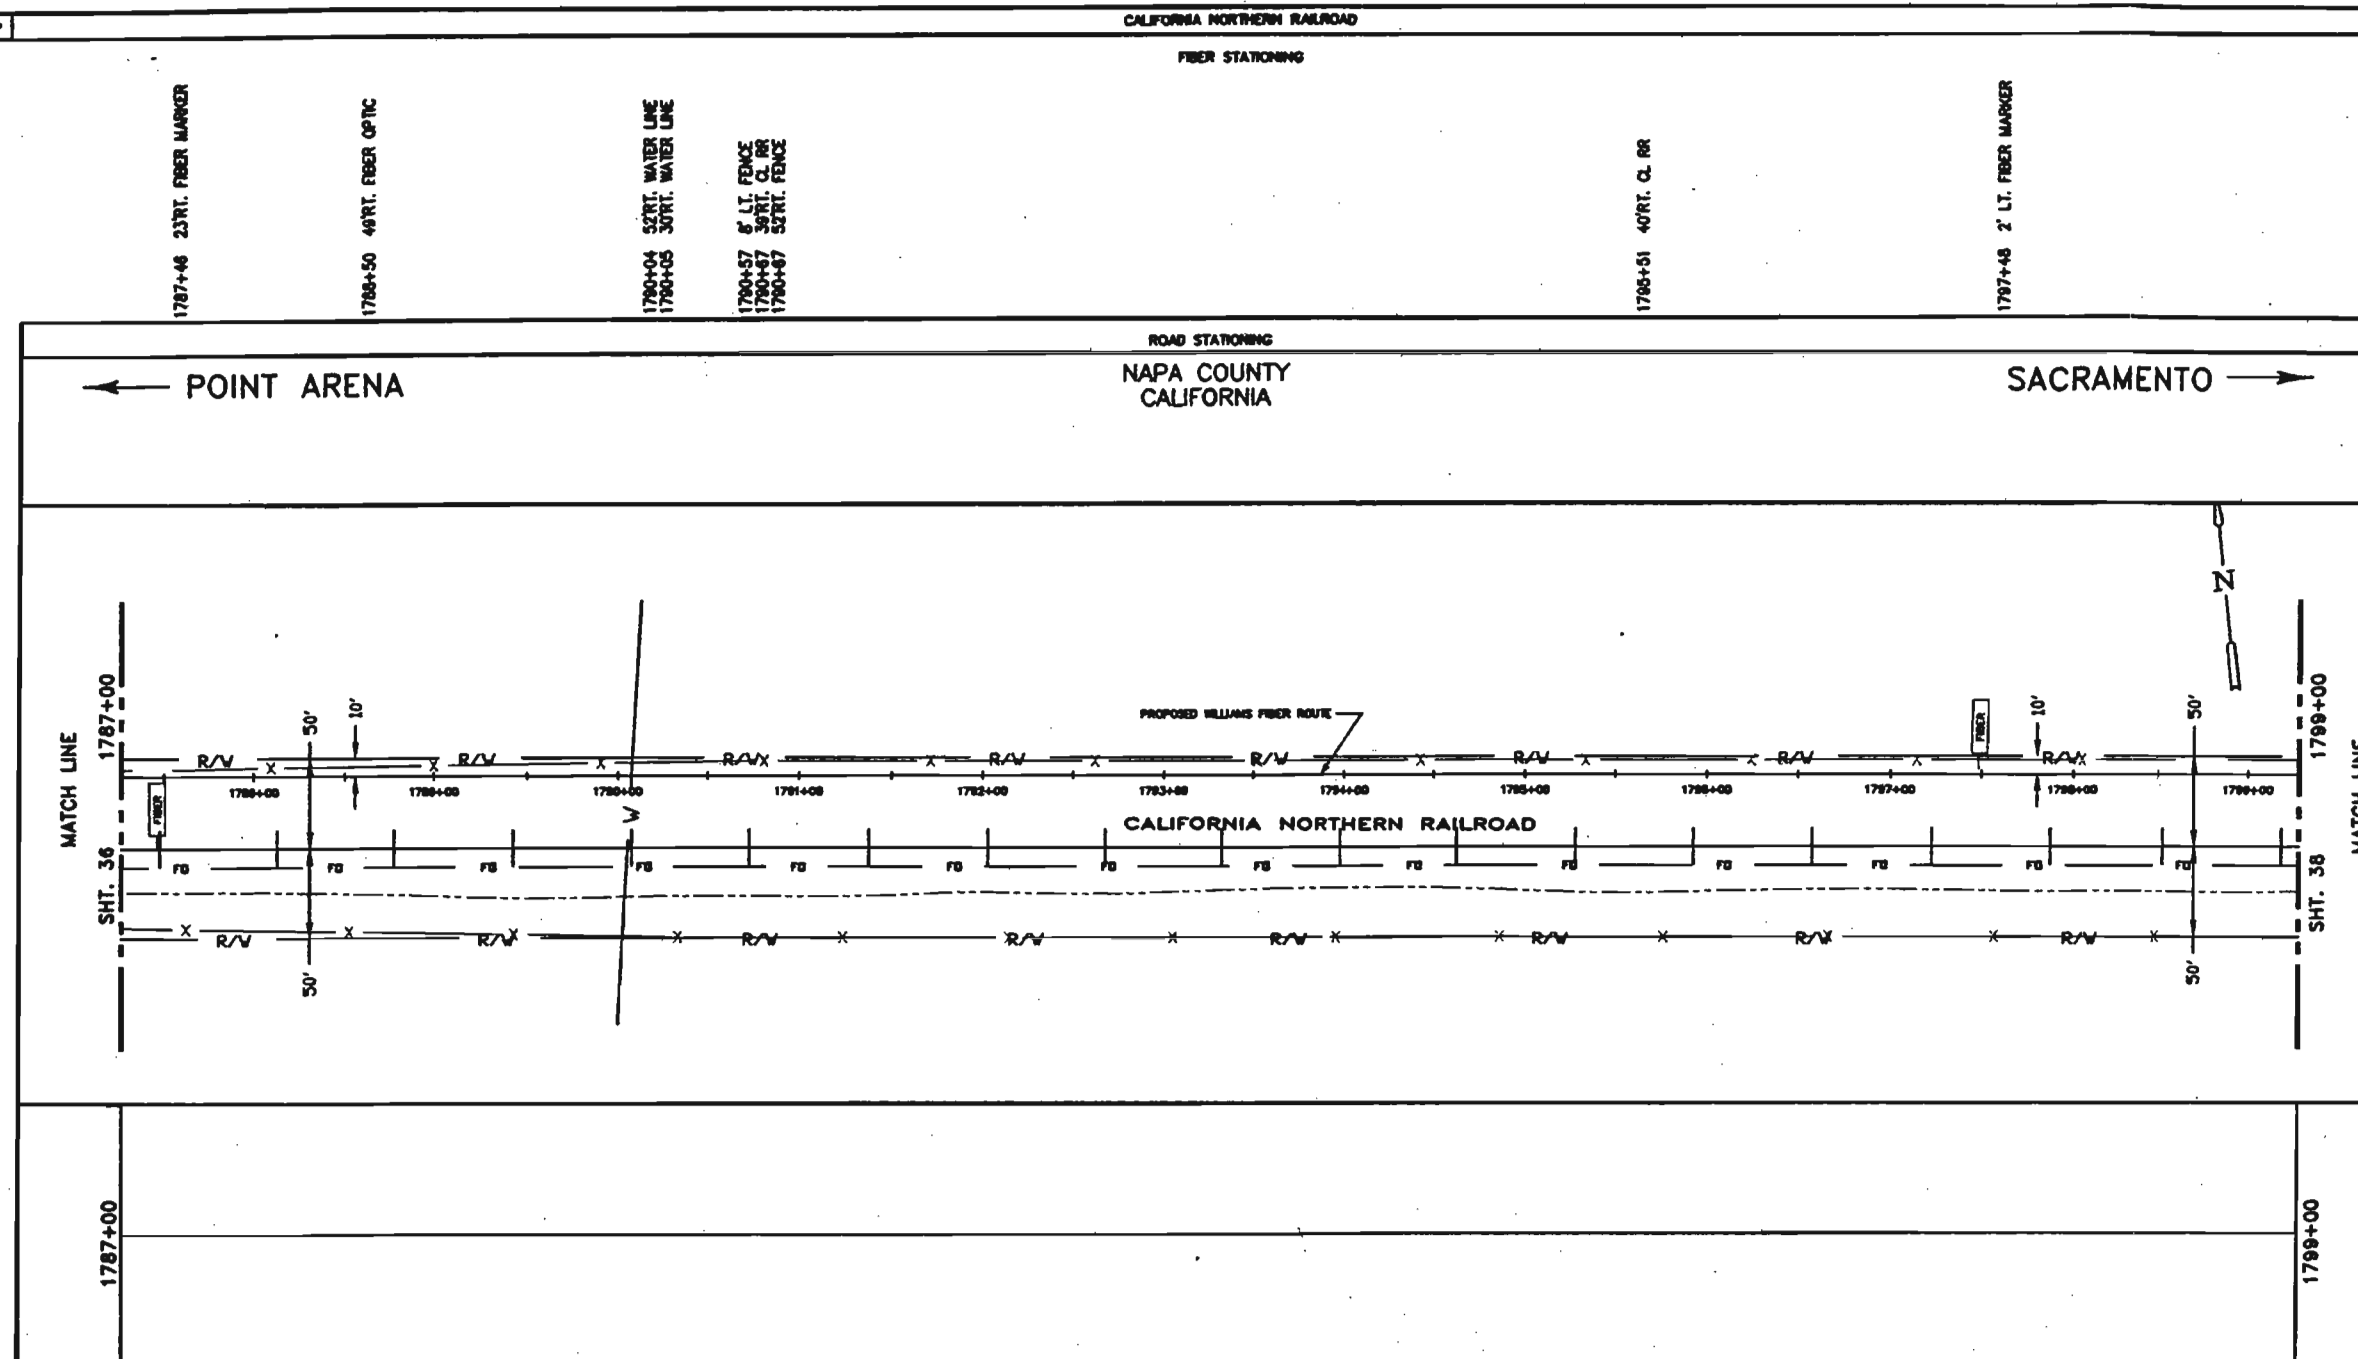

LEGEND

	Interstate Hwy.		Region Site
	U.S. Hwy.		P.O.P./Jct.
	State Hwy.		Handhole Splice
	County Road		Handhole
	RR Mills Idler		Handhole Splice
	Min. Road Sign		Handhole
	New Fiber Cable		Power Pole
	Township Line		Water Valve / Meter
	City Limits		Gas Valve / Meter
	R/W Line		Signal Pole
	River/Stream		Fire Hydrant
	Cl. Road		Gas Marker
	Cl. RR Tracks		Oil Marker
	Fence		Fiber Marker
	Oil Pipeline		Water Inlet
	Gas Pipeline		
	Power Line		
	Water Line		
	San. Sewer		
	Storm Drain		
	Telephone Line		
	Black Iron Pipe		
	Galvanized Iron Pipe		
	Edge of Pavement		
	Edge of Ground		
	Face of Curve		
	Fog Line and/or White Line		

WILLIAMS
EMERGENCY NOTIFICATION NUMBER
1-800-582-9069

CAUTION
WILLIAMS LOCATE # FOR
COUNTY, STATE
1-888-945-2255

FOREIGN UTILITY LOCATIONS ARE
APPROXIMATE. CONTACT THE LOCAL ONE
CALL AGENCY 48 HOURS PRIOR
TO CONSTRUCTION FOR EXACT
UTILITY LOCATIONS AT :
1-800-227-2600

DRAWING DISCLAIMER

FACILITY LOCATIONS ARE GENERAL IN NATURE
WILLIAMS WILL NOT BE HELD ACCOUNTABLE FOR
THE ACCURACY OF THE INFORMATION PROVIDED
ON THESE DRAWINGS.

PRELIMINARY

[illegible]


96 - LEAF FIBER, LOOSE BUFFER TUBE CABLE, 12 FIBERS PER TUBE, DIELECTRIC CENTRAL MEMBER, DUAL JACKET SINGLE ARMOR, 1000 LB TENSILE STRENGTH	CABLE FIBER COUNT MFL TYPE OF GLASS	CABLE DESCRIPTION
REEL # N/A	CABLE REEL NO.	
N/A	SPICE TO SPICE CABLE LENGTH & CBL. LENGTH	PIPE & DIMENSIONS PLACEMENT
1200' 1-1.5" ID HDPE, 1-1.5" ID HDPE (SPARE), 1-1.25" ID HDPE (SPARE)	INSURTECT & TYPE (CORR./SMOOTH/COLOR)	
	STEEL PIPE SIZE	FUTURE USE PLACE
	PVC	
	FUTURE-1	
	FUTURE-3	
	FUTURE-4	



COMMUNICATIONS GROUP
Robert Taylor

POINT ARENA TO SACRAMENTO CABLE ROUTE

DRAWN BY :	MHC	DATE :	08/25/08
CHECKED BY :	LMW	DATE :	08/29/08
APPROVED BY :		SAC :	
APPROVED BY :		SAC :	
AGE :	4577	LOC. CODE :	
HORIZONTAL SCALE (HWS & PROF) :	1"=100'		
VERTICAL SCALE (VWS) :			
VERTICAL SCALE (VWP) :			
UWP PROJECTION :			
DRAWING NUMBER : SHEET -- 37			

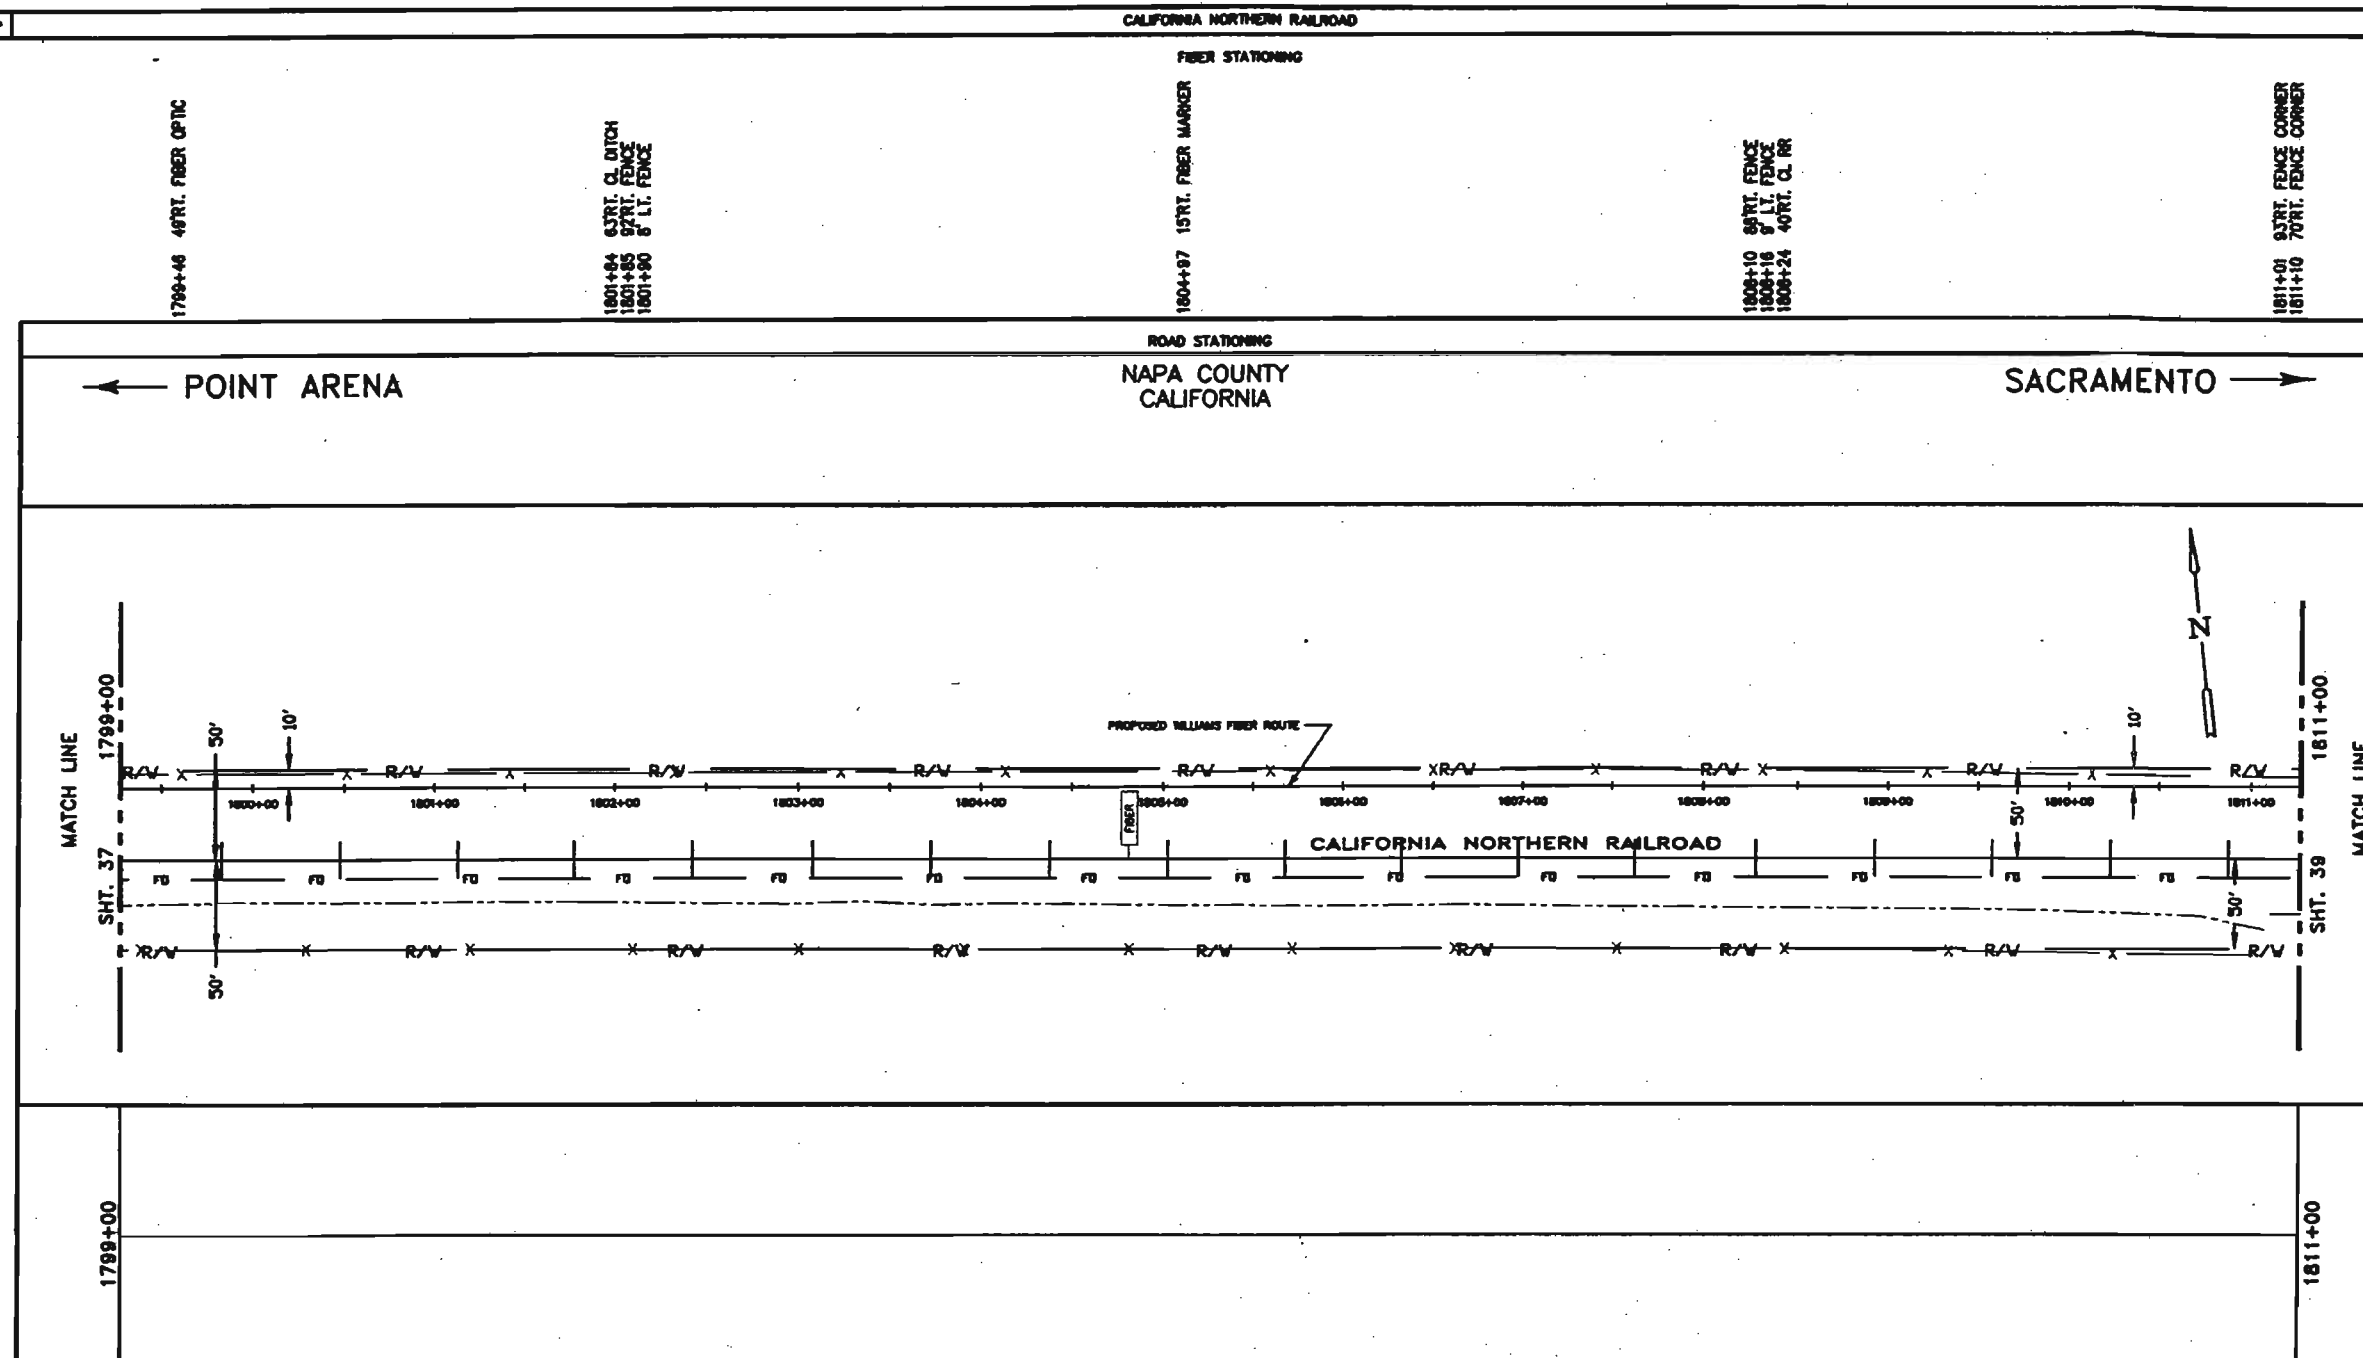

LEGEND

	Interstate Hwy.		Rugby 22
	U.S. Hwy.		P.O.P./dot
	State Hwy.		Handshake Spike
	County Hwy.		Handshake
	RR Mile Mtr.		Handshake Spike
	Mile		Handshake
	Misc. Road Sign		S 22
	Railroad Cable		Power Pole
	Township Line		Water Valve / Water
	City Limits		Gas Valve / Water
	R/W Line		Signal Pole
	River/Stream		Fire Hydrant
	CL Road		Gas Marker
	CL RR Tracks		Oil Marker
	Fence		Fiber Marker
	Oil Pipeline		Water Inlet
	Gas Pipeline		
	Power Line		
	Water Line		
	San. Sewer		
	Storm Drain		
	Telephone Line		
	Black Iron Pipe		
	Columbian Iron Pipe		
	Edge of Pavement		
	Edge of Gravel		
	Foot of Curve		
	Foot Line and/or White Line		

WILLIAMS
EMERGENCY NOTIFICATION NUMBER
1-800-582-9099

CAUTION

**WILLIAMS LOCATE # FOR
COUNTY, STATE
1-888-945-2255**

**FOREIGN UTILITY LOCATIONS ARE
APPROXIMATE. CONTACT THE LOCAL ONE
CALL AGENCY 48 HOURS PRIOR
TO CONSTRUCTION FOR EXACT
UTILITY LOCATIONS AT :**

1-800-227-2600

DRAWING DISCLAIMER

FACILITY LOCATIONS ARE GENERAL IN NATURE
WILLIAMS WILL NOT BE HELD ACCOUNTABLE FOR
THE ACCURACY OF THE INFORMATION PROVIDED
ON THESE DRAWINGS.


PRELIMINARY

[illegible]

96	-	LEAF FIBER, LOOSE BUFFER TUBE CABLE, 12 FIBERS PER TUBE, DIELECTRIC CENTRAL MEMBER, DUAL JACKET SINGLE ARMOR, 1000 LB TENSILE STRENGTH
		REEL # N/A
		N/A
		1200' 1-1.5" ID HDPE, 1-1.5" ID HDPE (SPARE), 1-1.25" ID HDPE (SPARE)

CABLE FIBER COUNT MFR. TYPE OF GLASS	CABLE
CABLE SERIAL NO.	DESCRIPTION
SPLICED TO SPLICED CABLE LENGTH IN COIL LENGTH	
INSULATION & TYPE (CONG./SHOWN/COILED)	PIPE &
STEEL PIPE SIZE	INSULATION
PVC	PLACEMENT
FUTURE-2	
FUTURE-3	FUTURE
FUTURE-4	PIPE

		COMMUNICATIONS GROUP Network Services	
POINT ARENA TO SACRAMENTO CABLE ROUTE			
DRAWN BY : MMC		DATE : 08/25/00	
CHECKED BY : MHW		DATE : 08/29/00	
APPROVED BY :		DATE :	
APPROVED BY :		DATE :	
AGE : 4827		LPC CODE :	
HORIZONTAL SCALE (HWD & PROF) : 1"=100'			
VERTICAL SCALE (HWD) :			
VERTICAL SCALE (PROF) :			
MAP PROJECTION :			
DRAWING NUMBER : SHEET -- 38			

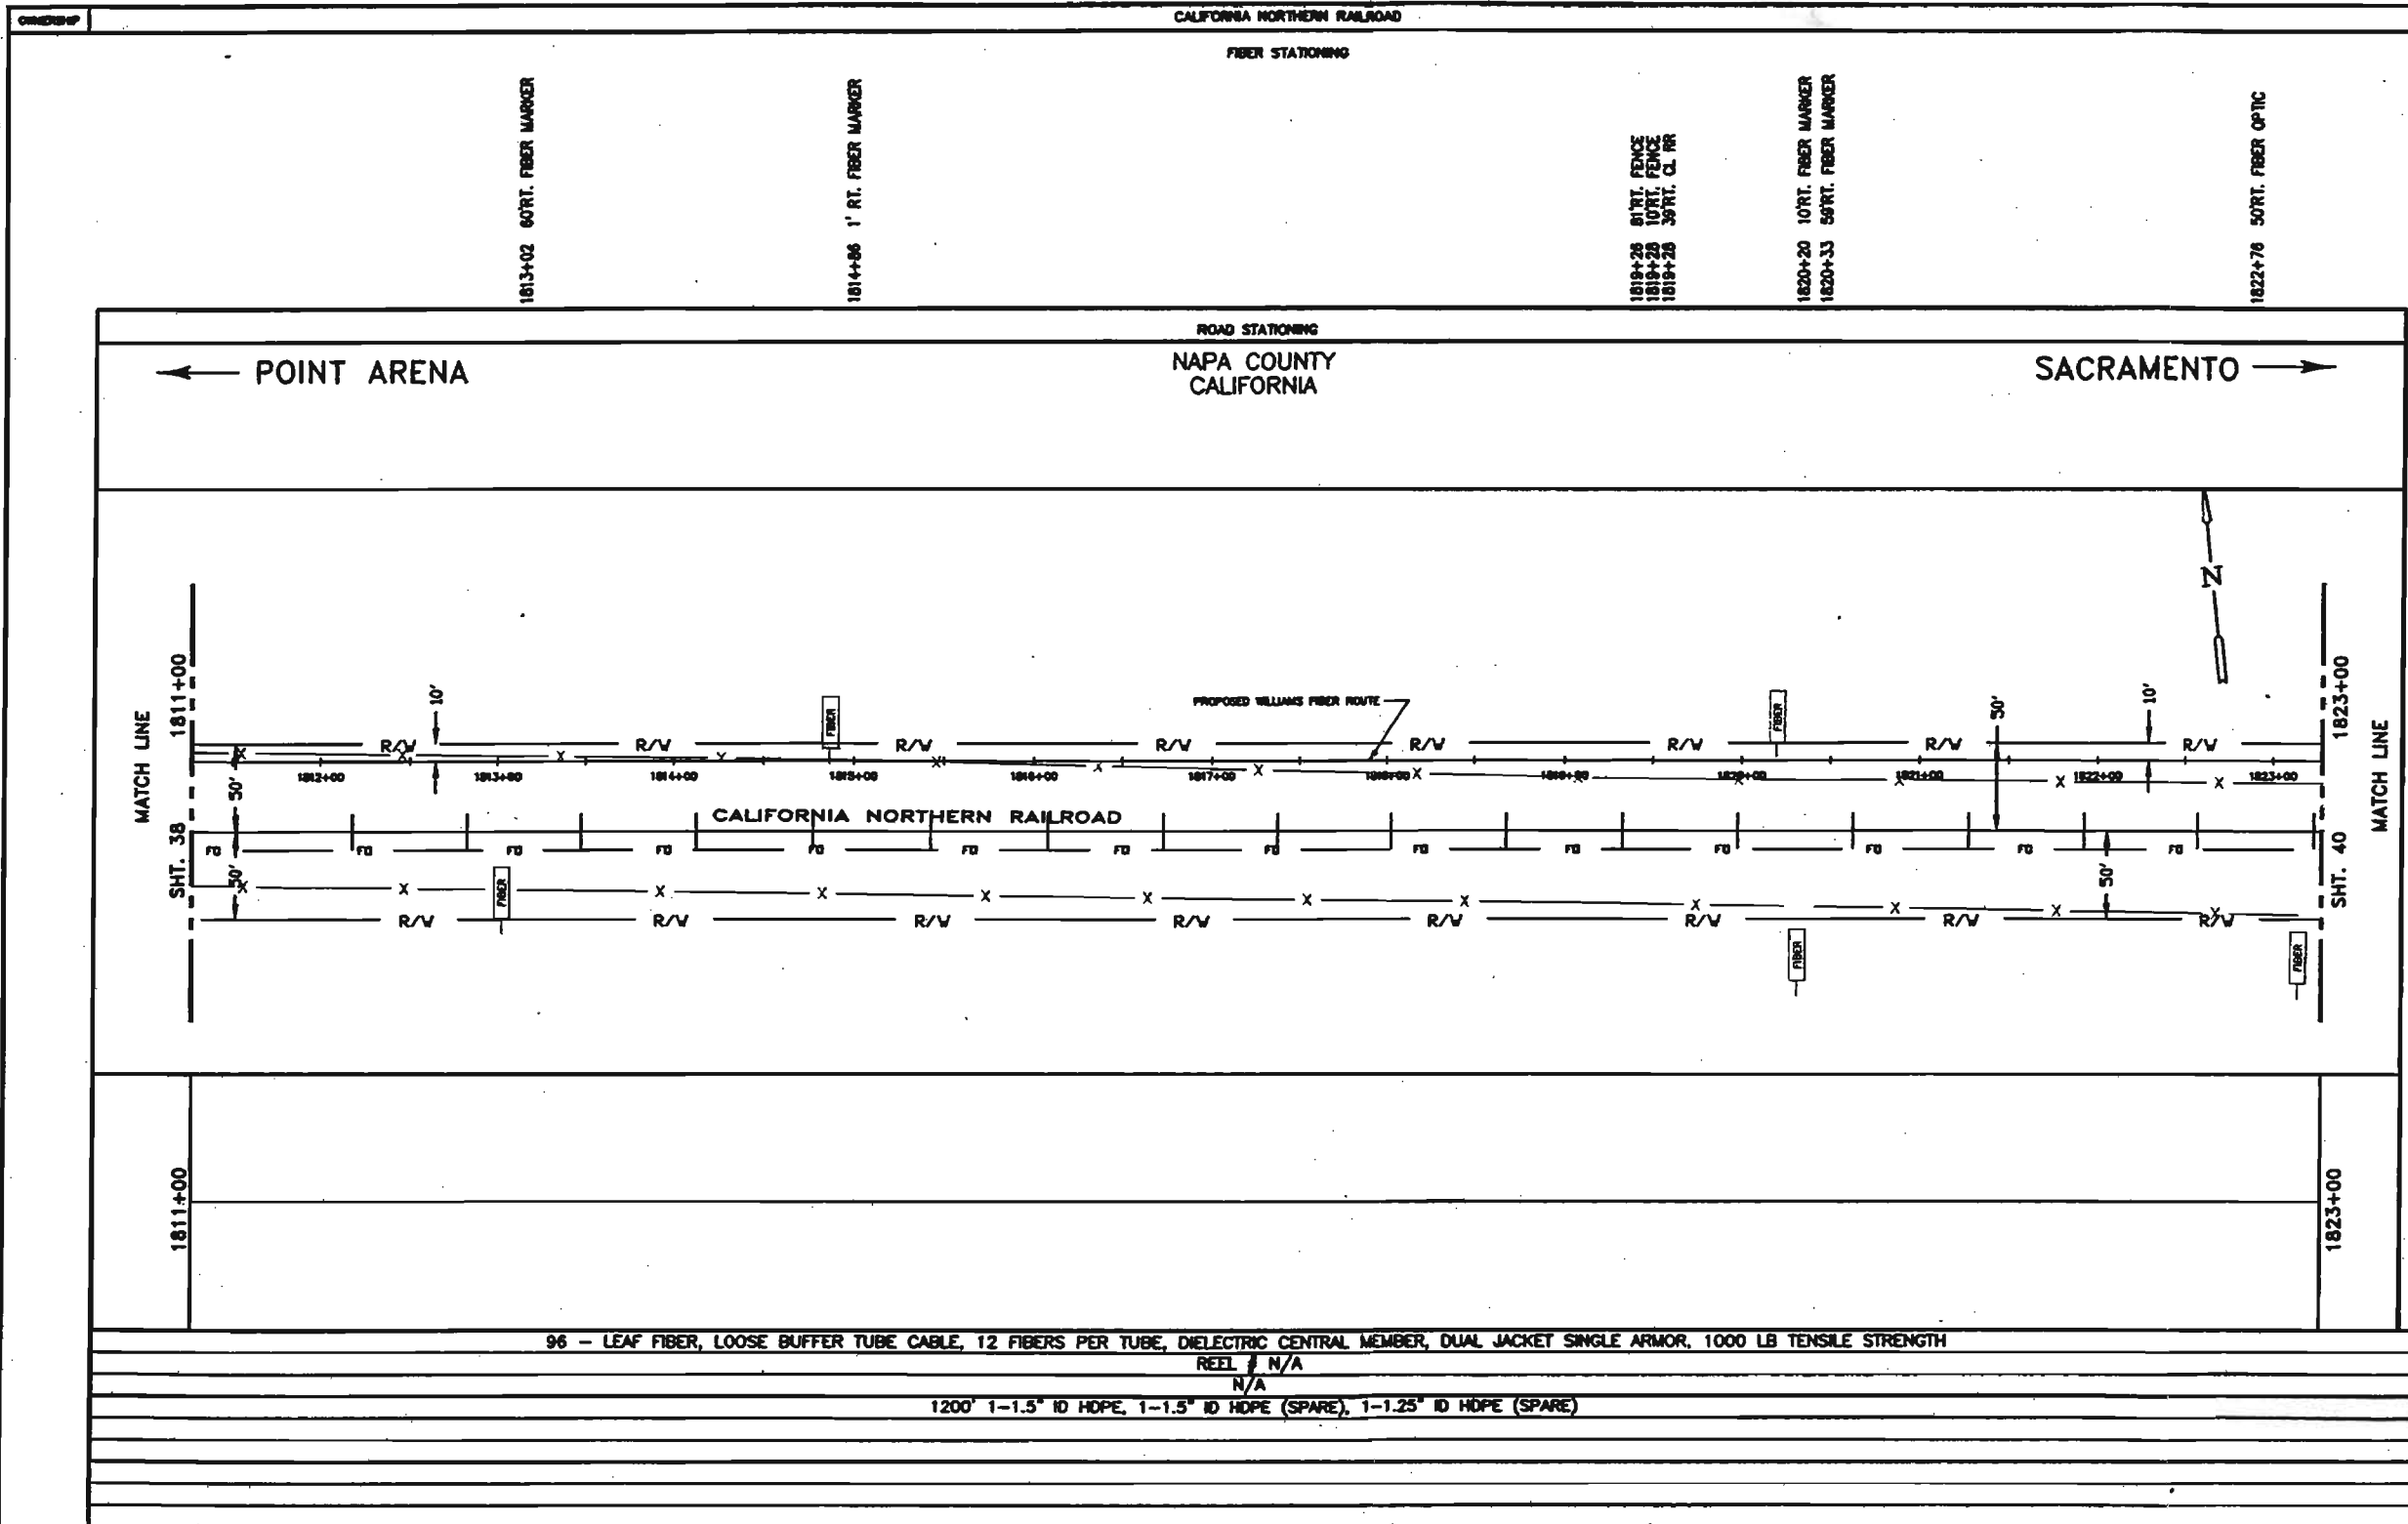

LEGEND

Interstate Hwy.
U.S. Hwy.
State Hwy.
County Road
RR Mile Mkr.
Mile Road Sign
New Fiber Cable
Trenching Line
City Limits
R/W Line
River/Stream
CL Road
CL RR Tracks
Fence
Oil Pipeline
Gas Pipeline
Power Line
Water Line
San. Sewer
Storm Drain
Telephone Line
Black Iron Pipe
Galvanized Iron Pipe
Edge of Pavement
Edge of Gravel
Face of Curb
Fog Line and/or White Line

Region Site
P.O.P./Jct.
Handhole Splice
Handhole
Handhole Splice
Handhole
25 Handhole
Power Pole
Water Valve / Meter
Gas Valve / Meter
Signal Pole
Fire Hydrant
One Marker
Oil Marker
Fiber Marker
Water Inlet

WILLIAMS

EMERGENCY NOTIFICATION NUMBER
1-800-582-9089

CAUTION

WILLIAMS LOCATE & FOR
COUNTY, STATE
1-888-945-2235

FOREIGN UTILITY LOCATIONS ARE
APPROXIMATE. CONTACT THE LOCAL ONE
CALL AGENCY 48 HOURS PRIOR
TO CONSTRUCTION FOR EXACT
UTILITY LOCATIONS AT :
1-800-227-2600

DRAWING DISCLAIMER

FACILITY LOCATIONS ARE GENERAL IN NATURE
WILLIAMS WILL NOT BE HELD ACCOUNTABLE FOR
THE ACCURACY OF THE INFORMATION PROVIDED
ON THESE DRAWINGS.

PRELIMINARY

REV. NO.	DESCRIPTION	BY	DATE

CABLE FIBER COUNT, MFG. TYPE OF GLASS	CABLE DESCRIPTION
CABLE REEL NO.	
SPACE TO SPACE CABLE LENGTH & COIL LENGTH	
INSULATION & TYPE (CONC/SMOOTH/COLOR)	PIPE & INVERT
STEEL PIPE SIZE	PLACEMENT
PVC	
FUTURE-2	FUTURE
FUTURE-3	WAY
FUTURE-4	PLACE

COMMUNICATIONS GROUP
National Services


**POINT ARENA TO SACRAMENTO
CABLE ROUTE**

DRAWN BY: HNC DATE: 08/28/00
CHECKED BY: MNY DATE: 08/29/00
APPROVED BY: DATE:
APPROVED BY: DATE:

AFE: 4877 LSC CODE:

HORIZONTAL SCALE (DWG & PROF): 1"=100'
VERTICAL SCALE (DWG):
VERTICAL SCALE (PROF):
MAP PROJECTION:

DRAWING NUMBER: SHEET - 39

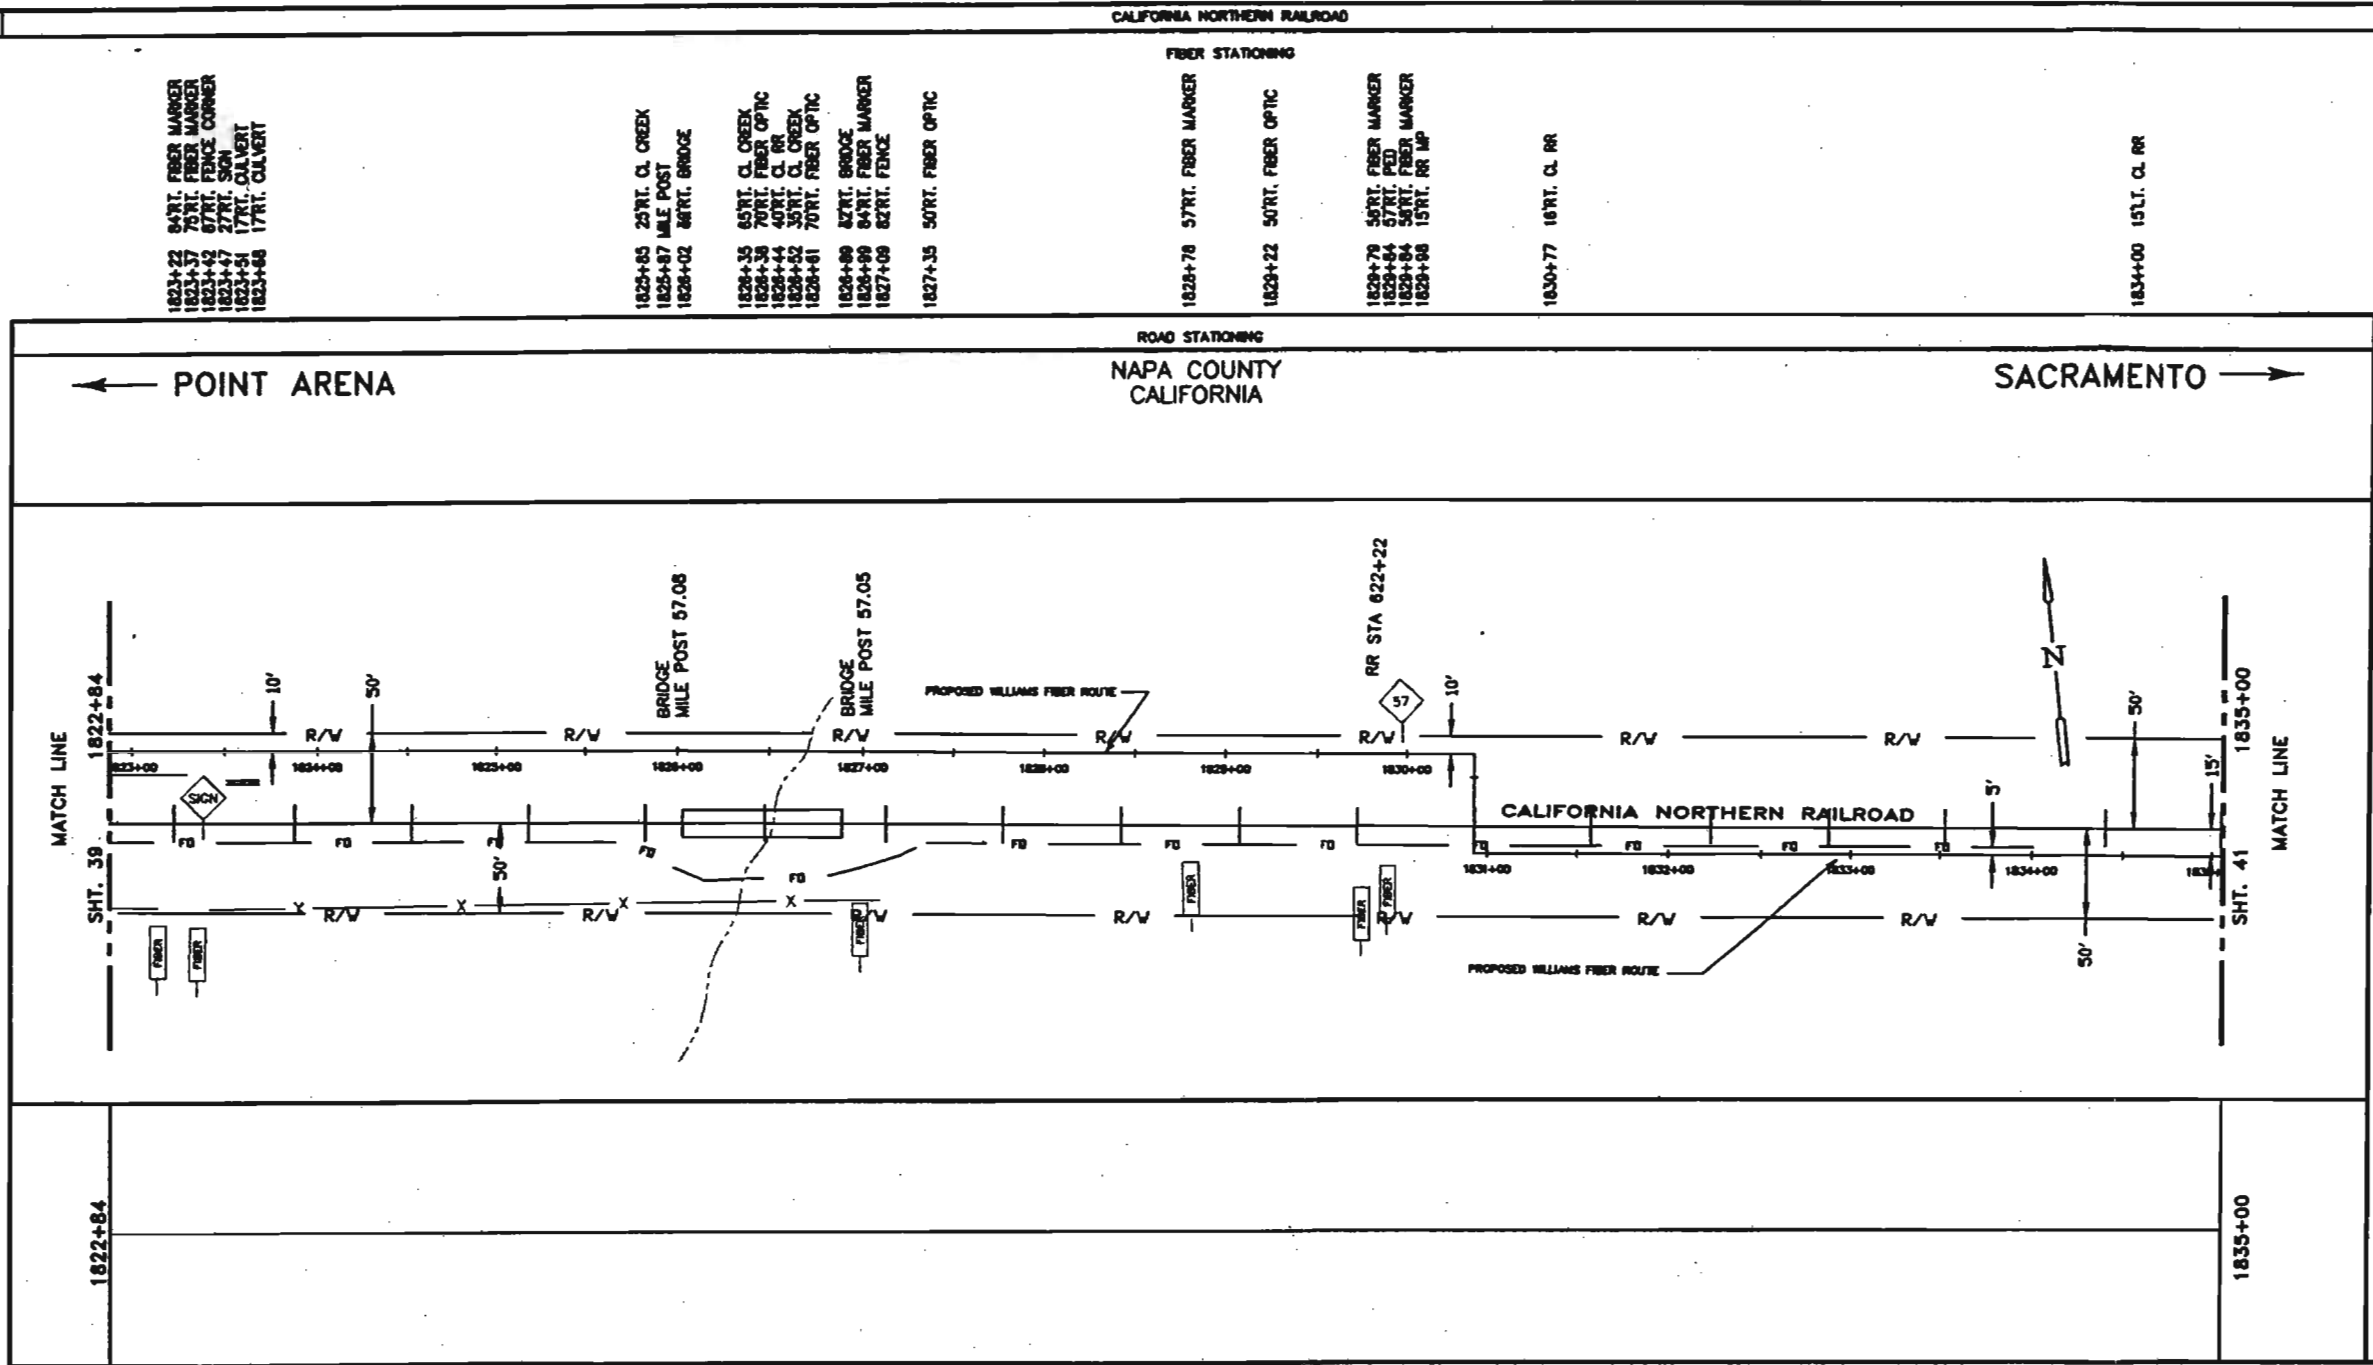

1823+22 84' RT. FIBER MARKER
1823+37 70' RT. FIBER MARKER
1823+42 67' RT. FENCE CORNER
1823+47 27' RT. SIGN
1823+51 17' RT. CULVERT
1823+68 17' RT. CULVERT

1825+05 25' RT. CL CREEK
1825+87 MILE POST
1826+02 84' RT. BRIDGE

1826+35 65' RT. CL CREEK
1826+38 70' RT. FIBER OPTIC
1826+44 40' RT. CL RR
1826+52 35' RT. CL CREEK
1826+61 70' RT. FIBER OPTIC

1826+88 42' RT. BRIDGE
1826+89 84' RT. FIBER MARKER
1827+08 62' RT. FENCE
1827+35 50' RT. FIBER OPTIC

FIBER STATIONING
1828+78 57' RT. FIBER MARKER
1829+22 50' RT. FIBER OPTIC
1829+78 50' RT. FIBER MARKER
1829+84 57' RT. FIBER MARKER
1829+86 50' RT. FIBER MARKER
1829+88 15' RT. RR MP

1830+77 16' RT. CL RR
1834+00 15' RT. CL RR

ROAD STATIONING
NAPA COUNTY
CALIFORNIA

← POINT ARENA NAPA COUNTY CALIFORNIA SACRAMENTO →

LEGEND	
	Interstate Hwy.
	U.S. Hwy.
	State Hwy.
	County Road
	RR Mile Marker
	Min. Road Sign
	New Fiber Cable
	Remains Line
	City Limits
	R/W Line
	River/Stream
	CL Road
	CL RR Tracks
	Fence
	Gas Pipeline
	Gas Pipeline
	Power Line
	Water Line
	San. Sewer
	Storm Drain
	Telephone Line
	B.I.P.
	C.I.P.
	EP
	ES
	FC
	FL
	Right of Way
	P.O.P./Jct.
	Handhole Splice
	Handhole Splice
	Handhole
	SS Handhole
	Power Pole
	San Valve / Meter
	Signal Pole
	Fire Hydrant
	Gas Marker
	Oil Marker
	Fiber Marker
	Water Inlet

WILLIAMS
EMERGENCY NOTIFICATION NUMBER
1-800-582-9088

CAUTION
WILLIAMS LOCATE & FOR
COUNTY, STATE
1-888-945-2255

FOREIGN UTILITY LOCATIONS ARE
APPROXIMATE. CONTACT THE LOCAL ONE
CALL AGENCY 48 HOURS PRIOR
TO CONSTRUCTION FOR EXACT
UTILITY LOCATIONS AT:
1-800-227-1500

DRAWING DISCLAIMER
FACILITY LOCATIONS ARE GENERAL IN NATURE
WILLIAMS WILL NOT BE HELD ACCOUNTABLE FOR
THE ACCURACY OF THE INFORMATION PROVIDED
ON THESE DRAWINGS.

PRELIMINARY

REVISIONS			
REV. NO.	DESCRIPTION	BY	DATE
1	REVISION HERE	THE	5/25/00

96 - LEAF FIBER, LOOSE BUFFER TUBE CABLE, 12 FIBERS PER TUBE, DIELECTRIC CENTRAL MEMBER, DUAL JACKET SINGLE ARMOR, 1000 LB TENSILE STRENGTH.	
REEL # N/A	
N/A	
1200' 1-1.5" ID HOPE, 1-1.5" ID HOPE (SPARE), 1-1.25" ID HOPE (SPARE)	

CABLE FIBER COUNT MFR. TYPE OF GLASS	CABLE DESCRIPTION
CABLE REEL NO.	
SPACE TO SPACE CABLE LENGTH & COIL LENGTH	PIPE & SPORE/PLACEMENT
SPACING & TYPE (CONC/SHOULDER/COLOR)	
STEEL PIPE SIZE	FUTURE PIPE PLACE
PVC	
FUTURE-2	
FUTURE-3	
FUTURE-4	

COMMUNICATIONS GROUP
Suburban Services

**POINT ARENA TO SACRAMENTO
CABLE ROUTE**

DRAWN BY: MHC	DATE: 06/23/00
CHECKED BY: MHW	DATE: 06/23/00
APPROVED BY:	DATE:
DATE:	DATE:

MPE: 4877 LOC. CODE:


HORIZONTAL SCALE (DWG & PROF): 1"=100'

VERTICAL SCALE (DWG):

VERTICAL SCALE (PROF):

MAP PROJECTION:

DRAWING NUMBER: SHEET - 40

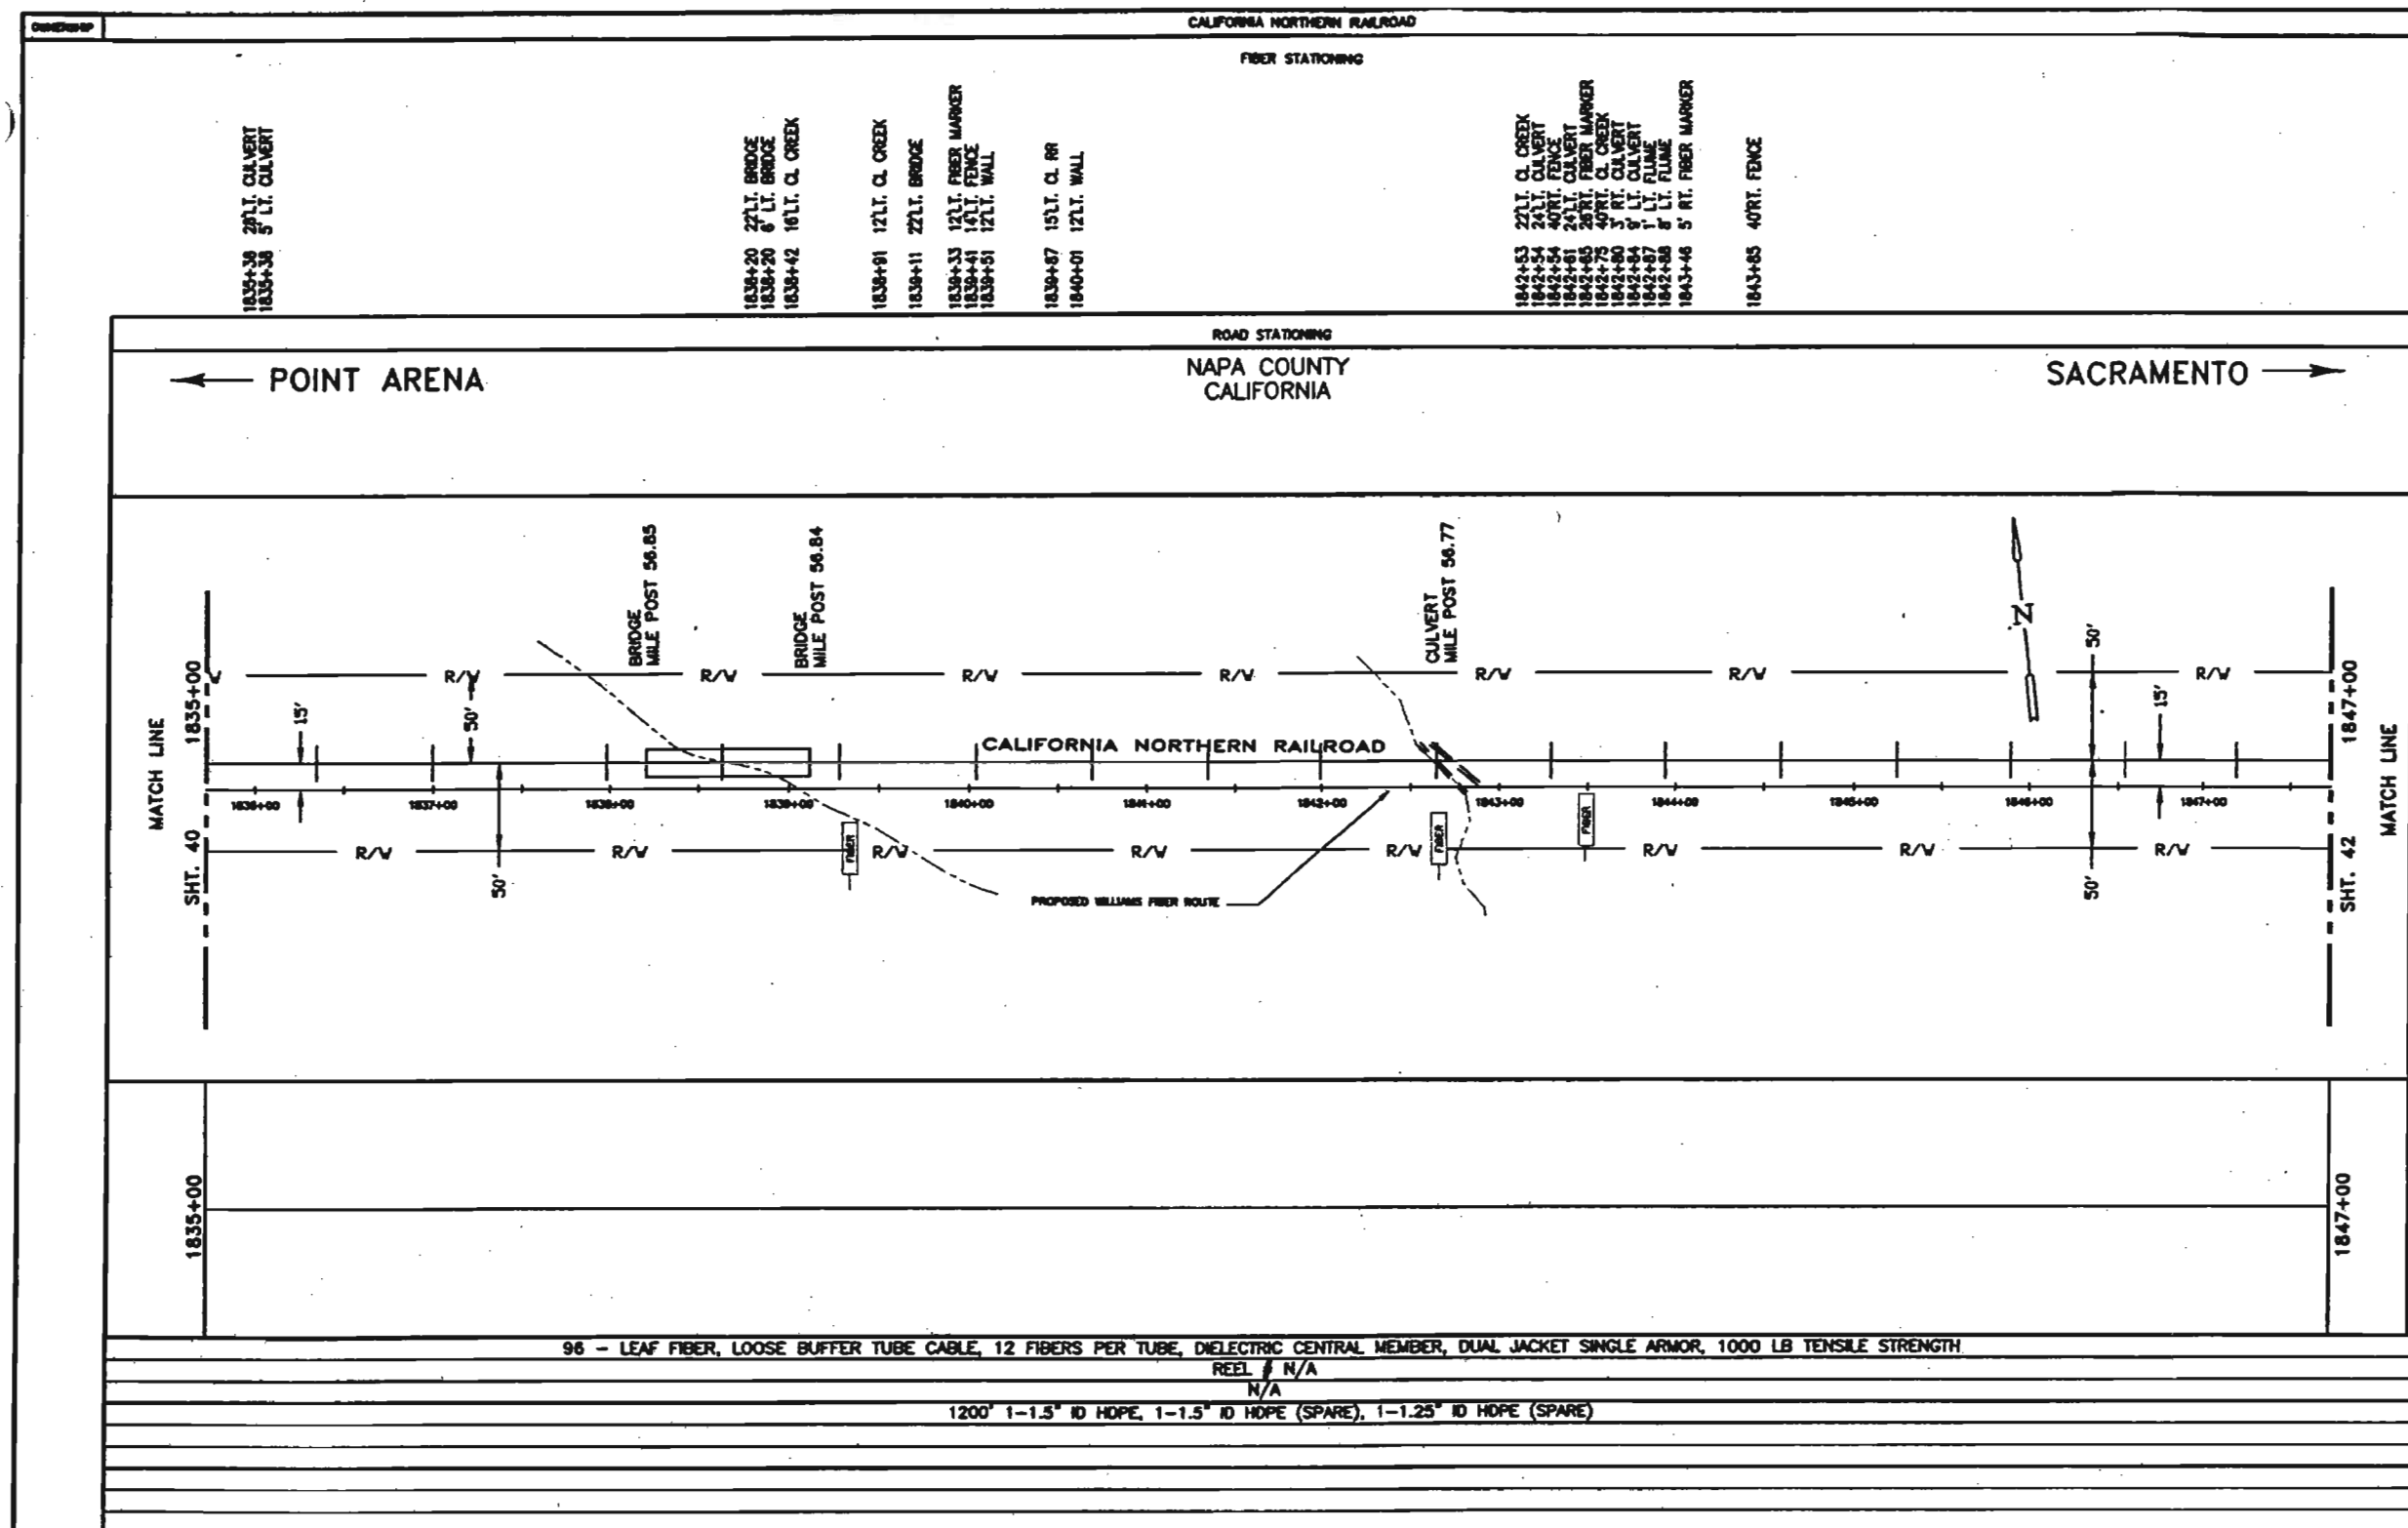

LEGEND

Interstate Hwy.	Region Site
U.S. Hwy.	P.A.P./Aut.
State Hwy.	Handhole Splice
County Road	Handhole
RR Mile Mkr.	Handhole Splice
Min. Road Sign	Handhole
New Fiber Cable	25' Markhole
Trenching Line	Power Pole
City Limits	Water Valve / Meter
R/W Line	Gas Valve / Meter
Street/Stream	Signal Pole
CL Road	Fire Hydrant
CL RR Tracks	Gas Marker
Fence	Oil Marker
Oil Pipeline	Oil Marker
Gas Pipeline	Oil Marker
Power Line	Water Inlet
Water Line	
Sew. Storm	
Storm Drain	
Telephone Line	
Black Iron Pipe	
Galvanized Iron Pipe	
Edge of Pavement	
Edge of Gravel	
Form of Curb	
FL	Fog Line and/or White Line

WILLIAMS
EMERGENCY NOTIFICATION NUMBER
1-800-582-8089

CAUTION
WILLIAMS LOCATE & FOR
COUNTY, STATE
1-888-943-2255
FOREIGN UTILITY LOCATIONS ARE
APPROXIMATE. CONTACT THE LOCAL ONE
CALL AGENCY 48 HOURS PRIOR
TO CONSTRUCTION FOR EXACT
UTILITY LOCATIONS AT :
1-800-227-2600

DRAWING DISCLAIMER
FACILITY LOCATIONS ARE GENERAL IN NATURE
WILLIAMS WILL NOT BE HELD ACCOUNTABLE FOR
THE ACCURACY OF THE INFORMATION PROVIDED
ON THESE DRAWINGS.

PRELIMINARY

REV. NO.	DESCRIPTION	BY	DATE

CABLE REEL NO.	CABLE DESCRIPTION


PIPE & INDUCT PLACEMENT	PIPE & INDUCT PLACE

COMMUNICATIONS GROUP
Robert Burdick

**POINT ARENA TO SACRAMENTO
CABLE ROUTE**

DRAWN BY : NMC	DATE : 08/25/00
CHECKED BY : NMC	DATE : 08/29/00
APPROVED BY : NMC	DATE :
APPROVED BY : NMC	DATE :
APR : 4577	LOC. CODE :
HORIZONTAL SCALE (HWS & PROF) : 1"=100'	
VERTICAL SCALE (VWS) :	
VERTICAL SCALE (VWP) :	
MAP PROJECTION :	

DRAWING NUMBER : SHEET - 41

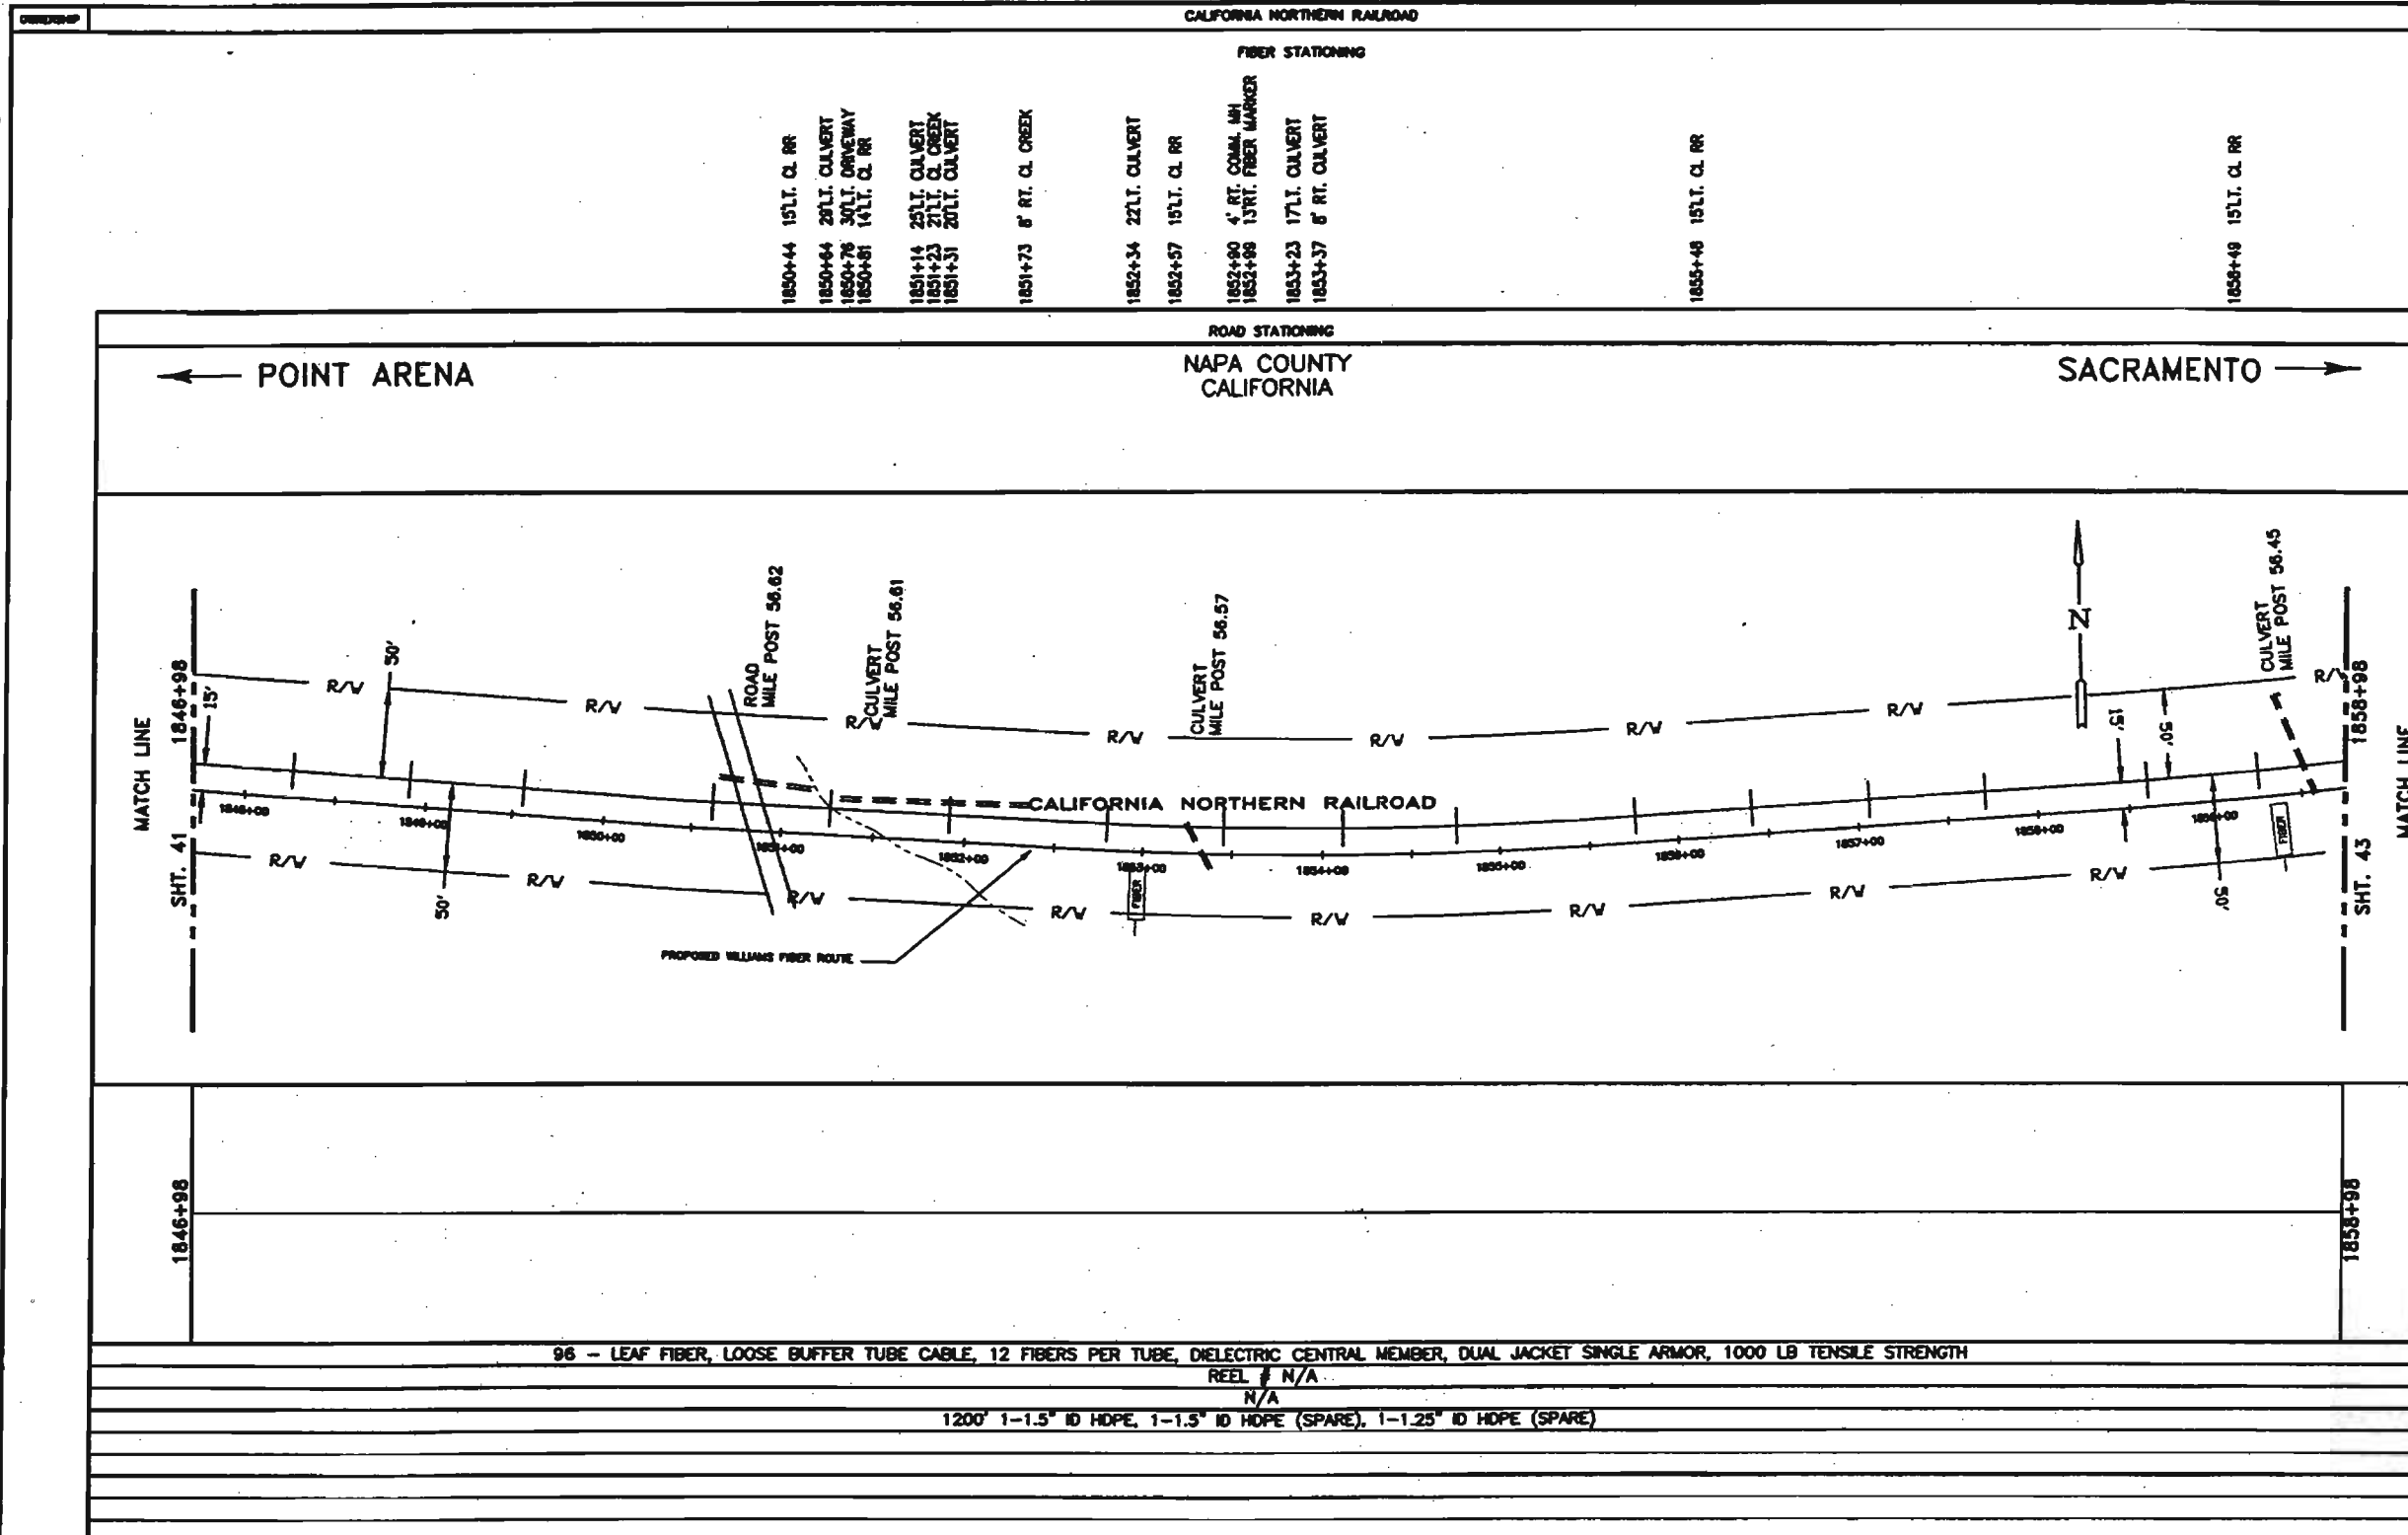

LEGEND	
	Interstate Hwy.
	U.S. Hwy.
	State Hwy.
	County Road
	RR Mile Mkr.
	Min. Road Sign
	New Fiber Cable
	Temporary Line
	City Limits
	R/W Line
	River/Stream
	CL Road
	CL RR Tracks
	Fence
	Oil Pipeline
	Gas Pipeline
	Power Line
	Water Line
	Sew. Sewer
	Storm Drain
	Telephone Line
	Black Iron Pipe
	Galvanized Iron Pipe
	Edge of Pavement
	Edge of Gravel
	Face of Curb
	Flag Line and/or White Line
	Right-of-Way Site
	P.O.P./Jct.
	Handhole Splice
	Handhole
	Manhole Splice
	Manhole
	30' Manhole
	Power Pole
	Water Valve / Meter
	Signal Pole
	Fire Hydrant
	Gas Marker
	Oil Marker
	Fiber Marker
	Water Inlet

WILLIAMS

EMERGENCY NOTIFICATION NUMBER
1-800-582-9089

CAUTION

WILLIAMS LOCATE & FOR
COUNTY, STATE
1-888-945-2255

FOREIGN UTILITY LOCATIONS ARE
APPROXIMATE. CONTACT THE LOCAL ONE
CALL AGENCY 48 HOURS PRIOR
TO CONSTRUCTION FOR EXACT
UTILITY LOCATIONS AT :
1-800-227-2800

DRAWING DISCLAIMER

FACILITY LOCATIONS ARE GENERAL IN NATURE
WILLIAMS WILL NOT BE HELD ACCOUNTABLE FOR
THE ACCURACY OF THE INFORMATION PROVIDED
ON THESE DRAWINGS.

PRELIMINARY

REVISIONS			
REV. NO.	DESCRIPTION	BY	DATE

CABLE FIBER COUNT, MFG. TYPE OF GLASS	CABLE
CABLE REEL NO.	DESCRIPTION
SPICE TO SPICE CABLE LENGTH & CBL. LENGTH	
WIREMANT & TYPE (COND./SMOOTH/COLOR)	PIPE & WIREMANT PLACEMENT
STEEL PIPE SIZE	
PVC	
FUTURE-2	FUTURE
FUTURE-3	WIRE
FUTURE-4	PLACE


 COMMUNICATIONS GROUP
Subcontract Services

**POINT ARENA TO SACRAMENTO
CABLE ROUTE**

DRAWN BY : HNC	DATE : 08/25/00
CHECKED BY : MHW	DATE : 08/29/00
APPROVED BY :	DATE :
APPROVED BY :	DATE :

AFE : 4877 LOC. CODE :
HORIZONTAL SCALE (HWS & FWS) : 1"=100'
VERTICAL SCALE (VWS) :
VERTICAL SCALE (VWS) :
MAP PROJECTION :

DRAWING NUMBER : SHEET - 42

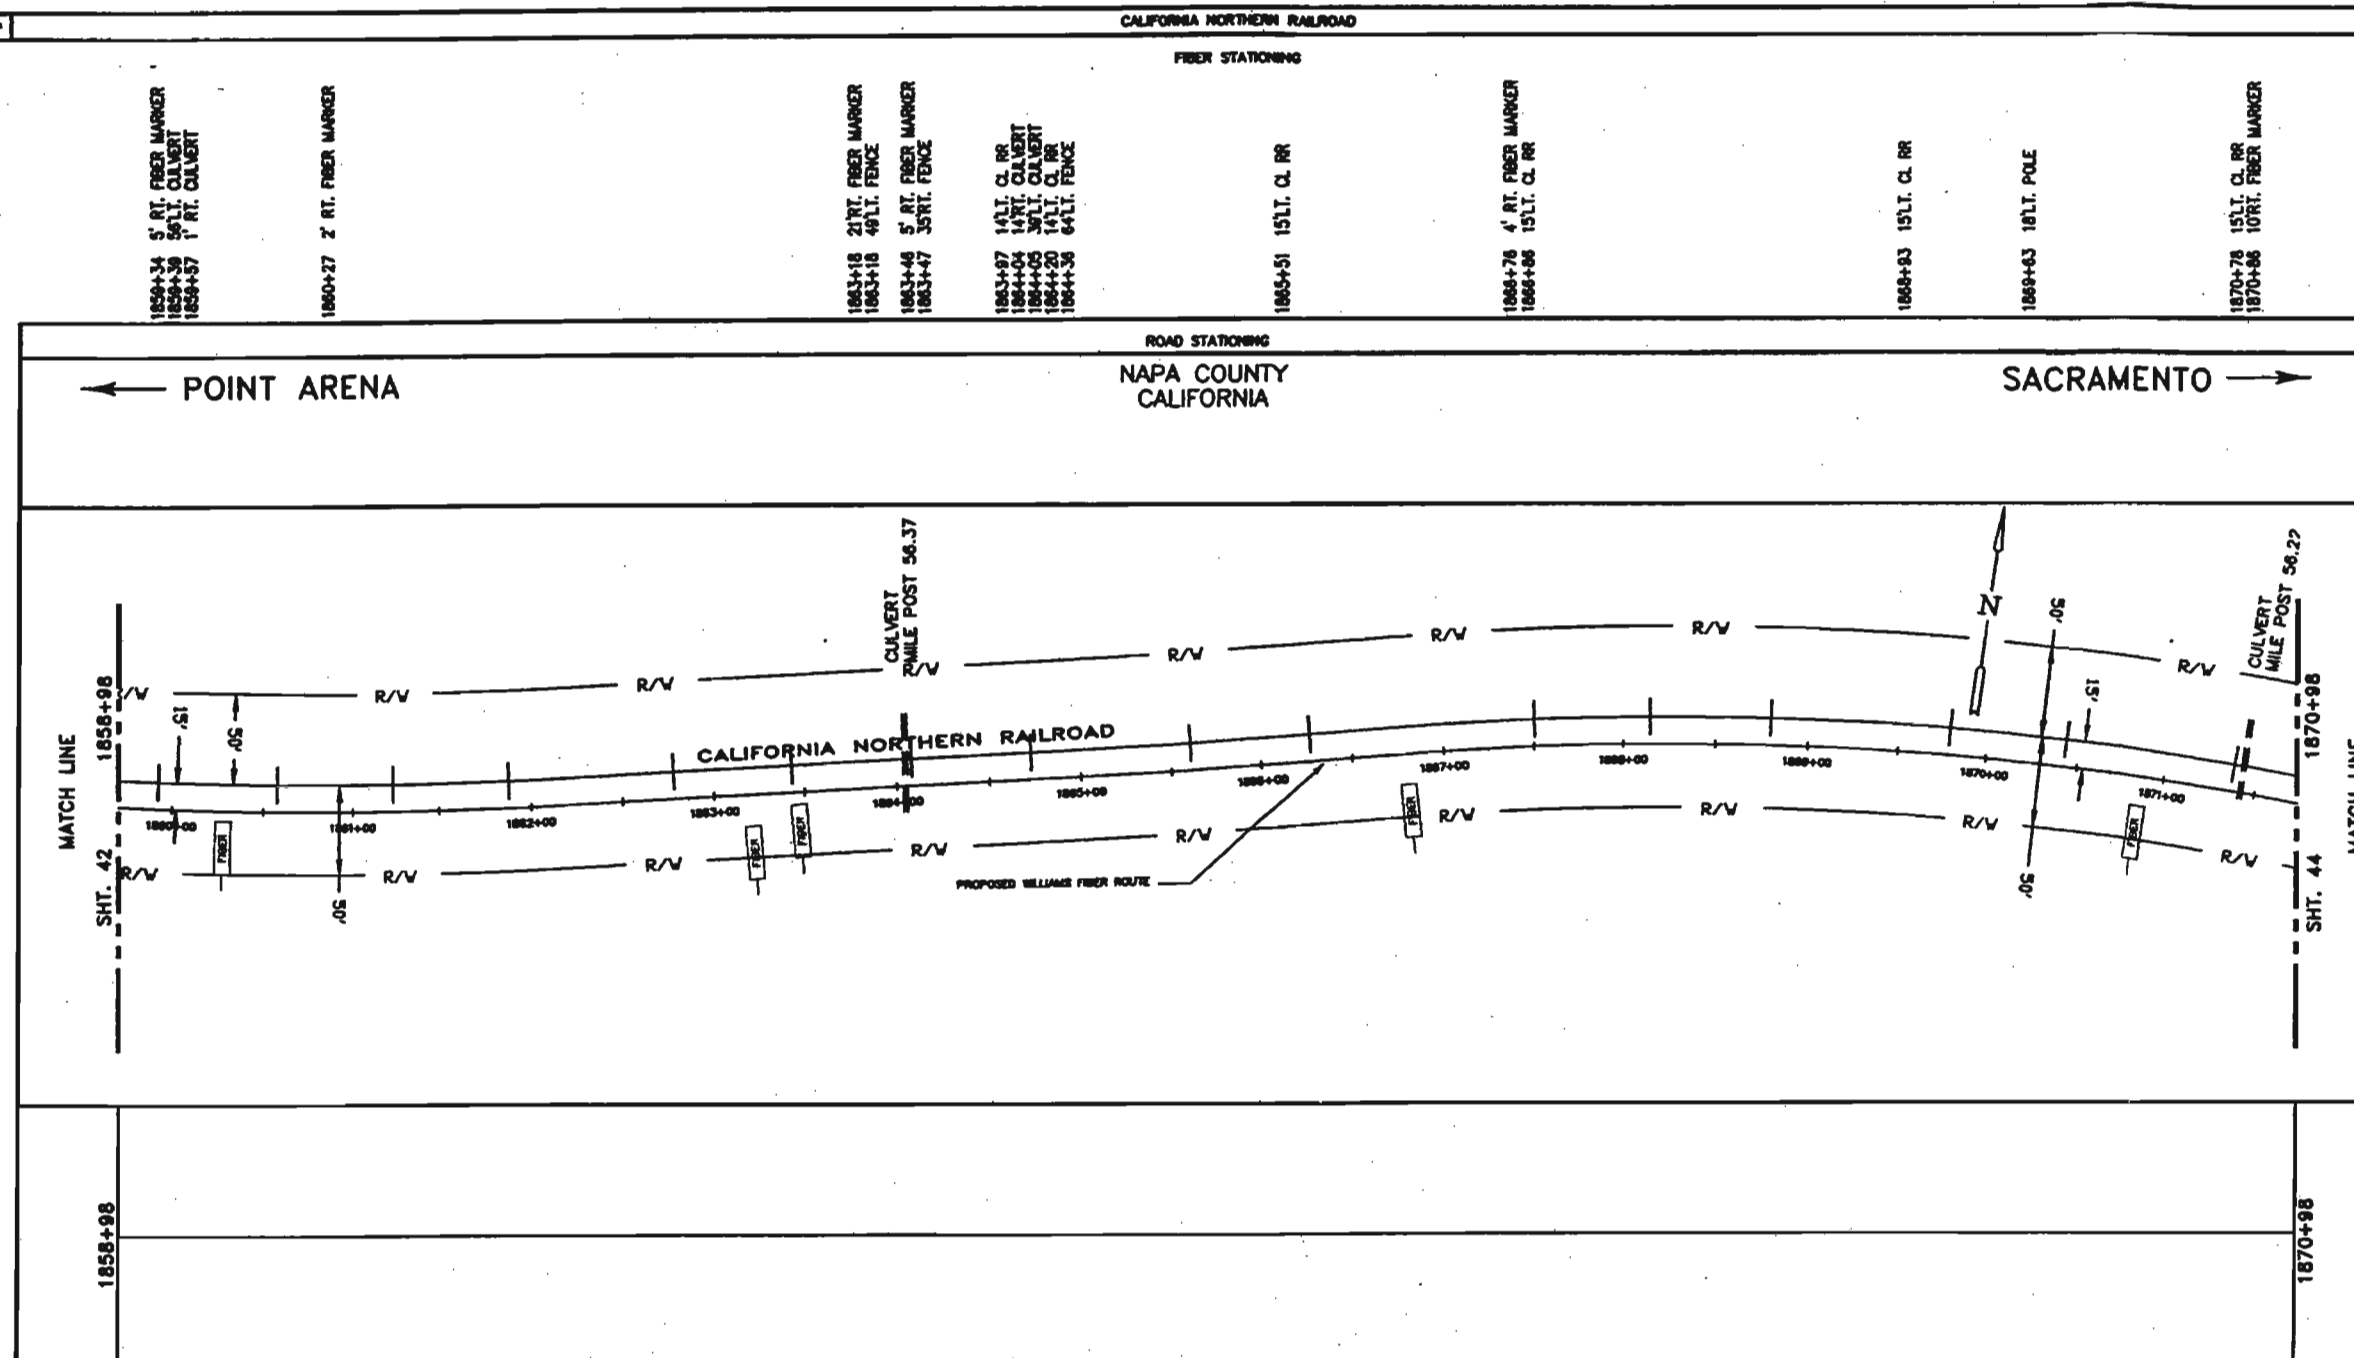

96	- LEAF FIBER, LOOSE BUFFER TUBE CABLE, 12 FIBERS PER TUBE, DIELECTRIC CENTRAL MEMBER, DUAL JACKET SINGLE ARMOR, 1000 LB TENSILE STRENGTH
	REEL # N/A
	N/A
	1200' 1-1.5" ID HDPE, 1-1.5" ID HDPE (SPARE), 1-1.25" ID HDPE (SPARE)

LEGEND

	Interstate Hwy.		Regen Site
	U.S. Hwy.		P.O.P./Int.
	State Hwy.		Manhole Spline
	County Road		Manhole
	RR Mile Marker		Manhole Spline
	Max. Road Sign		Manhole
	New Fiber Cable		SG Manhole
	Township Line		Water Valve / Meter
	City Limits		Gas Valve / Meter
	R/W Line		Signal Pole
	River/Stream		Fire Hydrant
	CL Road		Gas Marker
	CL RR Tracks		Oil Marker
	Fence		Fiber Marker
	Oil Pipeline		Water Inlet
	Gas Pipeline		
	Power Line		
	Water Line		
	Sewer		
	Storm Drain		
	Telephone Line		
	Black Iron Pipe		
	Galvanized Iron Pipe		
	Edge of Pavement		
	Edge of Grout		
	Face of Curb		
	Fog Line and/or White Line		

WILLIAMS
EMERGENCY NOTIFICATION NUMBER
1-800-582-8089

CAUTION

**WILLIAMS LOCATE & FOR
COUNTY, STATE
1-888-945-2255**

**FOREIGN UTILITY LOCATIONS ARE
APPROXIMATE. CONTACT THE LOCAL ONE
CALL AGENCY 48 HOURS PRIOR
TO CONSTRUCTION FOR EXACT
UTILITY LOCATIONS AT :**

1-800-227-2600

DRAWING DISCLAIMER


FACILITY LOCATIONS ARE GENERAL IN NATURE
WILLIAMS WILL NOT BE HELD ACCOUNTABLE FOR
THE ACCURACY OF THE INFORMATION PROVIDED
ON THESE DRAWINGS.

PRELIMINARY

[illegible]

CABLE FIBER COUNT MFG. TYPE OF GLASS	CABLE SECTION
CABLE REEL NO.	
SPlice TO SPlice CABLE LENGTH & COIL LENGTH	PIPE & INSTRUMENT PLACEMENT
INTERFACET & TYPE (CORE/SHADOW/COLOR)	
STEEL PIPE SIZE	PIPE WELL PLACE
PVC	
POTURE-2	
POTURE-3	
POTURE-4	

		COMMUNICATIONS GROUP Network Services	
POINT ARENA TO SACRAMENTO CABLE ROUTE			
DRAWN BY : HMC		DATE : 06/25/09	
CHECKED BY : MFW		DATE : 06/25/09	
APPROVED BY :		DATE :	
APPROVED BY :		DATE :	
APE : 4877		LAC. CODE :	
HORIZONTAL SCALE (HWS & PWS) : 1"=100'			
VERTICAL SCALE (VWS) :			
VERTICAL SCALE (VPS) :			
MAP PROJECTION :			
SHEET NUMBER : SHEET - 43			

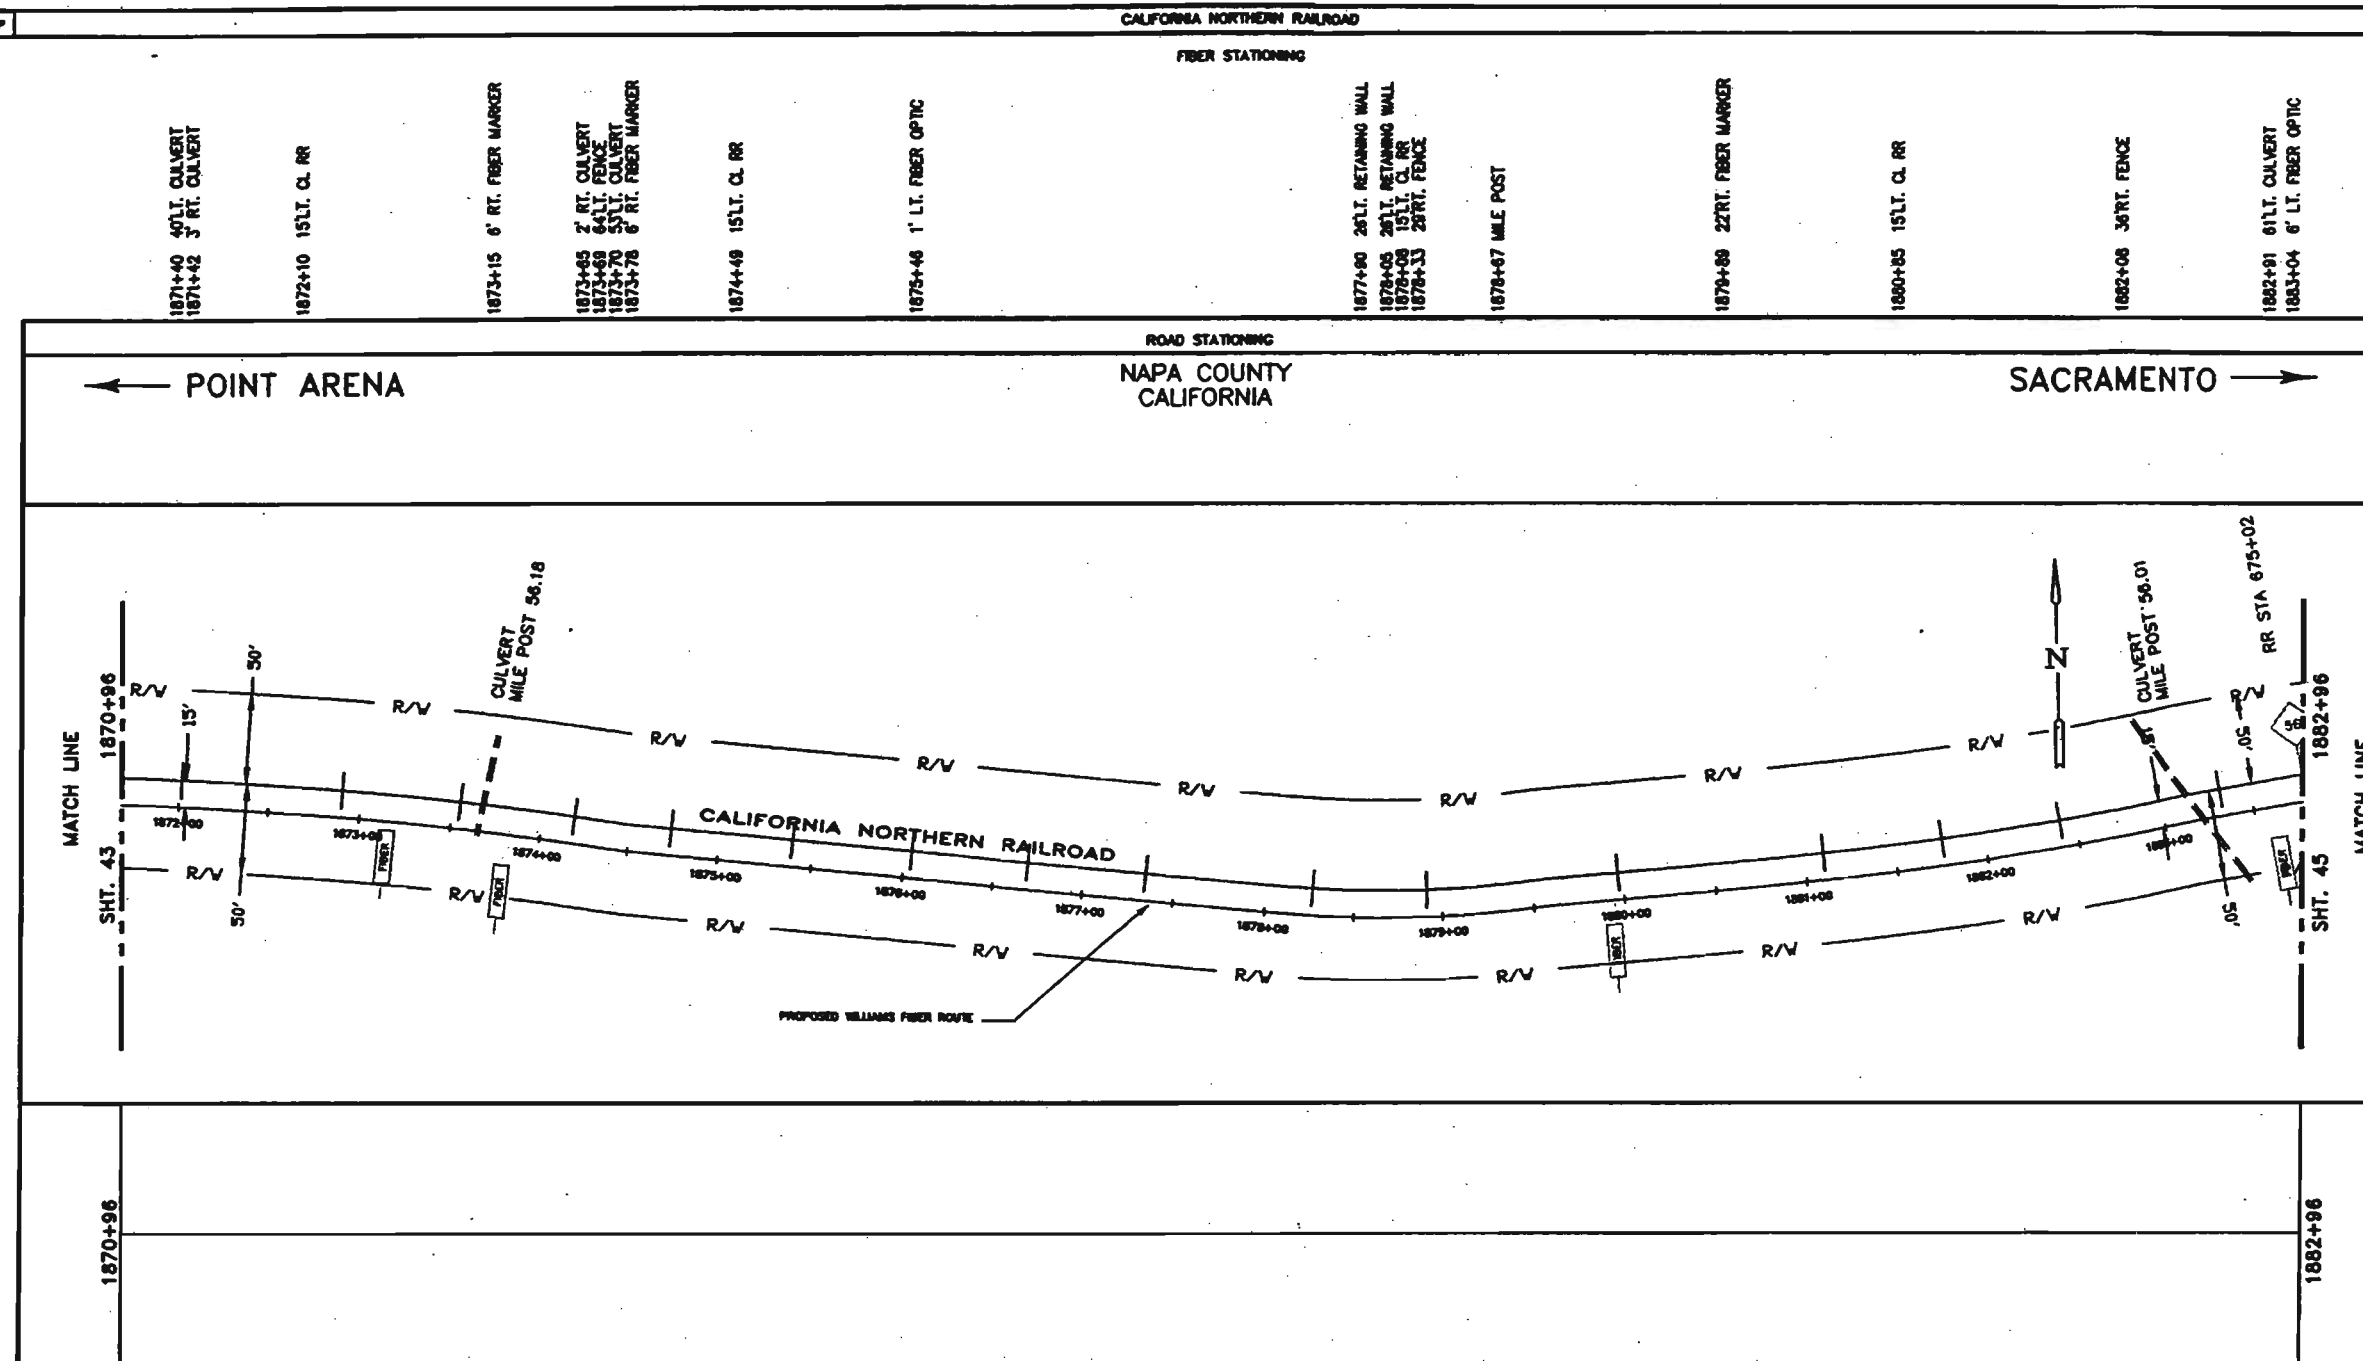

96	- LEAF FIBER, LOOSE BUFFER TUBE CABLE, 12 FIBERS PER TUBE, DIELECTRIC CENTRAL MEMBER, DUAL JACKET SINGLE ARMOR, 1000 LB TENSILE STRENGTH
	REEL N/A
	N/A
	1200' 1-1.5" ID HDPE, 1-1.5" ID HDPE (SPARE), 1-1.25" ID HDPE (SPARE)

LEGEND

	Interstate Hwy.		Region 8
	U.S. Hwy.		P.O.P./Jct.
	State Hwy.		Mainstate Splice
	County Road		Mainstate
	RR Mile Mkr.		Mainstate Splice
	Mileage Road Sign		Mainstate
	New Fiber Cable		Power Pole
	Township Line		Water Valve / Meter
	City Limits		Gas Valve / Meter
	R/W Line		Signal Pole
	River/Stream		Fire Hydrant
	CL Road		Gas Marker
	CL RR Tracks		Oil Marker
	Fence		Water Marker
	Oil Pipeline		Black Iron Pipe
	Gas Pipeline		Galvanized Iron Pipe
	Power Line		Edge of Pavement
	Water Line		Edge of Gravel
	San. Sewer		Face of Cut
	Storm Drain		Fog Line and/or White Line
	Telephone Line		
	BLP		
	GLP		
	EP		
	EG		
	FC		
	FL		

WILLIAMS
EMERGENCY NOTIFICATION NUMBER
1-800-582-9088

CAUTION

WILLIAMS LOCATE # FOR
COUNTY, STATE
1-888-945-2255

FOREIGN UTILITY LOCATIONS ARE
APPROXIMATE. CONTACT THE LOCAL ONE
CALL AGENCY 48 HOURS PRIOR
TO CONSTRUCTION FOR EXACT
UTILITY LOCATIONS AT :

1-800-227-2800

DRAWING DISCLAIMER


FACILITY LOCATIONS ARE GENERAL IN NATURE
WILLIAMS WILL NOT BE HELD ACCOUNTABLE FOR
THE ACCURACY OF THE INFORMATION PROVIDED
ON THESE DRAWINGS.


PRELIMINARY

[illegible]

CABLE FIBER COUNT W/O. TYPE OF GLASS	CABLE DESCRIPTION
CABLE REEL NO.	
SPACE TO SPACE CABLE LENGTH & COIL LENGTH	PIPE & MINIMUM PLACEMENT
UNDERBUT & TYPE (COAR/SMOOTH/COLOR)	
STEEL PIPE SIZE	PIPE USE PLACE
PVC	
PURPOSE-2	
PURPOSE-3	
PURPOSE-4	

		COMMUNICATION GROUP Midwest Division	
PORT ARENA TO SACRAMENTO CABLE ROUTE			
DRAWN BY : MMC		DATE : 08/25/00	
CHECKED BY : MRW		DATE : 08/25/00	
APPROVED BY :		DATE :	
APPROVED BY :		DATE :	
NPS : 4577		LOC. CODE :	
HORIZONTAL SCALE (HWS & PLAN) : 1"=500'			
VERTICAL SCALE (VWS) :			
VERTICAL SCALE (VWS) :			
MAP PROJECTION :			
STANDARD NUMBER : SHEET - 44			

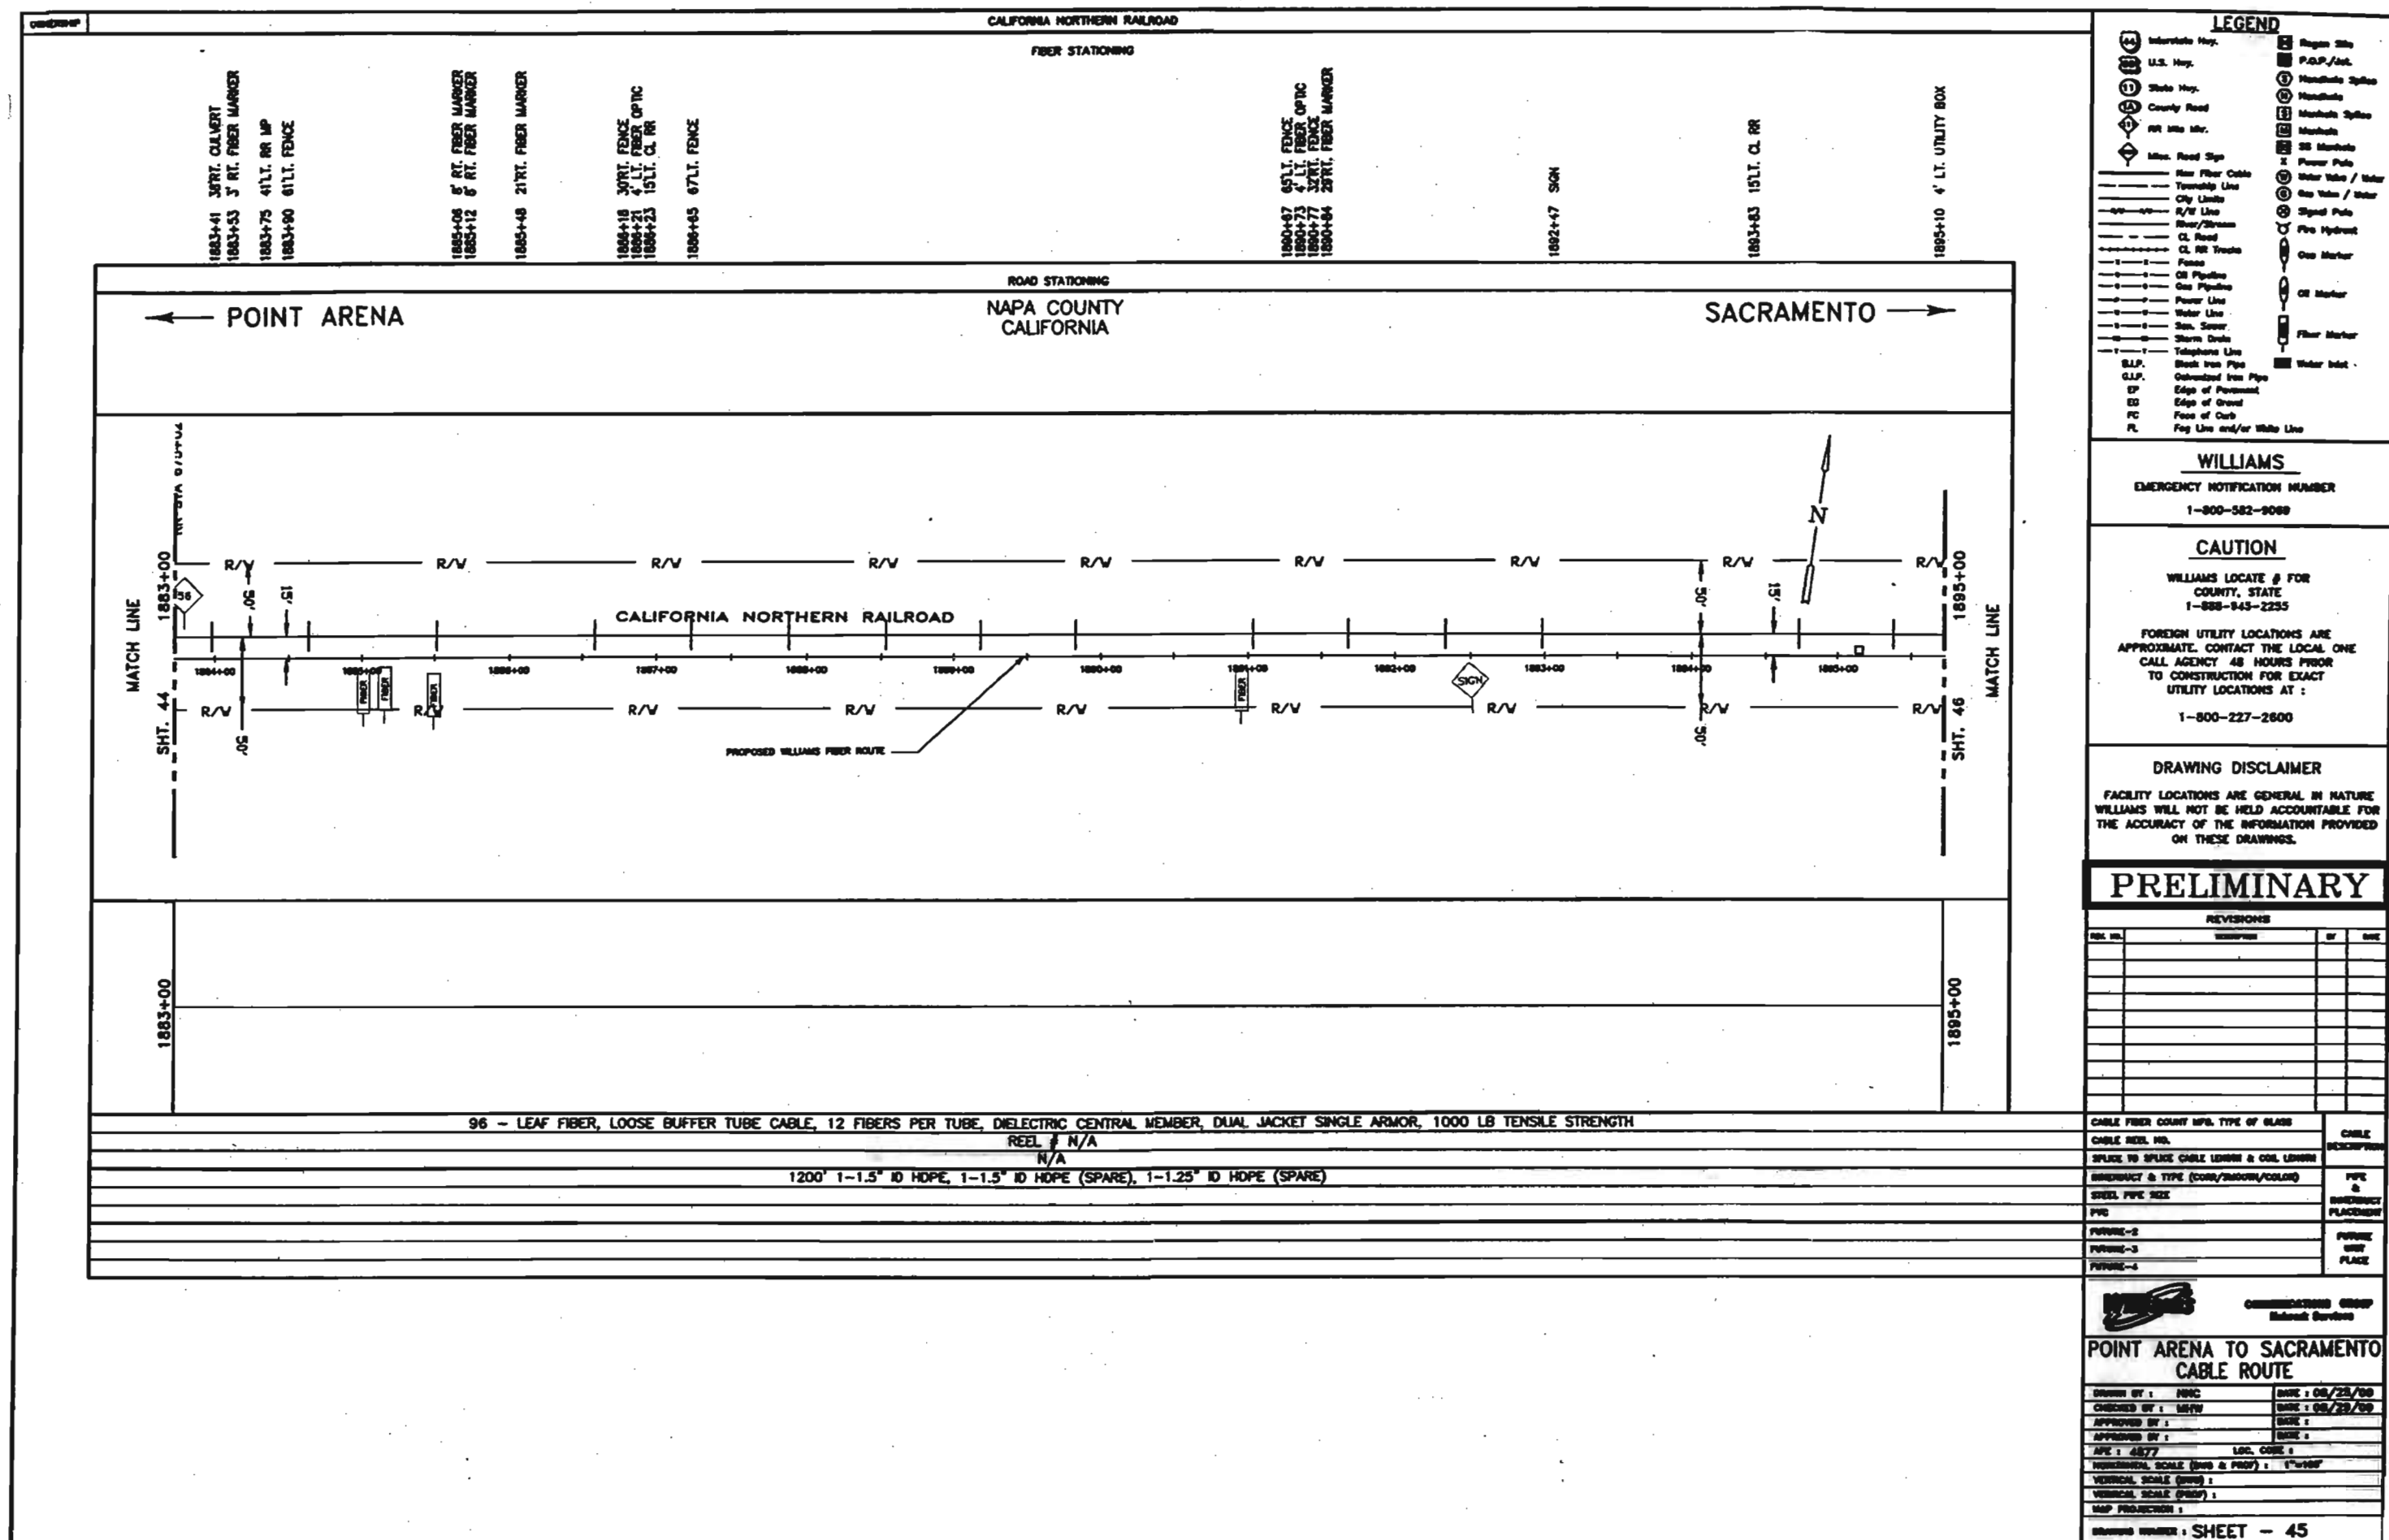

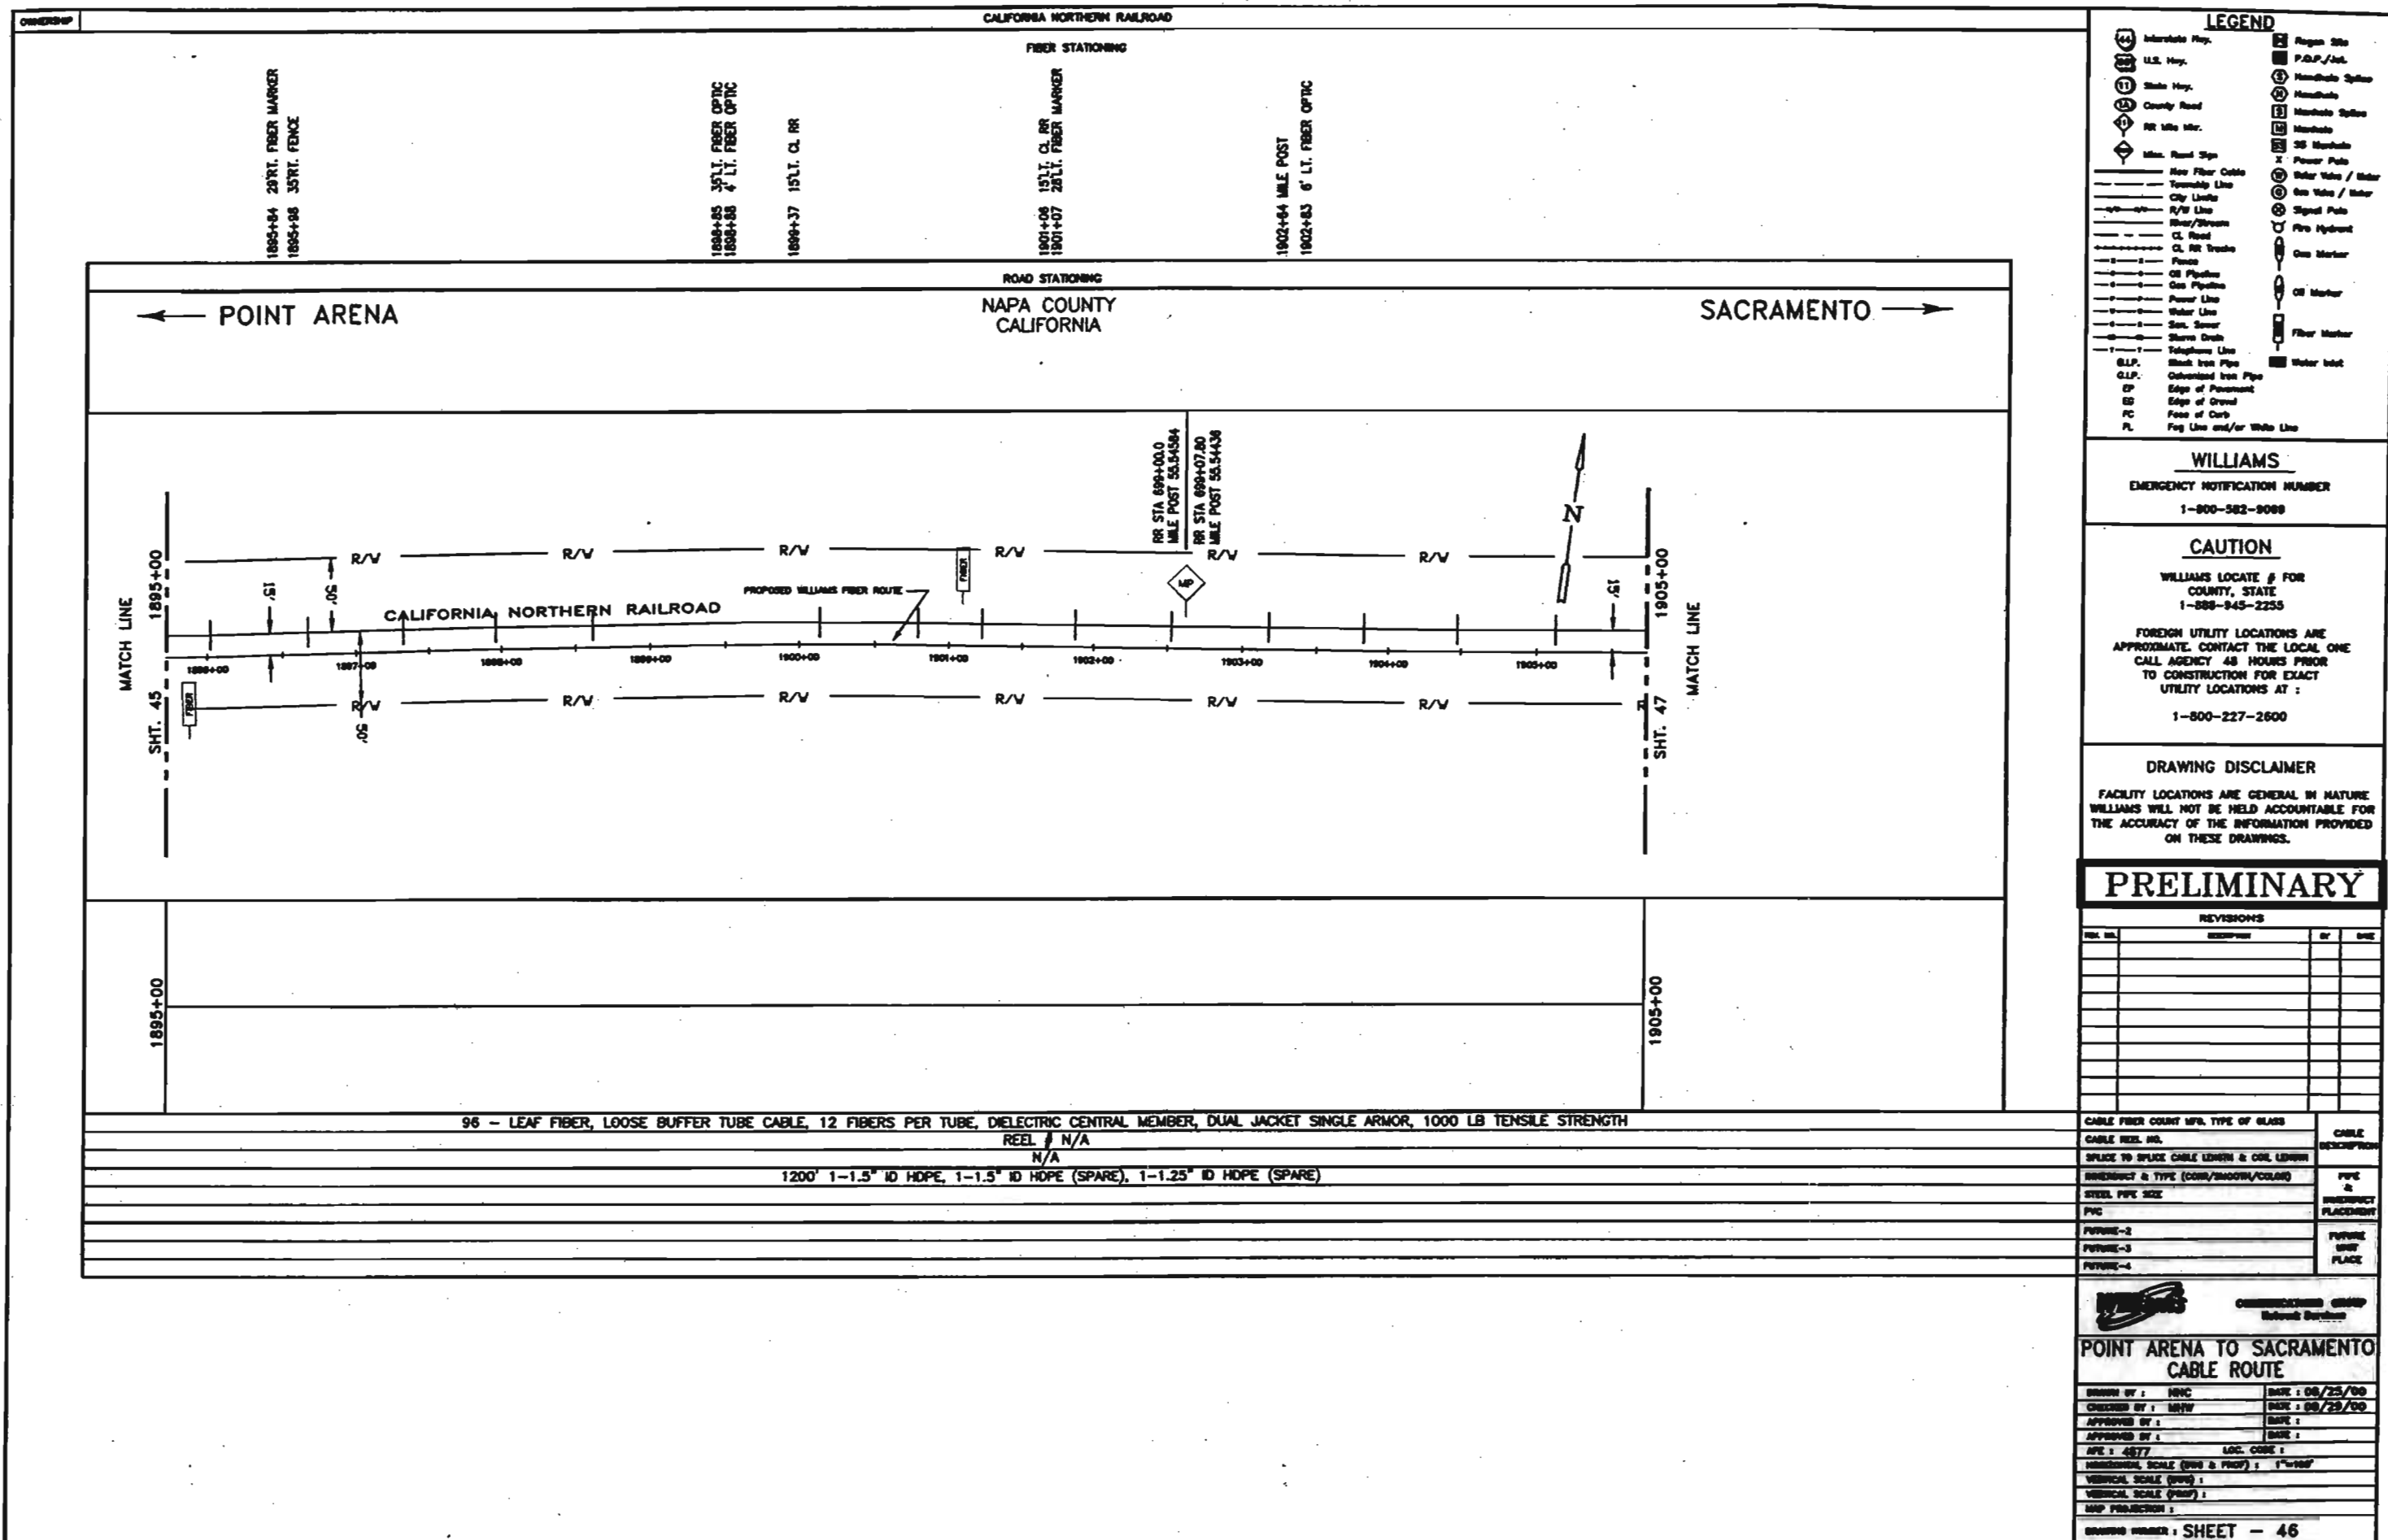


FIBER STATIONING	
1905+89	5' LT. FIBER OPTIC
1905+16	WATER LINE
1905+23	20" LT. WATER LINE
1905+25	30" LT. WATER LINE
1905+28	1" RT. WATER LINE
1905+31	40" LT. WATER LINE
1905+38	30" LT. GAS LINE
1905+40	52" LT. VENT
1905+41	GAS LINE
1905+44	FIBER MARKER
1907+37	37" LT. FIBER MARKER
1907+37	40" LT. FIBER OPTIC
1907+37	5' LT. FIBER OPTIC
1907+37	FIBER MARKER
1908+00	5' RT. MEADOW
1908+10	1" LT. EOP
1908+13	80" LT. SON
1908+17	20" LT. CL RR
1908+28	54" LT. EOP
1908+45	70" LT. FENCE CORNER
1908+45	82" LT. UTILITY BOX
1908+49	28" LT. GATE
1908+50	64" LT. UTILITY BOX
1908+53	30" LT. GUY WIRE

POINT ARENA

ROAD STATIONING
NAPA COUNTY
CALIFORNIA

SACRAMENTO

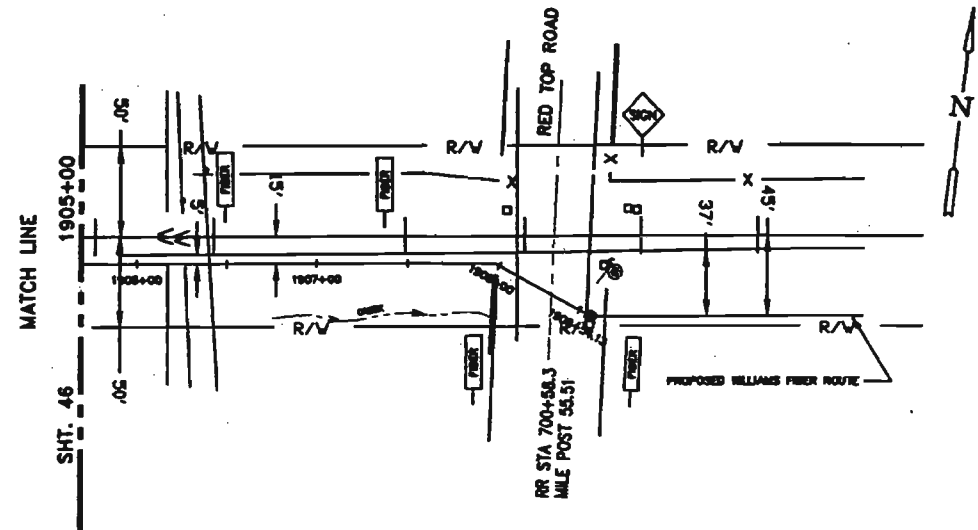

LEGEND	
44	Intermediate Hvy.
45	U.S. Hvy.
46	State Hvy.
47	County Road
48	RR Mile Mar.
49	Max. Road Sign
50	New Fiber Cable
51	Township Line
52	City Limits
53	R/W Line
54	River/Stream
55	CL Road
56	CL RR Tracks
57	Pump
58	Oil Pipeline
59	Gas Pipeline
60	Power Line
61	Water Line
62	San. Sewer
63	Storm Drain
64	Telephone Line
65	Black Iron Pipe
66	Galvanized Iron Pipe
67	Edge of Pavement
68	Edge of Gravel
69	Face of Curb
70	Fog Line and/or White Line
71	Regen Site
72	P.O.P./Jct.
73	Handhole Splice
74	Handhole
75	Manhole Splice
76	Manhole
77	SS Manhole
78	Power Pole
79	Water Valve / Meter
80	Gas Valve / Meter
81	Signal Pole
82	Fire Hydrant
83	Cup Marker
84	Oil Marker
85	Fiber Marker
86	Water Inlet

WILLIAMS

EMERGENCY NOTIFICATION NUMBER
1-800-582-9088

CAUTION

WILLIAMS LOCATE # FOR
COUNTY, STATE
1-888-845-2255

FOREIGN UTILITY LOCATIONS ARE
APPROXIMATE. CONTACT THE LOCAL ONE
CALL AGENCY 48 HOURS PRIOR
TO CONSTRUCTION FOR EXACT
UTILITY LOCATIONS AT :
1-800-227-2600

DRAWING DISCLAIMER

FACILITY LOCATIONS ARE GENERAL IN NATURE
WILLIAMS WILL NOT BE HELD ACCOUNTABLE FOR
THE ACCURACY OF THE INFORMATION PROVIDED
ON THESE DRAWINGS.

PRELIMINARY

REVISIONS			
REV. NO.	DESCRIPTION	BY	DATE

96 - LEAF FIBER, LOOSE BUFFER TUBE CABLE, 12 FIBERS PER TUBE, DIELECTRIC CENTRAL MEMBER, DUAL JACKET SINGLE ARMOR, 1000 LB TENSILE STRENGTH	
REEL # N/A	
N/A	
1200' 1-1.5" ID HOPE, 1-1.5" ID HOPE (SPARE), 1-1.25" ID HOPE (SPARE)	

CABLE FIBER COUNT MFG. TYPE OF GLASS	CABLE DESCRIPTION
CABLE REEL NO.	
SPACE TO SPACE CABLE LENGTH & COIL LENGTH	PIPE & BURIED PLACEMENT
DIRECTION & TYPE (CON/SIGCON/COLOR)	
STEEL PIPE SIZE	FUTURE USE PLACE
PVC	
FUTURE-2	
FUTURE-3	
FUTURE-4	

**COMMUNICATIONS GROUP**
Network Services

**POINT ARENA TO SACRAMENTO
CABLE ROUTE**

DESIGN BY : HNC DATE : 08/25/00
CHECKED BY : MHW DATE : 08/29/00
APPROVED BY : DATE :
APPROVED BY : DATE :
APE : 4877 LAC CODE :
HORIZONTAL SCALE (HWS & PWS) : 1"=100'
VERTICAL SCALE (VWS) :
VERTICAL SCALE (VWP) :
MAP PROJECTION :
DRAWING NUMBER : SHEET - 47